

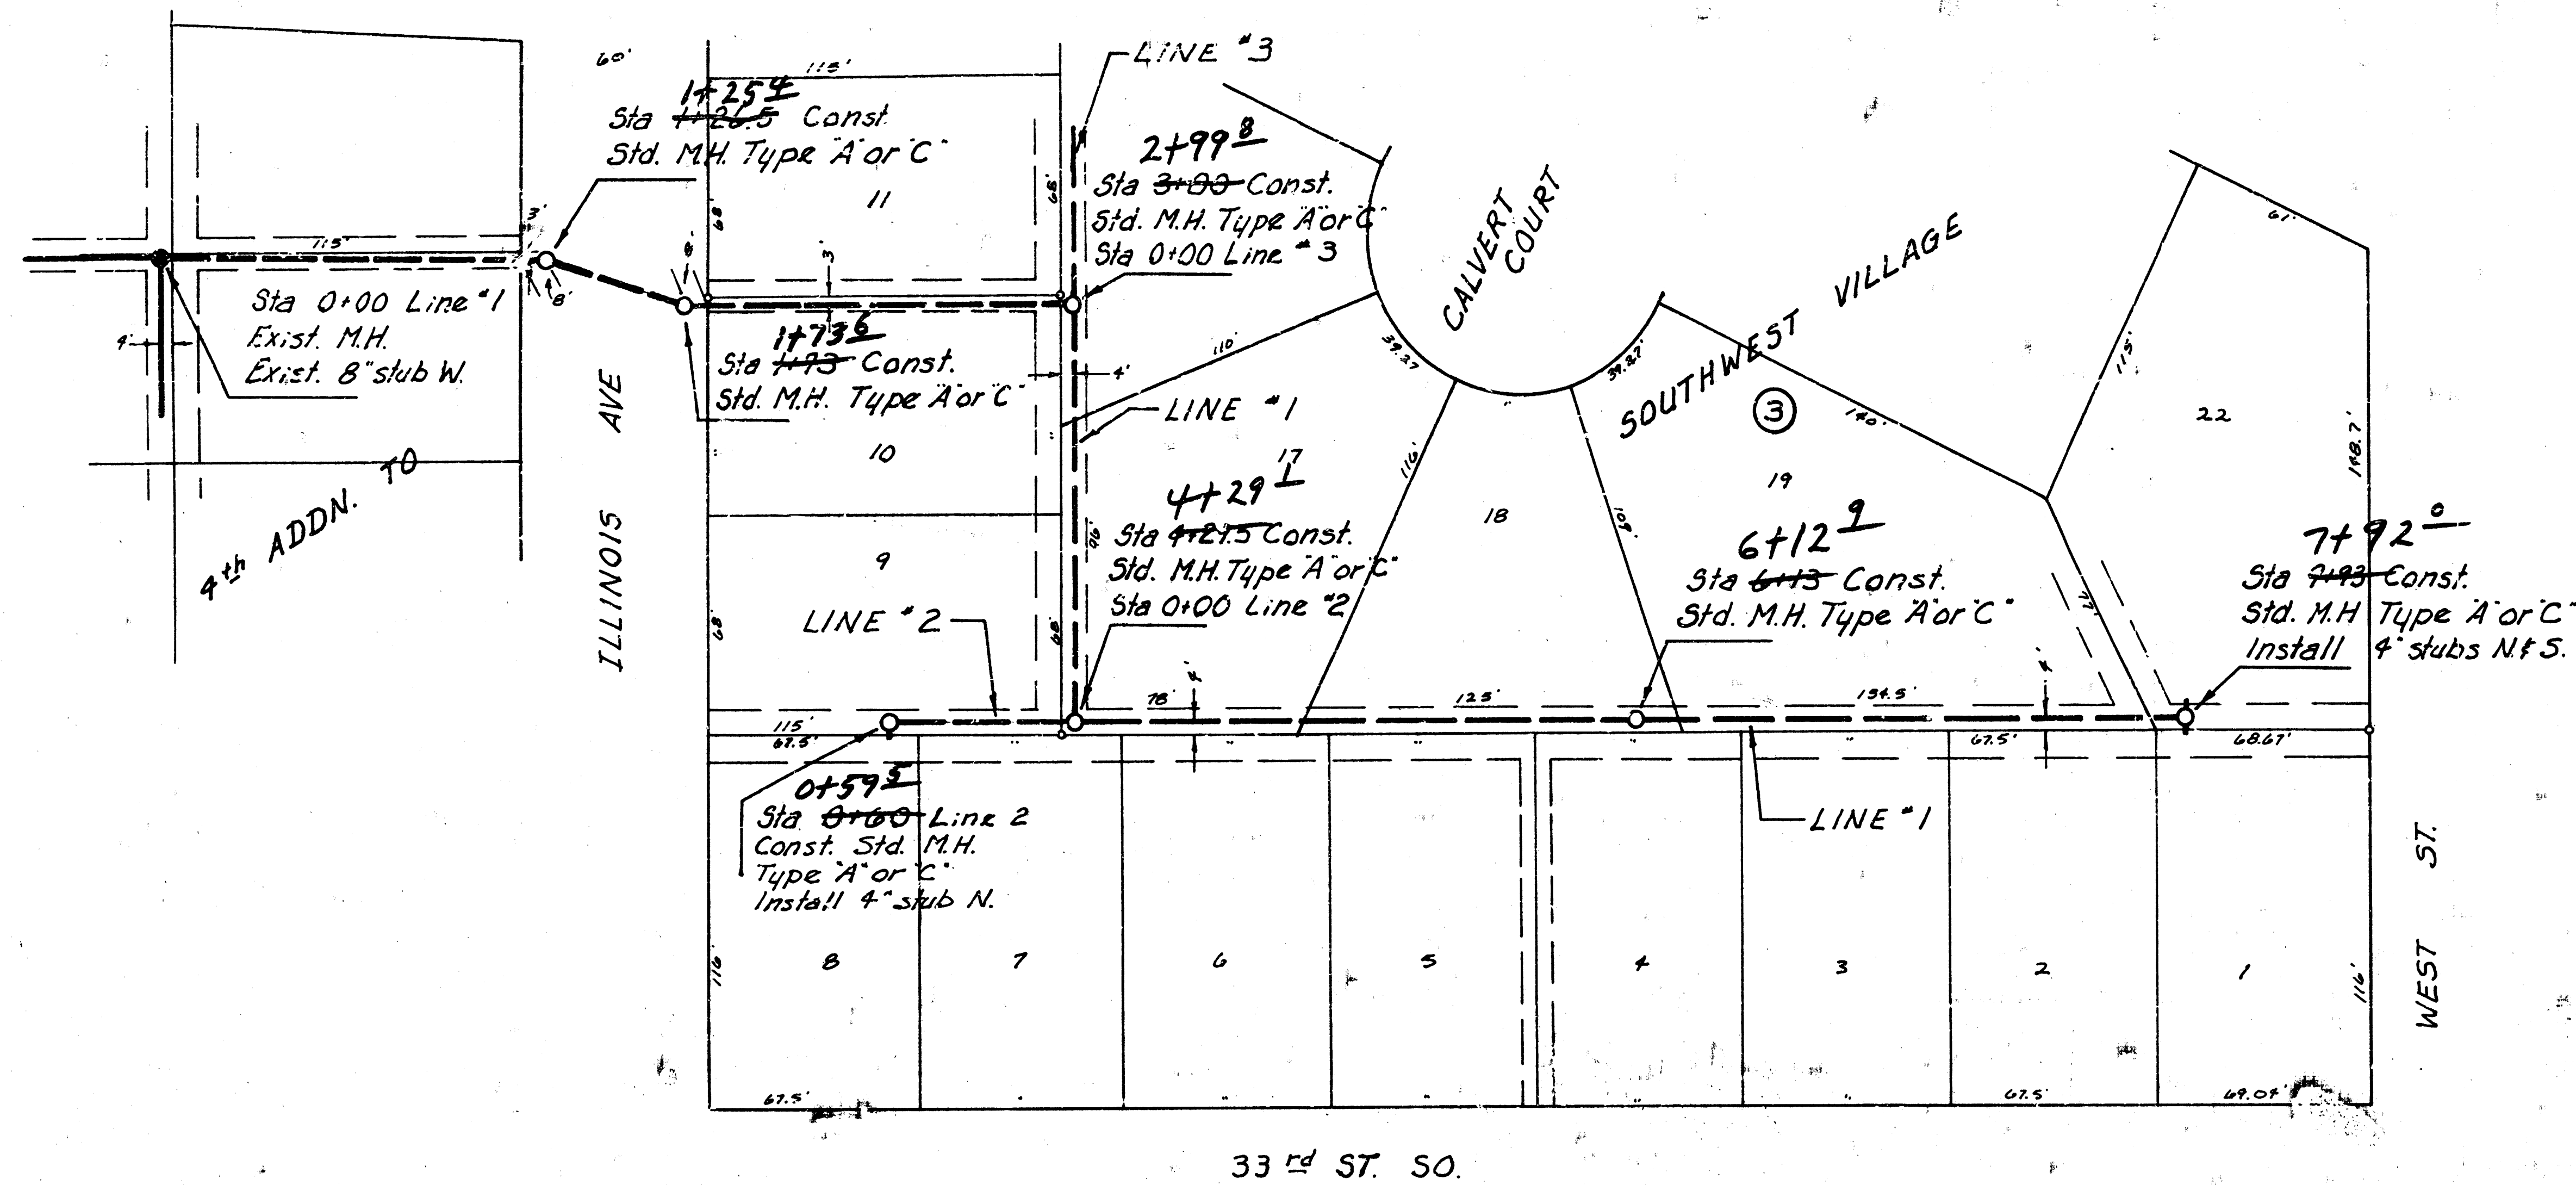




Fig. 261
K. Loomis

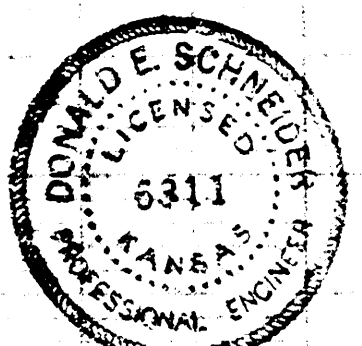

B.M. 103.97 City Sid. 33' E & 46' S. of
 & West St. & 31st St. So.
 B.M. 100.80 "B" cut on N.W. corner of
 East Headwall to R.C.B. just N. of
 St. By-Pass South of 31st St. on West St.

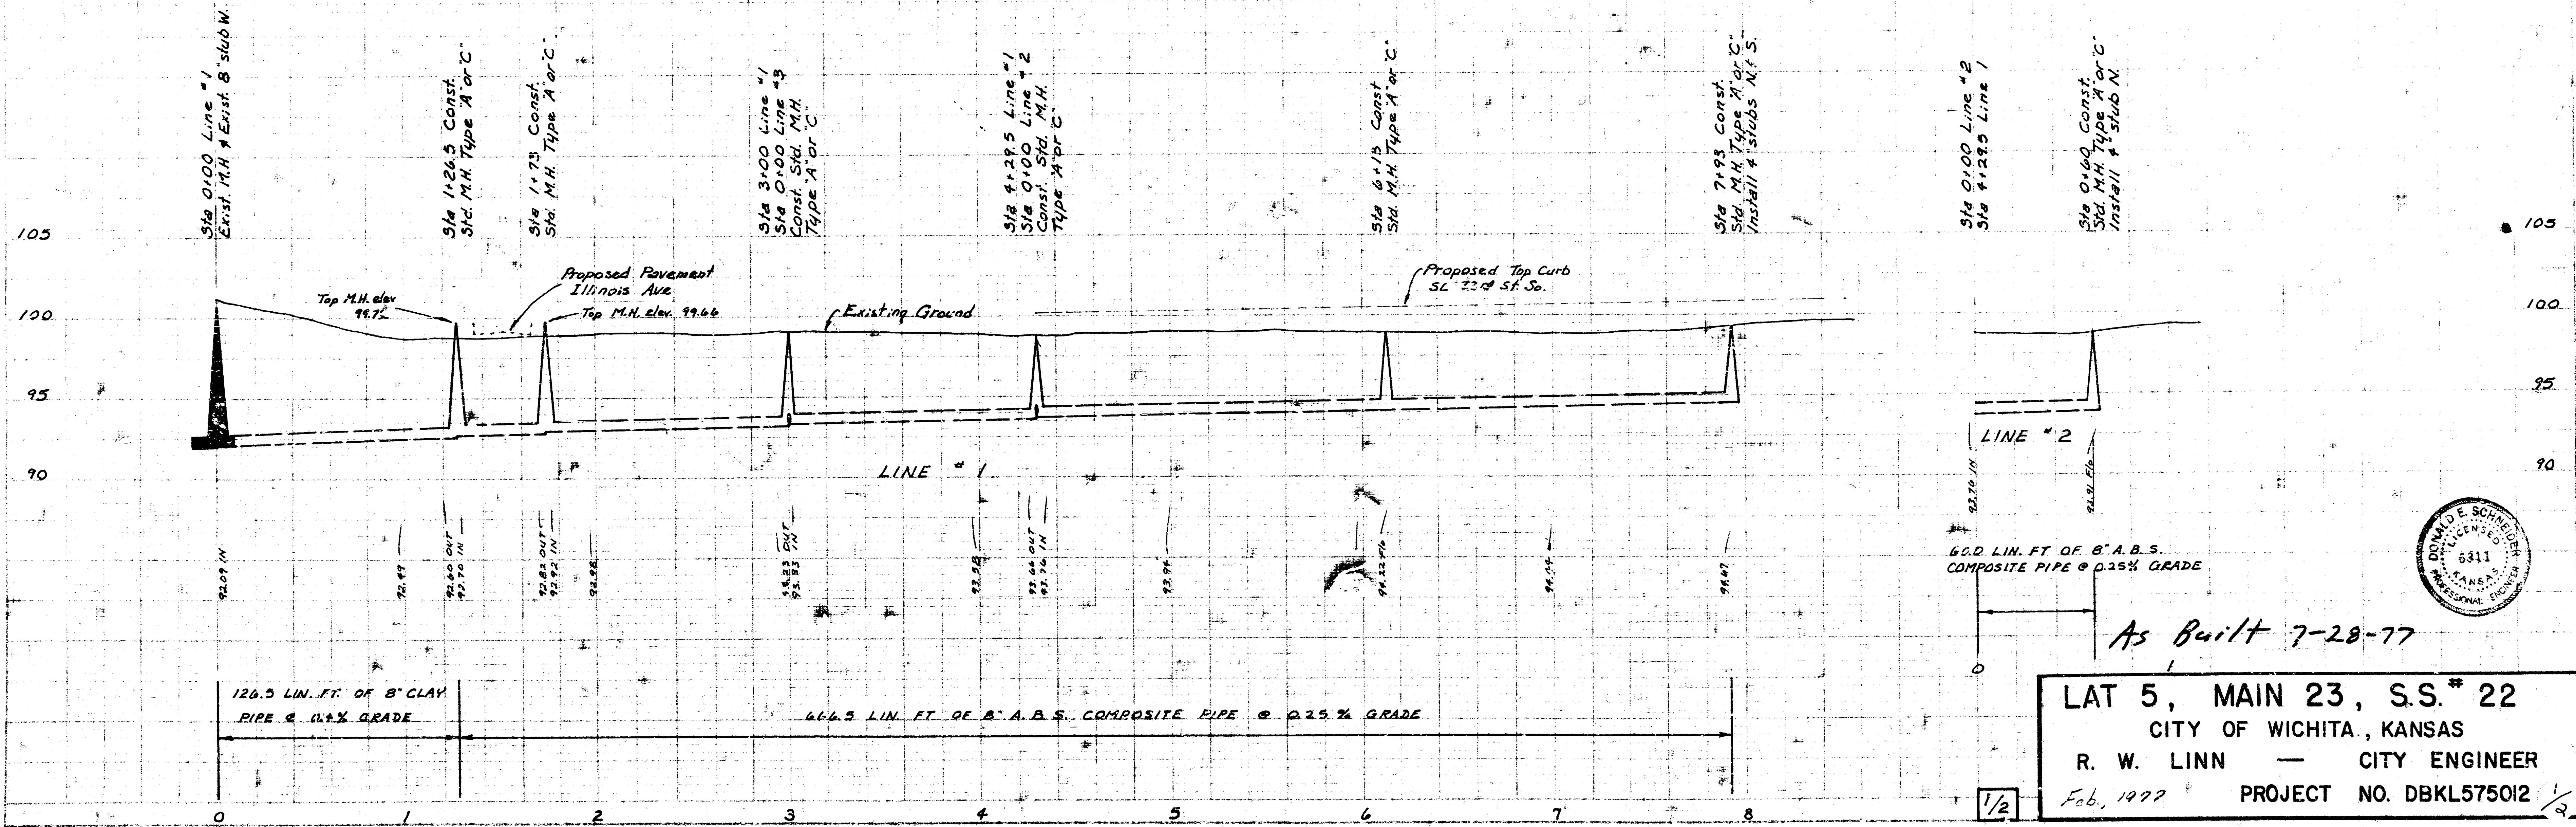

LAT 5, MAIN 23, S.S.* 22
 CITY OF WICHITA, KANSAS
 R. W. LINN — CITY ENGINEER
 Feb, 1977 PROJECT NO. DBKL575012

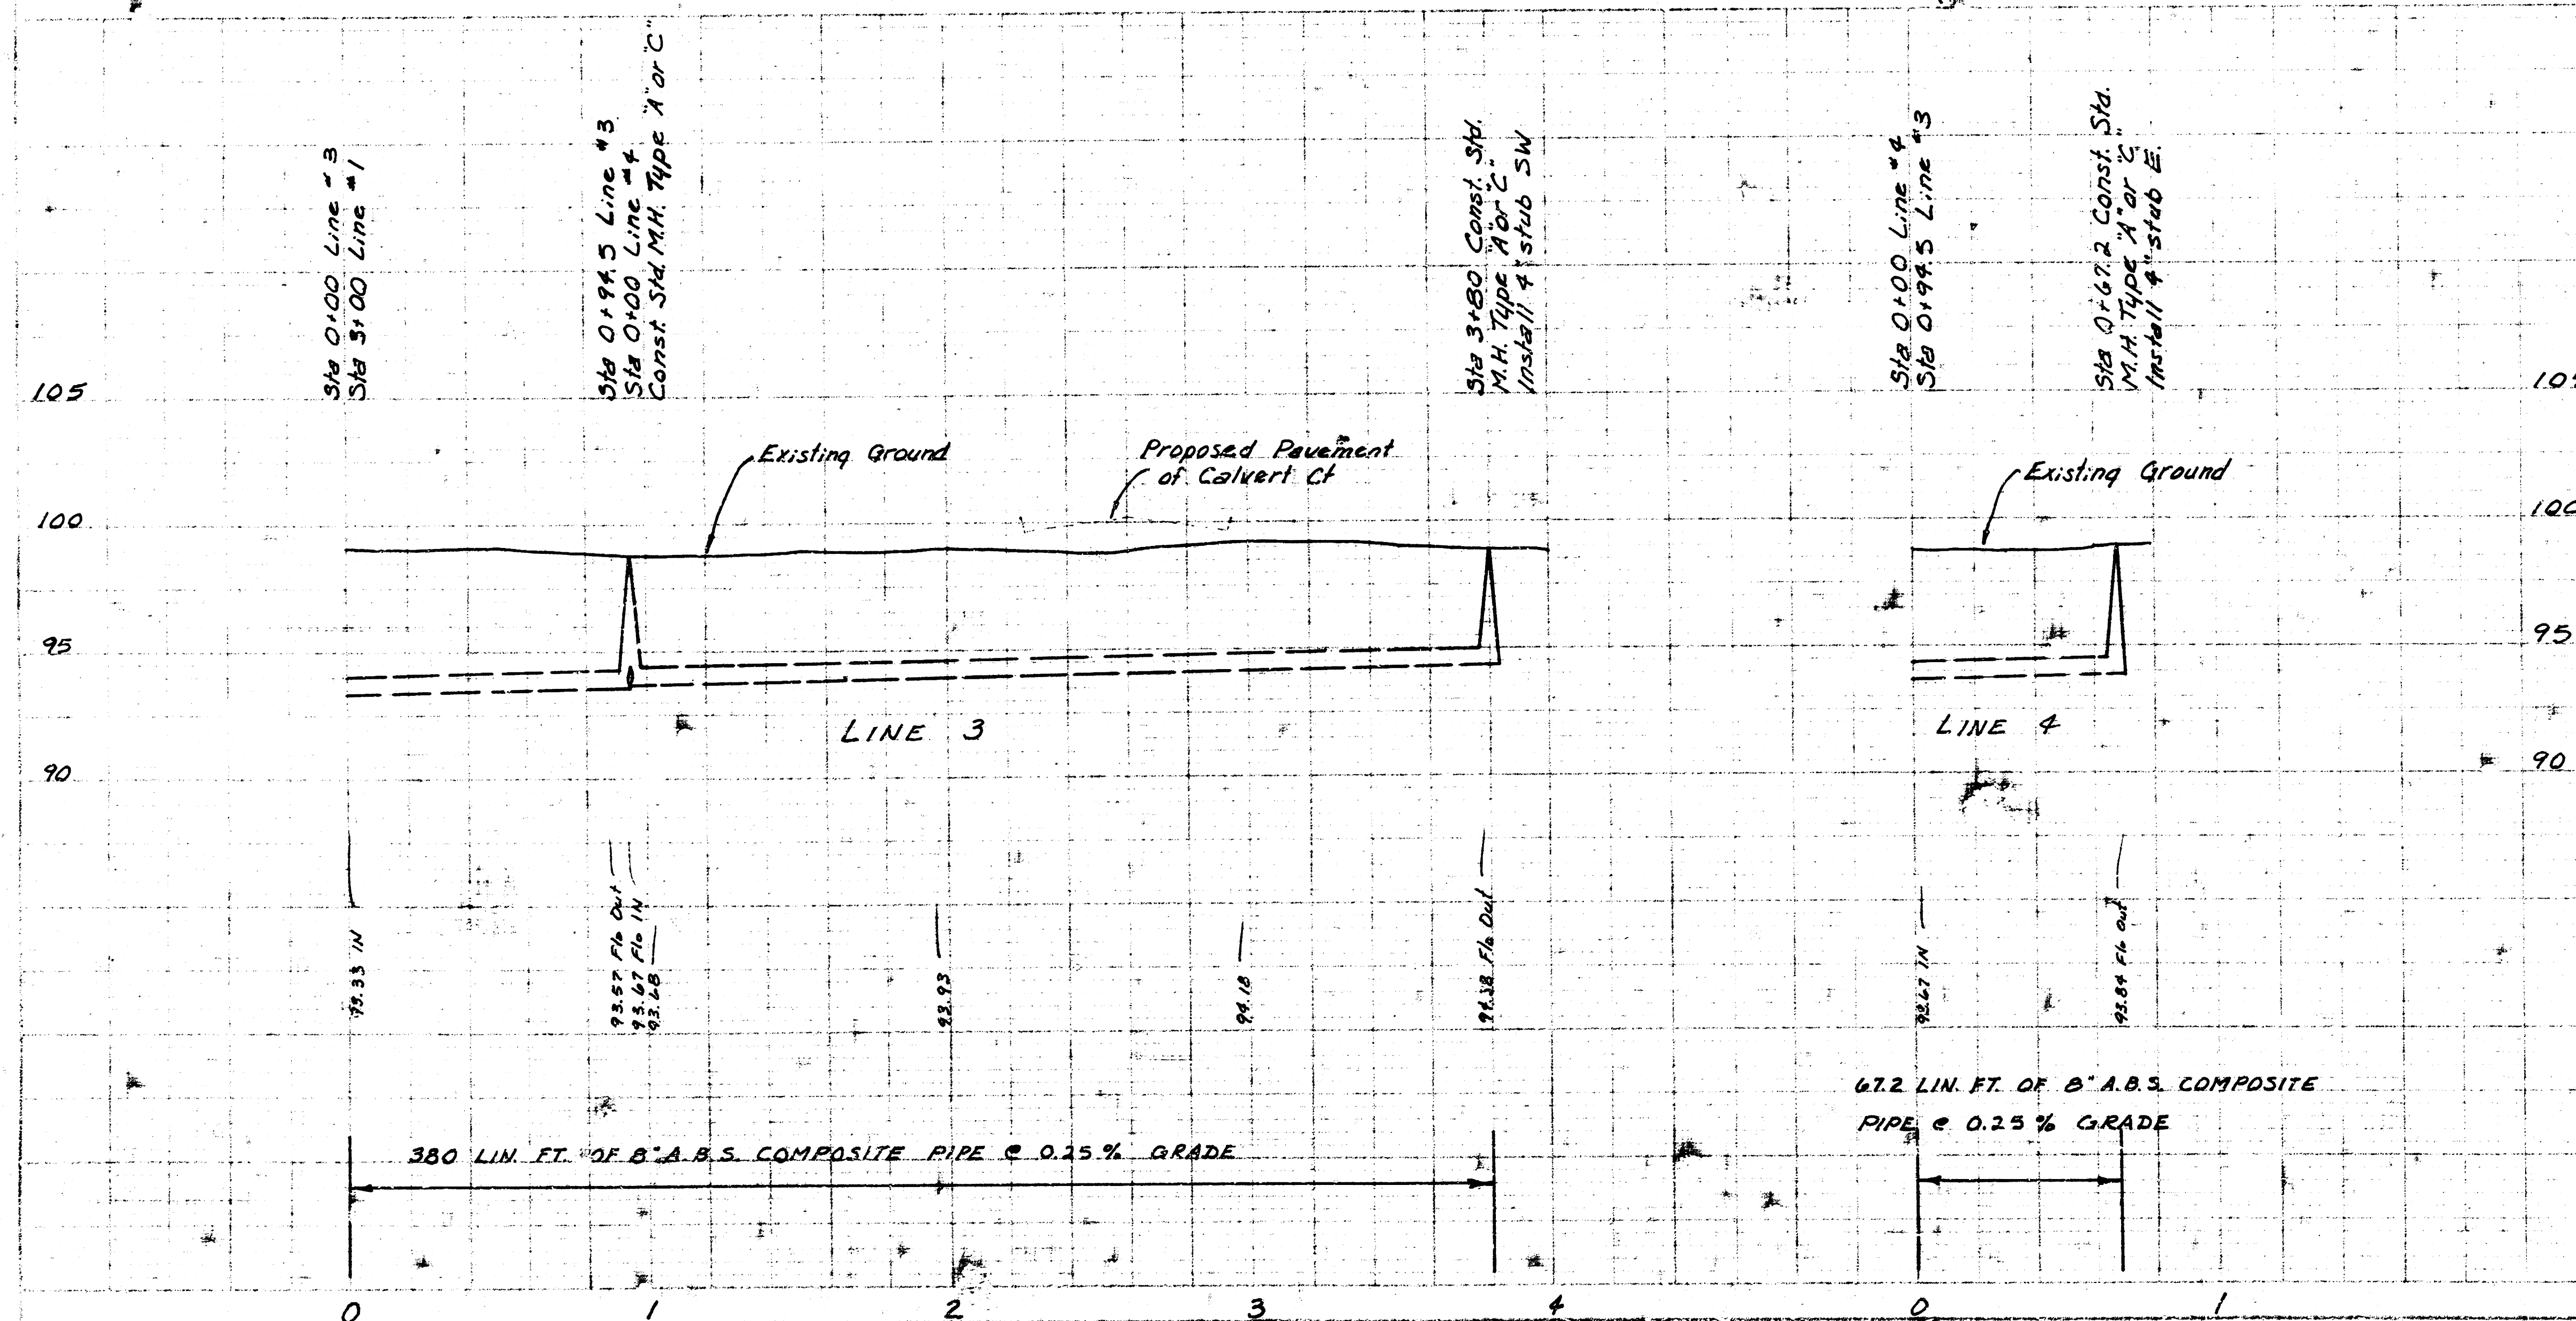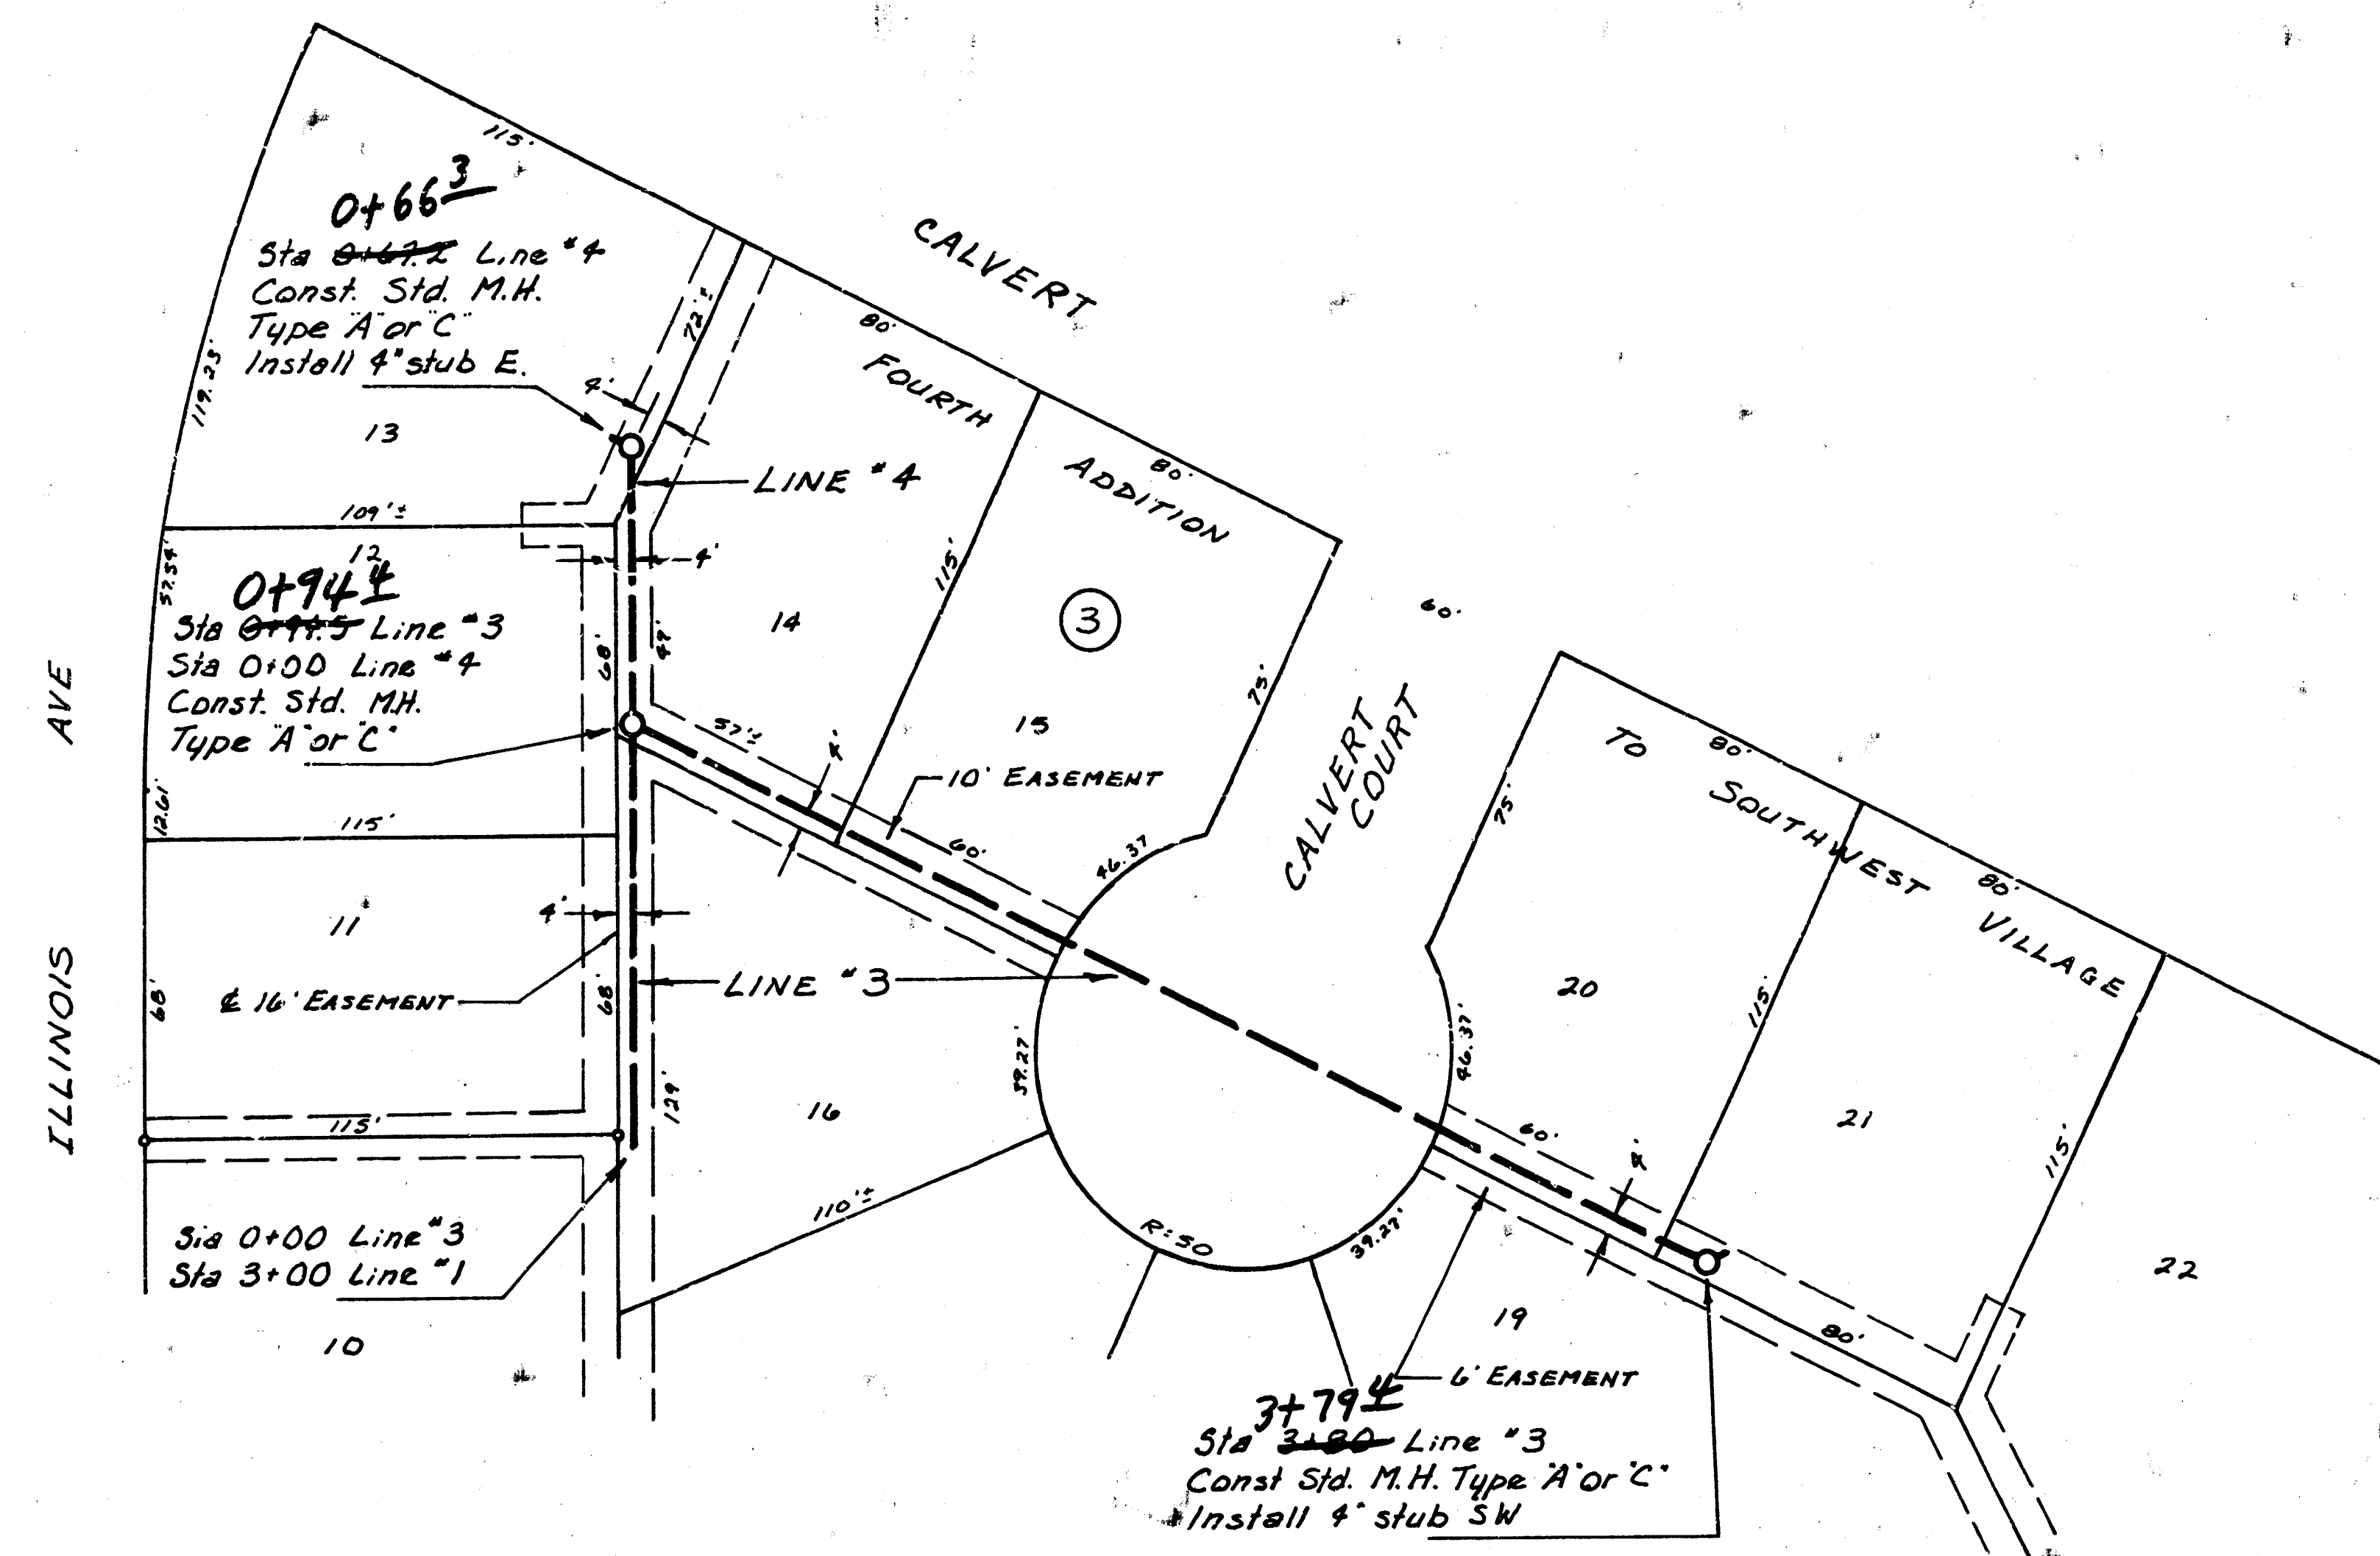

LAT 5, MAIN 23, S.S.*22
 PROJECT NO. DBKL575012
 2/2