



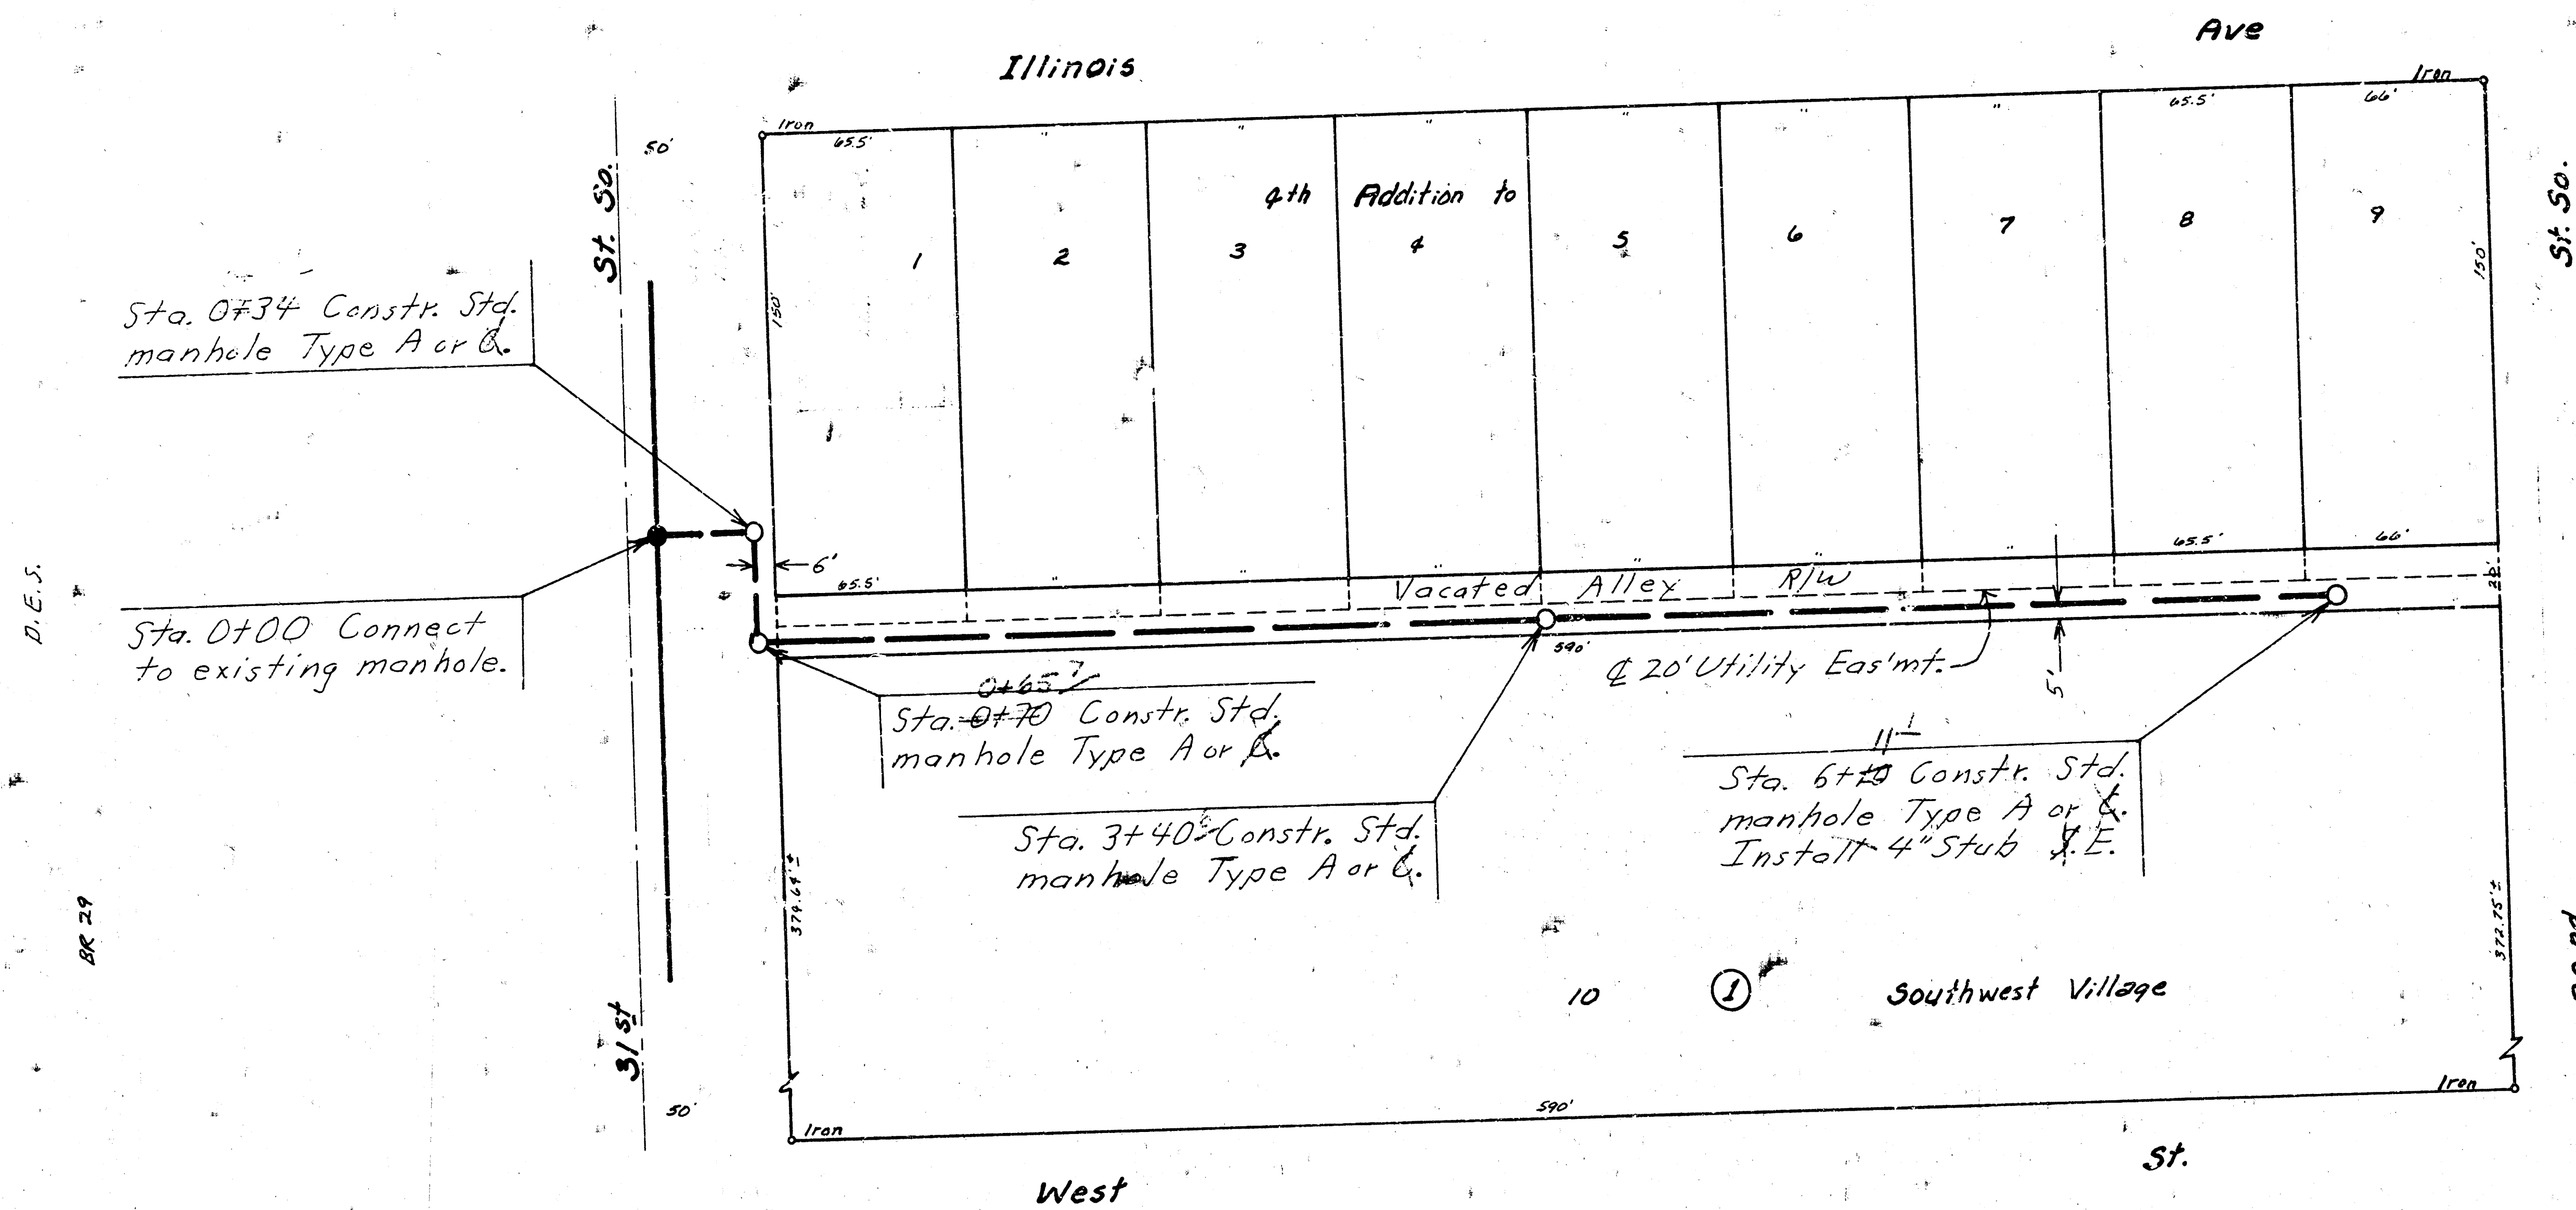


Scale Plan 1" = 40'
 Profile 1" = 40' Horiz.
 1" = 5' Vert.





NOTE: FIELD ENGINEER SHALL SET TOPS OF MANHOLES TO MATCH PROPOSED FINISHED GRADE AS DETERMINED BY THE INTERFERING AGENS. ADDITIONAL SLOPS SHALL BE INSTALLED ON THIS PROJECT TO SERVE INDIVIDUAL LOTS WITH DELAYS OF THE FIELD ENGINEER. RISES OF THE ALIGNS SHALL BE MARKED BY FASTENING GREEN PLASTIC COLORED TAPES TO THE TOP OF THE ALIGNS AND SLOPES OF THE GROUND SURFACE AS THE EXCAVATION IS BACKFILLED SO THAT THE COLORED TAPES WILL BE VISIBLE WHEN THE PROJECT IS COMPLETED. ALL RISERS SHALL BE CONSTRUCTED USING S.D.R. 23.5 A.B.S. OR P.V.C. PIPE. ELEVATIONS OF STUBS AND TOPS OF RISERS SHALL BE SUCH THAT WILL FACILITATE CONNECTION OF RESIDENT DRAINS WHEN THESE LOTS ARE DEVELOPED.

B.M. 103.47 City Std. Disc 53' E. & 44' S. of Q's 31st St. S. & West St.

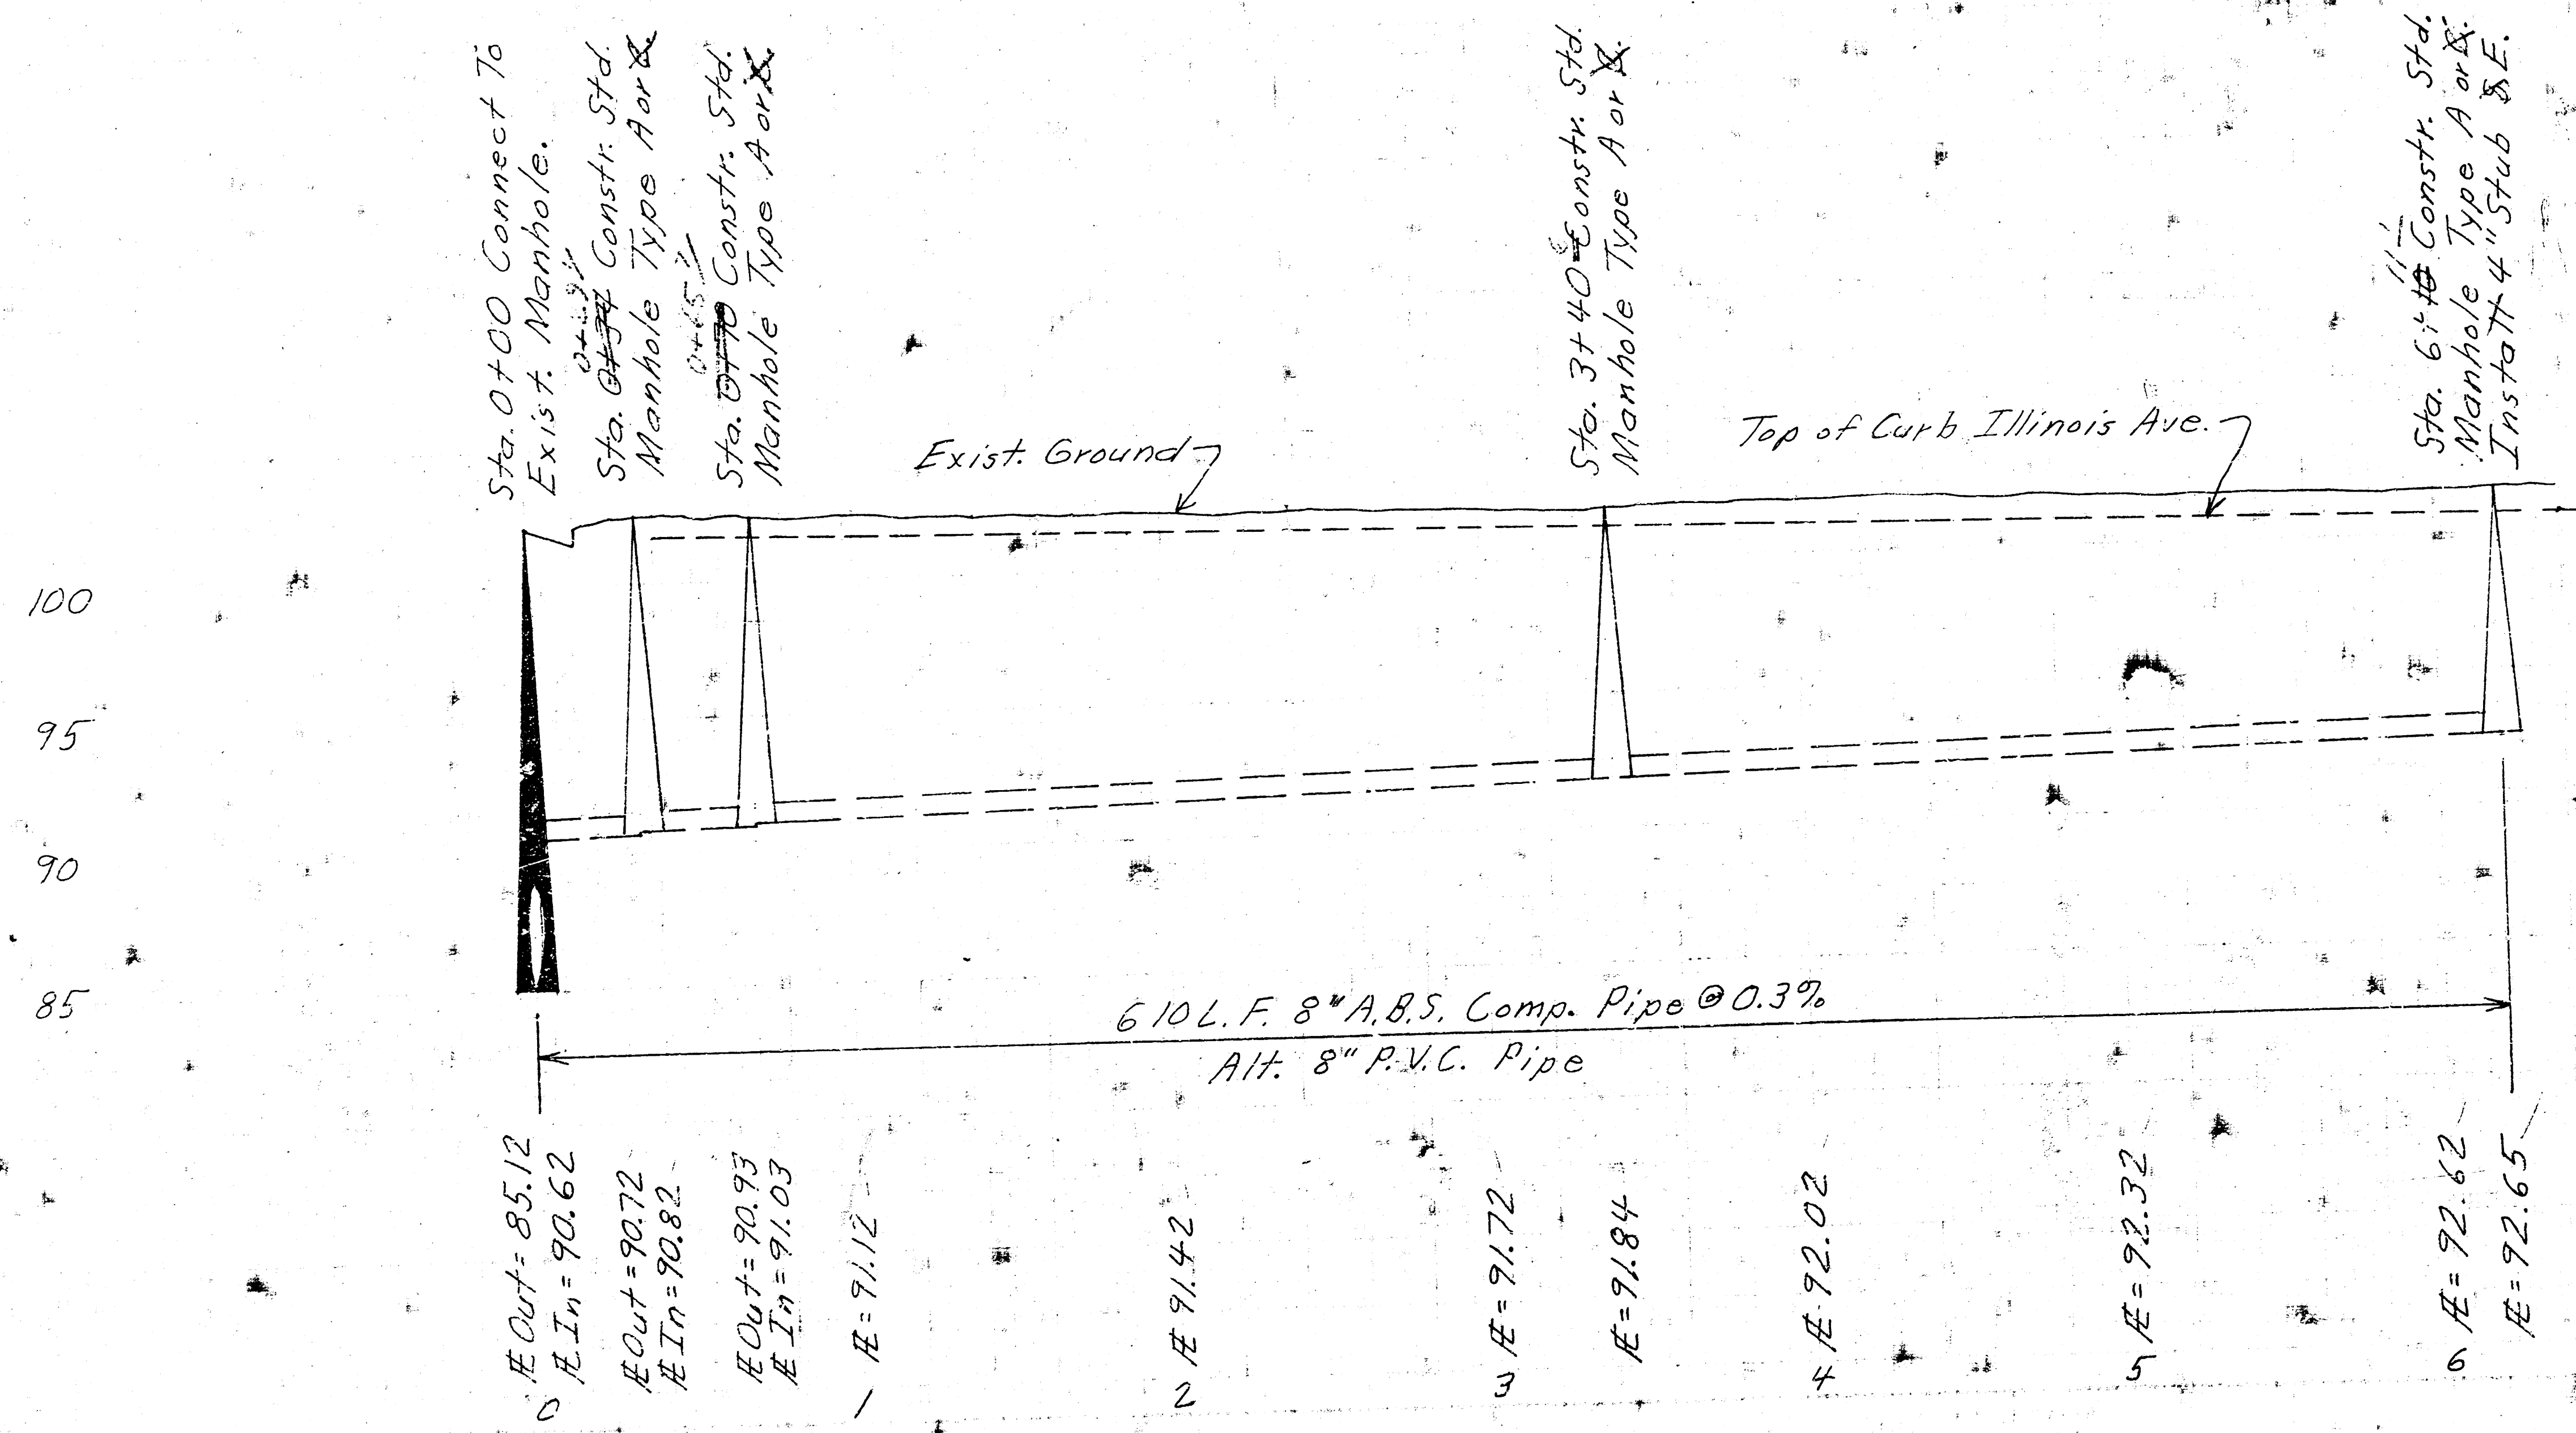

Lat. 6, Main 23, S.S. # 22
 City of Wichita, Kansas
 Dean Sellers - Acting City Engineer
 Proj. # 468-76-245-80190-000-001
 Sht. # 1 of 2

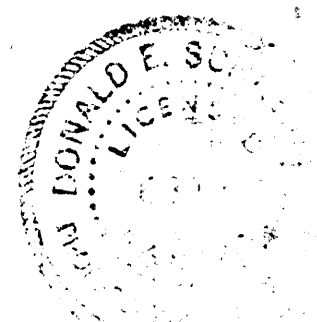

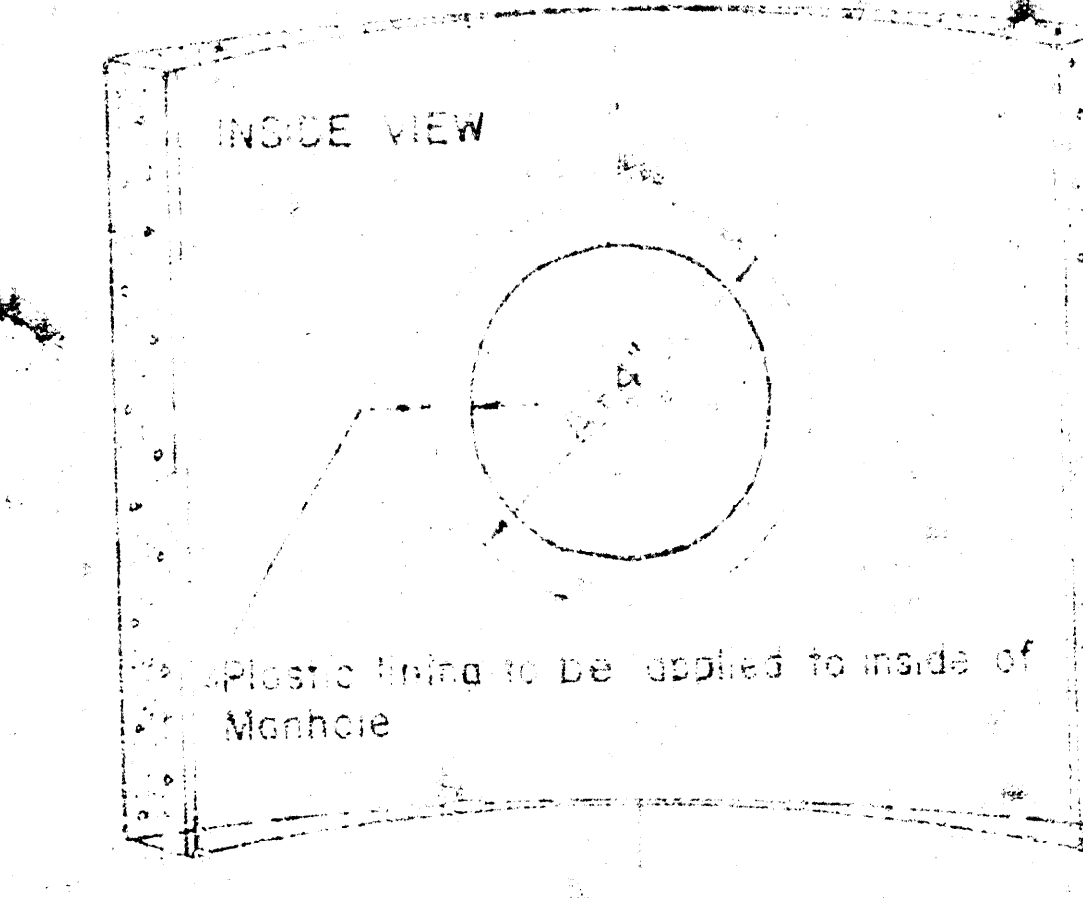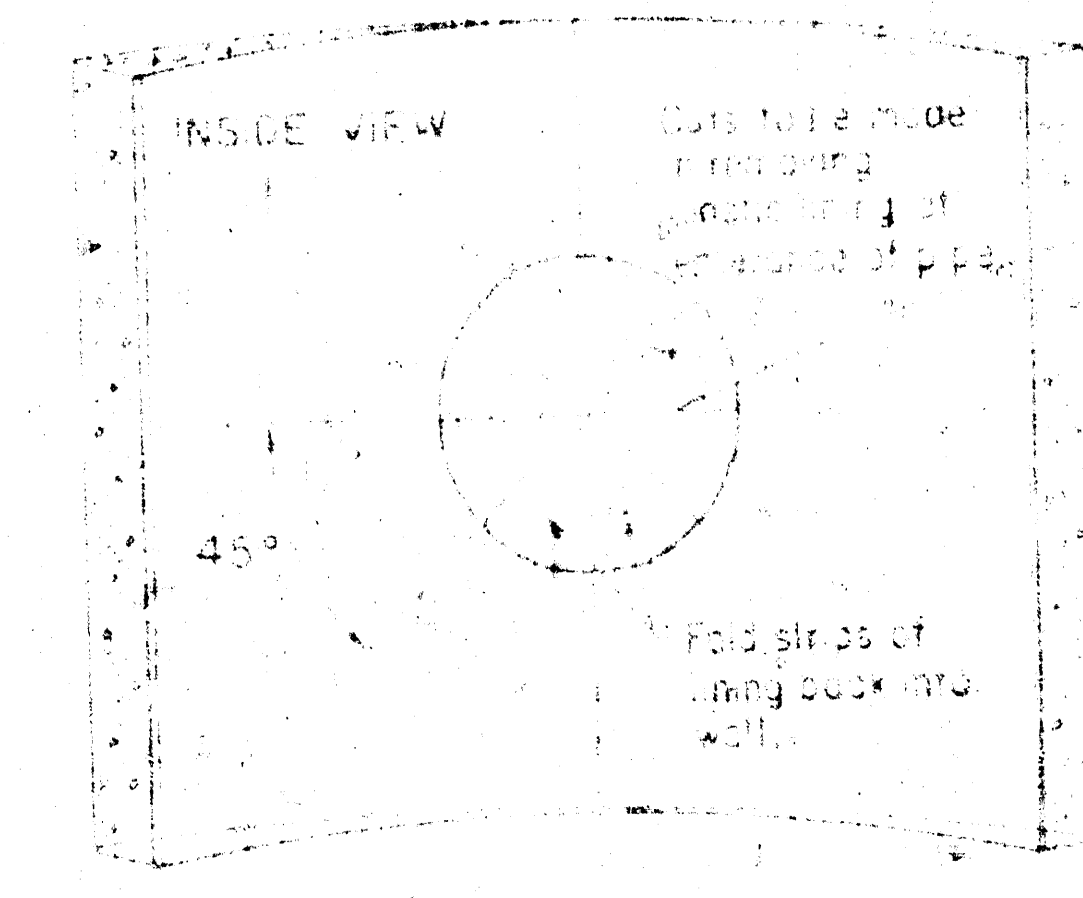 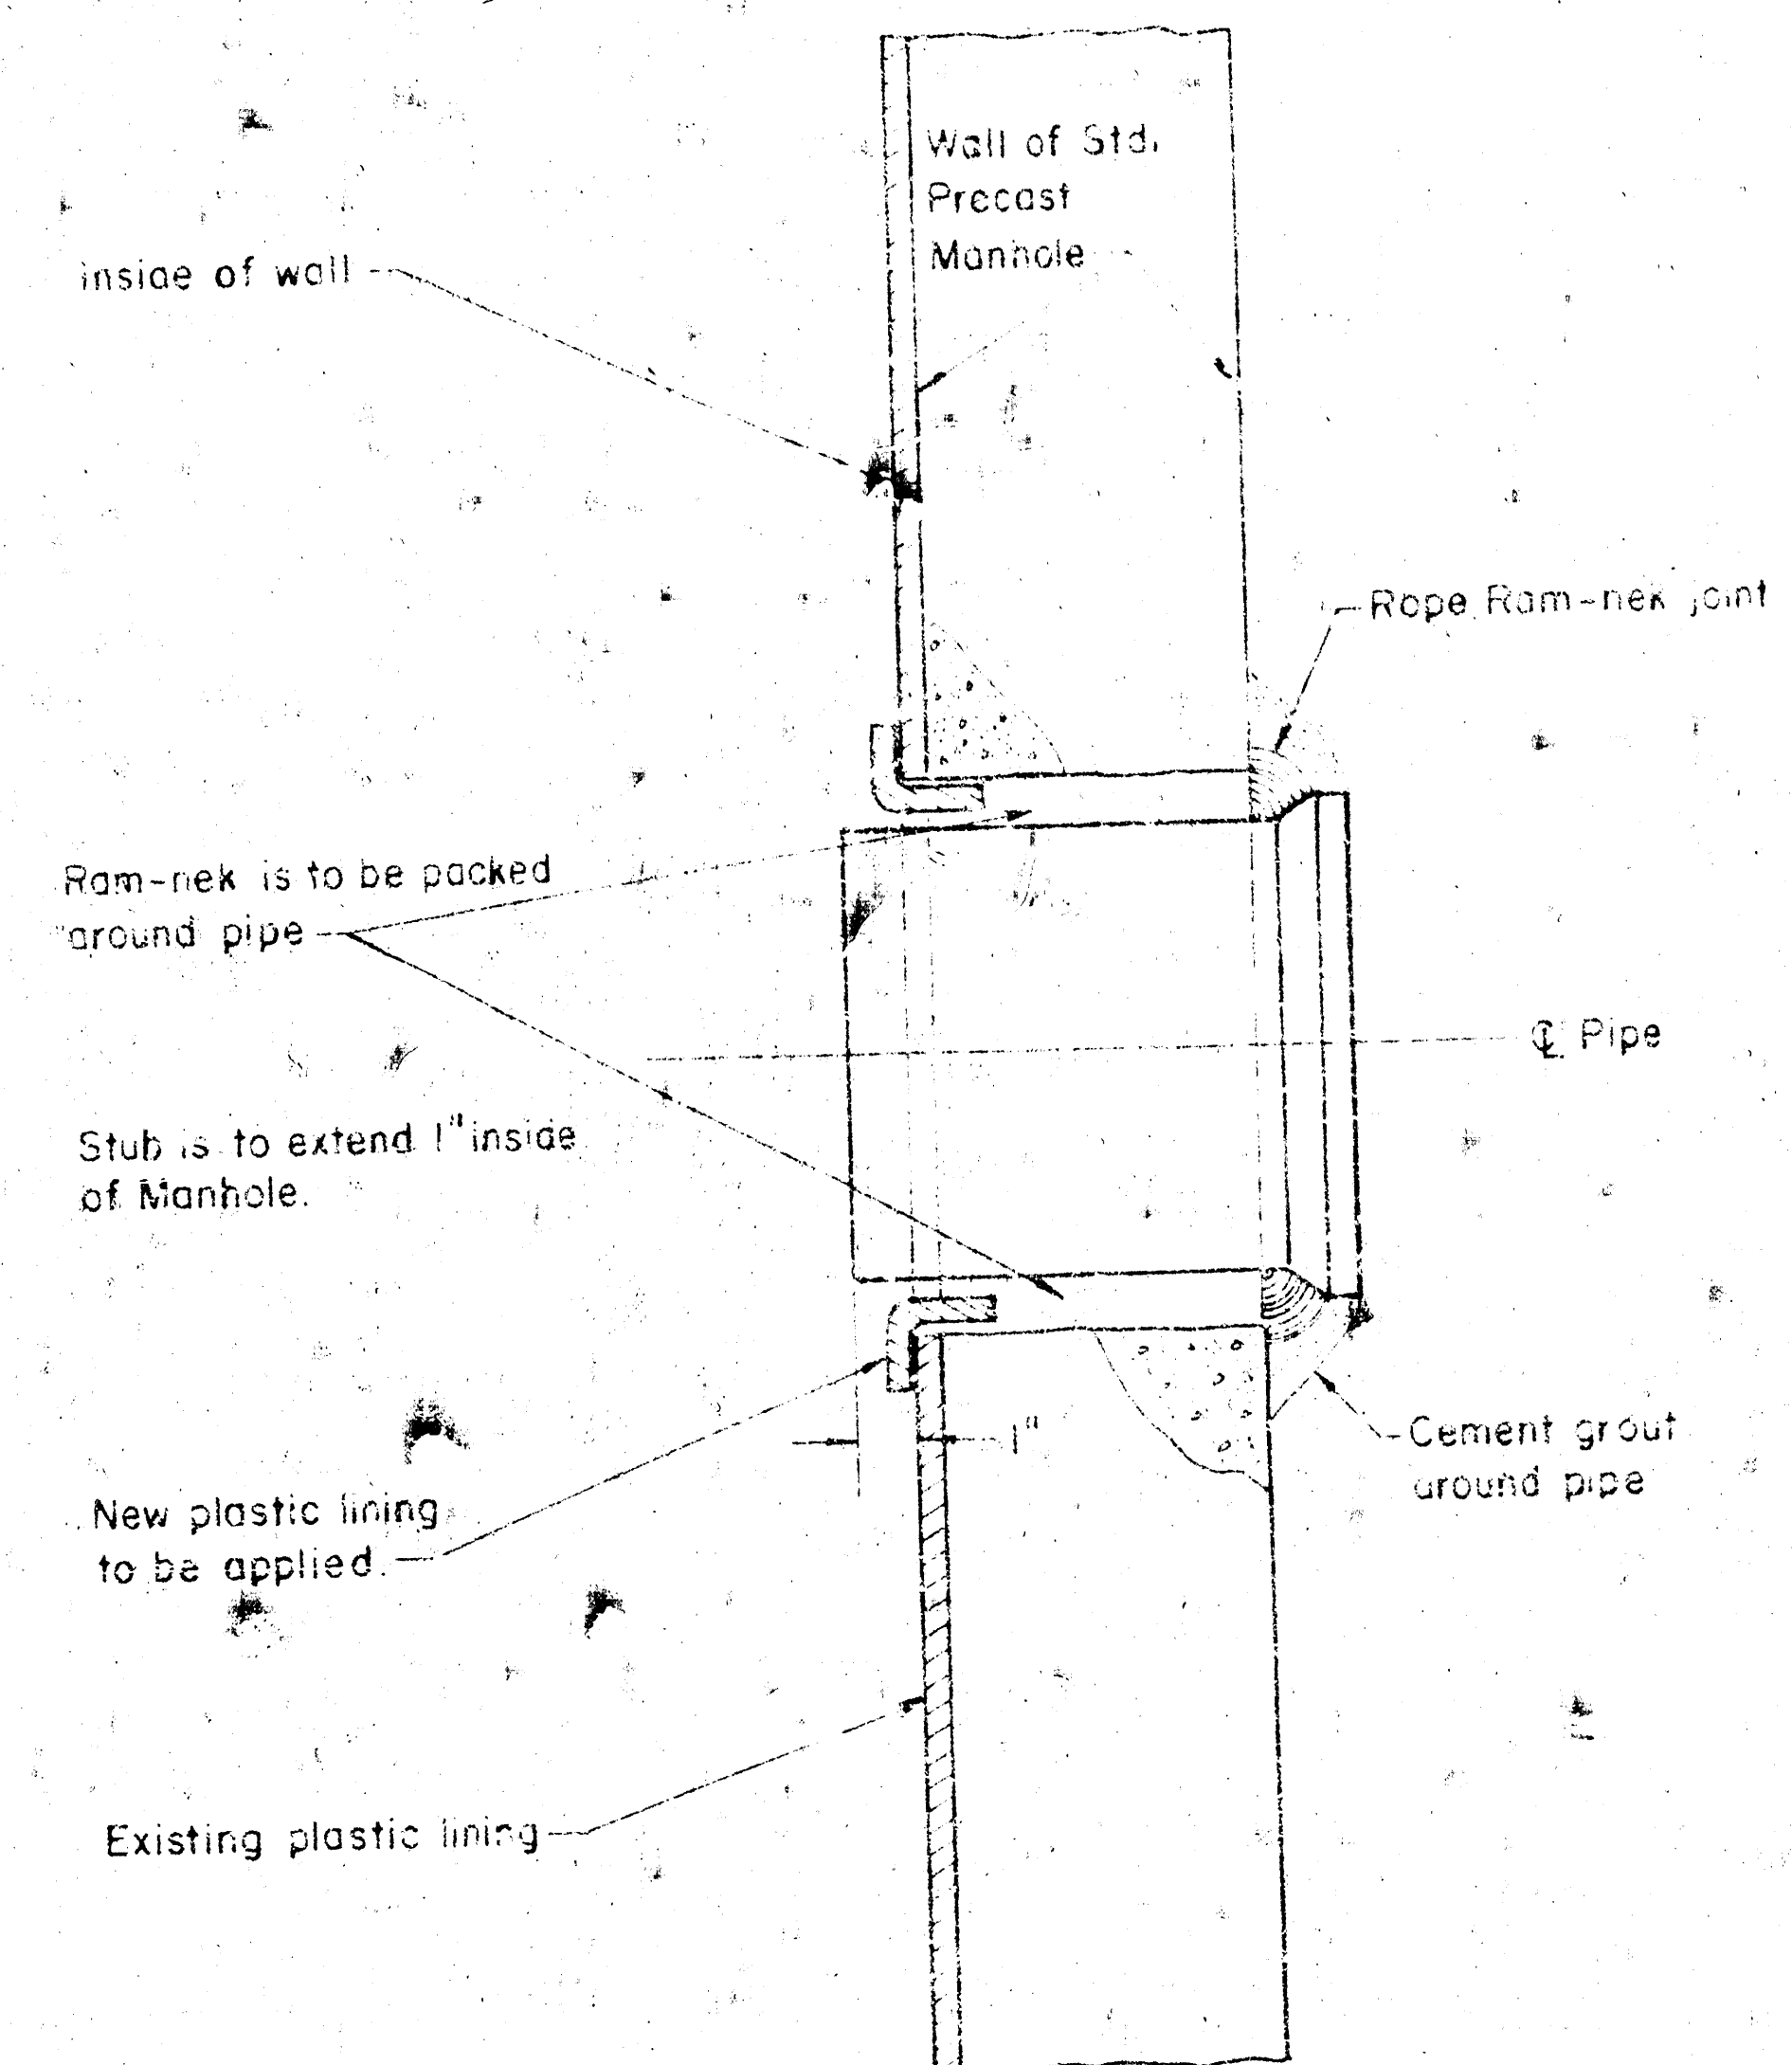

A = OUTSIDE DIAMETER OF PIPE + 2"

DRAWN: OCT 1975
 DETAIL OF PIPE CONNECTION
 TO STRUCTURAL TEE MANHOLE
 CITY OF WICHITA, KANSAS
 R.W. LINN CITY ENGINEER
 PROJECT NUMBER: 10838
 DATE: 10/2/75
 SHEET # 2 of 2