



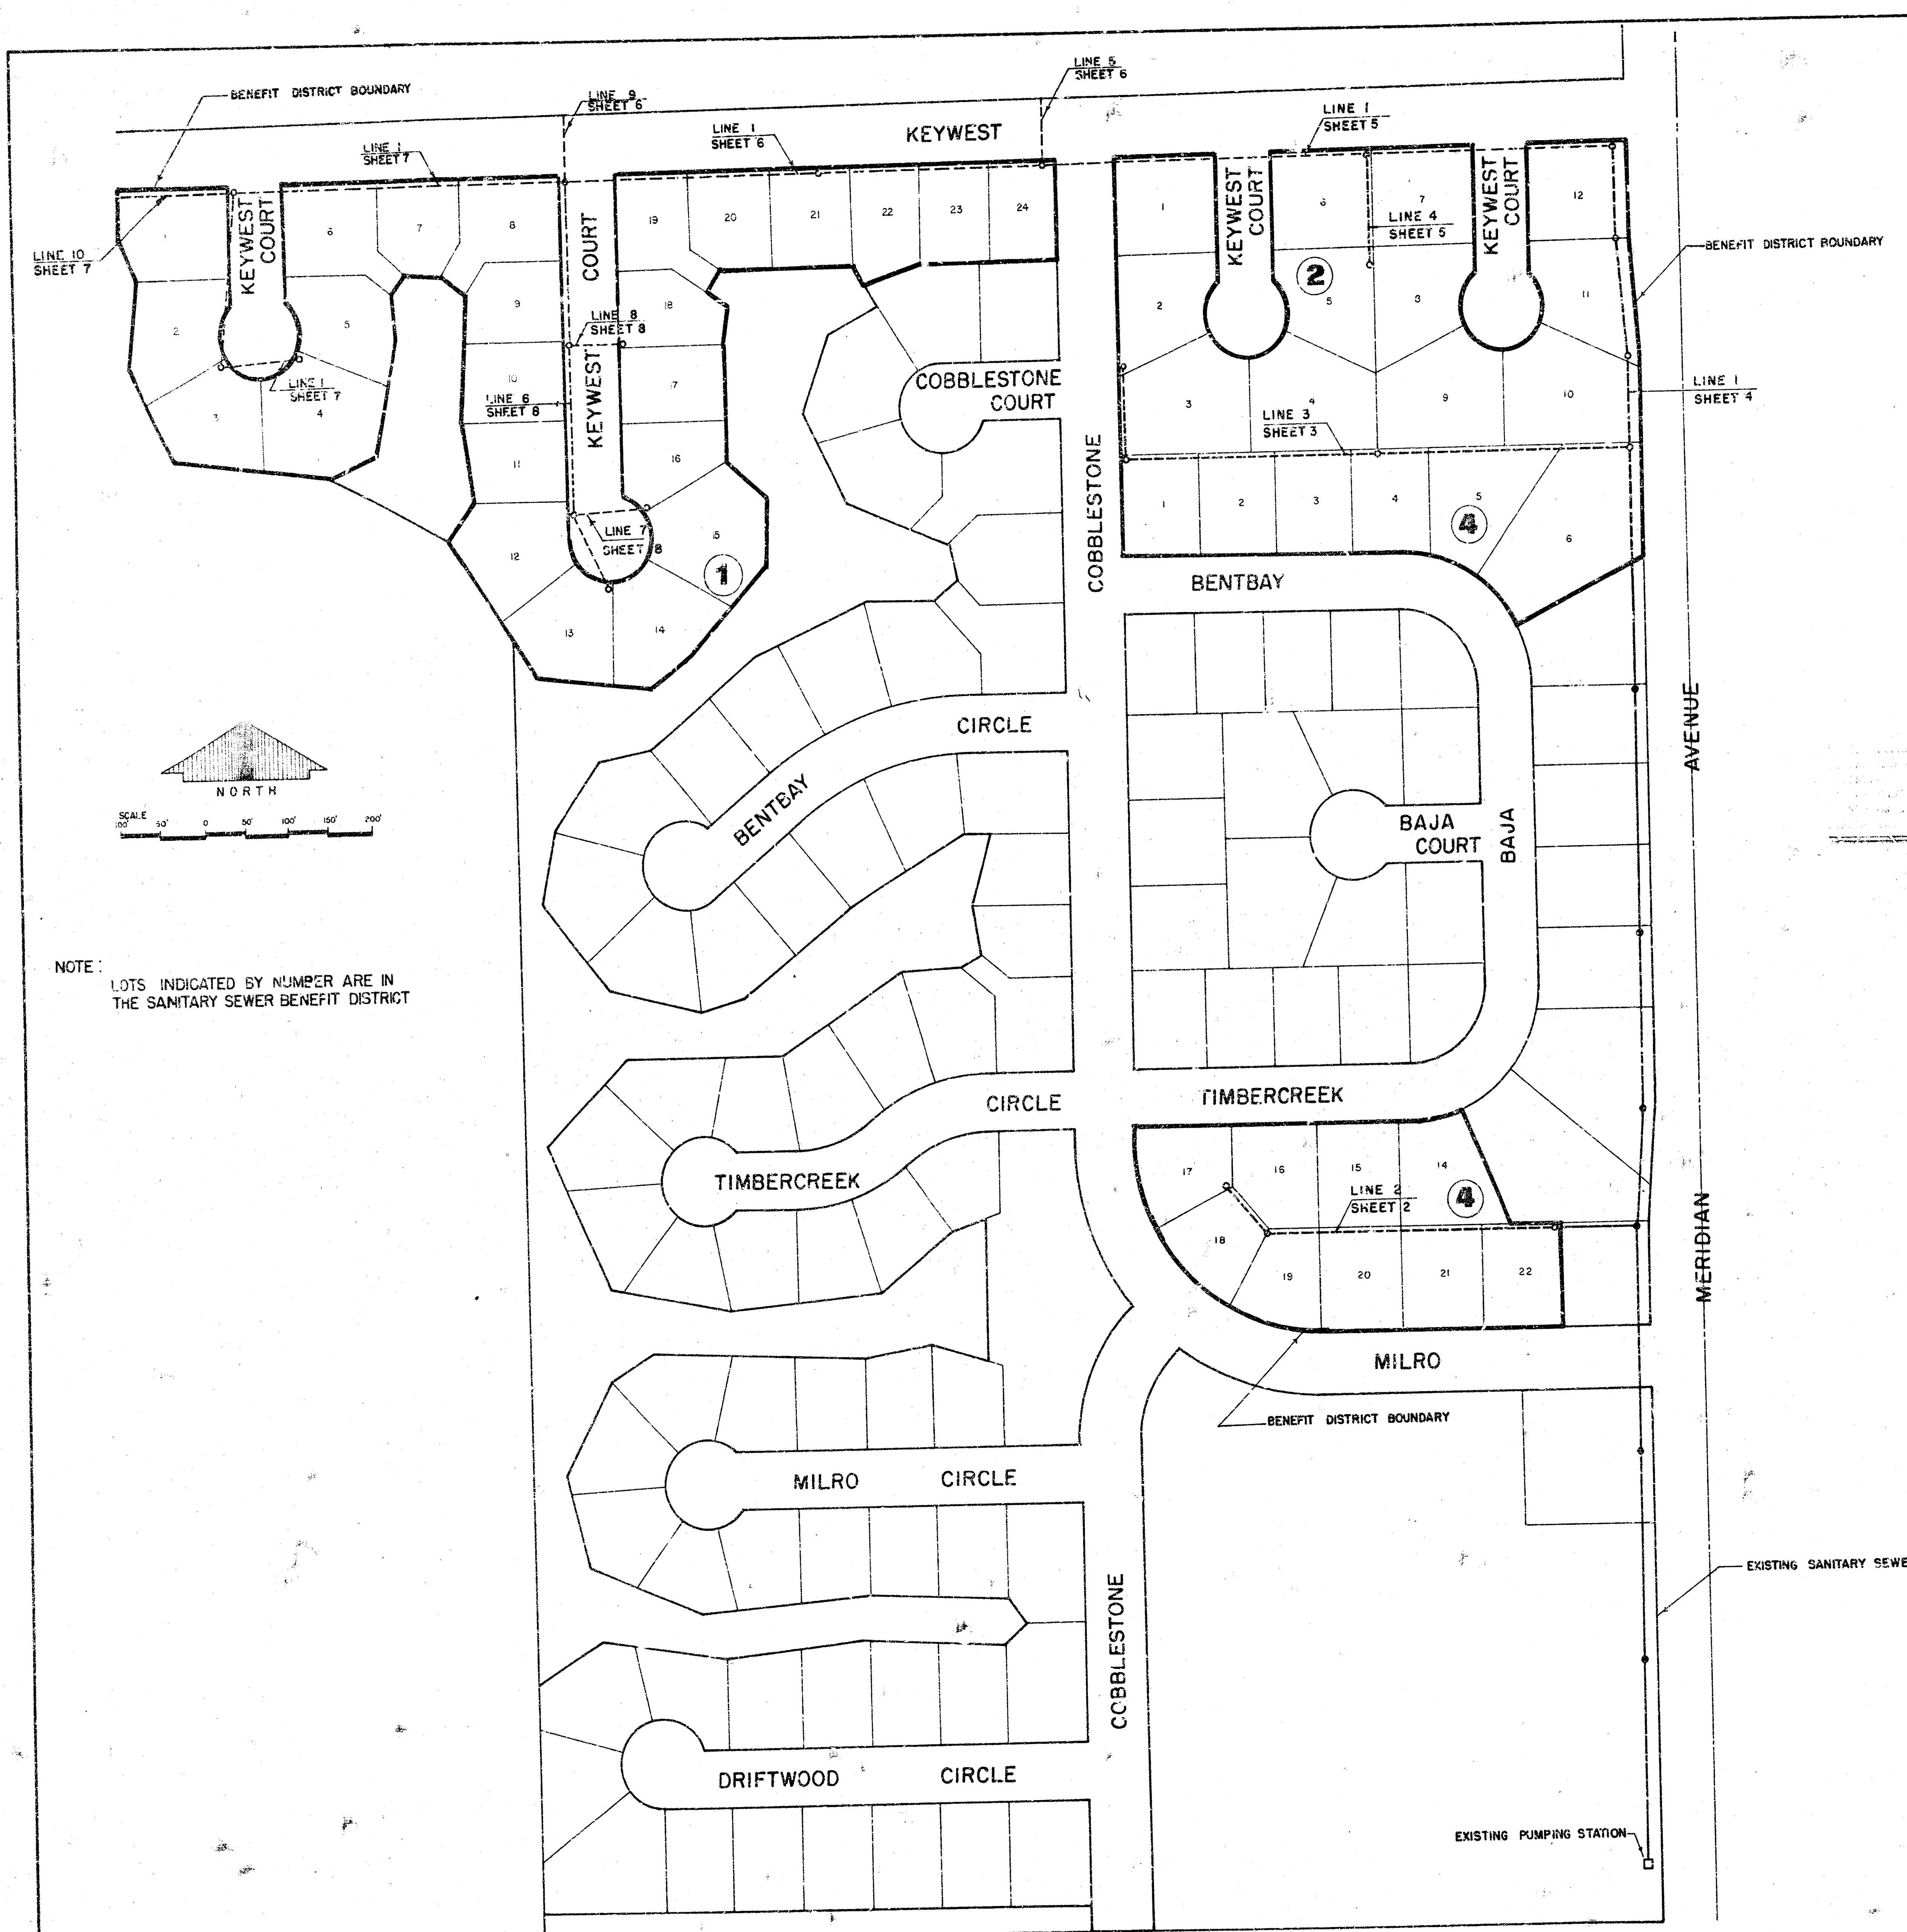



LATERAL 33, SANITARY SEWER NO. 23
 CITY OF WICHITA
 DEAN SELLERS - ACTING CITY ENGINEER
 PROJECT NO. 468-76-245-80440-000-000-001
 1980

TABLE OF CONTENTS

Line 1	Sheets	4-5-6-7
Line 2	Sheet	2
Line 3	Sheet	3
Line 4	Sheet	5
Line 5	Sheet	6
Line 6	Sheet	8
Line 7	Sheet	8
Line 8	Sheet	8
Line 9	Sheet	6
Line 10	Sheet	7
Vertical Riser Detail	Sheet	10
Paving Detail	Sheet	9

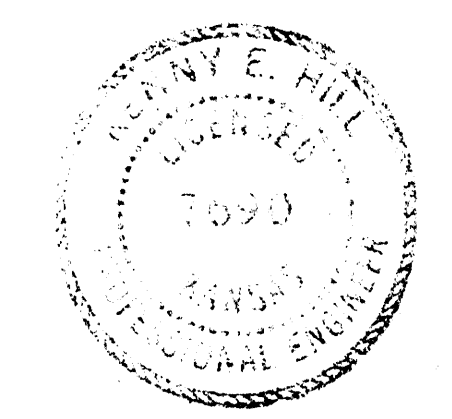

Revised 4/80
 6/8

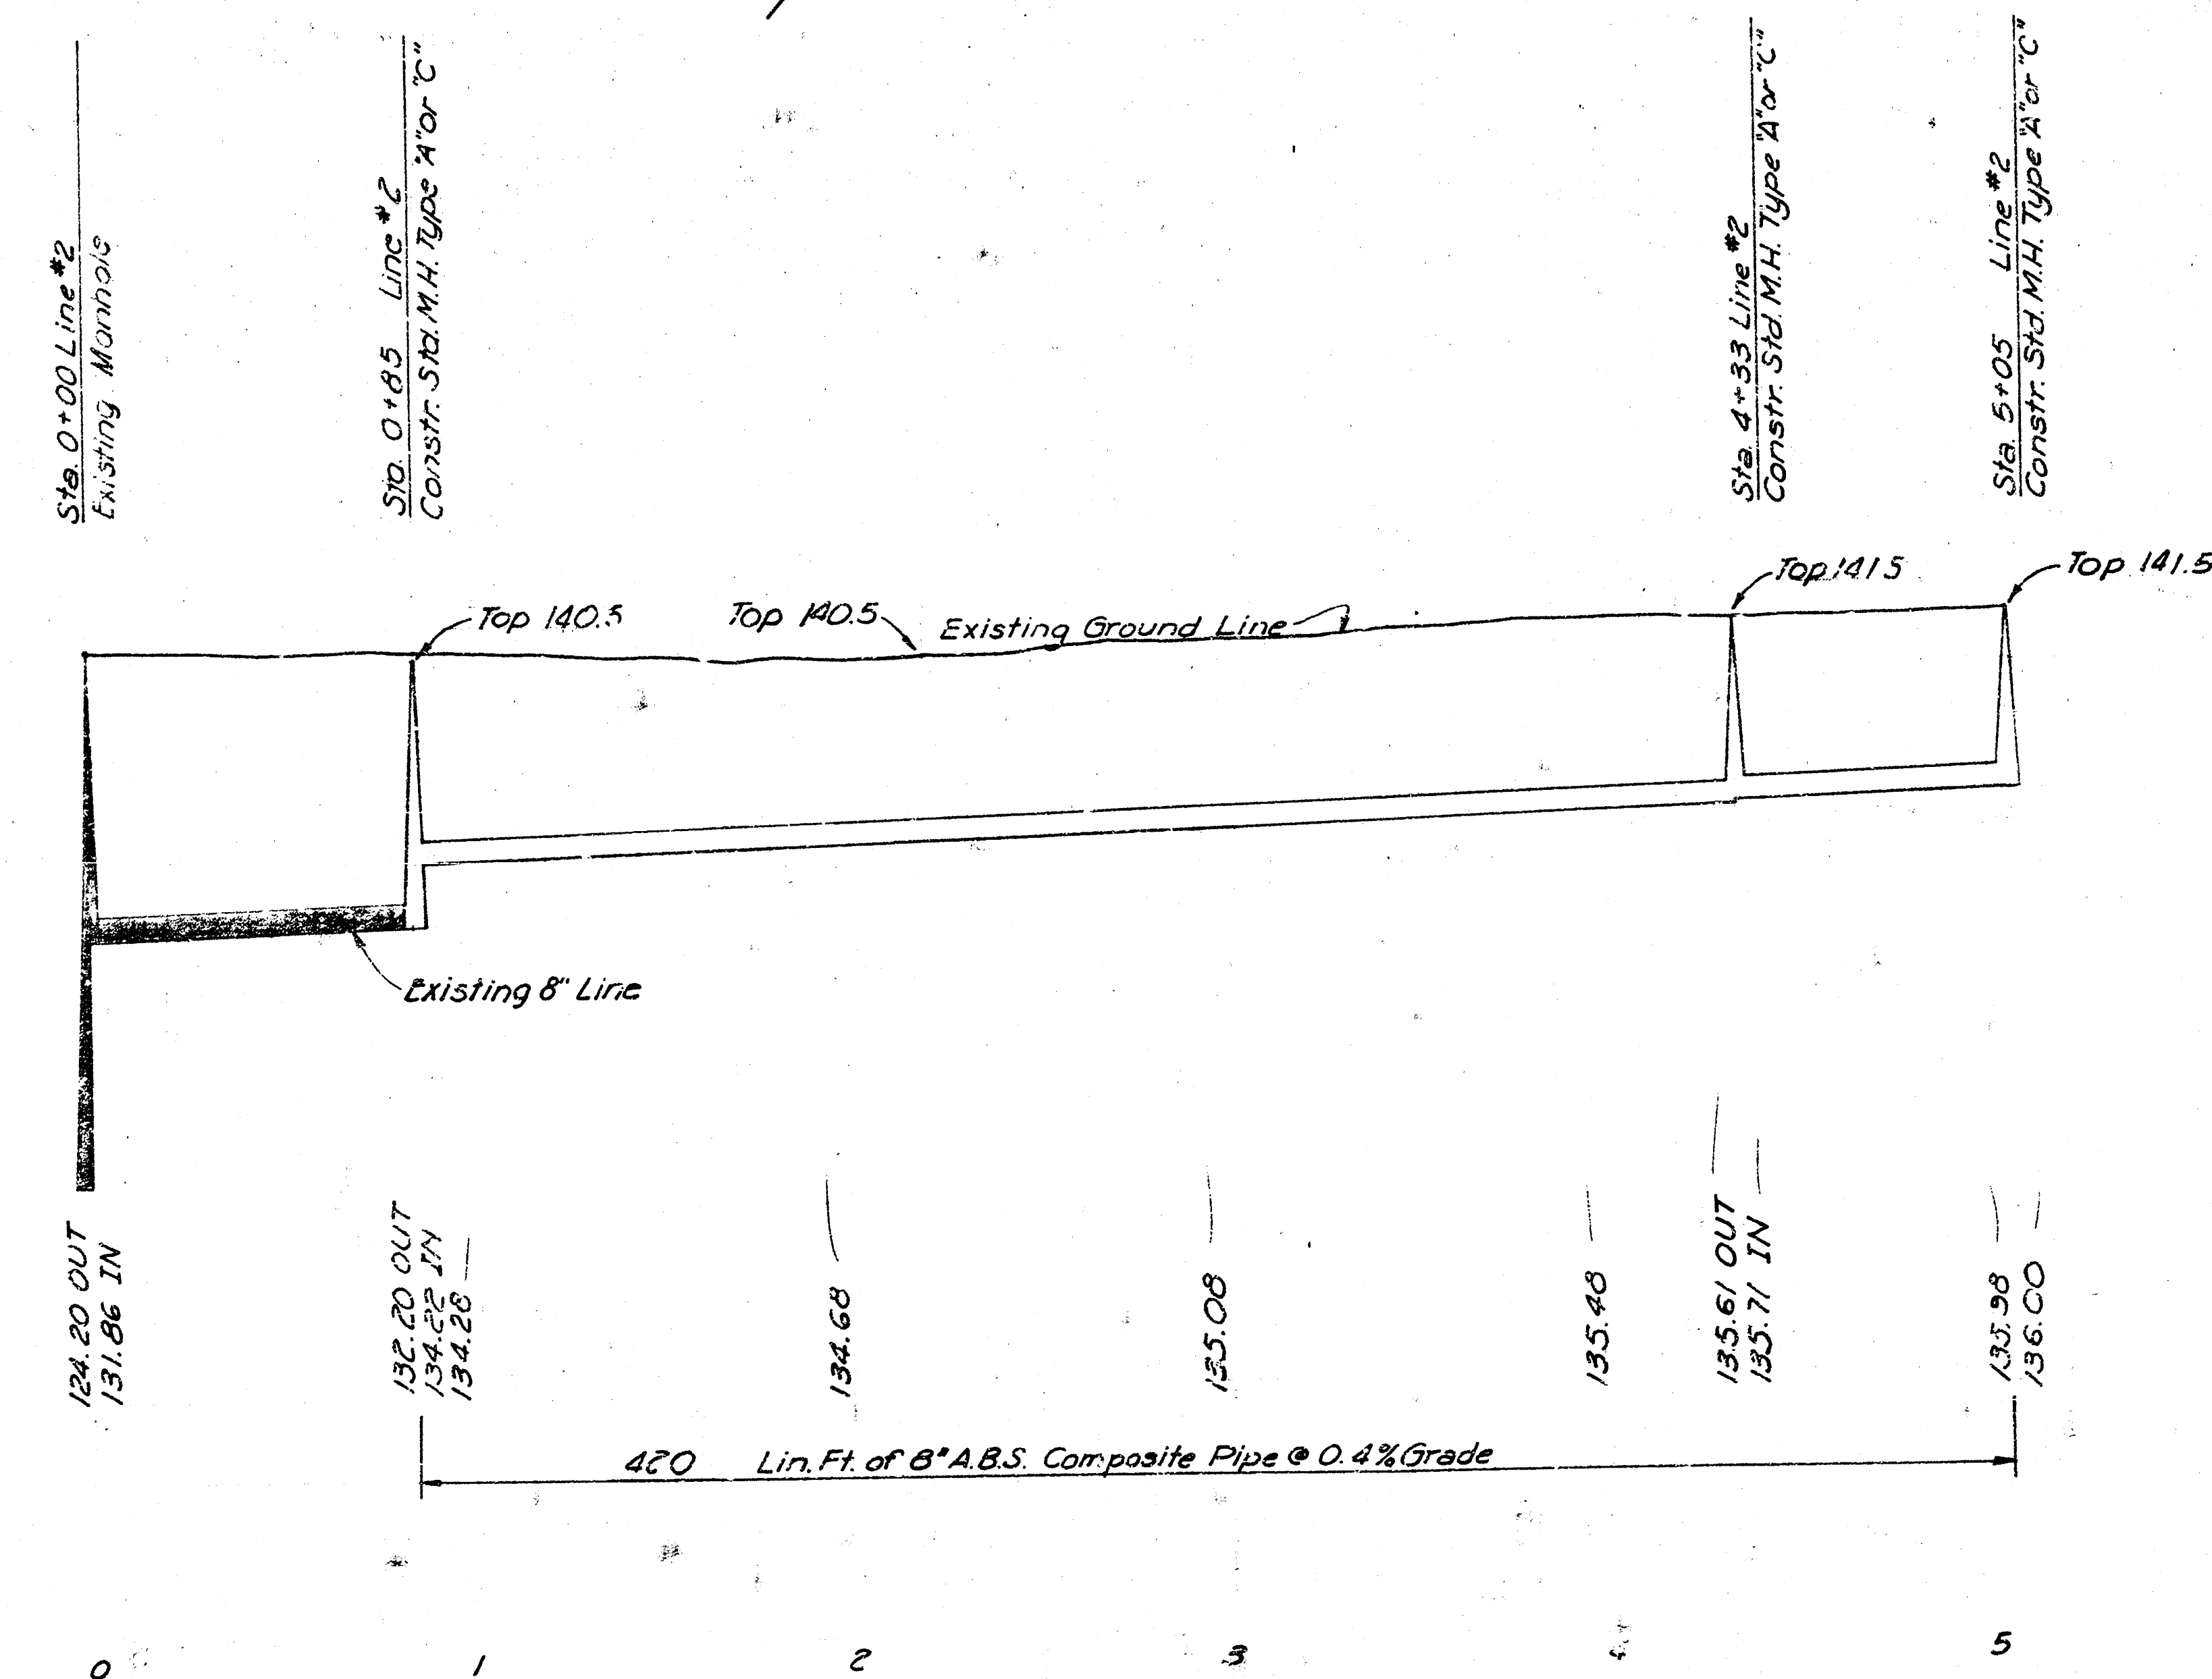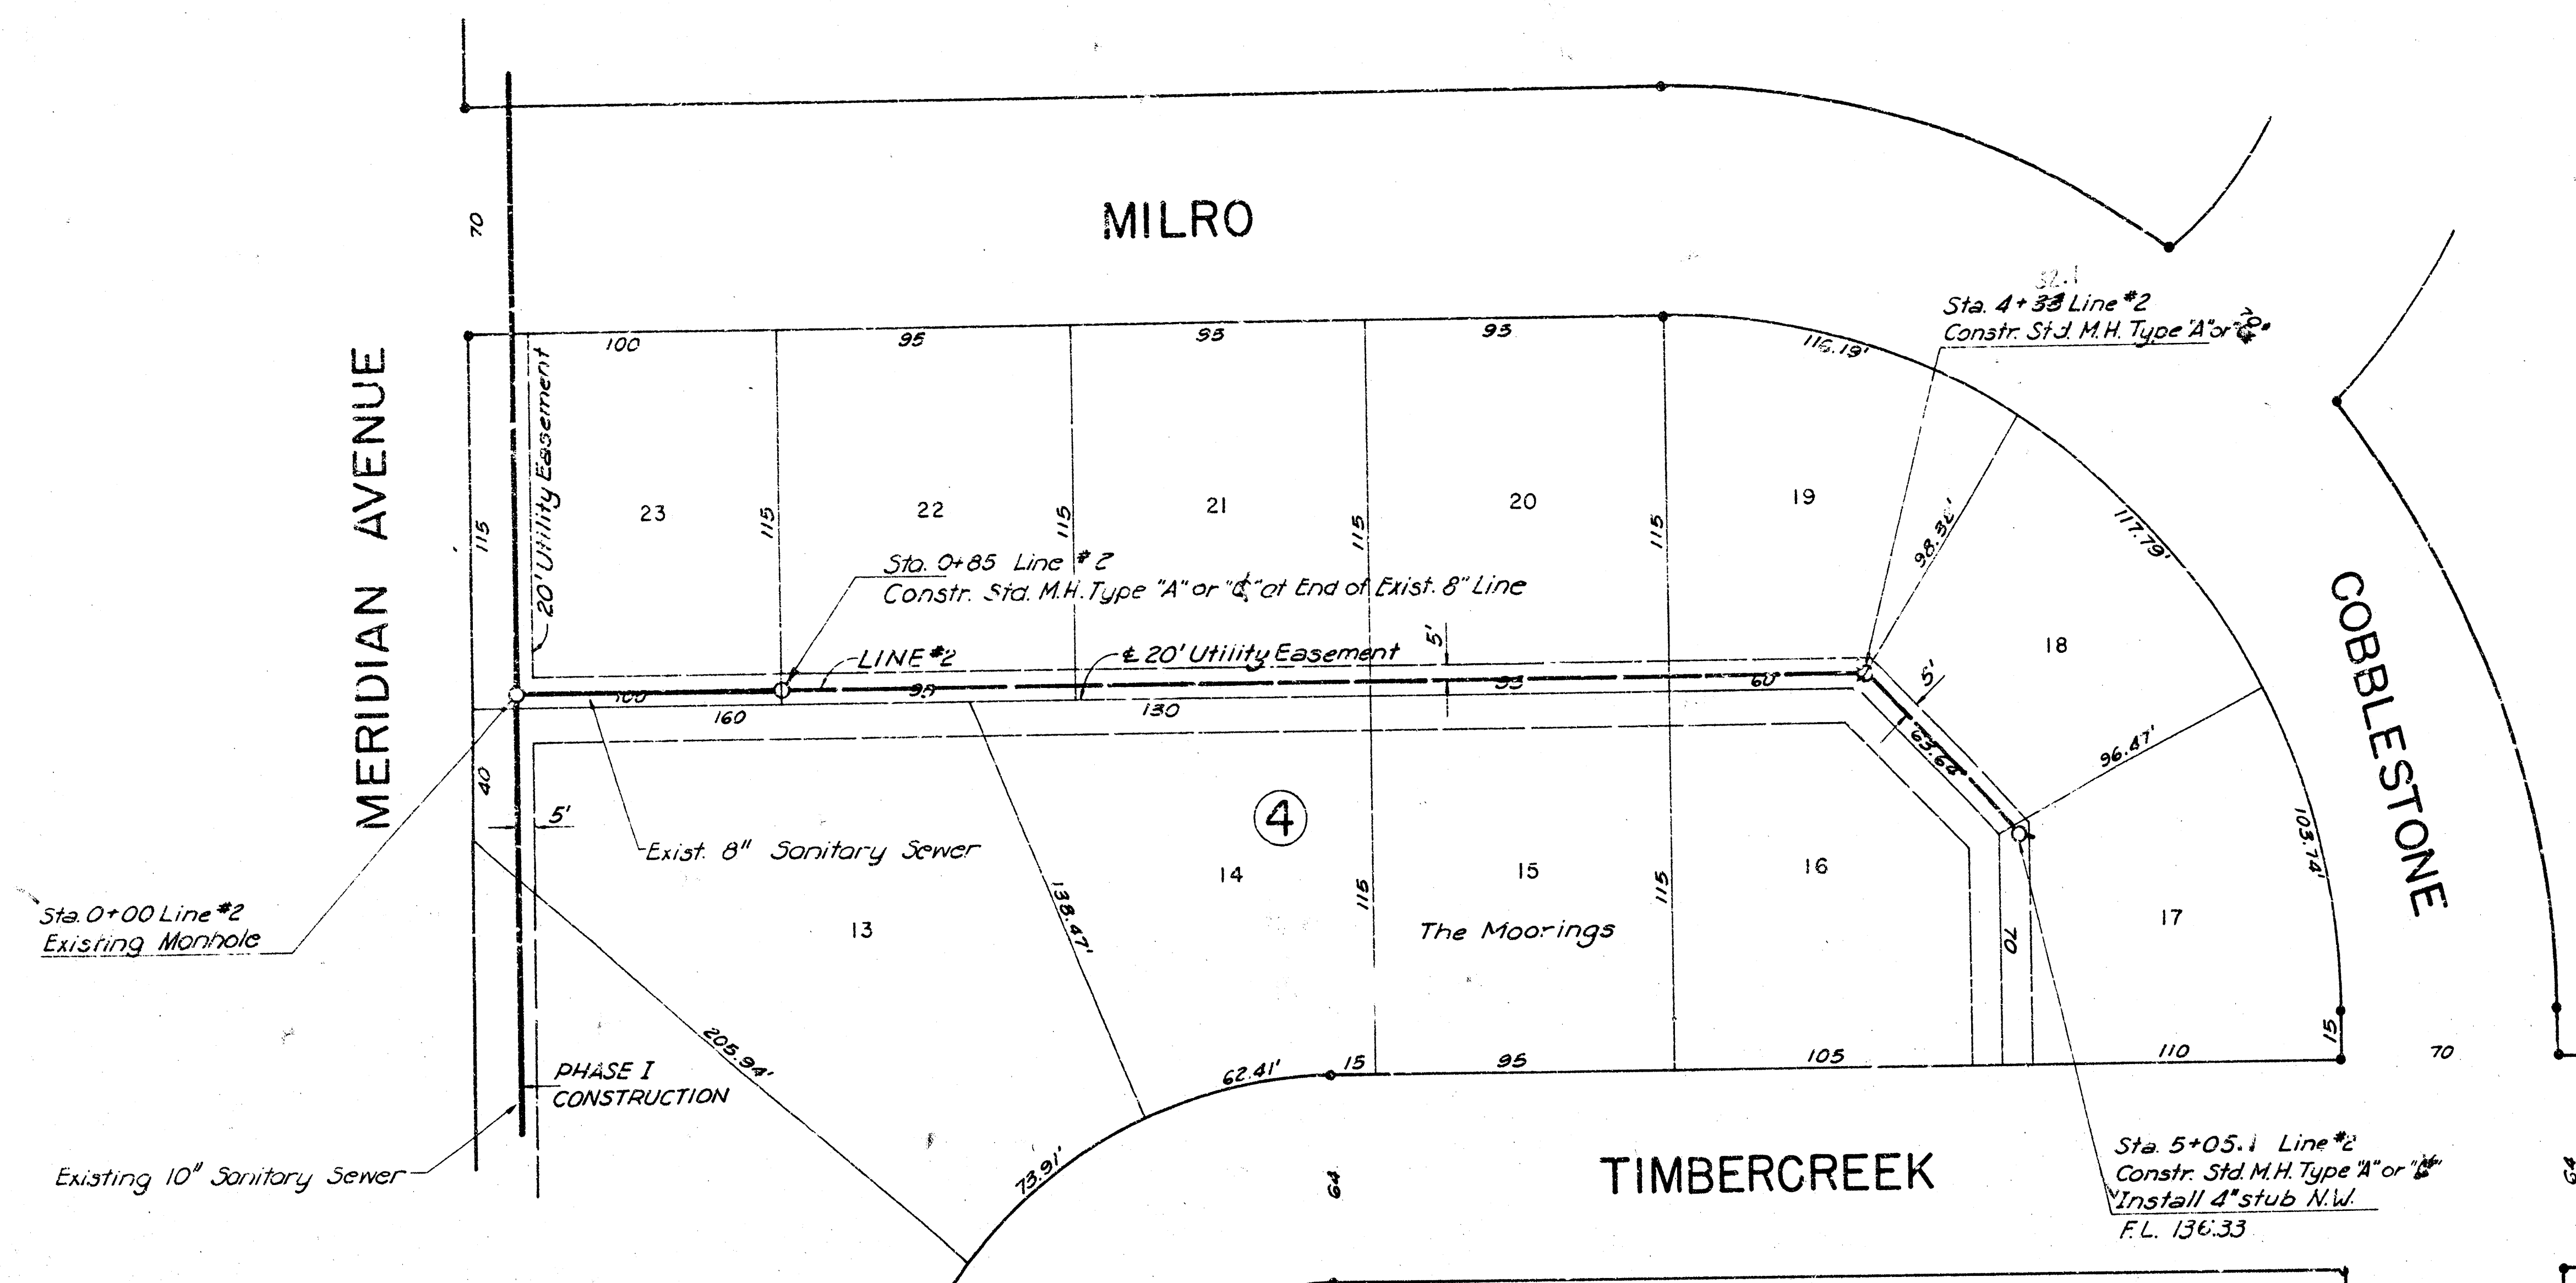


LAT. 33 S. 23
CITY OF WICHITA, KANSAS
DEAN SELLERS — ACTING CITY ENGINEER
PROJECT NO. 468-76-245-80440-000-000-001

2/0

MERIDIAN AVENUE

BENTBAY

COBBLESTONE

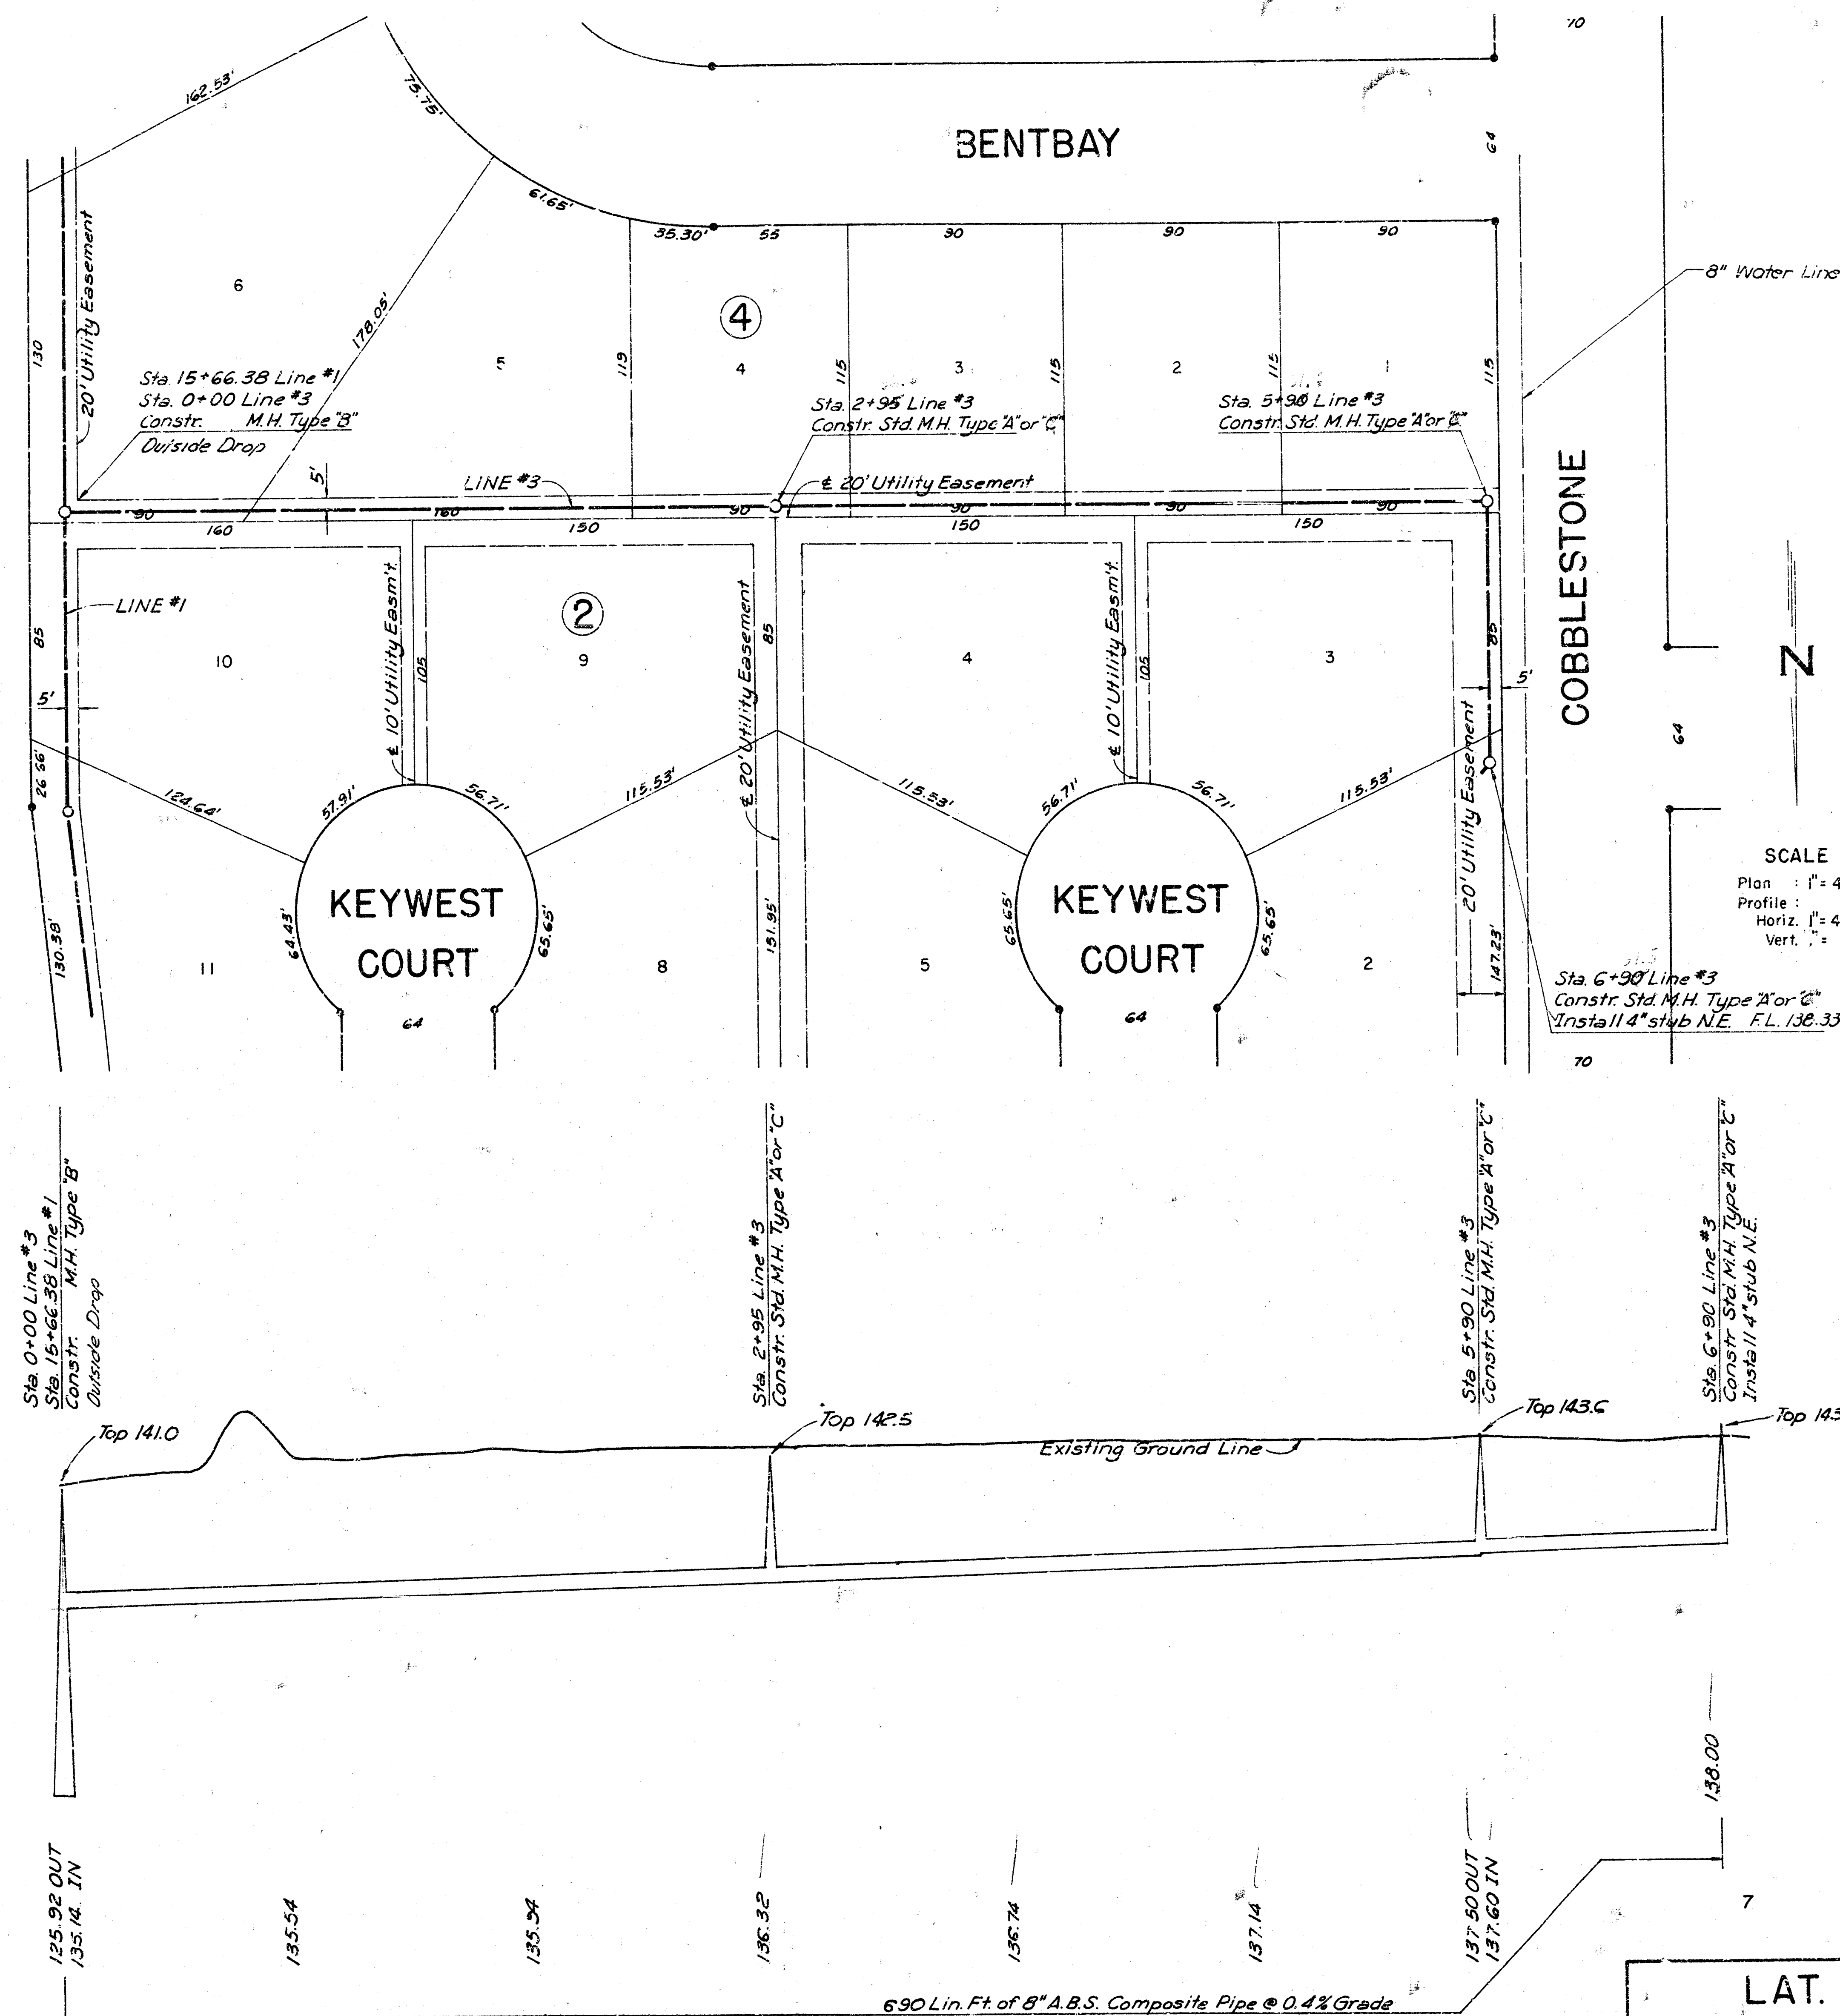


LAT. 33 S. S. # 23


CITY OF WICHITA, KANSAS
DEAN SELLERS — ACTING CITY ENGINEER

PROJECT NO. 468-75-245-80440-000-000-001


3/0

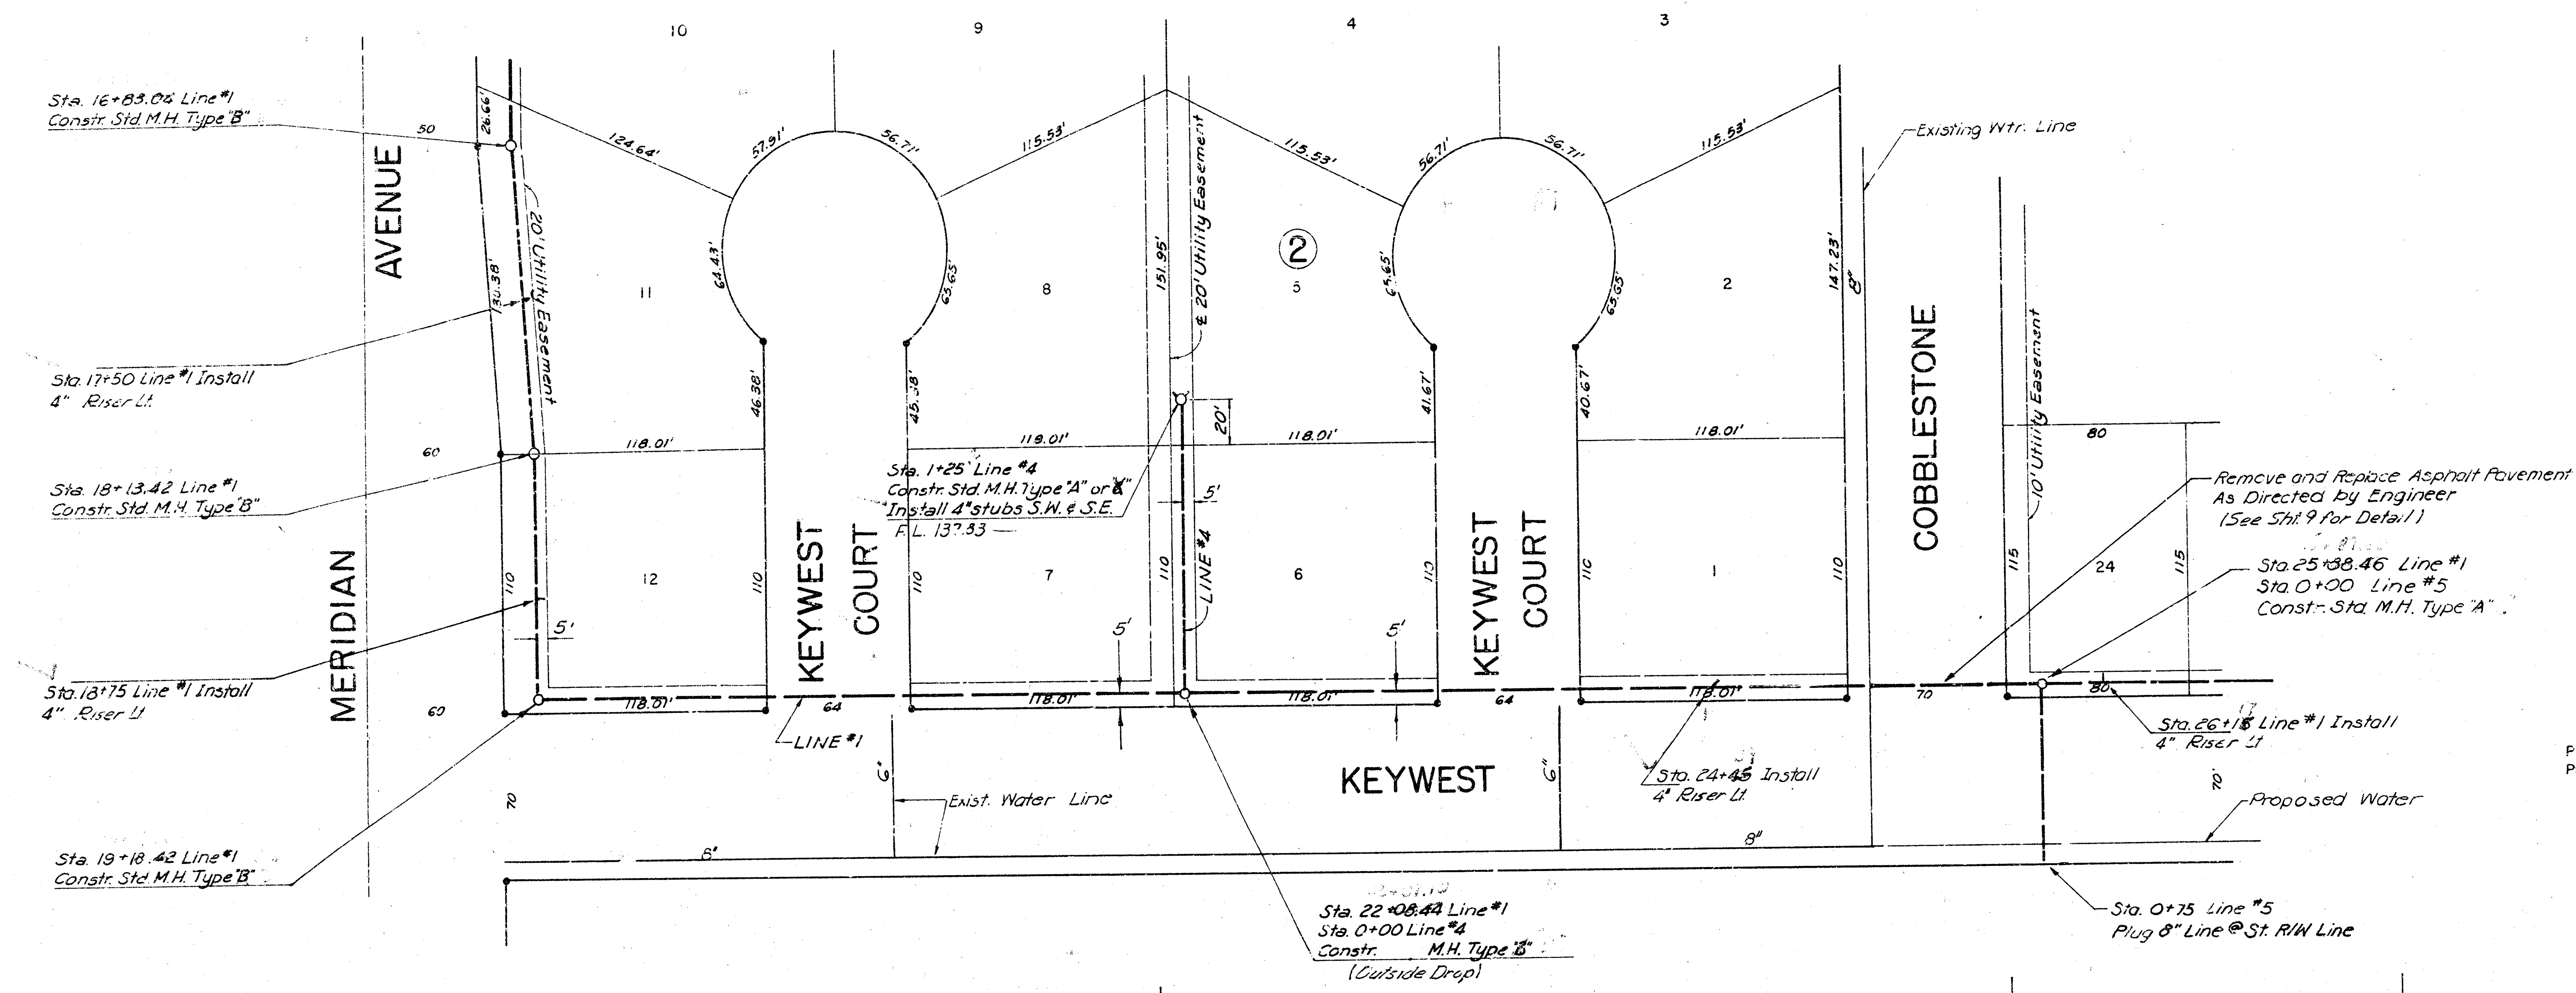

SCALE
 Plan : 1"=40'
 Profile : 1"=40'
 Horiz. 1"=40'
 Vert. 1"=5'

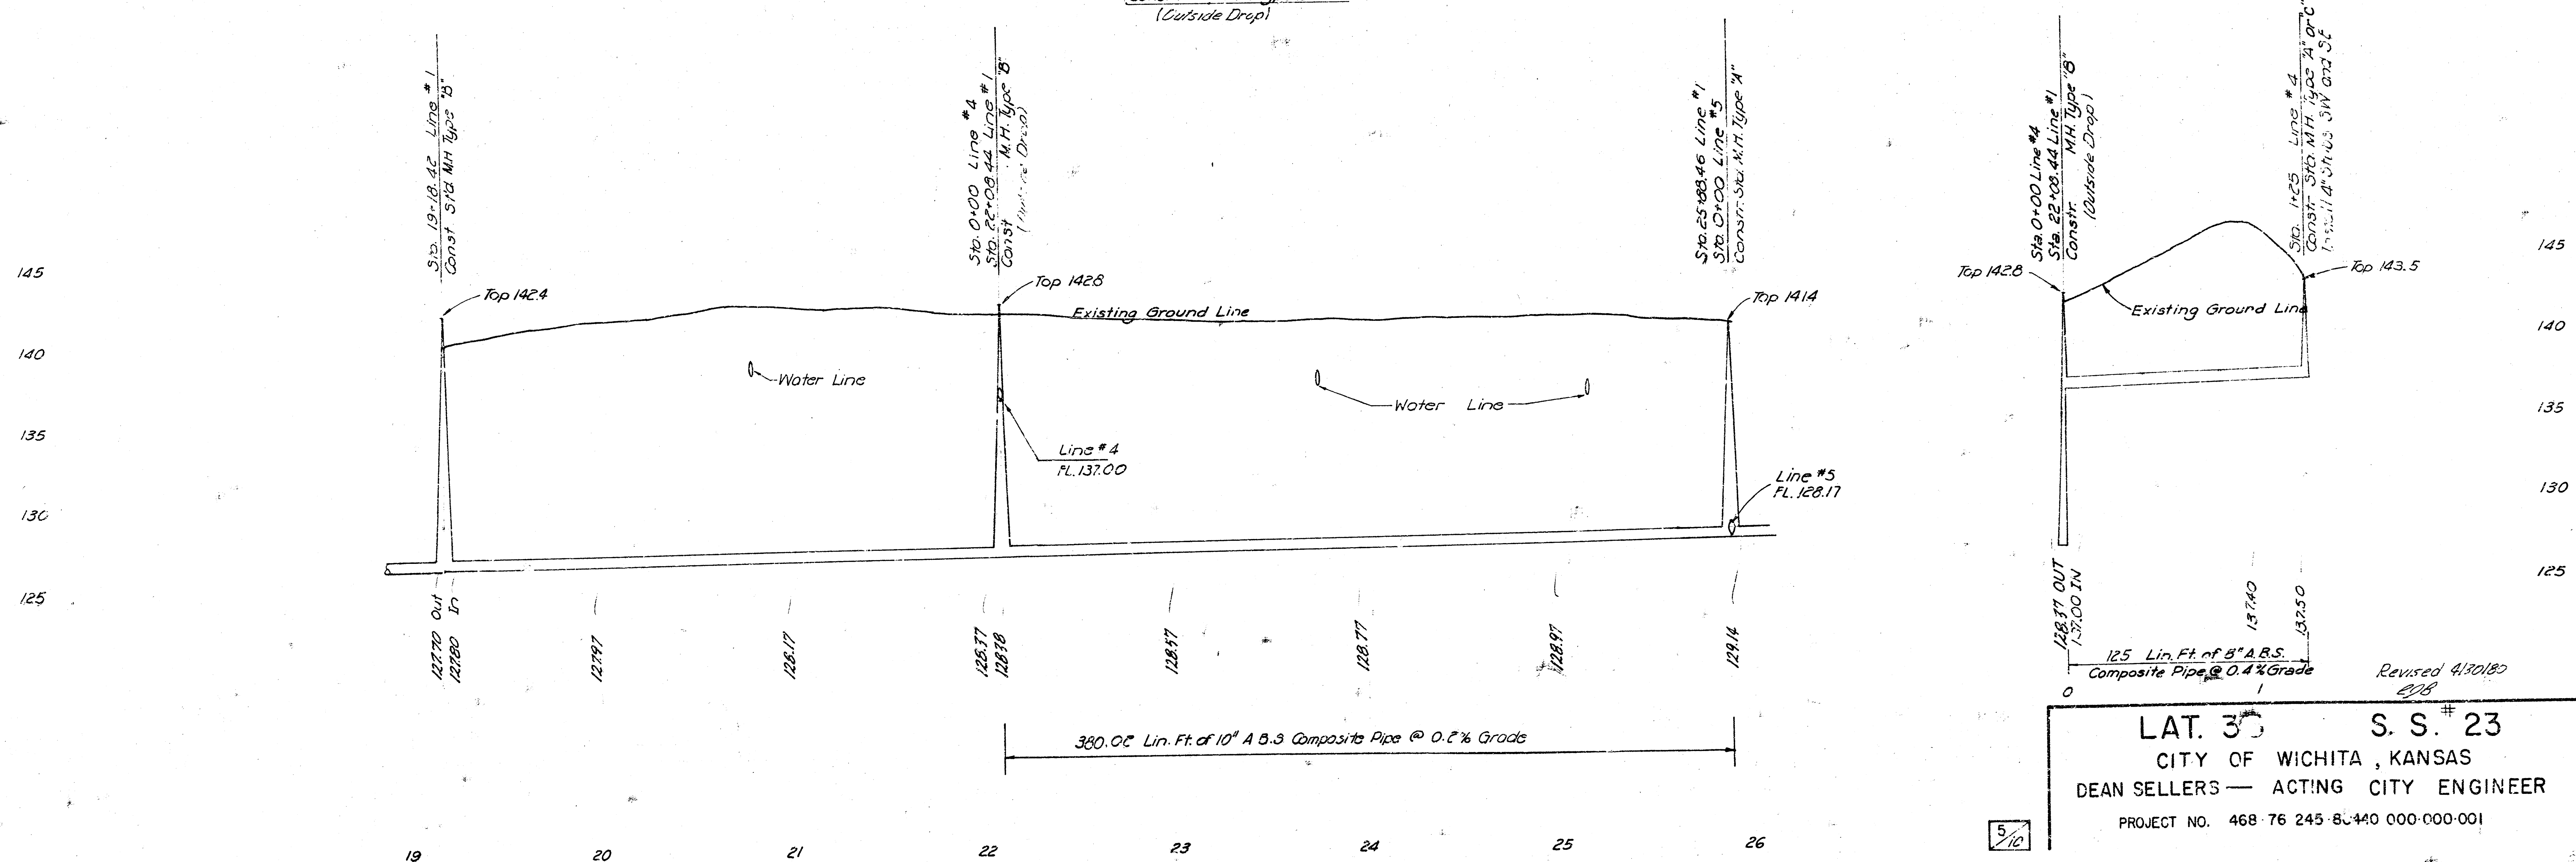


LAT. 35 S. S. # 23
CITY OF WICHITA, KANSAS
DEAN SELLERS — ACTING CITY ENGINEER
 PROJECT NO. 468-76-245-B-440-000-000-001

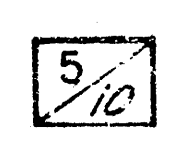


Note:
The Top of all Riser Pipes to be at Elev. 135.0.
Risers to be installed only where indicated.


B.M. 141.07 $\square$ in South Headwall, Culvert
at 45th Street North and Meridian.

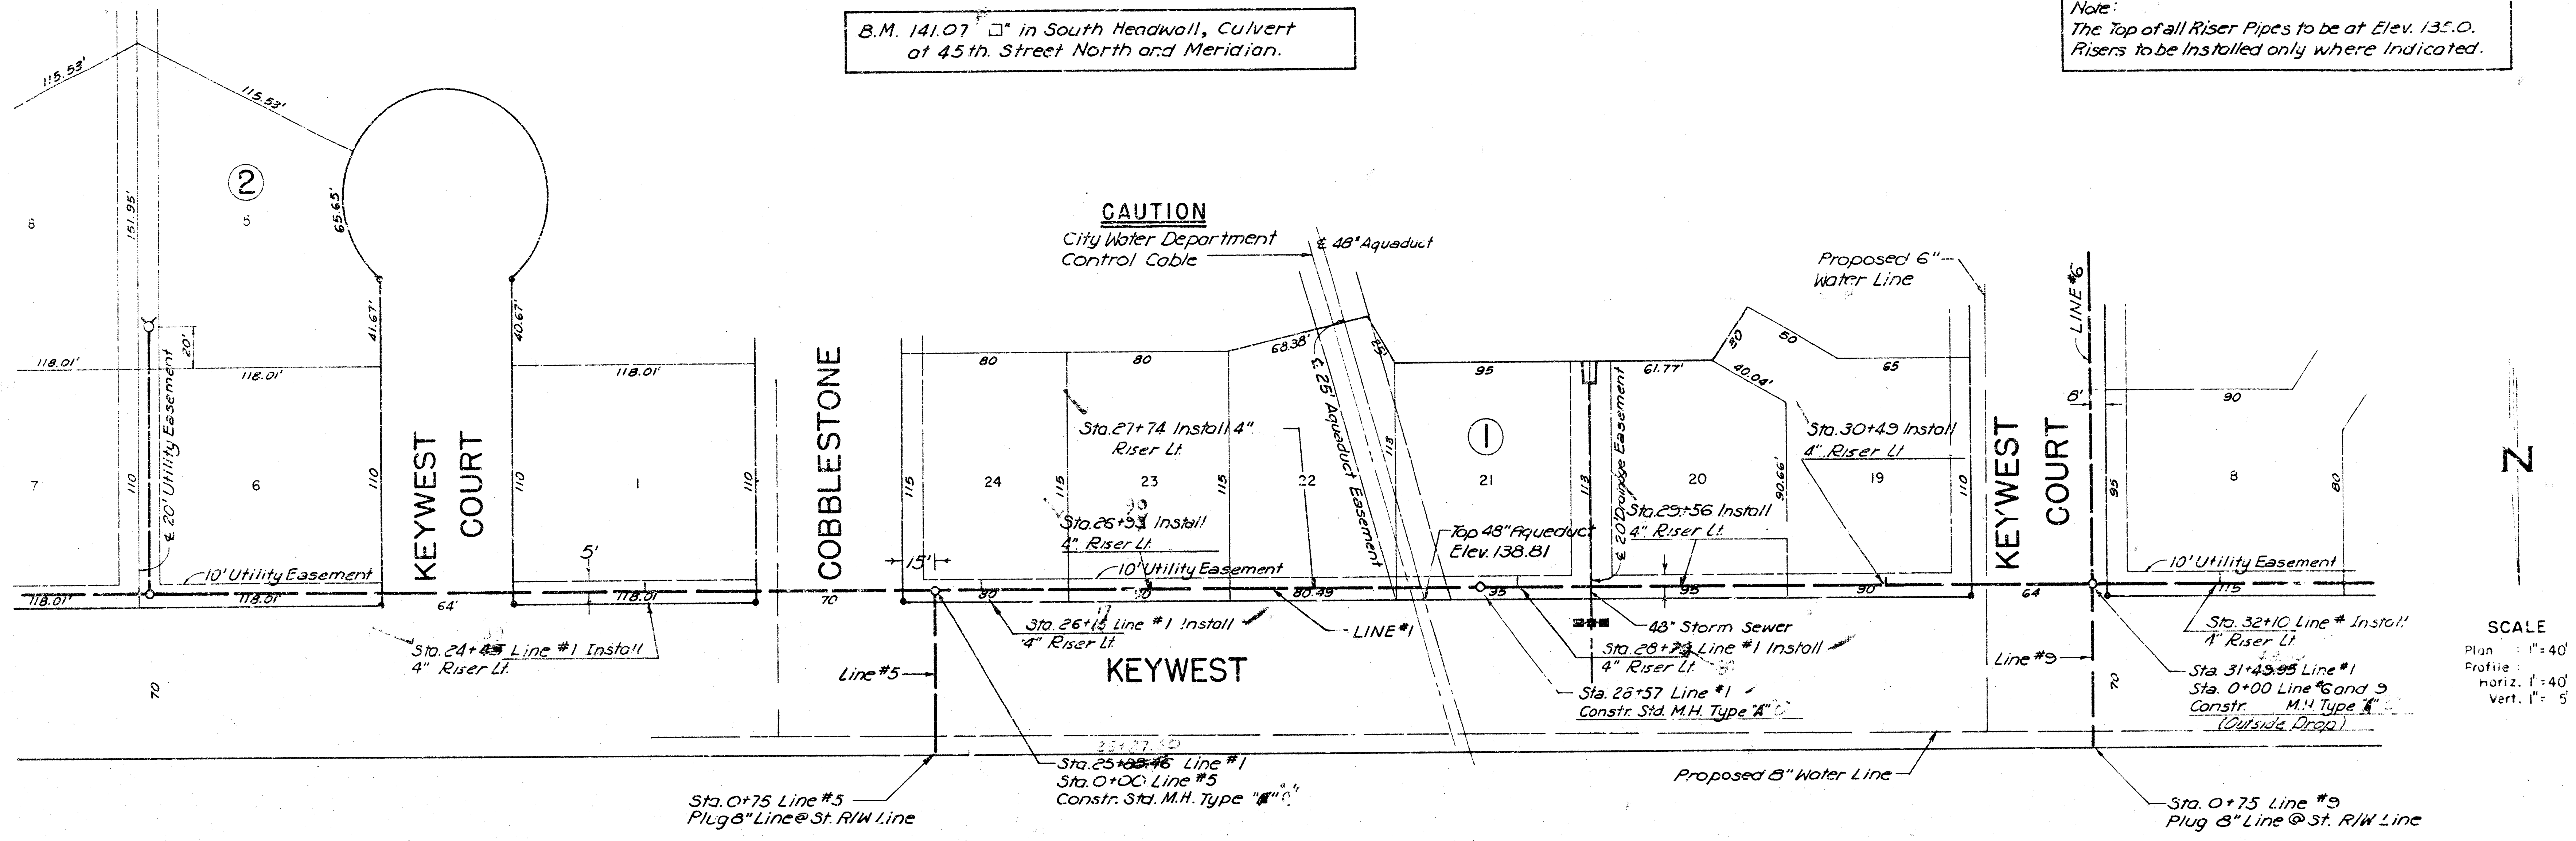


SCALE
Plan : 1" = 40'
Profile : 1" = 40'
Horiz. : 1" = 40'
Vert. : 1" = 5'

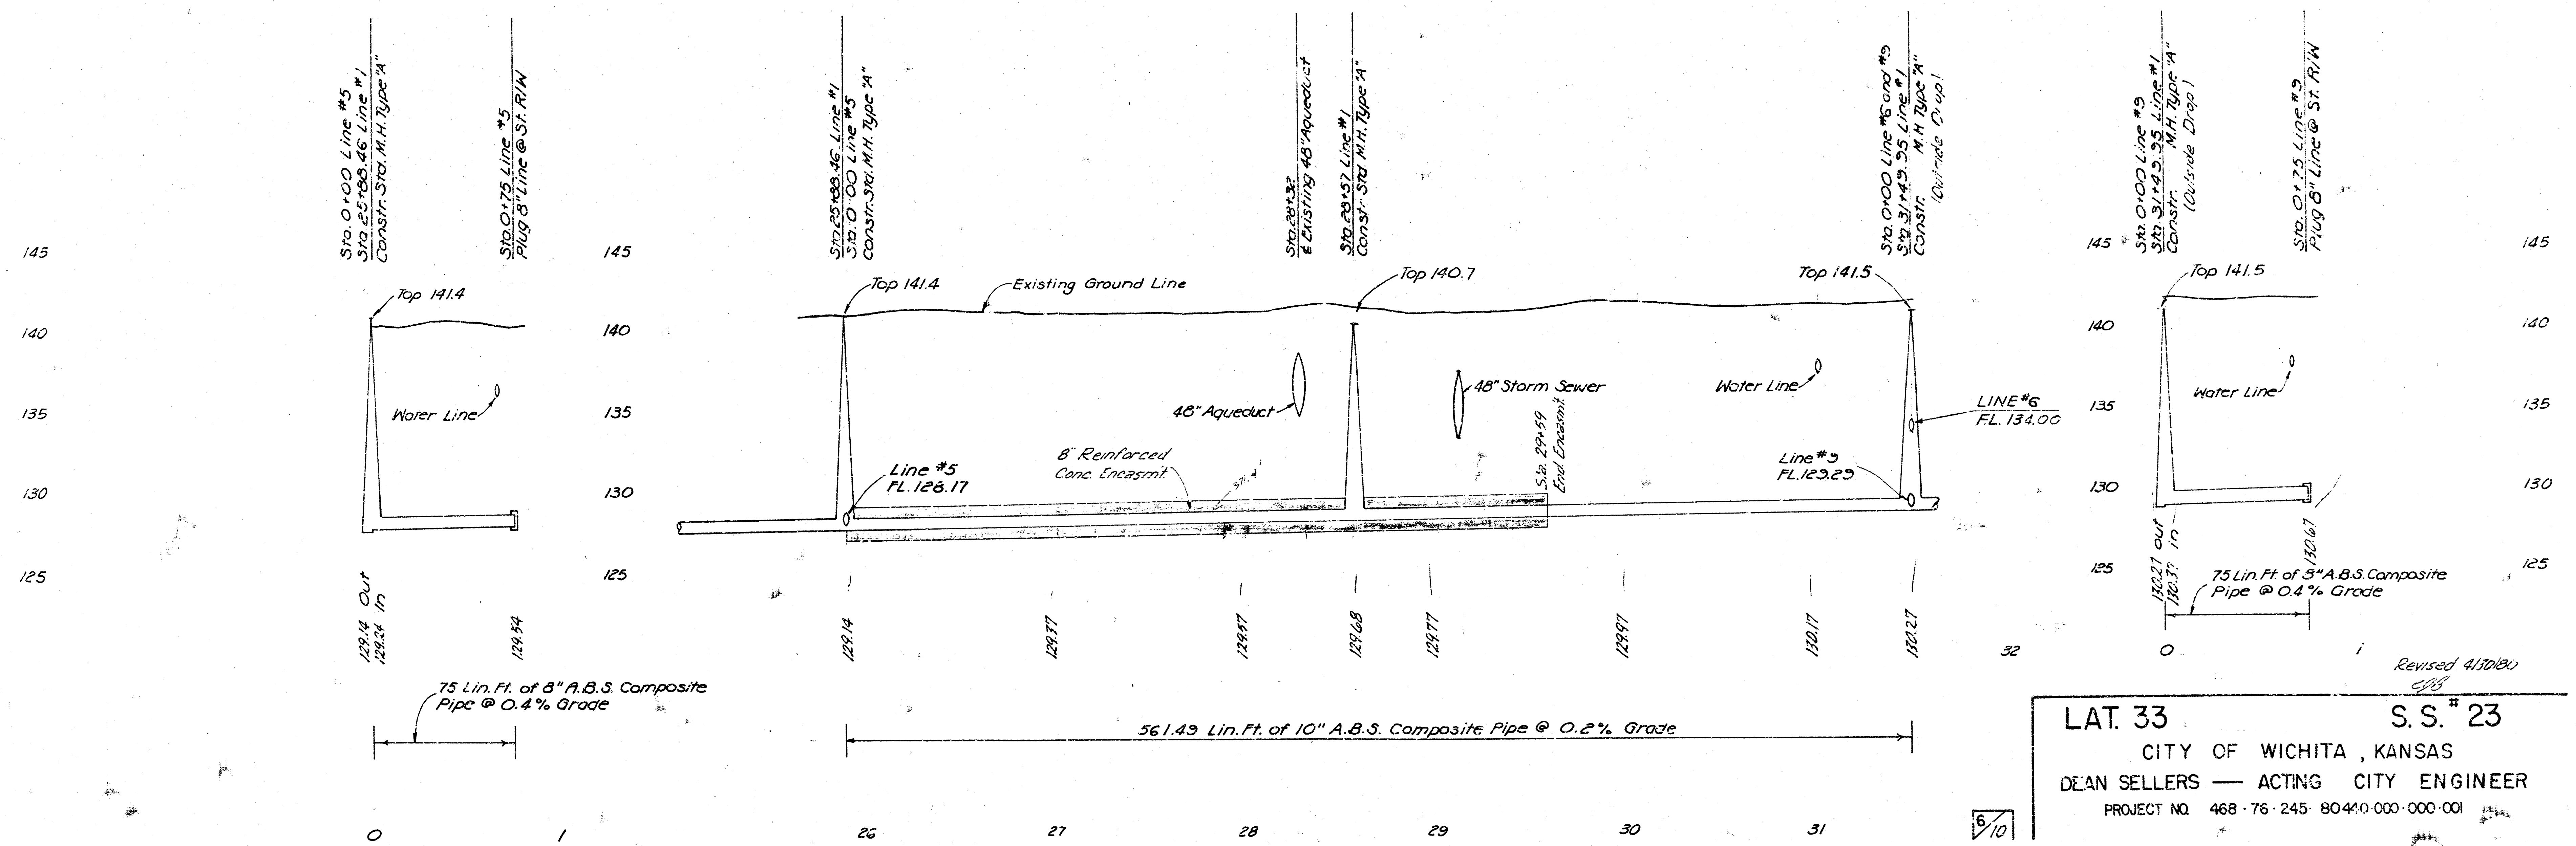


LAT. 33 S.S. # 23
CITY OF WICHITA, KANSAS
DEAN SELLERS — ACTING CITY ENGINEER
PROJECT NO. 468-76-245-80410-000-000-001
6/10

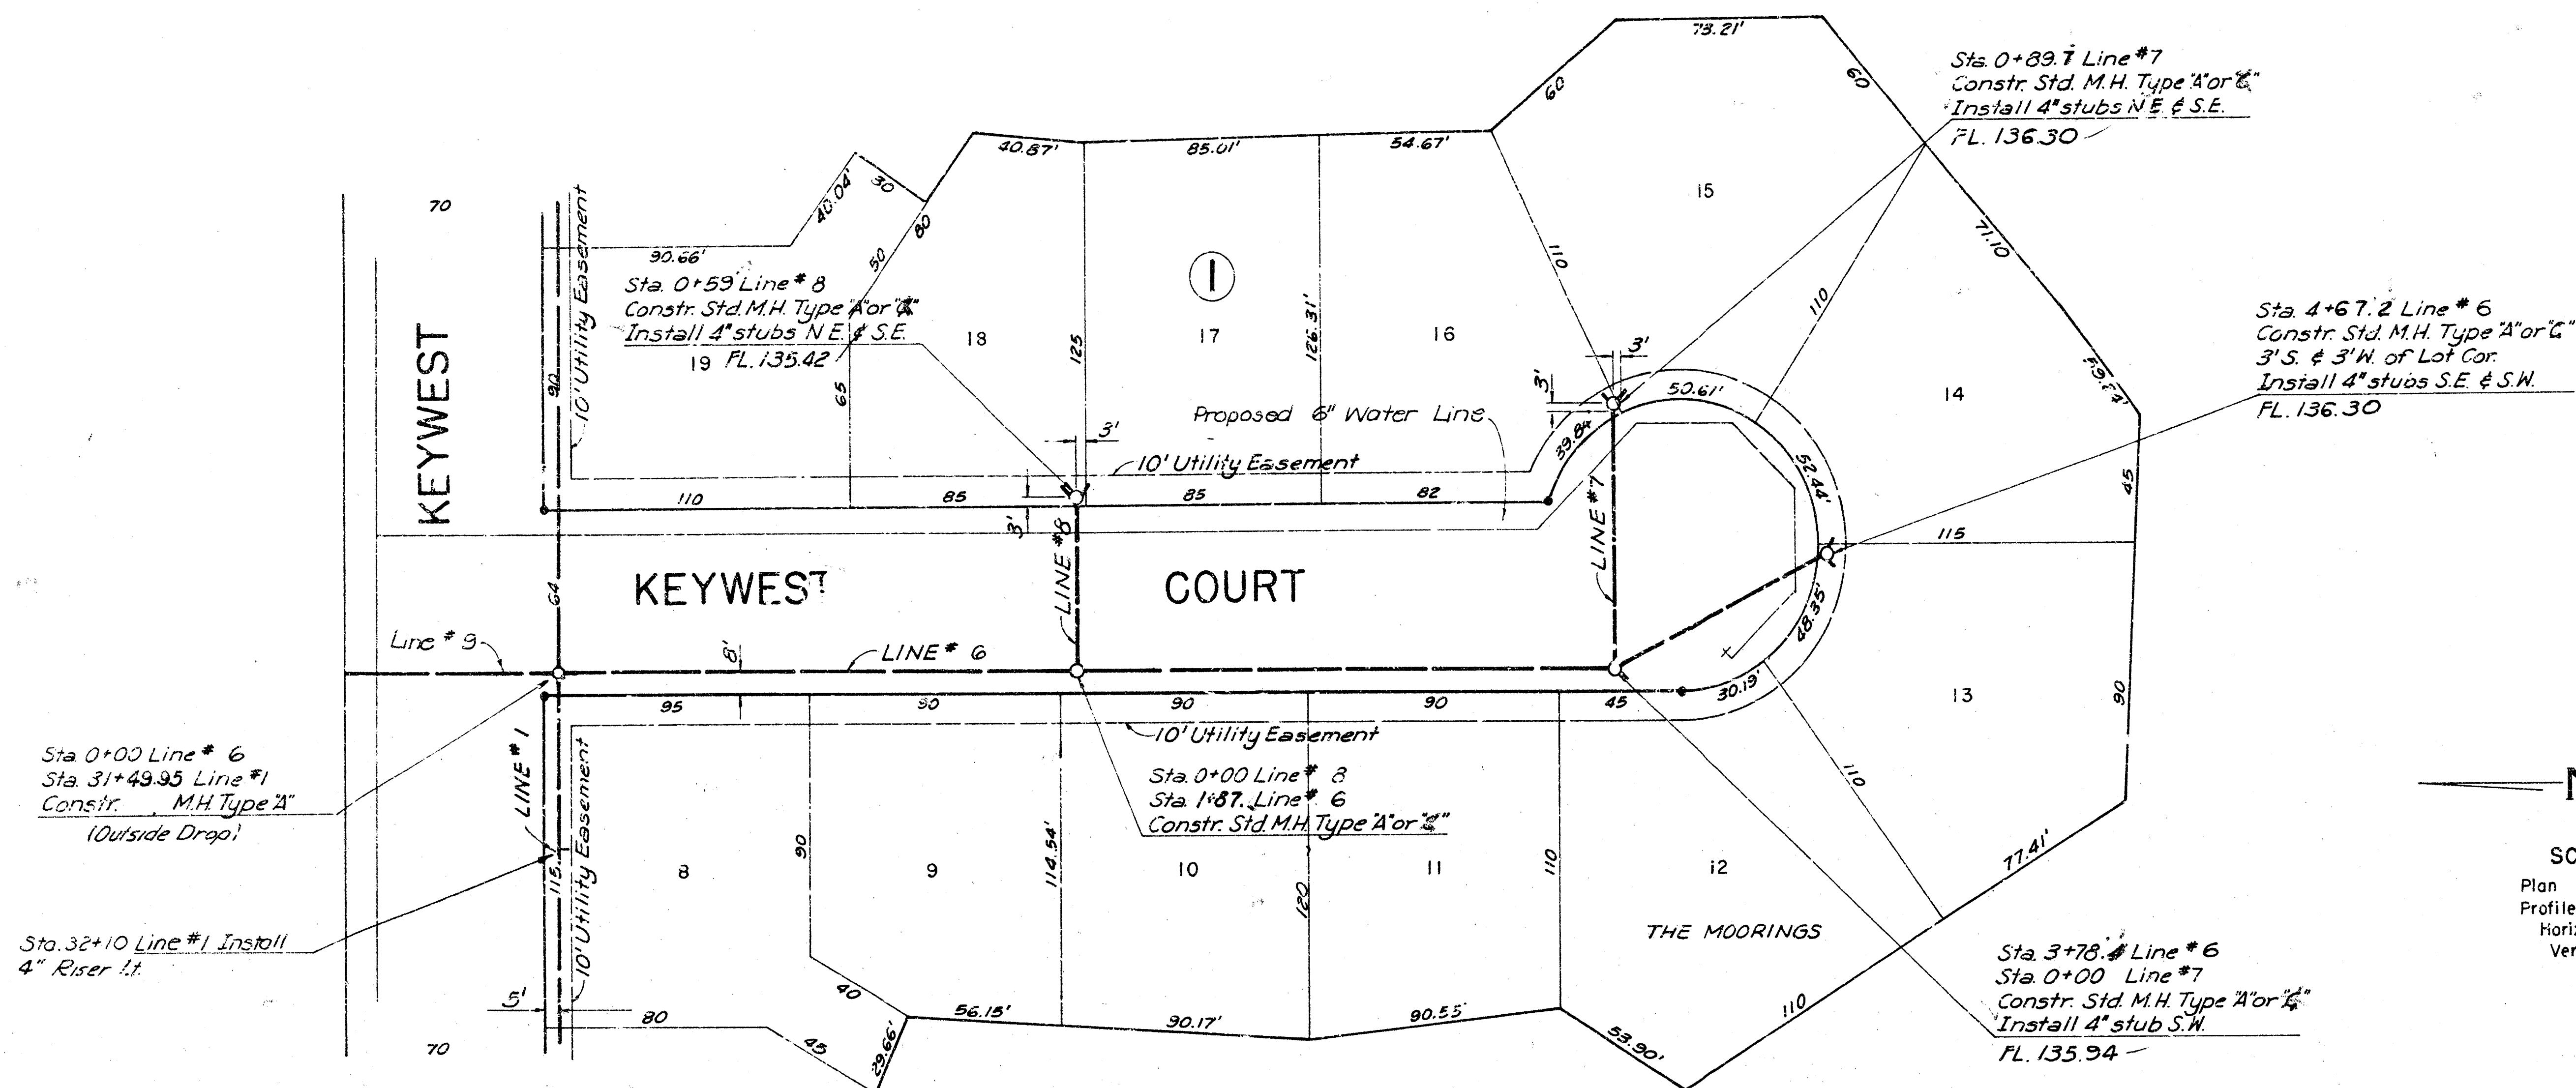

SCALE
 Plan : 1" = 40'
 Profile : 1" = 40'
 Horiz. : 1" = 40'
 Vert. : 1" = 5'

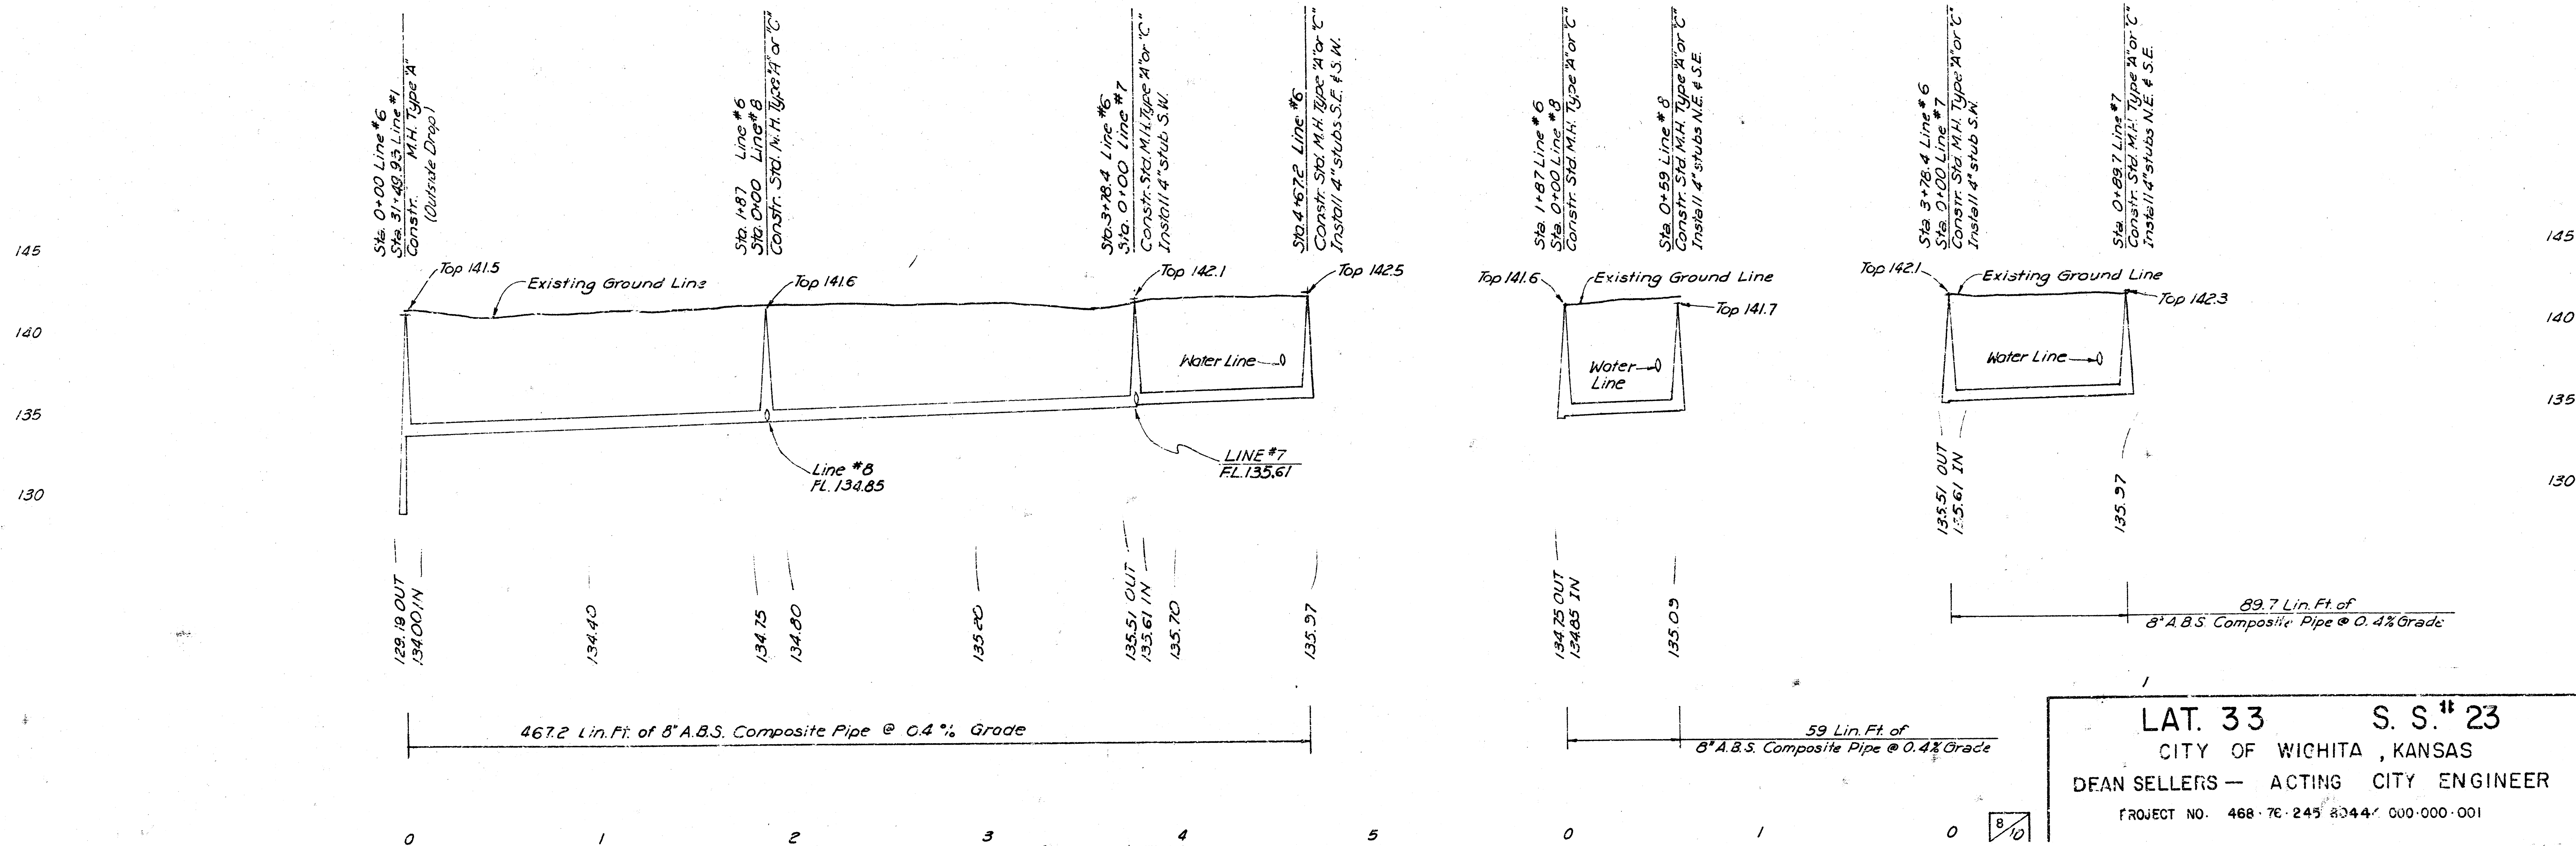

LAT. 33 S. S. 23
 CITY OF WICHITA, KANSAS
 DEAN SELLERS — ACTING CITY ENGINEER
 PROJECT NO. 468-76-245-2344-000-000-001

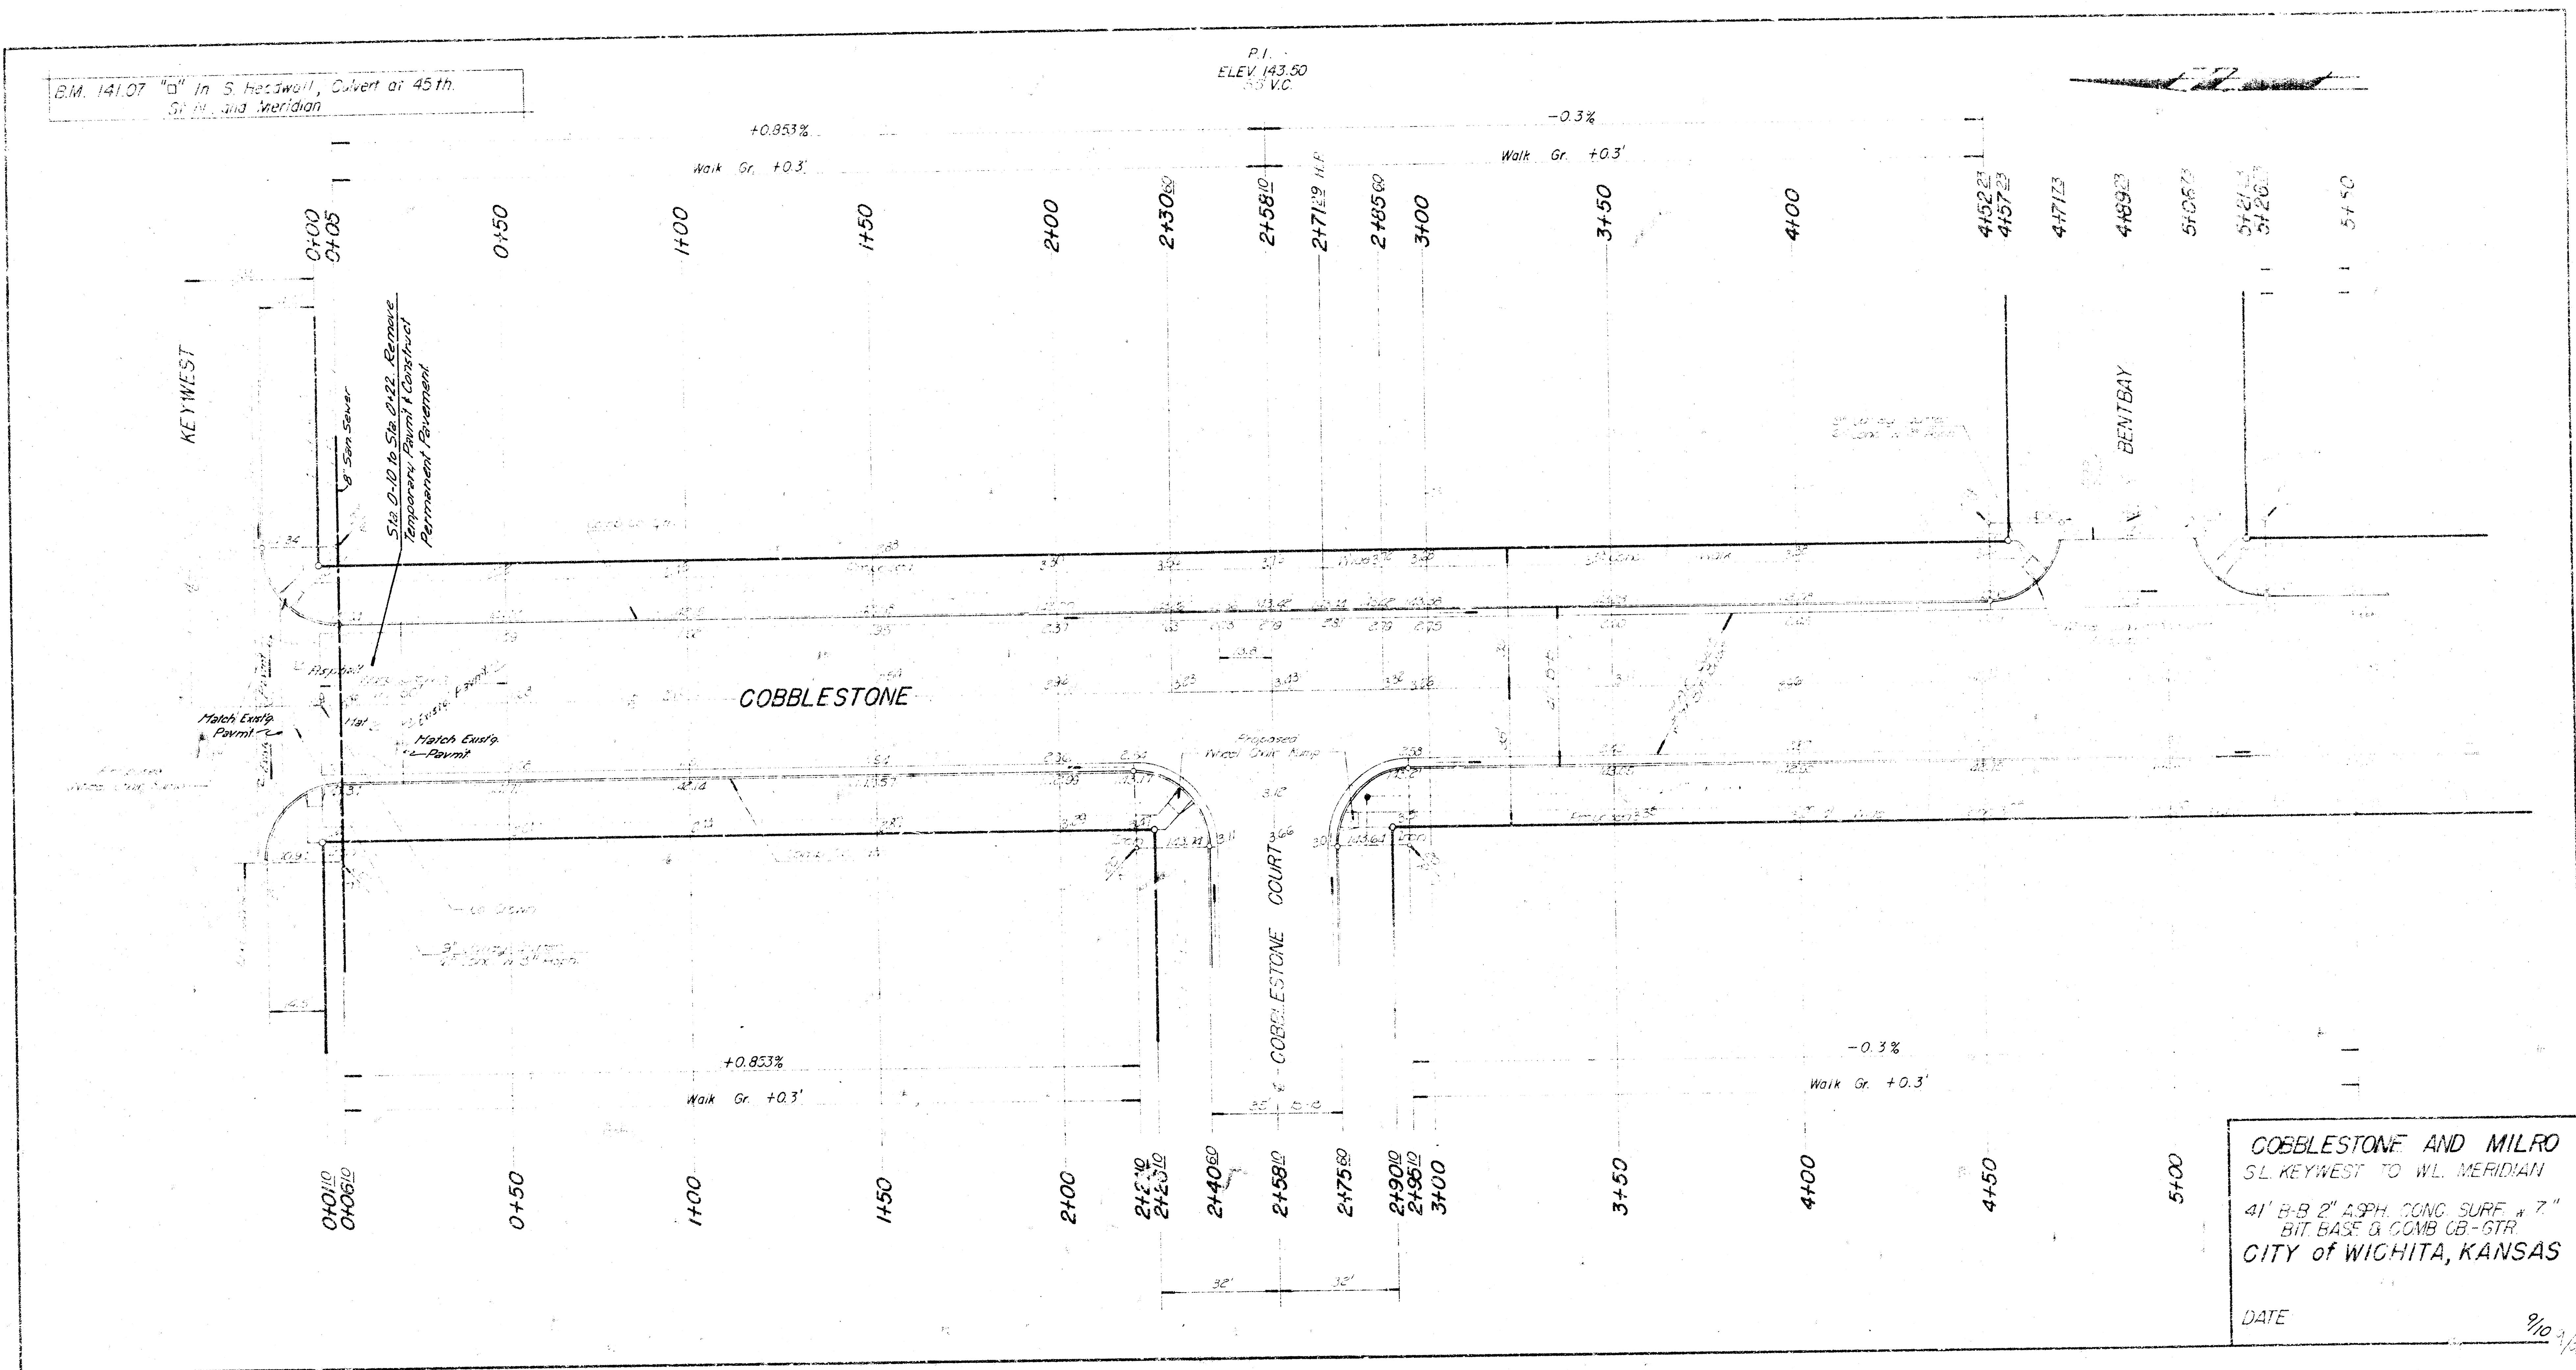

COBBLESTONE AND MILRO
S.L. KEYWEST TO WL. MERIDIAN
41' B-B 2' ASPH. CONC. SURF. & 7' BIT. BASE & COMB. CB-GTR
CITY OF WICHITA, KANSAS
DATE _____ 9/10 9/2