
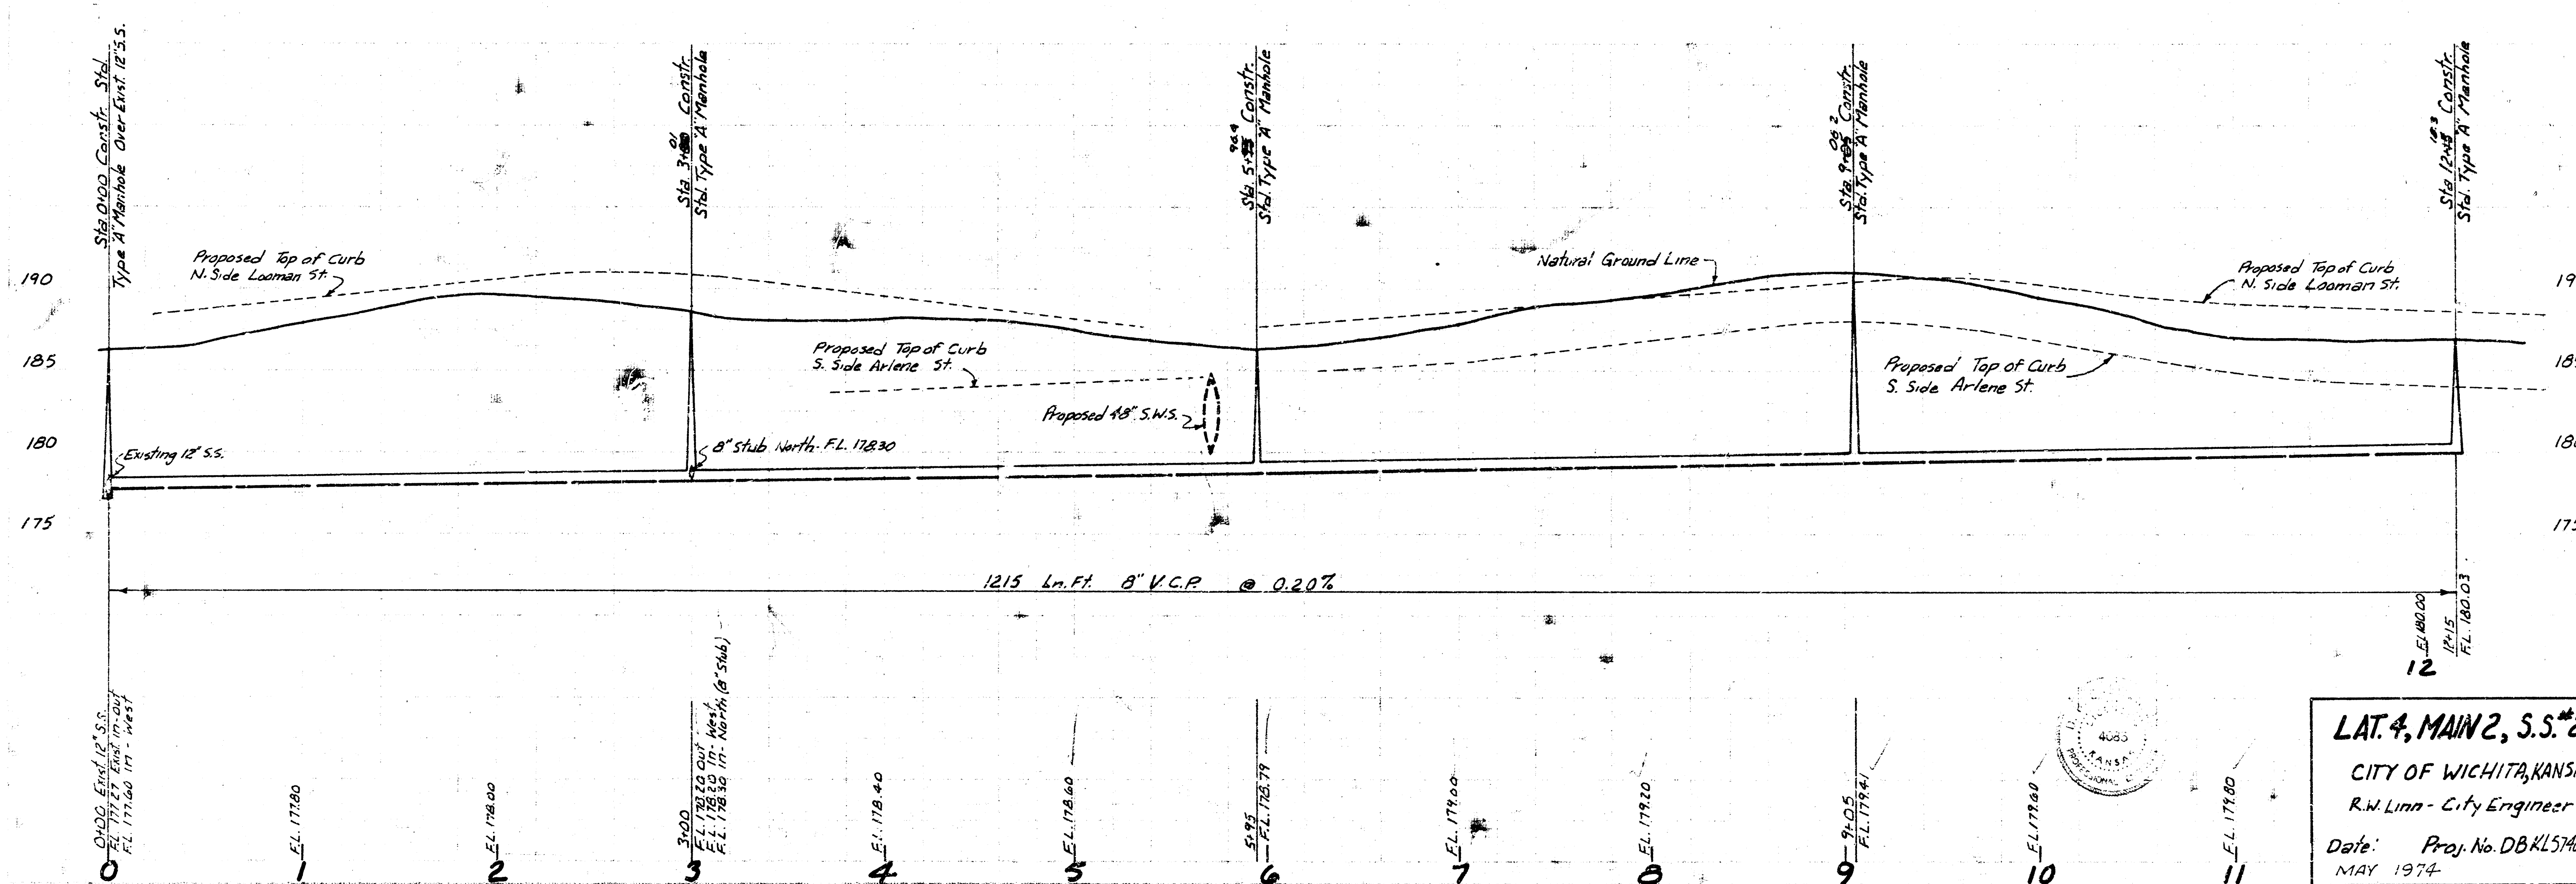


BM 17449 - City S&L 44' W. of E. Oliver Ave. & 32' N. of E. A.C. Pmt. W. on 25th St. N.
 BM 18377 - 12' cut Top curb W.S. Oliver 13th curb W. N. of S.L. Arlene ext.
 BM 18631 - S.W. Corner Conc. Pch. No. at 49th E. 24th St. N.

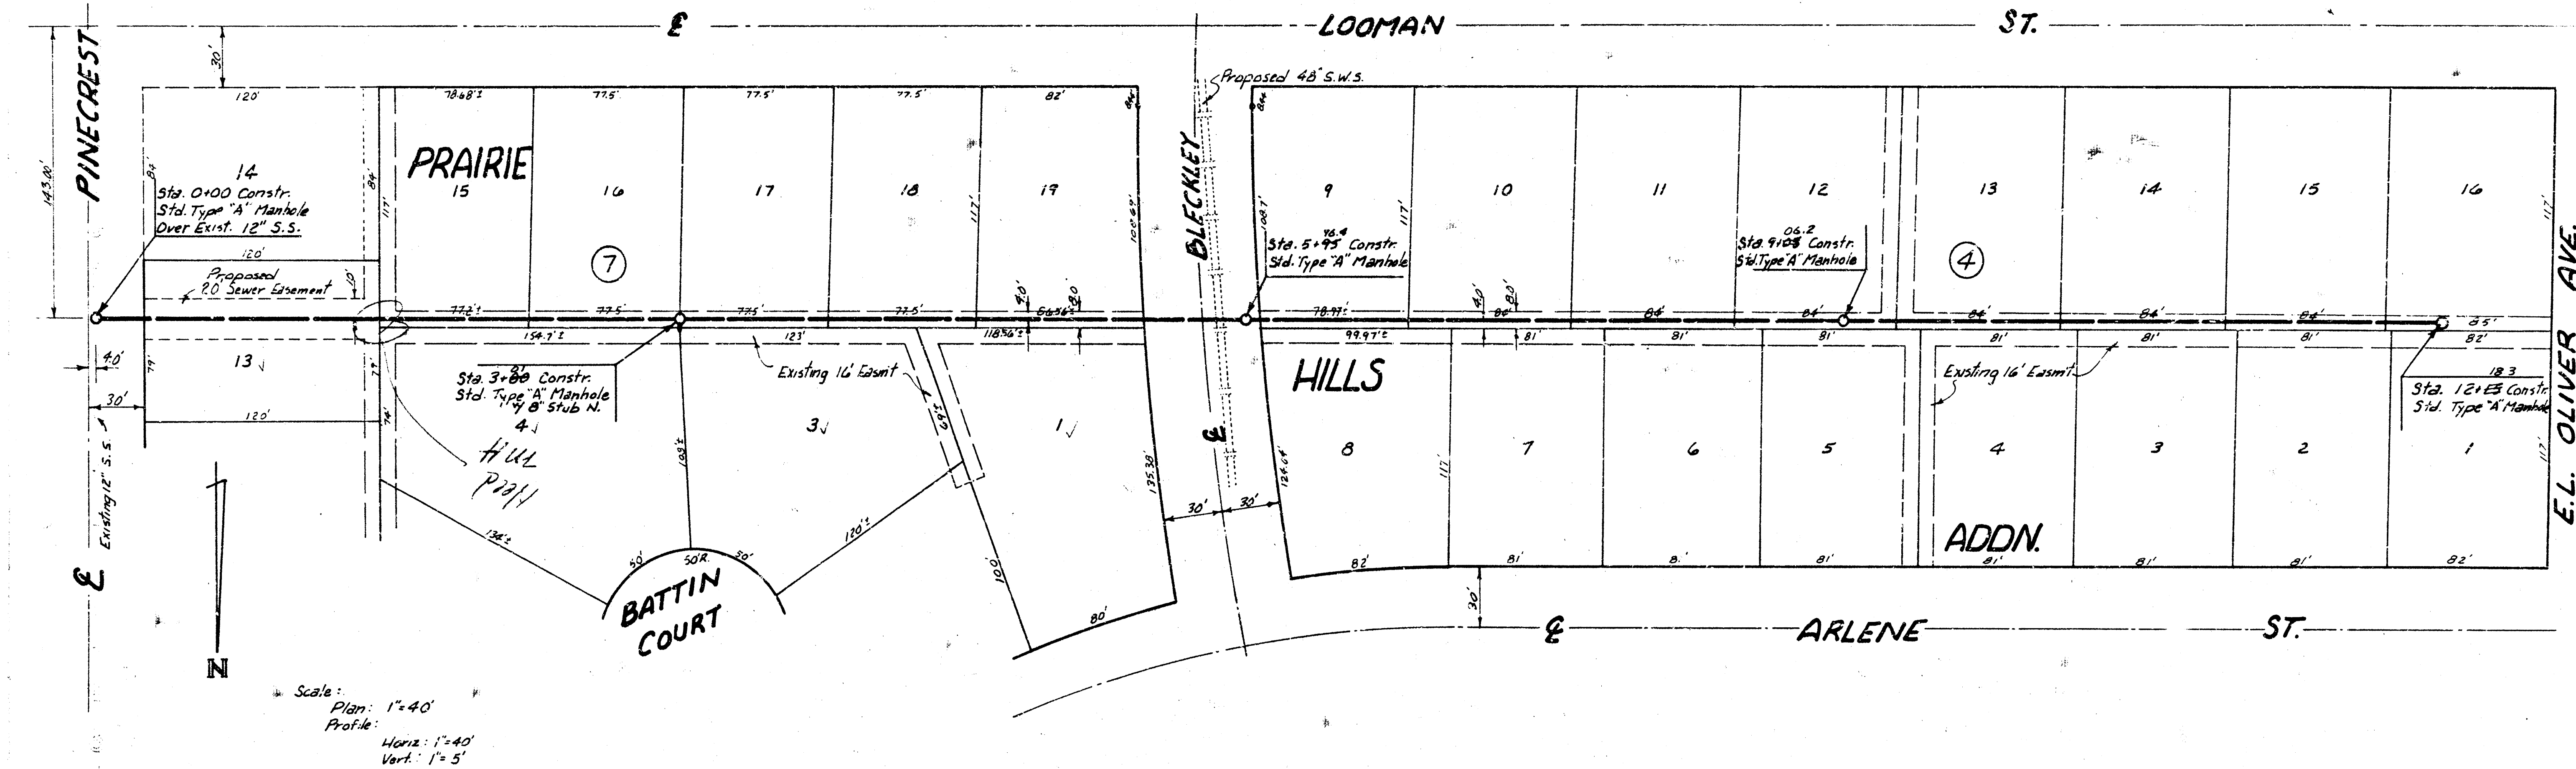

LAT. 4, MAIN 2, S.S. 23
 CITY OF WICHITA, KANSAS
 R.W. Linn - City Engineer
 Date: May 1974
 Proj. No. DBKL574011