PLAN — SURVEYED — PLOTTED — NOTE BOOK — PAGES CHECKED — NO. — BY — DATE

PROFILE — SURVEYED — PLOTTED — NOTE BOOK — PAGES CHECKED — NO. — BY — DATE

Existing 24" San. Sewer

Stone @ S.W. Corner Of The N.W. ¼ Of Sec. 34-26-1E

R/W & P. 50' Lt.

Cities Service Pipeline Marker

KG&E Subsation

KG&E MH 31"x50" CMP Fl 121.03

Bell Tel Junction Box

3'x50" CMP Fl. 131.20

HYDRAULIC AVE.

3' Stub

Edge Of Berm

15" V.C.P.

2-31"x50" CMP Fl. 129.42

2-31"x50" CMP Fl 125.34

Gas Meters

Sign

2-31"x50" CMP Fl. 123.03

R/W & P. 90' Rt.

R/W & P. 100' Rt.

Existing Sta. 5' Dia. M.H., Type "B" Sta. 0+00 = Sta. 46+ 7.5 Of Sub 4, S.S. 23

Sta. 3+00 Existing Std. 5' Dia. M.H., Type "B"

Sta. 5+97.5 Existing Std. 5' Dia. M.H., Type "B"

2+00 Sta. ~~81.98~~ Existing Std. 5' Dia. M.H., Type "B"

3+01.2 Sta. ~~12.133~~ Construct Std. 5' Dia. M.H., Type "B"

5+01.2 Sta. ~~14.166~~ Construct Std. 5' Dia. M.H., Type "B"

NOTE: Sand Fill And Flush

Project Bench Mark No. 1 – Top Of Existing Manhole Ring:- Elev. 133.30

SCALE Plan 1"= 50' Pr. file 1"= 5' Hor. 1"= 50'
















PLAN: SURVEYED / PLOTTED / ALIGNMENT CHECKED / RT. OF WAY CHECKED / NOTE BOOK / NO.

PROFILE: SURVEYED / PLOTTED / GRADE CHECKED / R.R. CROSSING / STRUCTURE PLOT / NO. CHECKED / NOTE BOOK / NO.

P P P

COUNTY OF SEDGWICK
HIGHWAY DEPARTMENT

SEDGWICK COUNTY COURTHOUSE

1635 St. Francis
Wichita, Kansas 67203
OFFICE OF
COUNTY ENGINEER

PHONE 268-7201

November 1, 1973

Mr. Don Moehring II
Brown Building
Wichita, Kansas

Dear Mr. Moehring,

This office has examined the plans for Sub Main 4, Extension Sanitary Sewer 23, City of Wichita, Kansas. We have no objection for its approval.

Very truly yours,

C. C. McLure, Jr., P. E.
Sedgwick County Engineer

N. J. Graham

N. J. Graham
Engineering Aide II

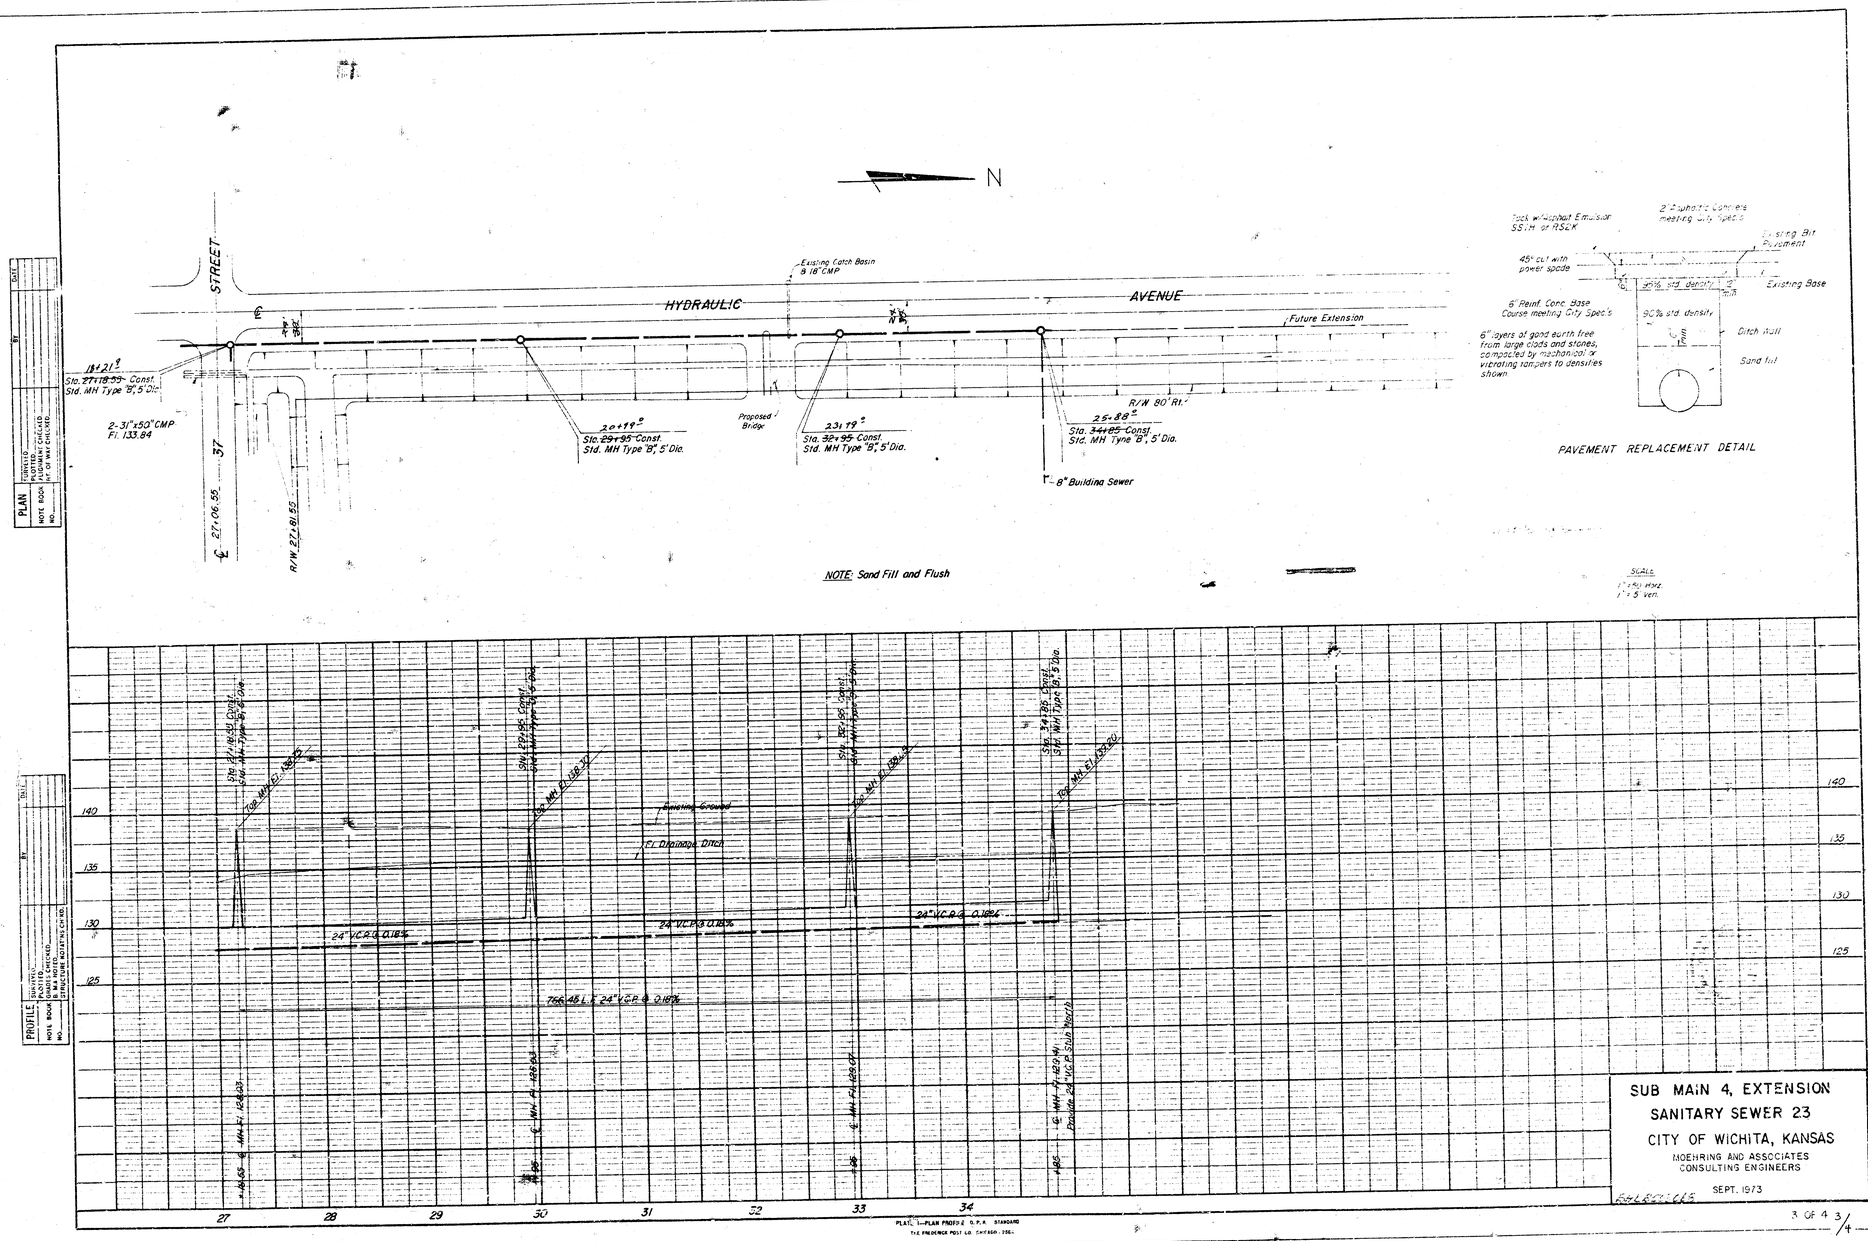

FILMED FROM THE BEST AVAILABLE COPY....

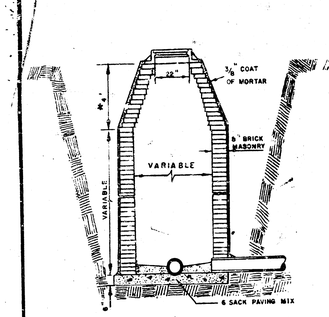

STANDARD MANHOLE
TYPE "A"

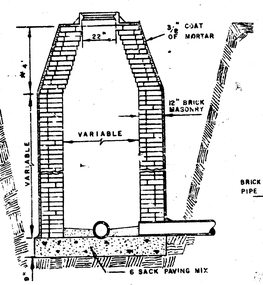

STANDARD MANHOLE
TYPE "B"

* DRAW = 6' ON 5' DIA. M.H.

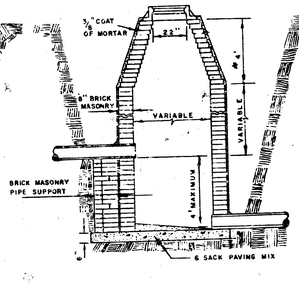

DROP MANHOLE
TYPE "A"

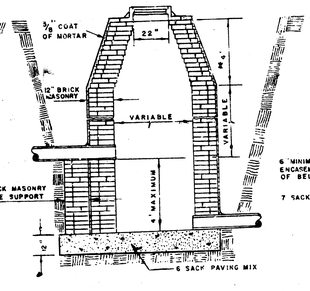

DROP MANHOLE
TYPE "B"

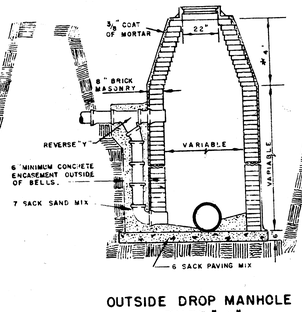

OUTSIDE DROP MANHOLE
TYPE "A"

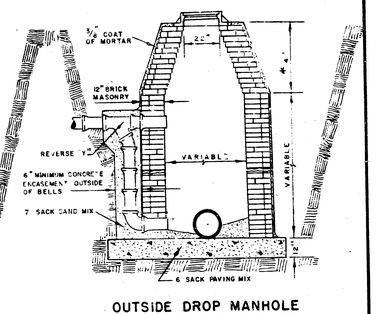

OUTSIDE DROP MANHOLE
TYPE "B"

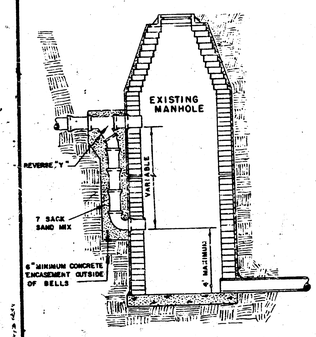

DETAIL OF DROP STACK
FOR EXISTING MANHOLES IN GROUND WATER

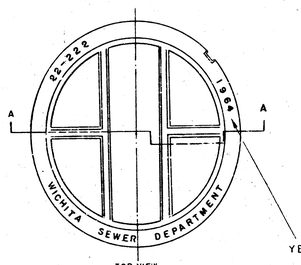

TOP VIEW
MANHOLE COVER
WEIGHT 110 lbs.

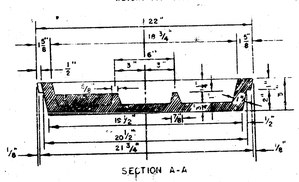

SECTION A-A
MANHOLE COVER

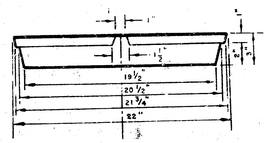

SIDE VIEW
MANHOLE COVER

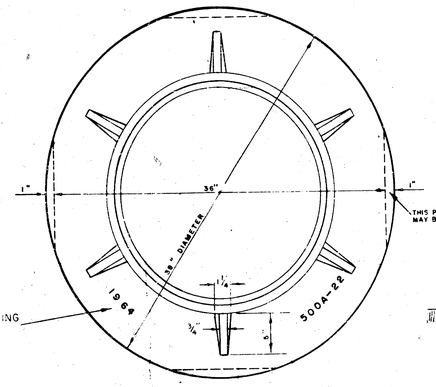

TOP VIEW
MANHOLE RING
WEIGHT 355 lbs.

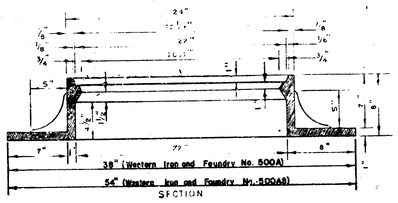

SECTION
MANHOLE RING

OUTSIDE CIRCUMFERENCE OF COVER AND THE INNER FACE AND SEAT OF RING TO BE MACHINE FIT.

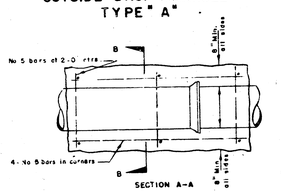

REINFORCED CONCRETE ENCASEMENT
FOR STRENGTH

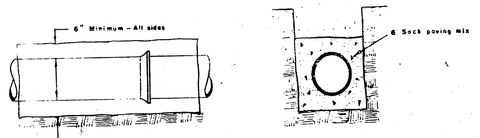

CONCRETE ENCASEMENT
FOR COVER

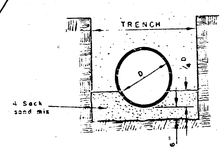

DETAIL OF CONCRETE CRADLE

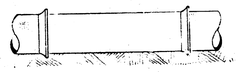

ORDINARY BEDDING METHOD
FOR CLAY PIPE

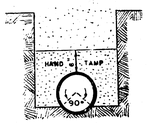

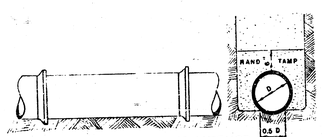

ORDINARY BEDDING METHOD
FOR REINFORCED CONCRETE PIPE

MANHOLES

THE CONCRETE USED FOR MORTAR IN MANHOLES SHALL CONTAIN 8 SACKS OF CEMENT PER CUBIC YARD.

STANDARD MANHOLES AND DROP MANHOLES, REGARDLESS OF DIAMETER, SHALL BE BID AT ONE PRICE AS STANDARD MANHOLES.

SINGLE OR DOUBLE OUTSIDE DROP MANHOLES SHALL BE BID AT ONE PRICE AS OUTSIDE DROP MANHOLES.

ALL MANHOLES WITH PIPES LARGER THAN 24" SHALL BE 5' DIAMETER UNLESS OTHERWISE SPECIFIED ON PLAN. ALL M.H.'S WITH PIPES 24" & SMALLER SHALL BE 4' DIA.

DETAILS OF
SEWER APPURTENANCES
ADOPTED AS STANDARD DESIGN
BY
ENGINEERING DIVISION
CITY OF WICHITA, KANSAS
R. W. LINN CITY ENGINEER
1964

Sheet 13 OF 4

FILMED FROM THE BEST AVAILABLE COPY....