


|         |      |
|---------|------|
| PLAN    | DATE |
| BY      |      |
| CHECKED |      |
| NOTED   |      |
| NO.     |      |


|         |      |
|---------|------|
| PROFILE | DATE |
| BY      |      |
| CHECKED |      |
| NOTED   |      |
| NO.     |      |

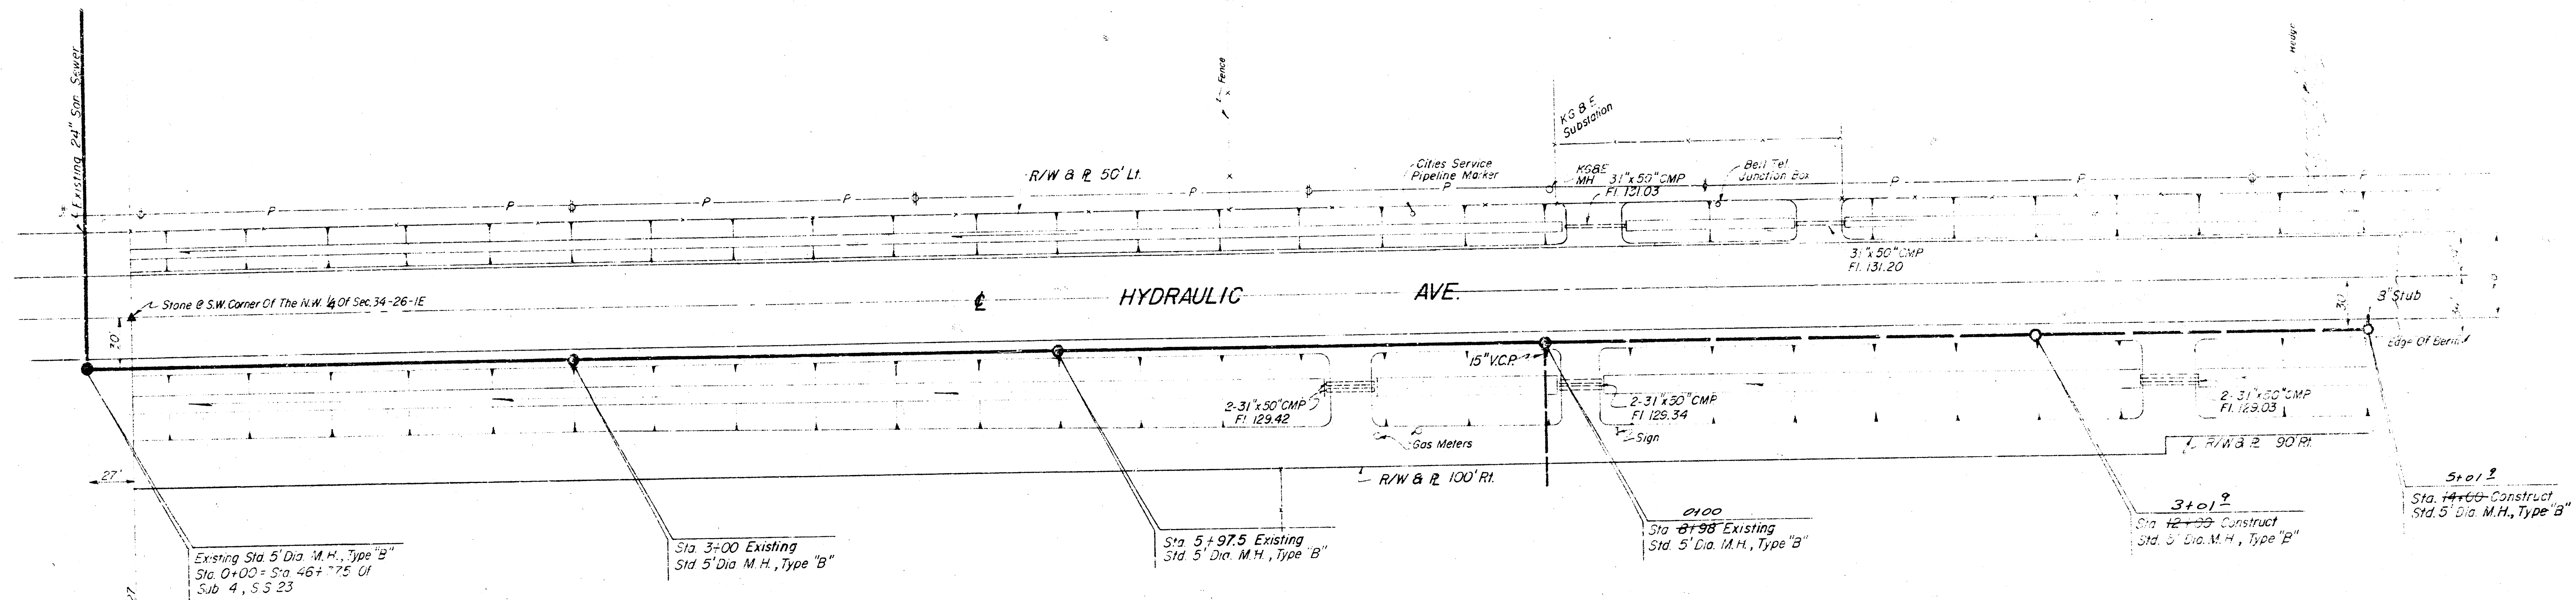



Project Bench Mark No. 1 - Top Of Existing Manhole Ring - Elev. 133.30

NOTE: Sand Fill And Flush

SCALE: Plan 1"=50'  
Profile 1"=5'

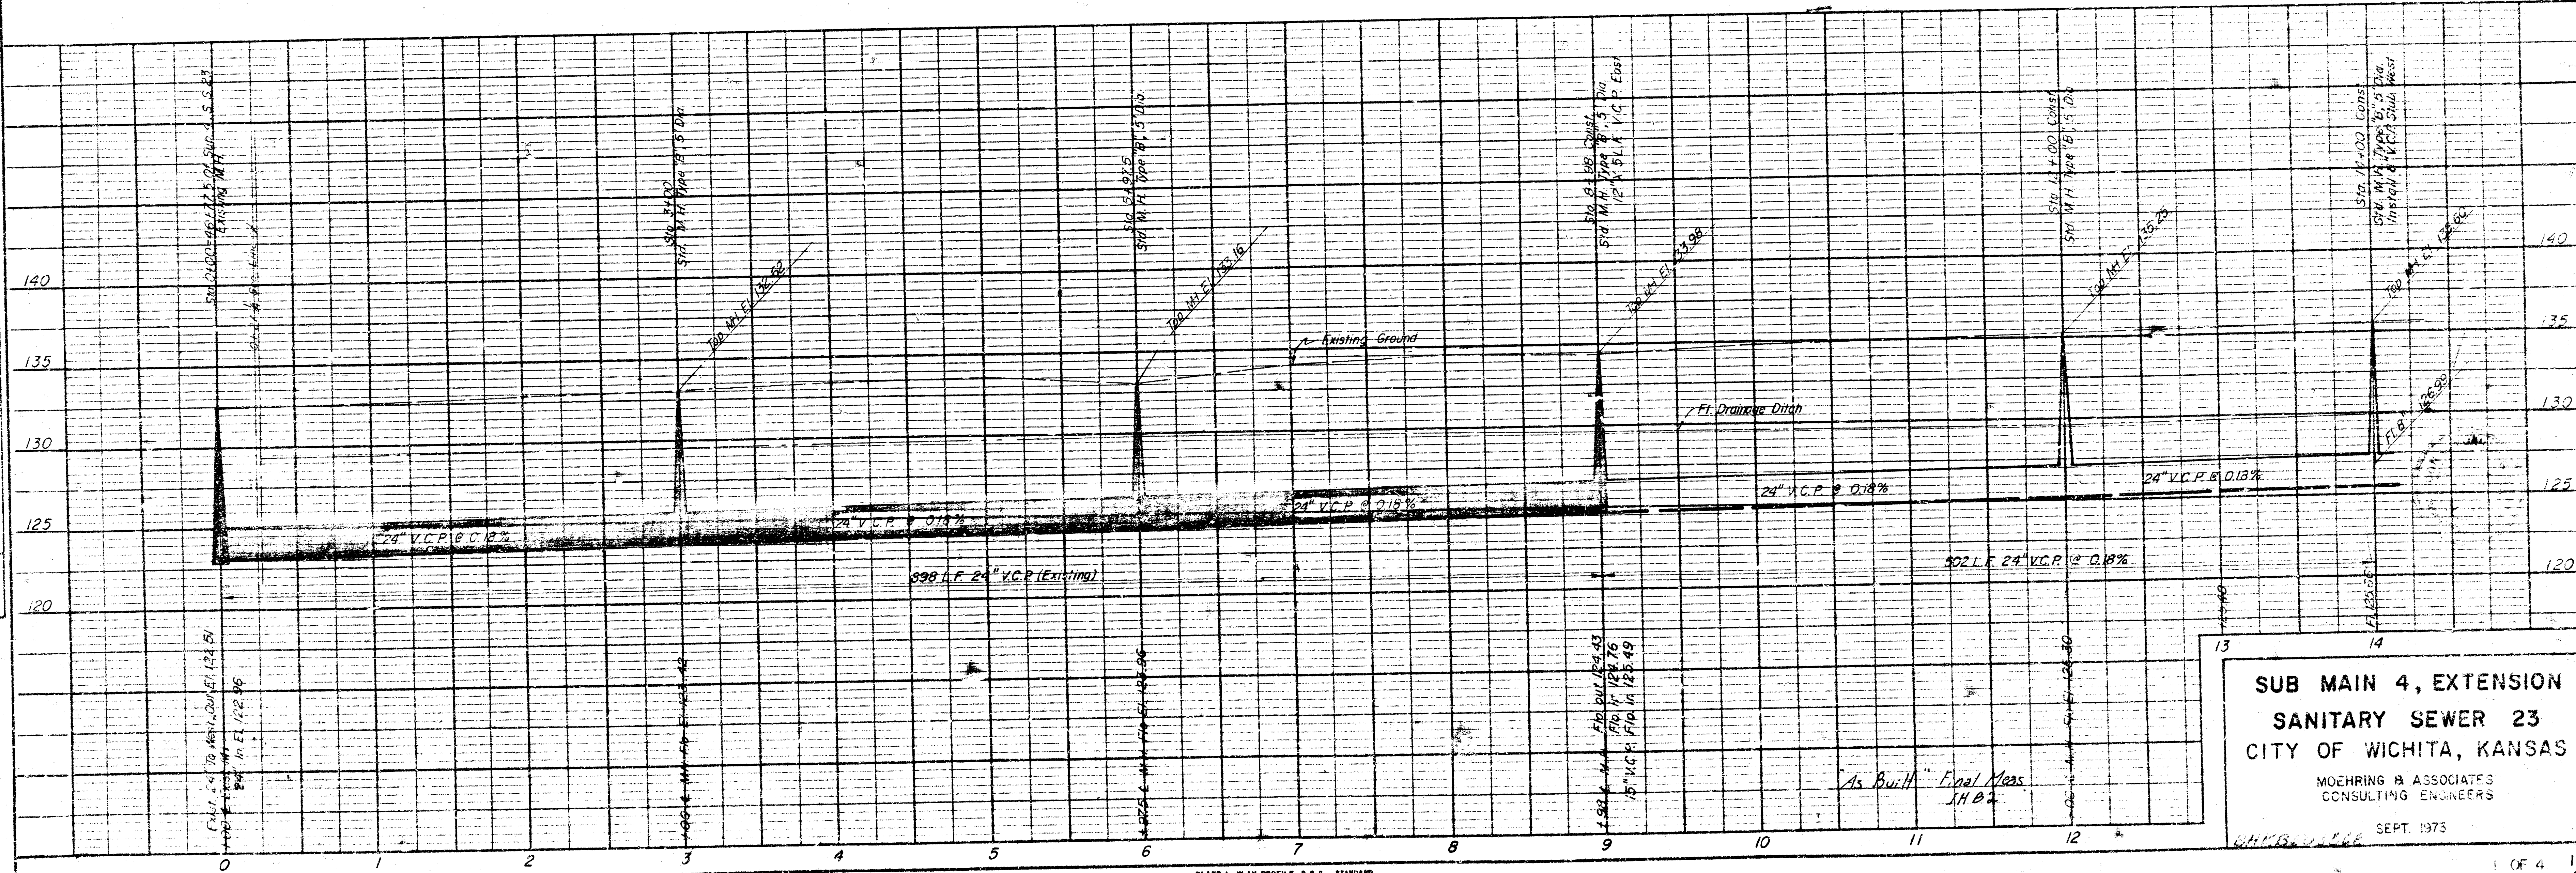

SUB MAIN 4, EXTENSION  
SANITARY SEWER 23  
CITY OF WICHITA, KANSAS  
MOEHRING & ASSOCIATES  
CONSULTING ENGINEERS  
SEPT. 1975

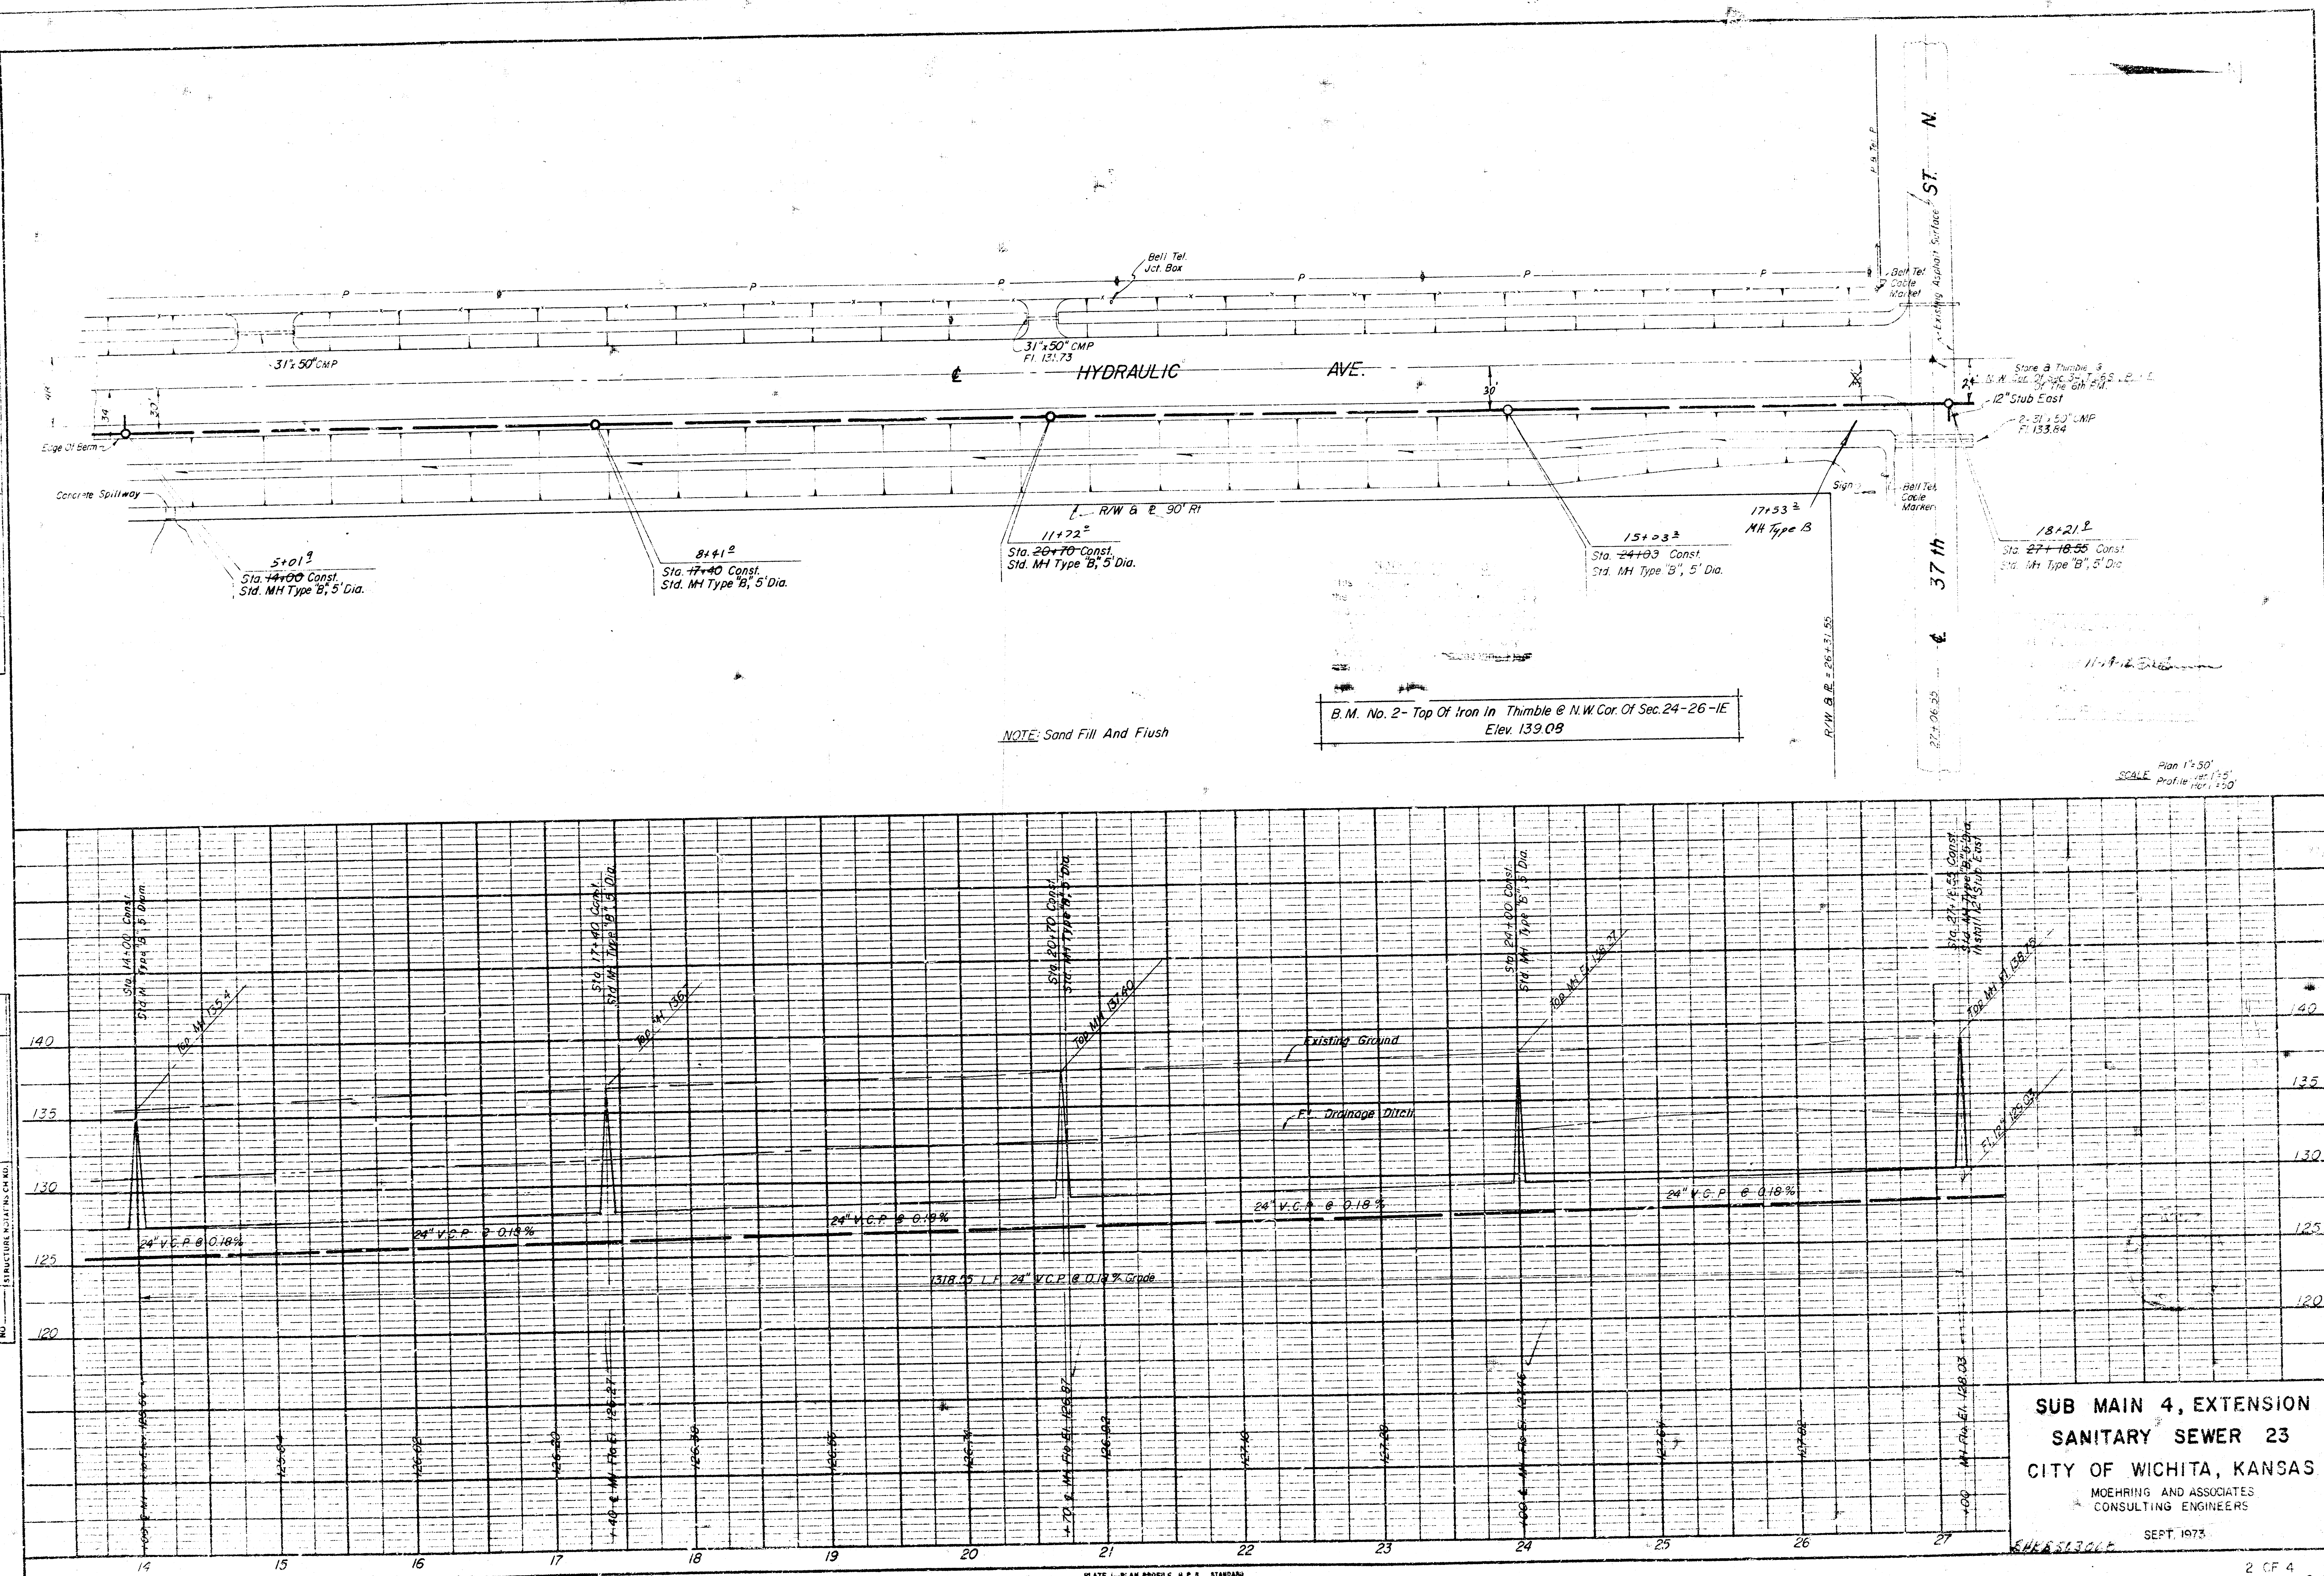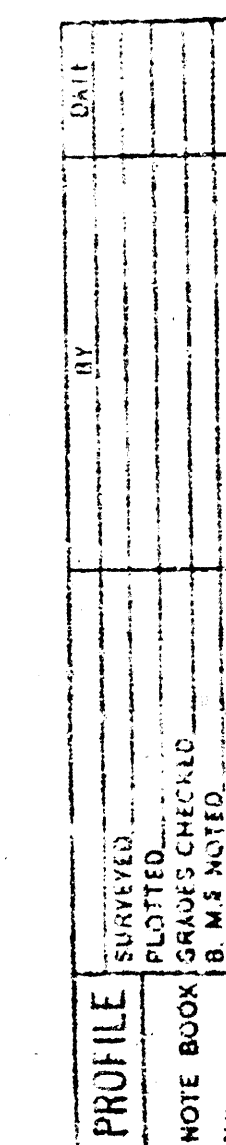



**COUNTY OF SEDGWICK**  
HIGHWAY DEPARTMENT

1011 CHERRY STREET  
WICHITA, KANSAS 67202  
COUNTY ENGINEER  
November 1, 1973  
PHONE 268-1201

Mr. Don Moehring II  
Brown Building  
Wichita, Kansas

Dear Mr. Moehring,

This office has examined the plans for Sub Main 4, Extension  
Sanitary Sewer 23, City of Wichita, Kansas. We have no objection  
for its approval.

Very truly yours,

G. C. McLure, Jr., P. E.  
Sedgwick County Engineer

*G. C. McLure, Jr.*

No. J. Graham  
Engineering Aide II



