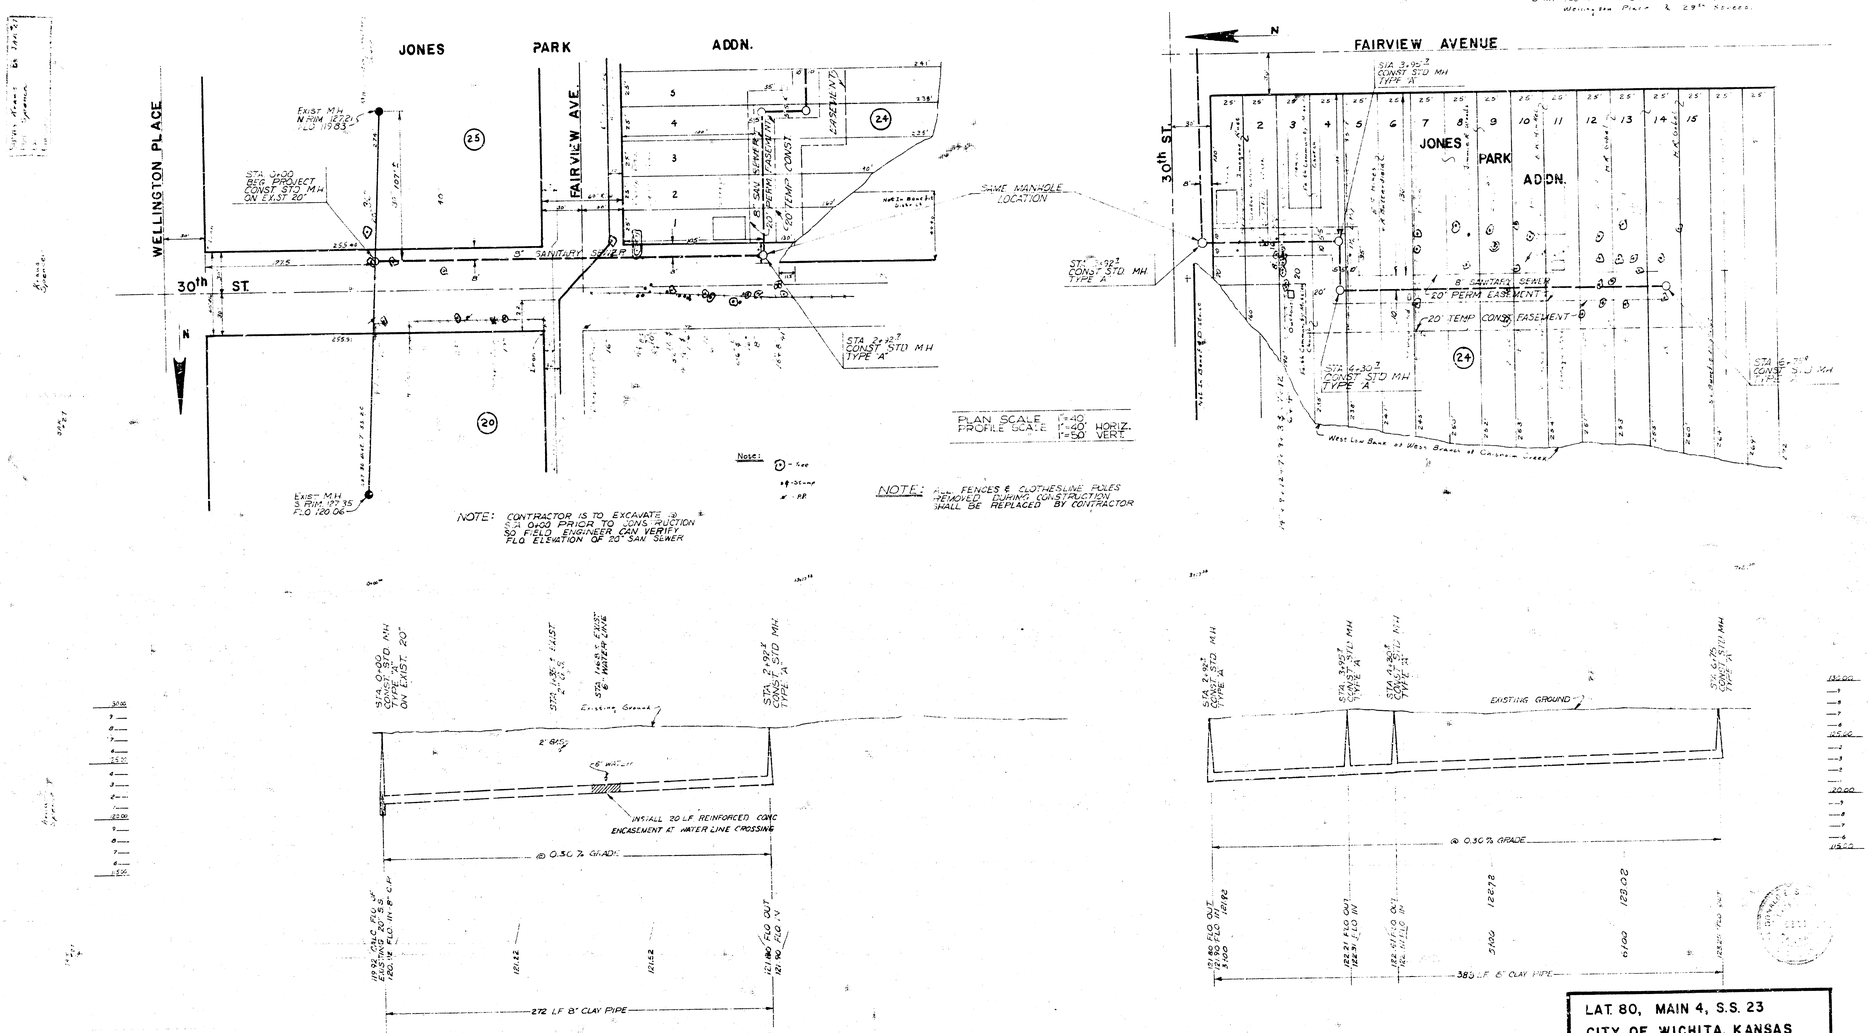

LAT. 80, MAIN 4, S.S. 23
CITY OF WICHITA, KANSAS
R.W. LINN, CITY ENGINEER
PROJ. NO. DBKL 573004
DATE: