
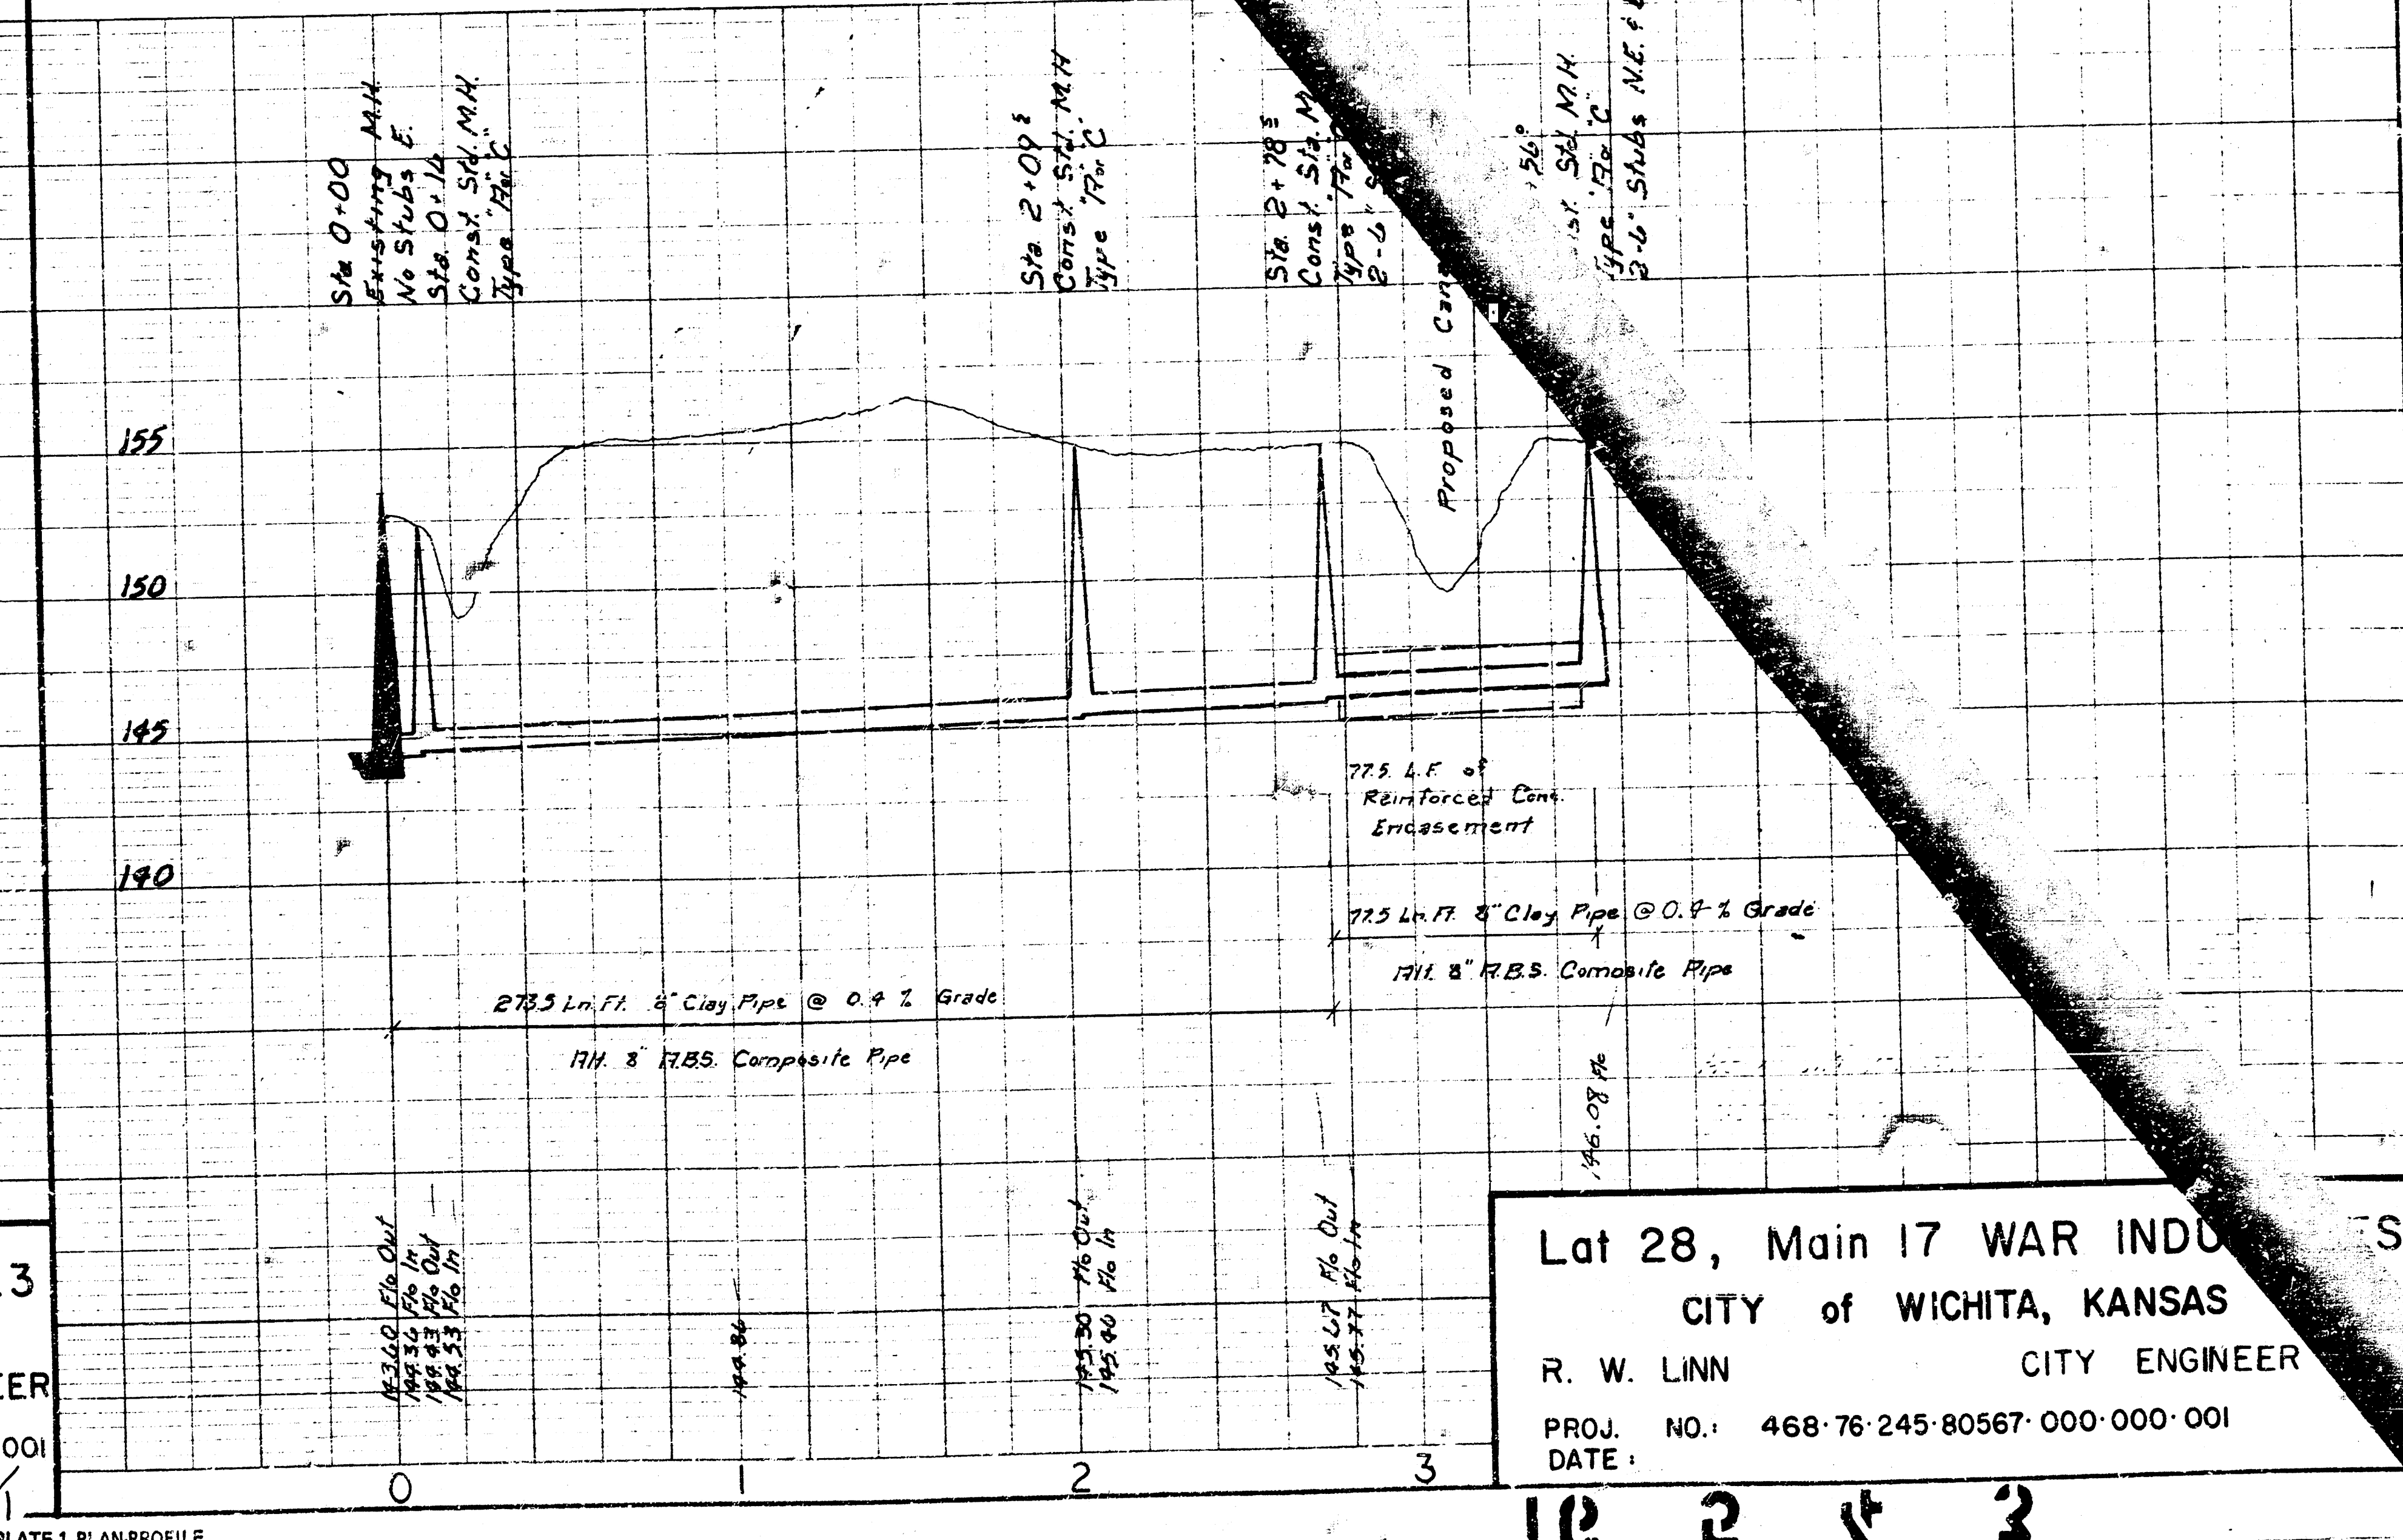


PROFILE	BY	DATE
	SUBJECT	
NOTE BOOK	PLOTTER	
NOTES	GRABBS CHECKED	
	R. M.'S NOTED. COMMENTS CHECKED	

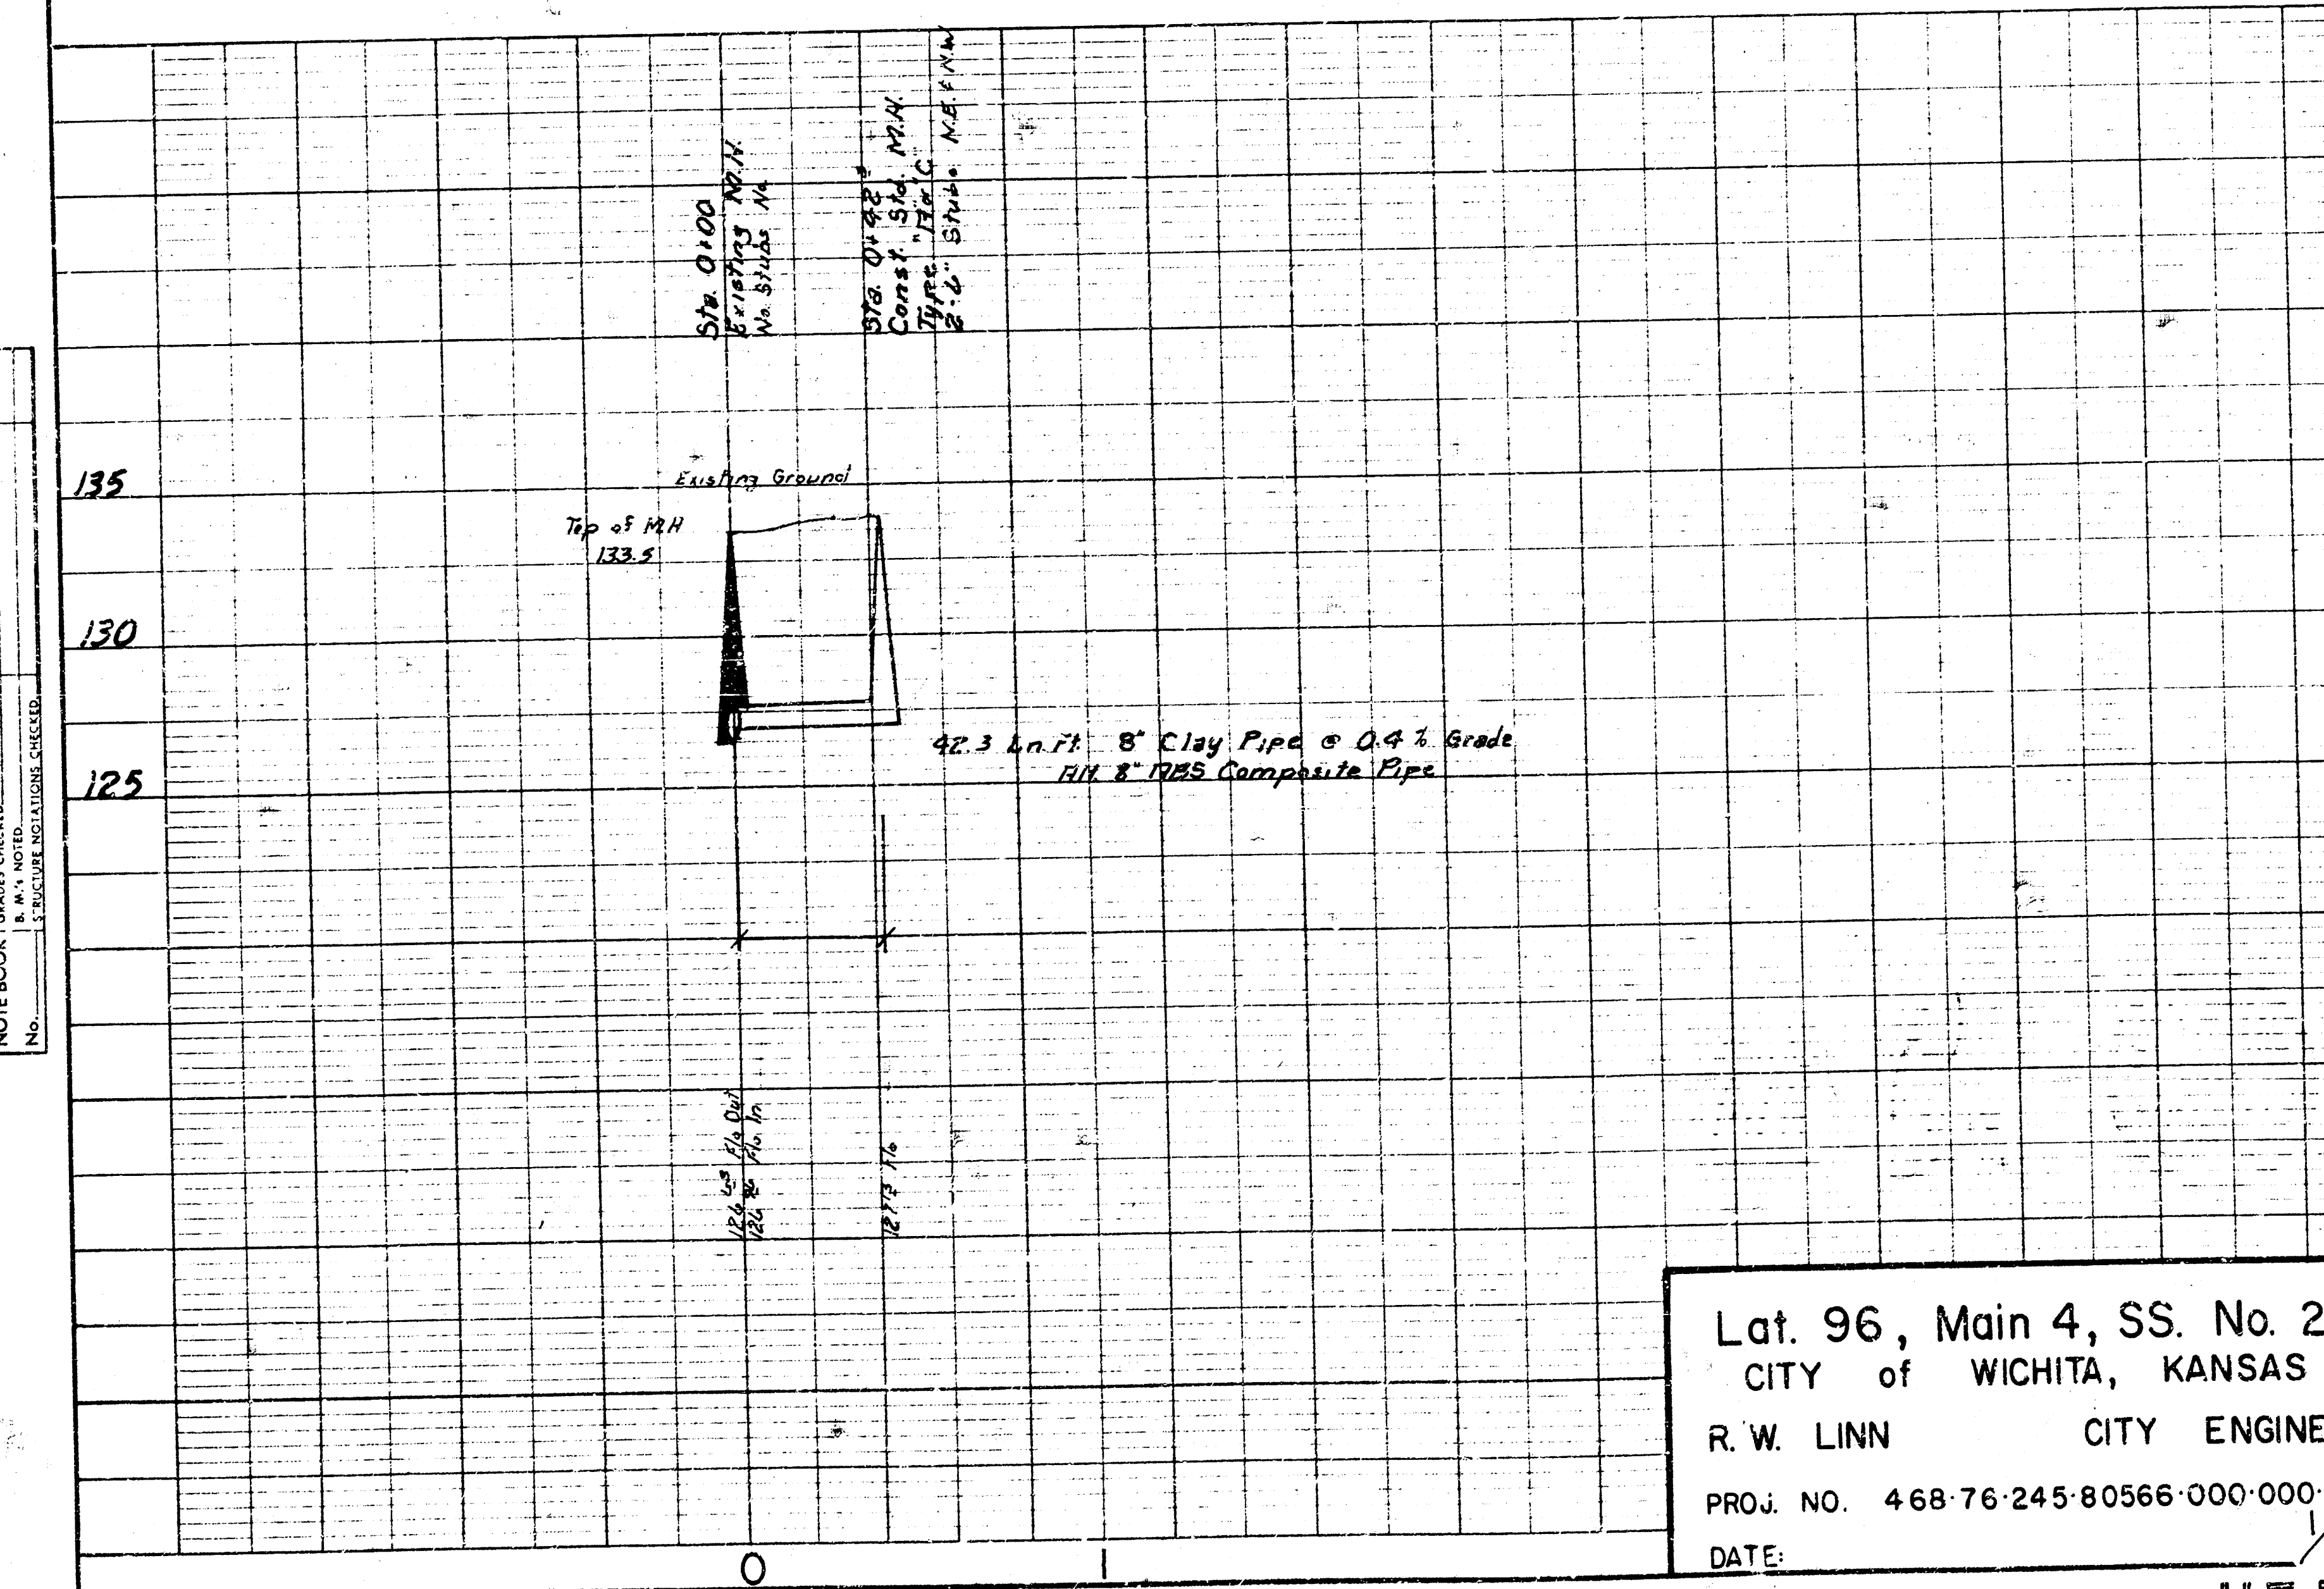

Lat. 96, Main 4, SS. No. 23
CITY of WICHITA, KANSAS
R. W. LINN CITY ENGINEER
PROJ. NO. 468-76-245-80566-000-000-001
DATE: 1/1

Lat 28, Main 17 WAR INDUSTRIES
CITY of WICHITA, KANSAS
R. W. LINN CITY ENGINEER
PROJ. NO. 468-76-245-80567-000-000-001
DATE: