




PLAN
 4/20
 De Cicco
 A. Adams

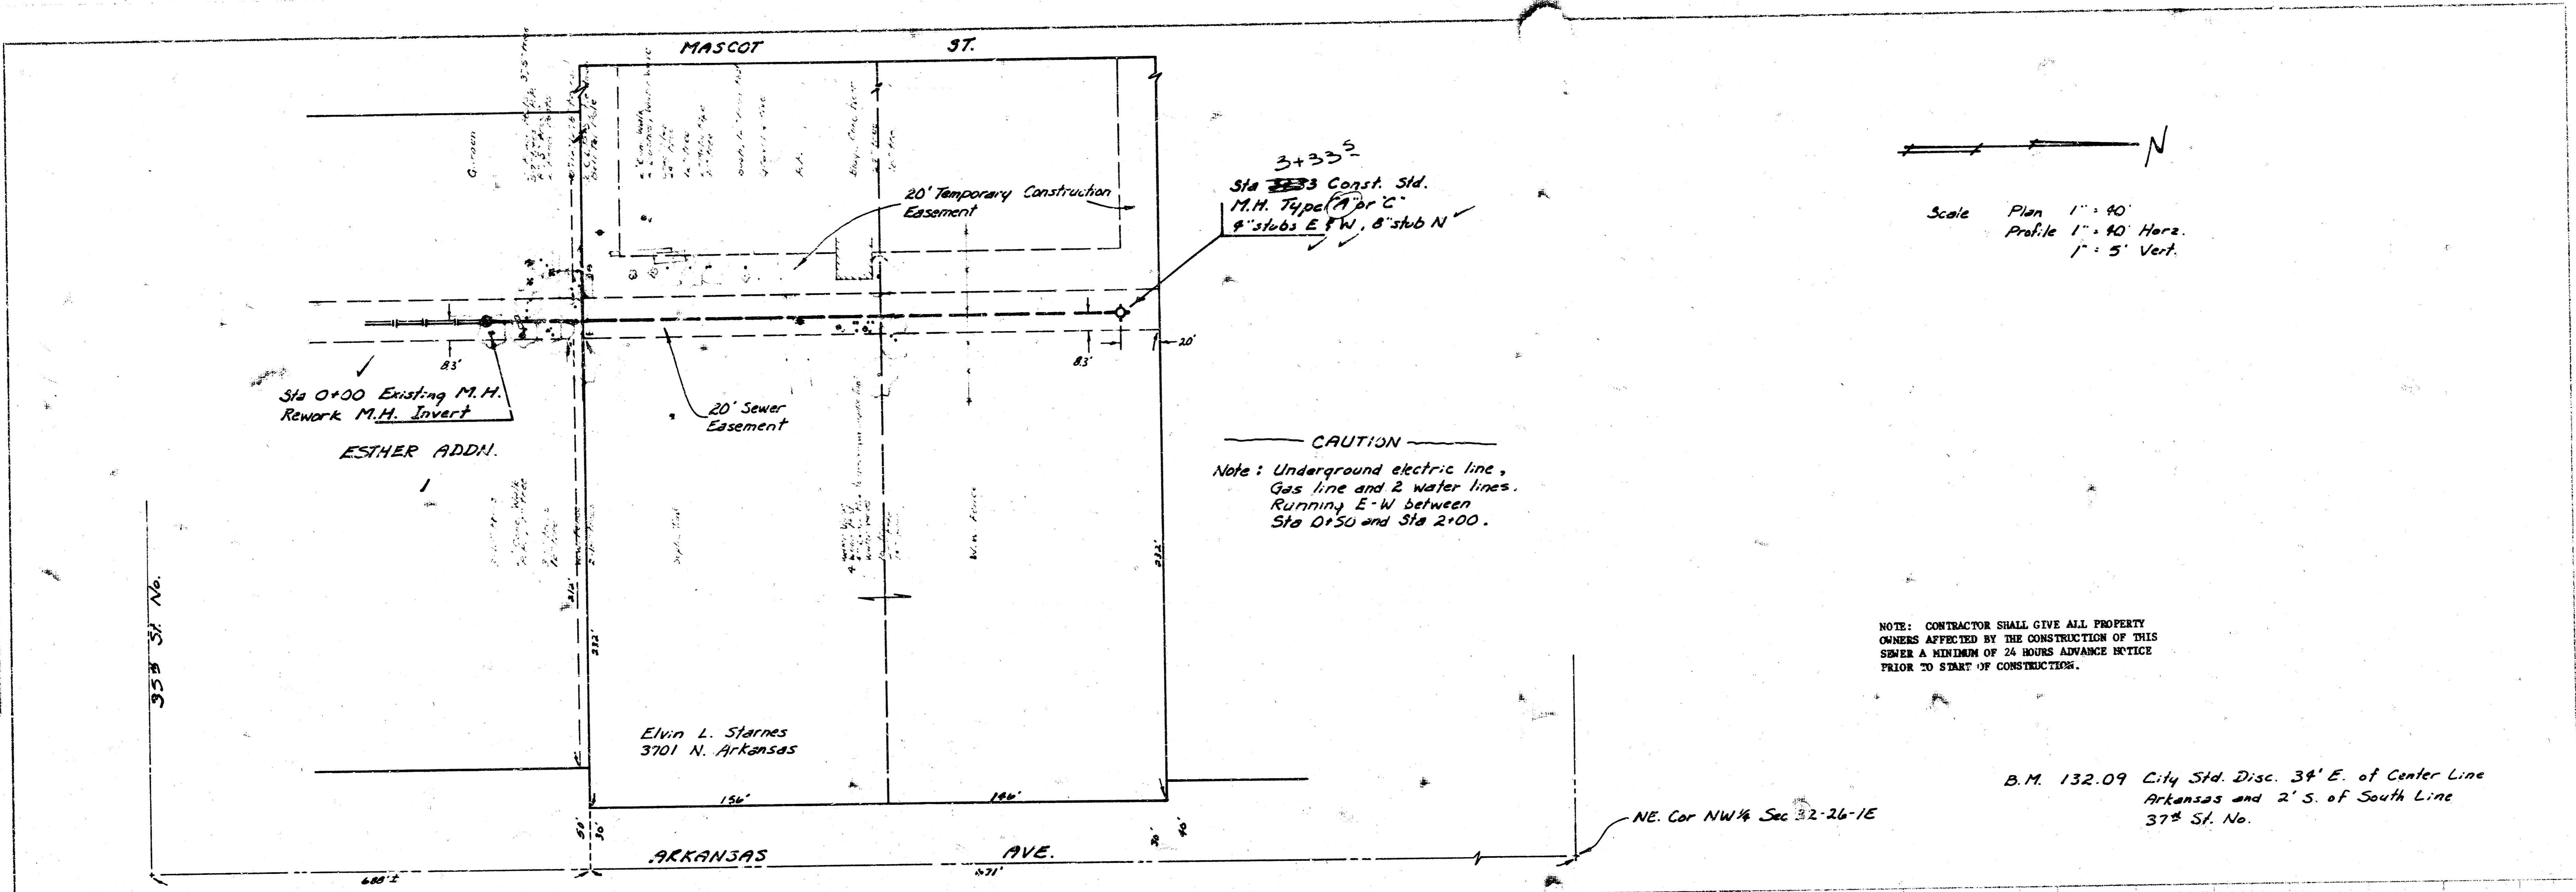

NOTE: CONTRACTOR SHALL GIVE ALL PROPERTY OWNERS AFFECTED BY THE CONSTRUCTION OF THIS SEWER A MINIMUM OF 24 HOURS ADVANCE NOTICE PRIOR TO START OF CONSTRUCTION.

B.M. 132.09 City Std. Disc. 38' E. of Center Line
 Arkansas and 2' S. of South Line
 37th St. No.

PROFILE
 4/20
 De Cicco
 A. Adams

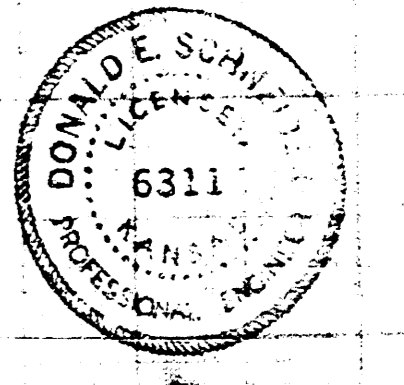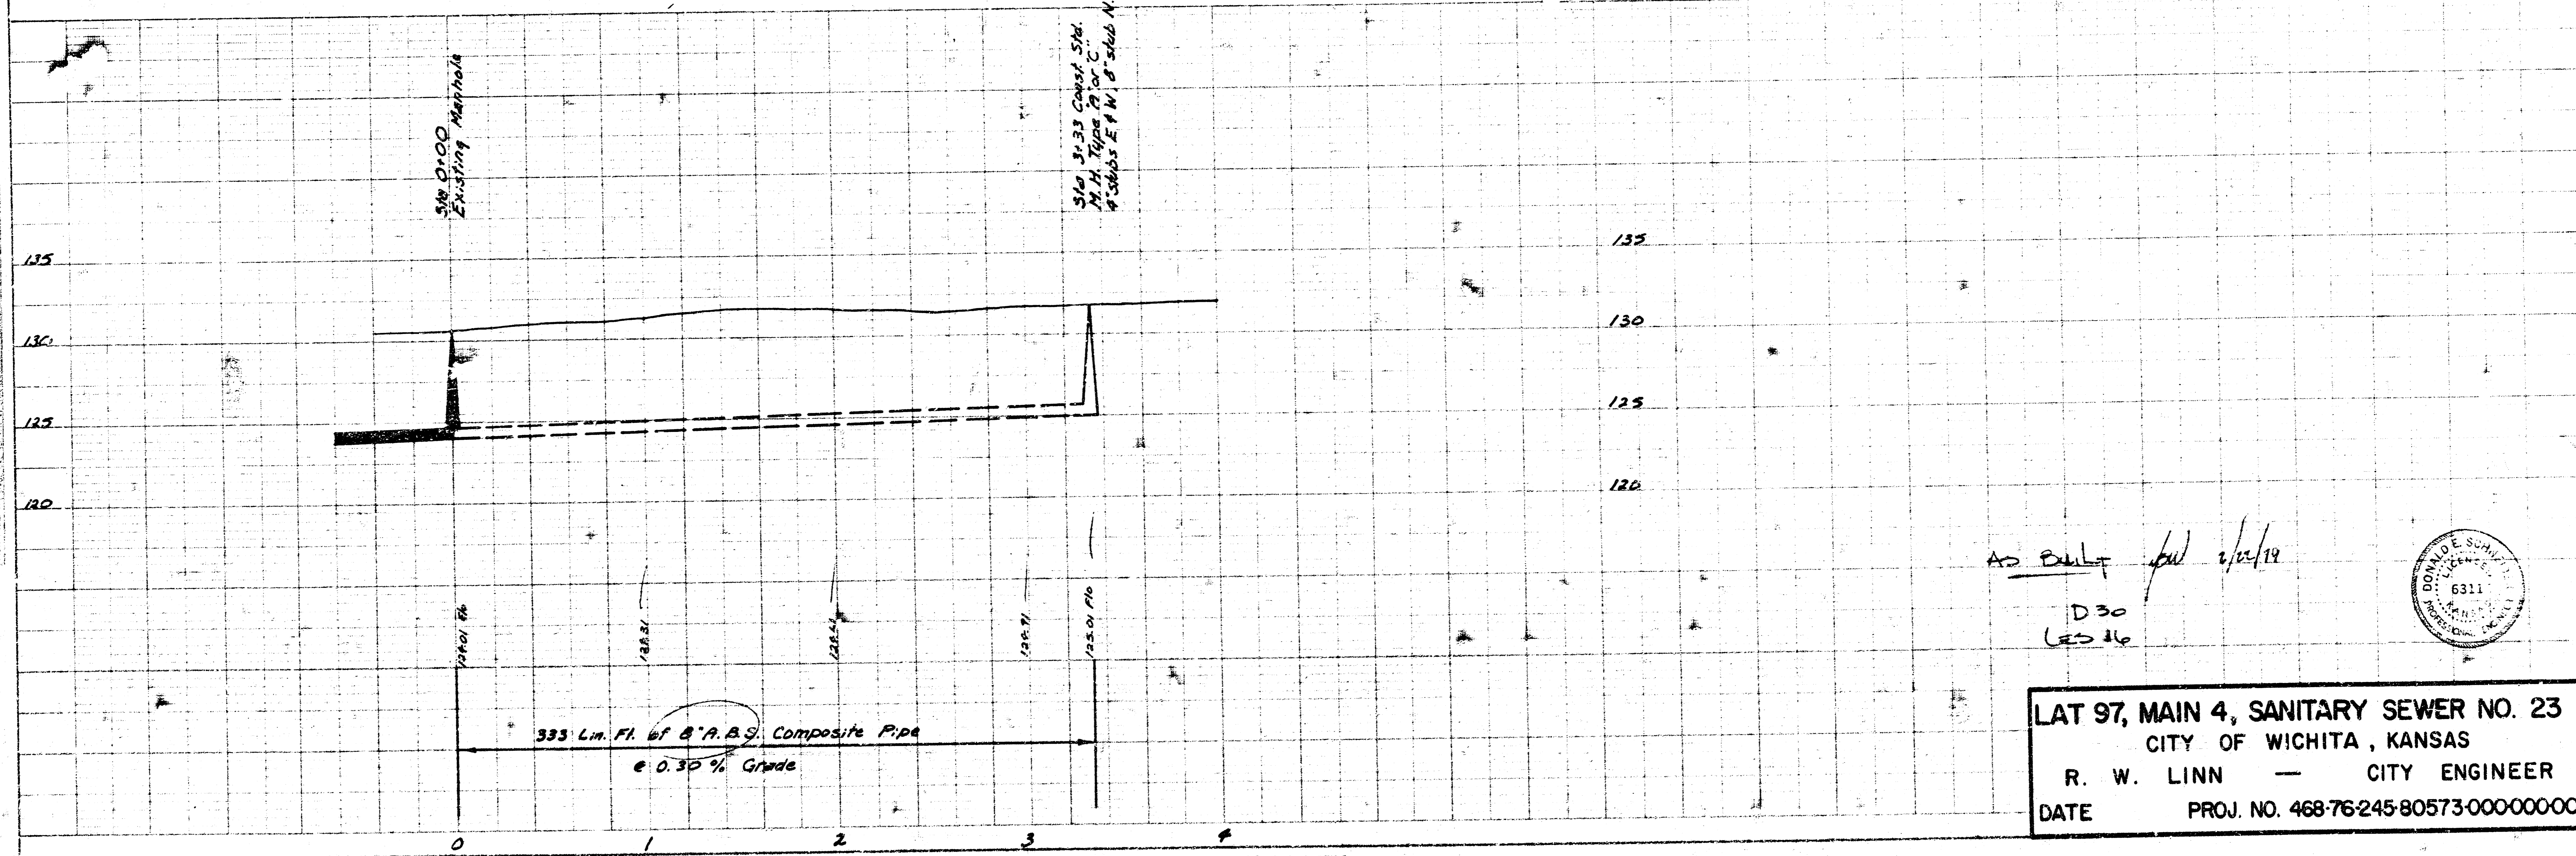

LAT 97, MAIN 4, SANITARY SEWER NO. 23
 CITY OF WICHITA, KANSAS
 R. W. LINN — CITY ENGINEER
 DATE PROJ. NO. 468-76-245-80573-000000001

14 5 5 2