


SCALE PLAN 1" = 40'  
PROFILE 1" = 40' HORZ.  
1" = 5' VERT.

THE CONTRACTOR SHALL BE RESPONSIBLE FOR PRESERVING PROPERTY IRONS. THE CONTRACTOR SHALL BE REQUIRED TO RE-ESTABLISH ANY PROPERTY IRONS WHICH ARE DAMAGED OR DESTROYED BY HIS CONSTRUCTION OPERATIONS. SUCH IRONS SHALL BE RE-ESTABLISHED BY A LICENSED LAND SURVEYOR OR A LICENSED PROFESSIONAL ENGINEER IN ACCORDANCE WITH STATE LAWS.

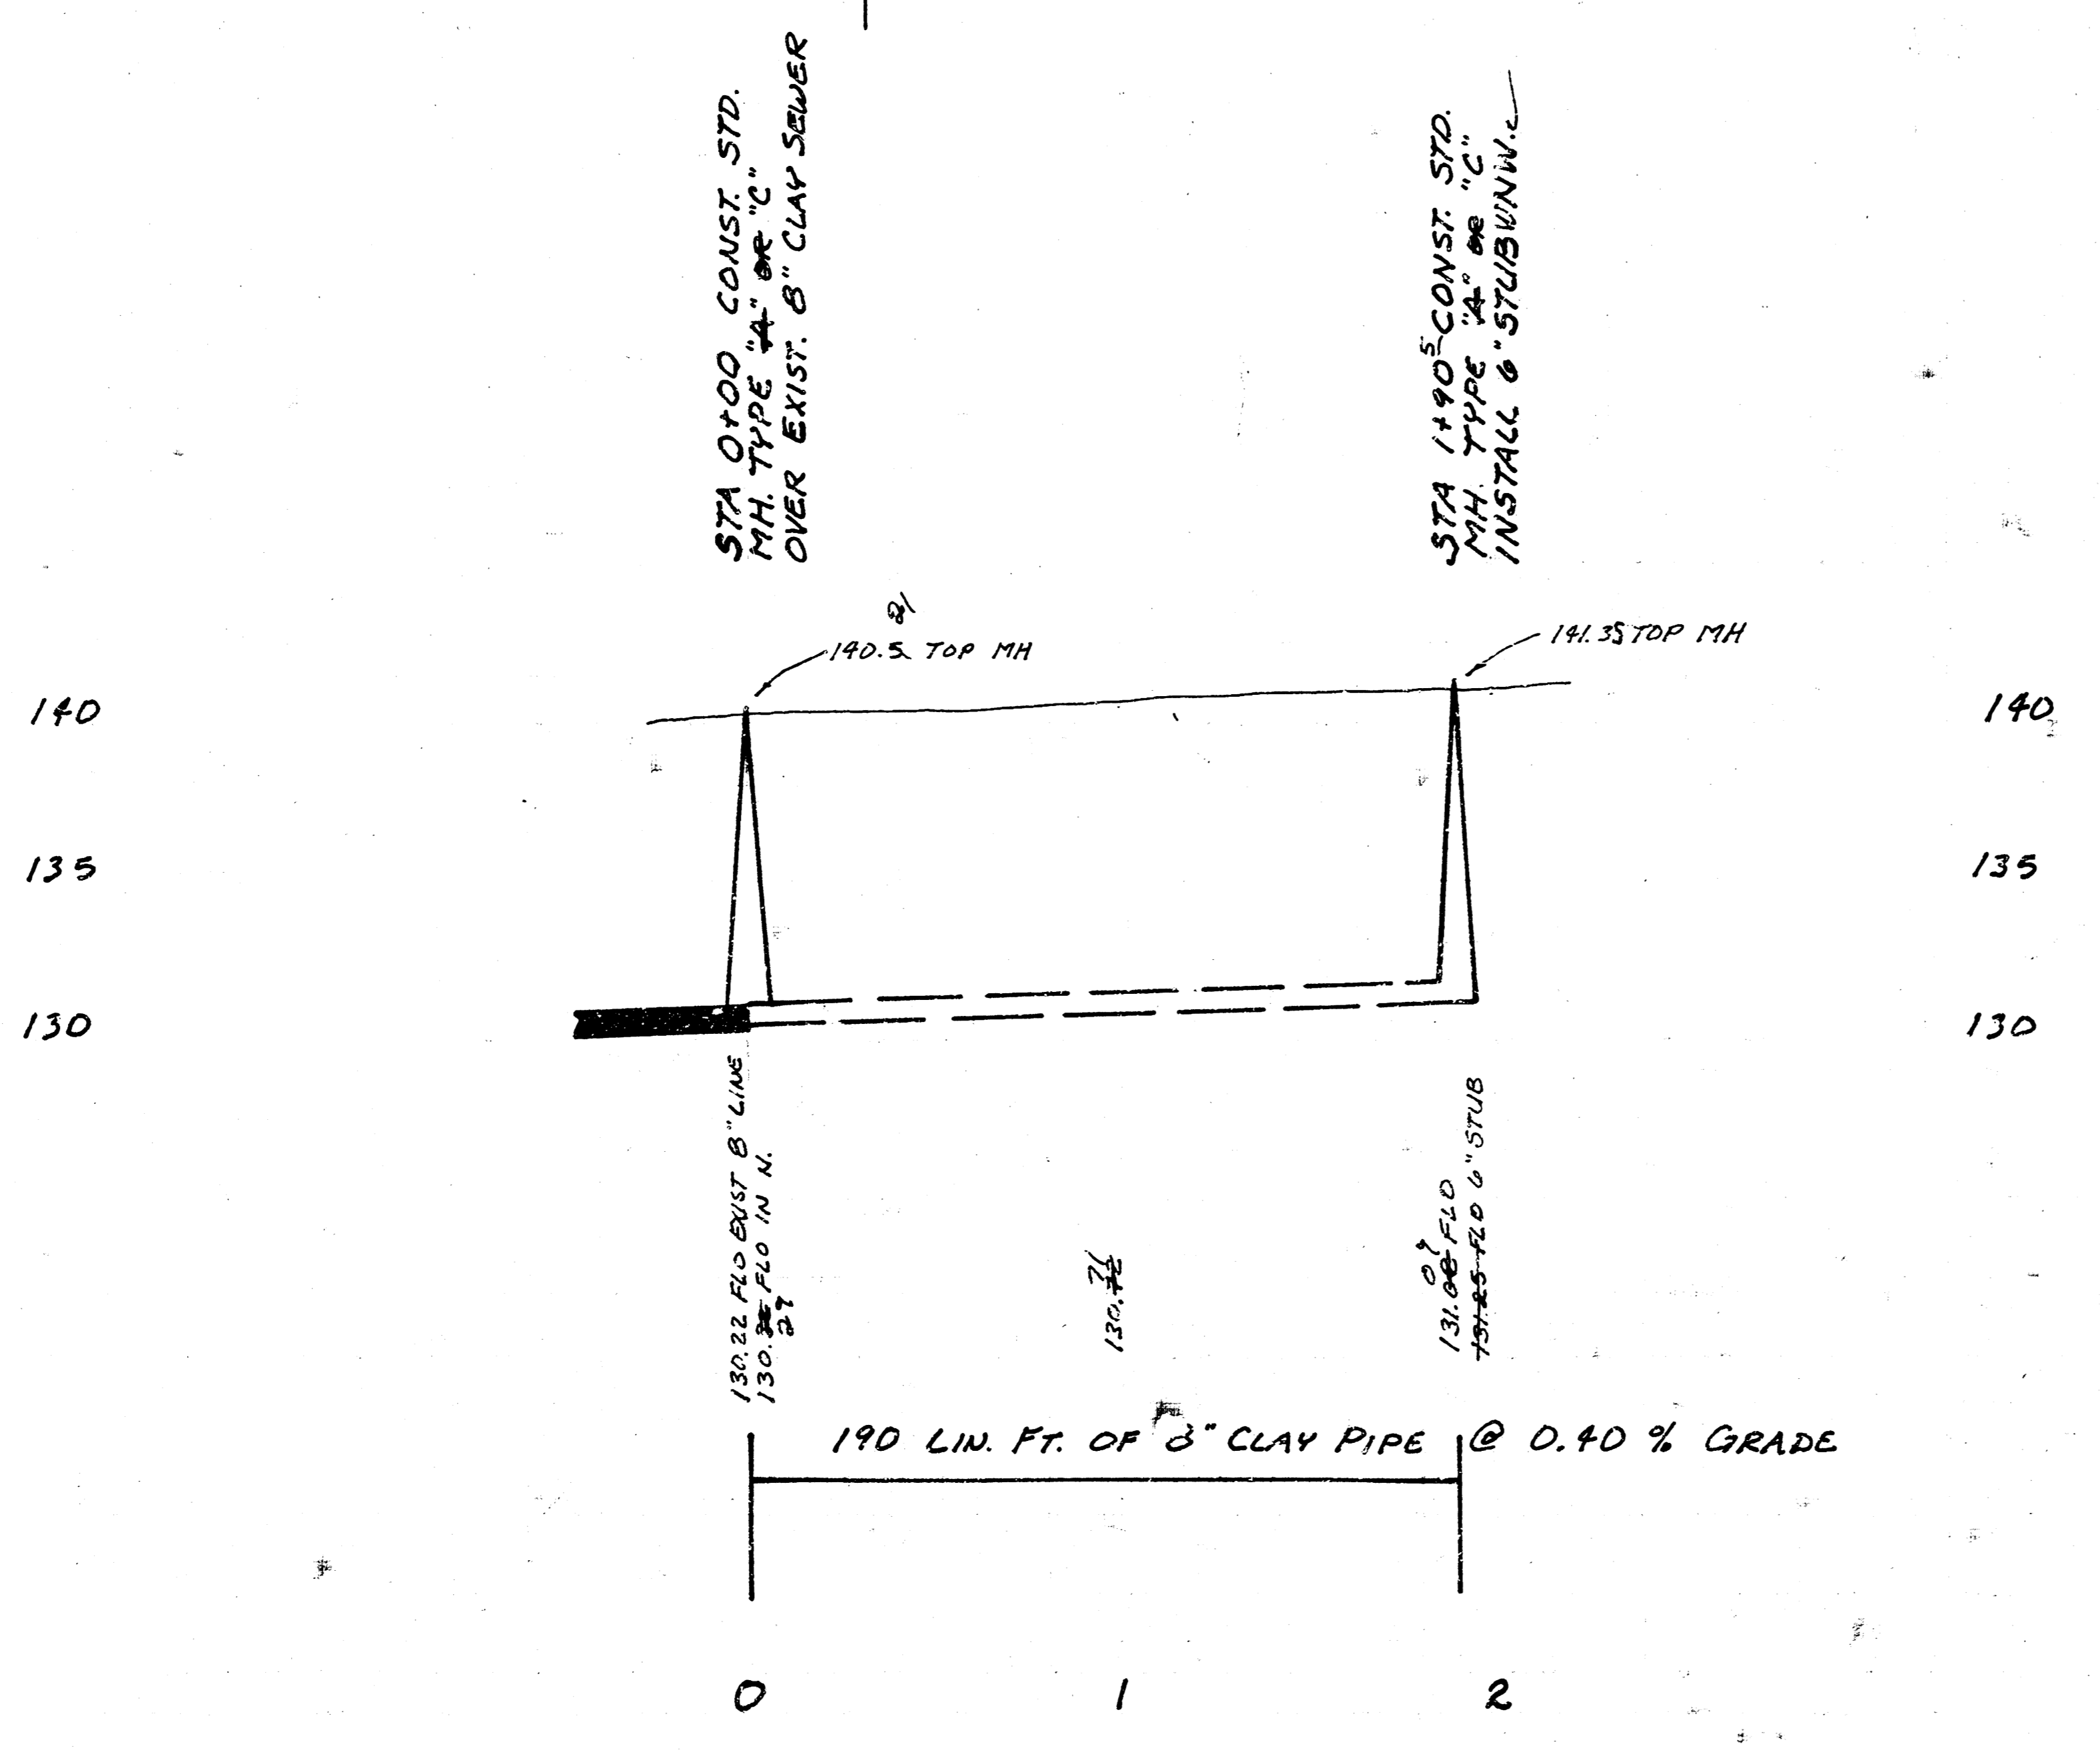

|  |             |      |
|--|-------------|------|
| PROJECT DESCRIPTION                    |             |      |
| LAT 113, MAIN 4, SANITARY SEWER NO. 23 |             |      |
| PROJECT NUMBER                         |             |      |
| 879-56-890-50134-295-000-000           |             |      |
| BOOK NO.                               | APPROVED BY | DATE |
| DRAWN BY LOOMIS                        |             |      |
| CITY OF WICHITA                        |             |      |
| DEPARTMENT OF ENGINEERING              |             |      |
| CITY ENGINEER                          | SCALE       |      |
| M.E. LINDBAK                           | 1"          |      |