




NOTE: FIELD ENGINEER TO ESTABLISH SEWER ALIGNMENT USING GIVEN DIMENSIONS AND ANGLES FROM THE S. E. CORNER OF THE N. E. QUARTER OF SEC. 1, T27S, R1E OF 6TH P.M.

NOTE TO CONTRACTOR
The project will be constructed under the supervision of the CITY ENGINEER and conforming to the SPECIFICATIONS of the CITY OF WICHITA. The CONTRACTOR will reimburse the City of Wichita for all cost of Engineering, Plans, and Inspection.

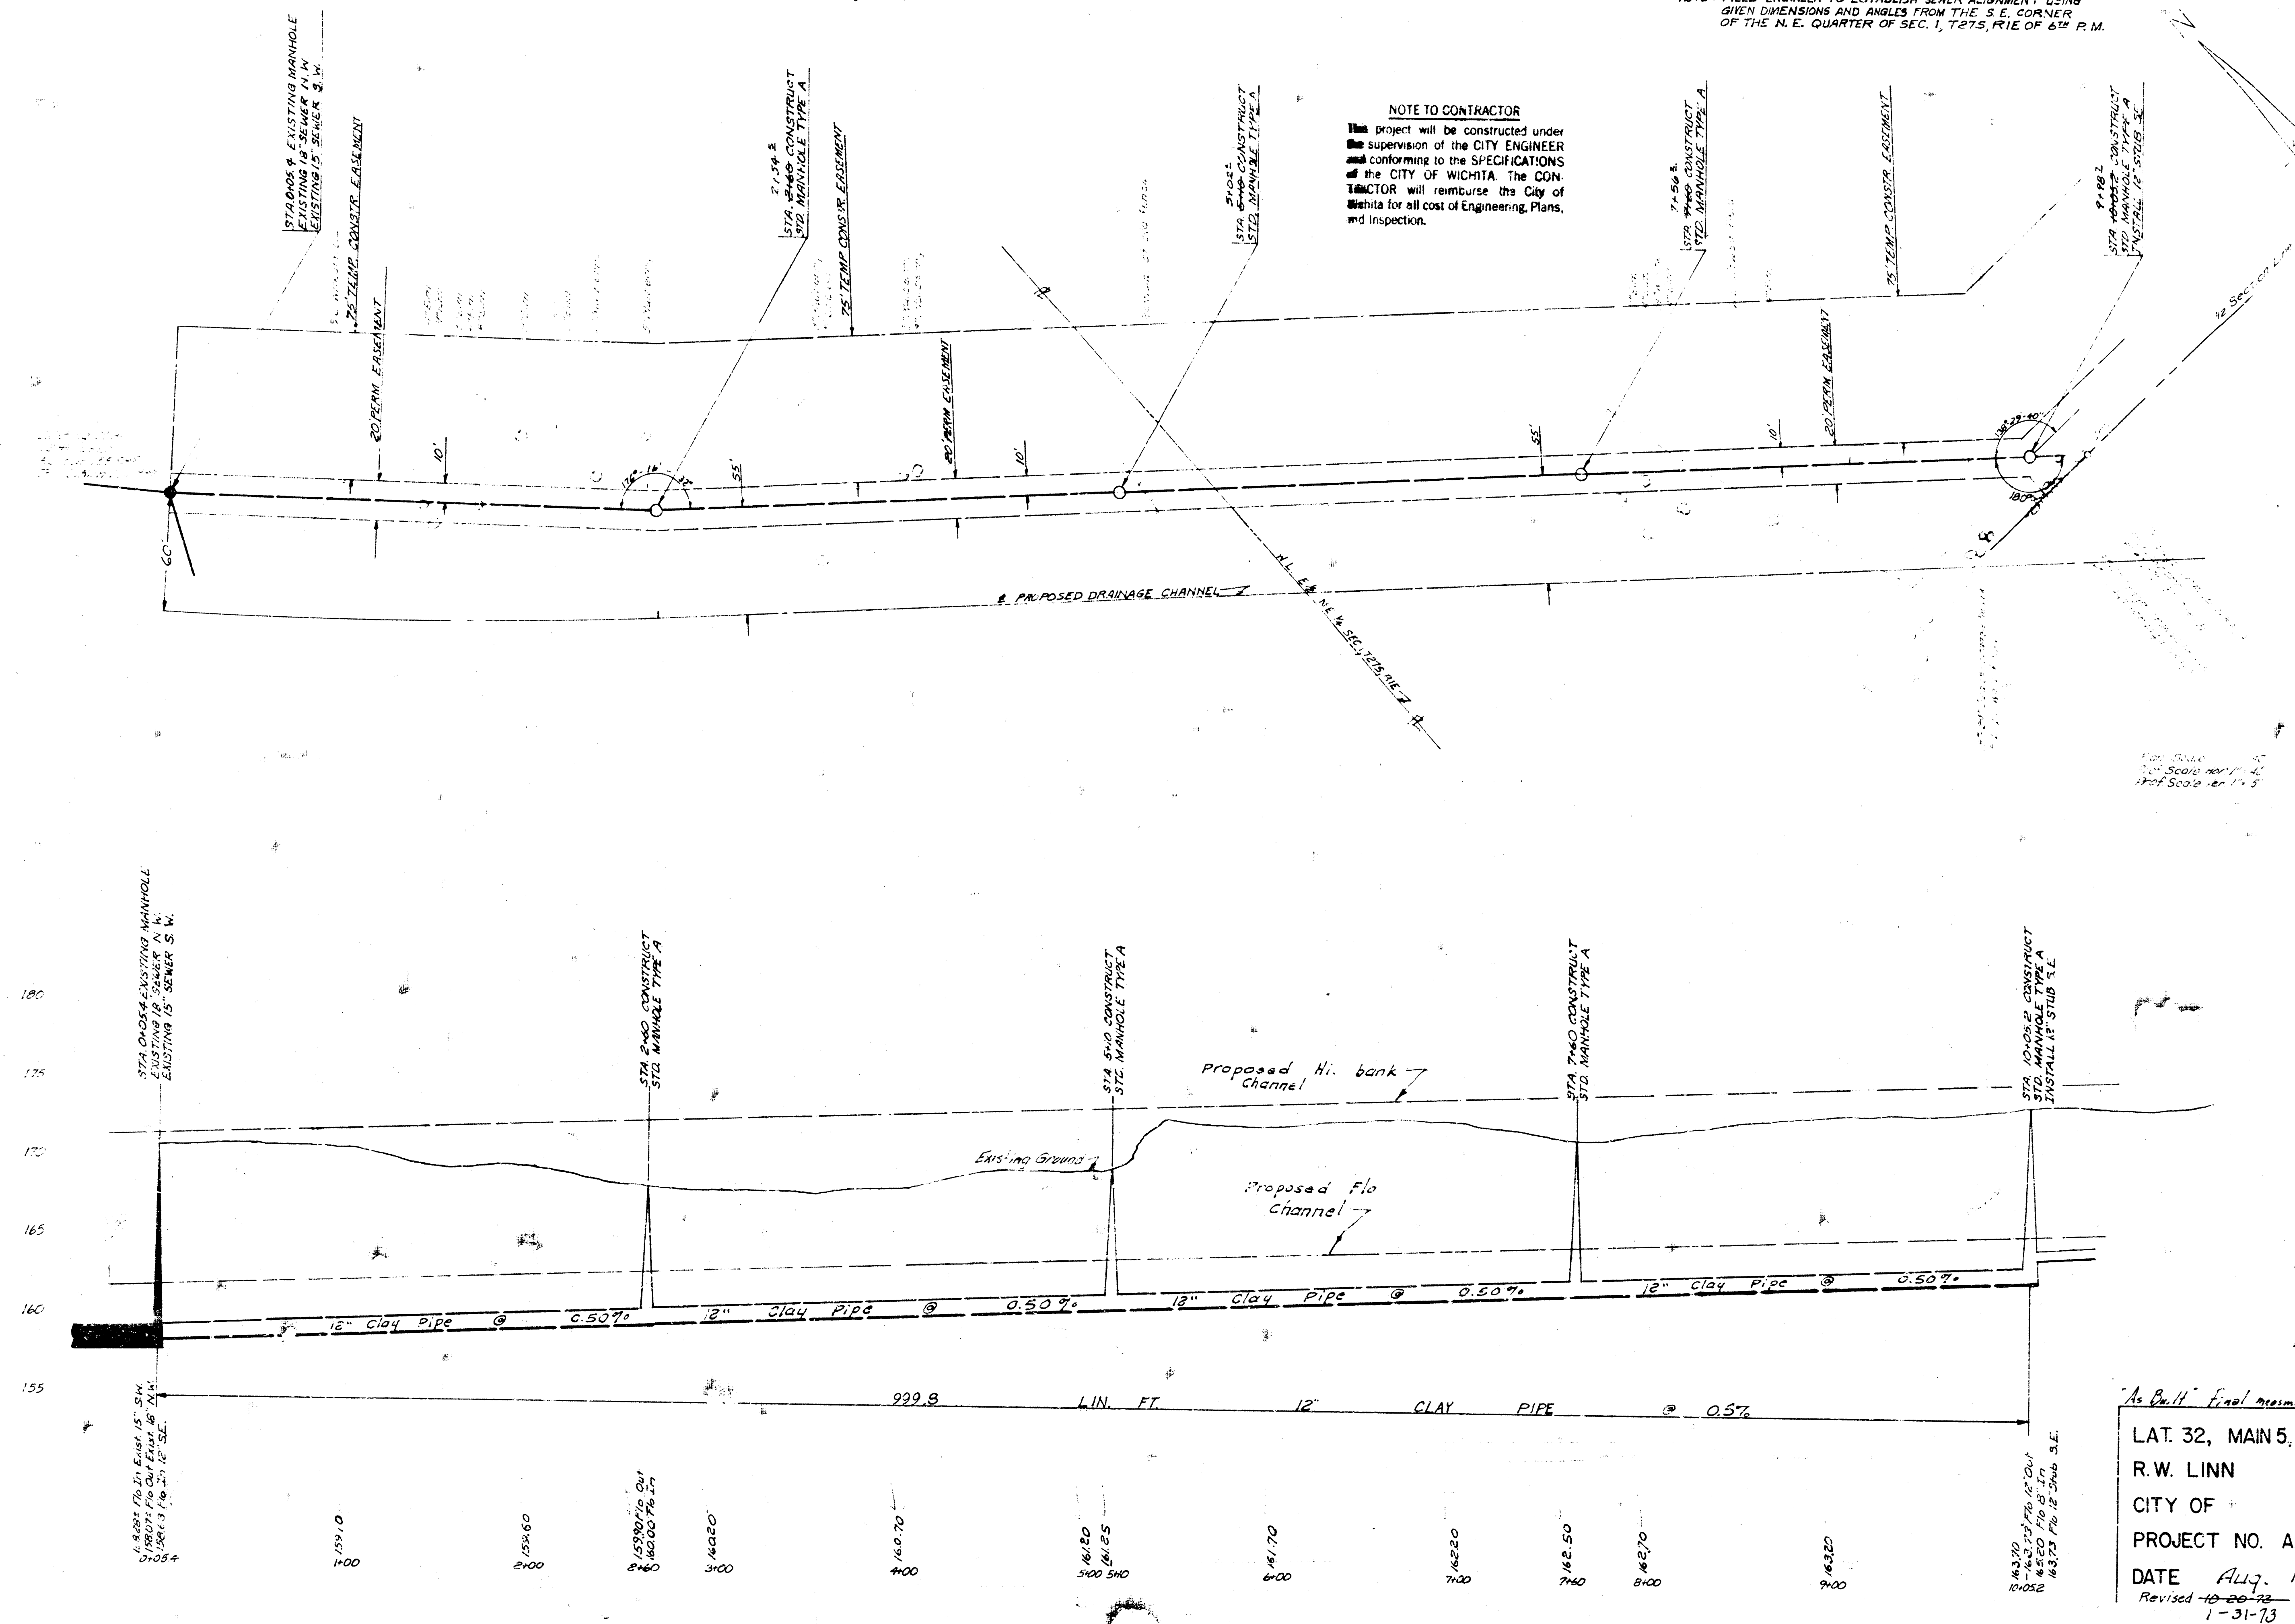

PLAN - 180°

B. M. 200.65 CITY STD. @ N.E. COR. WOODLAWN & 21ST ST.

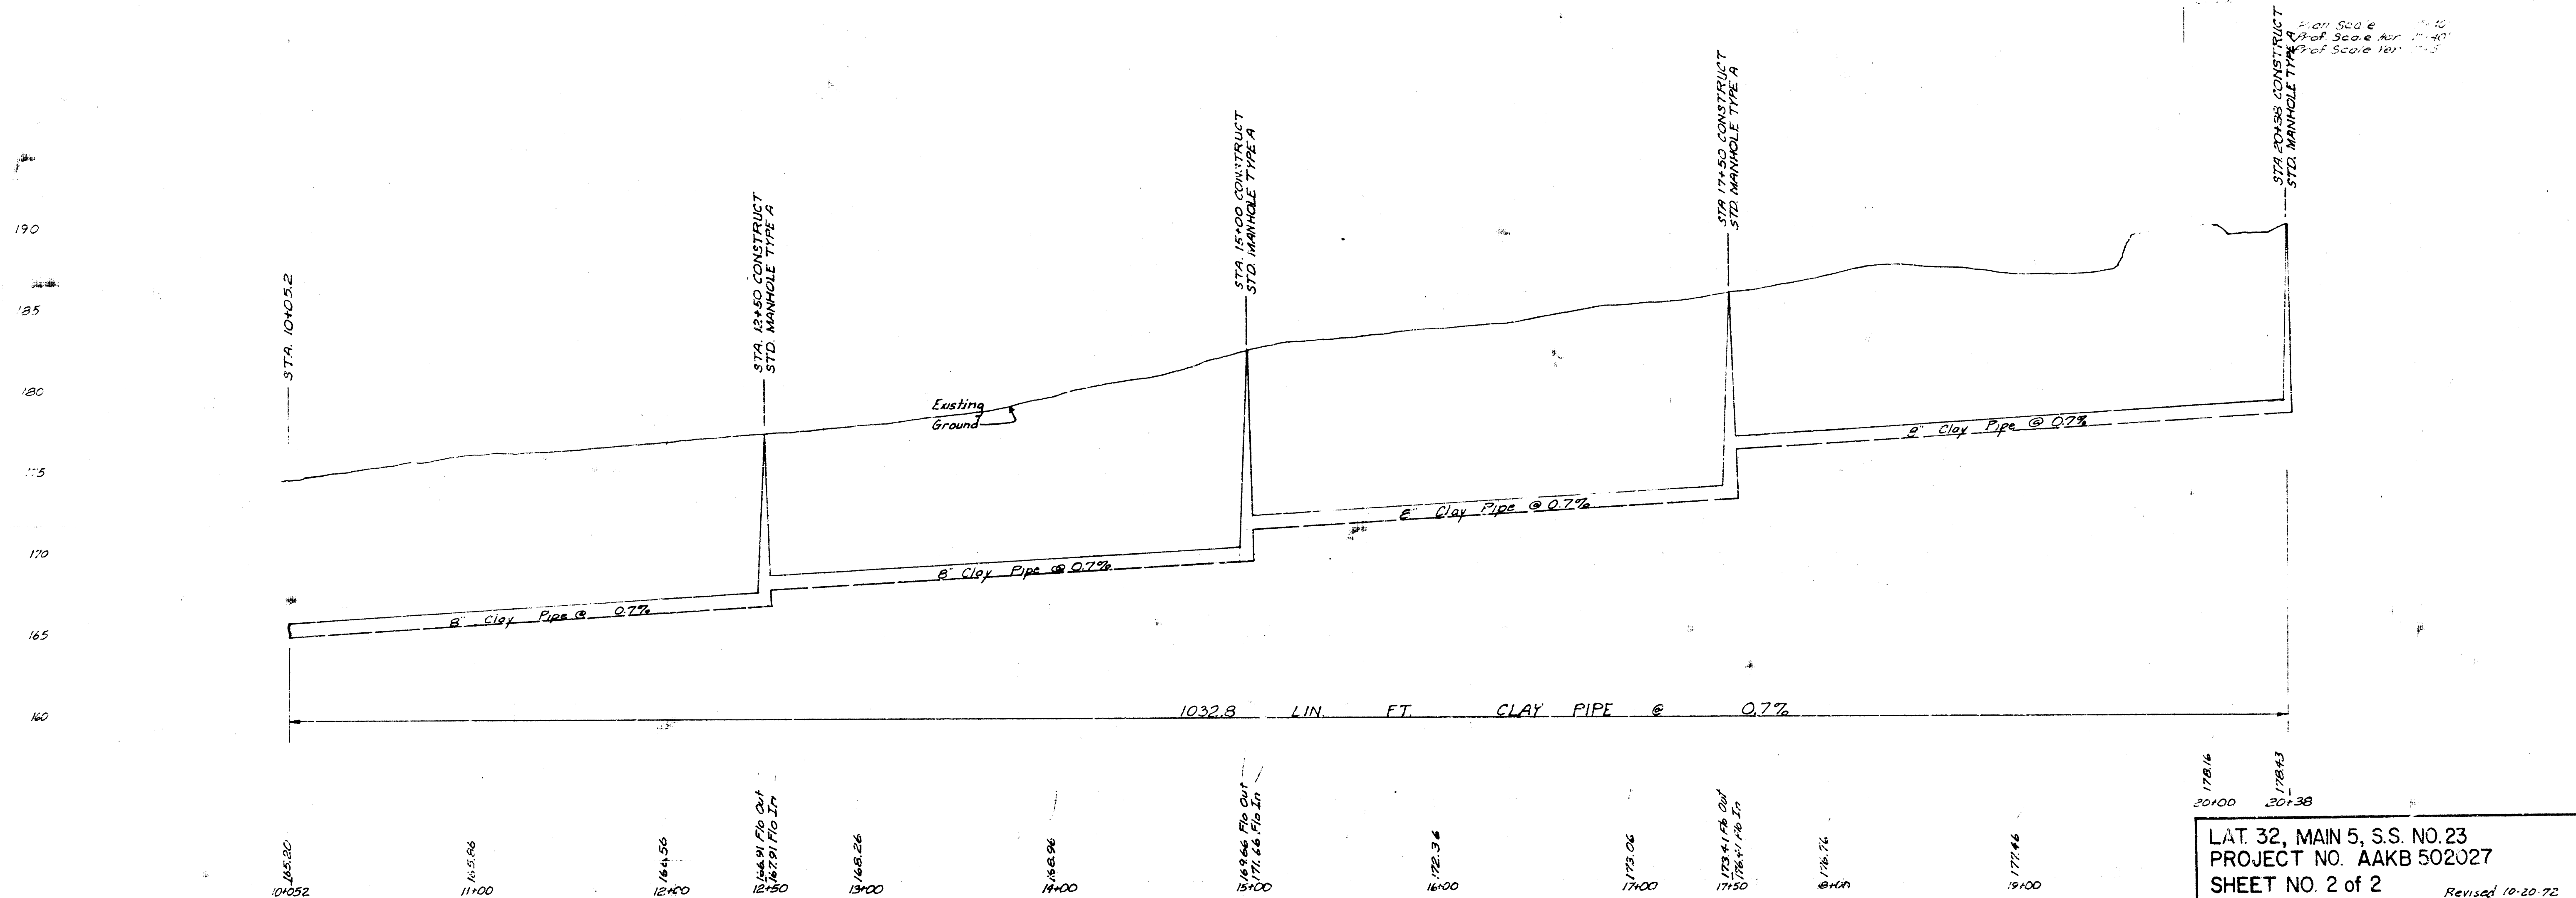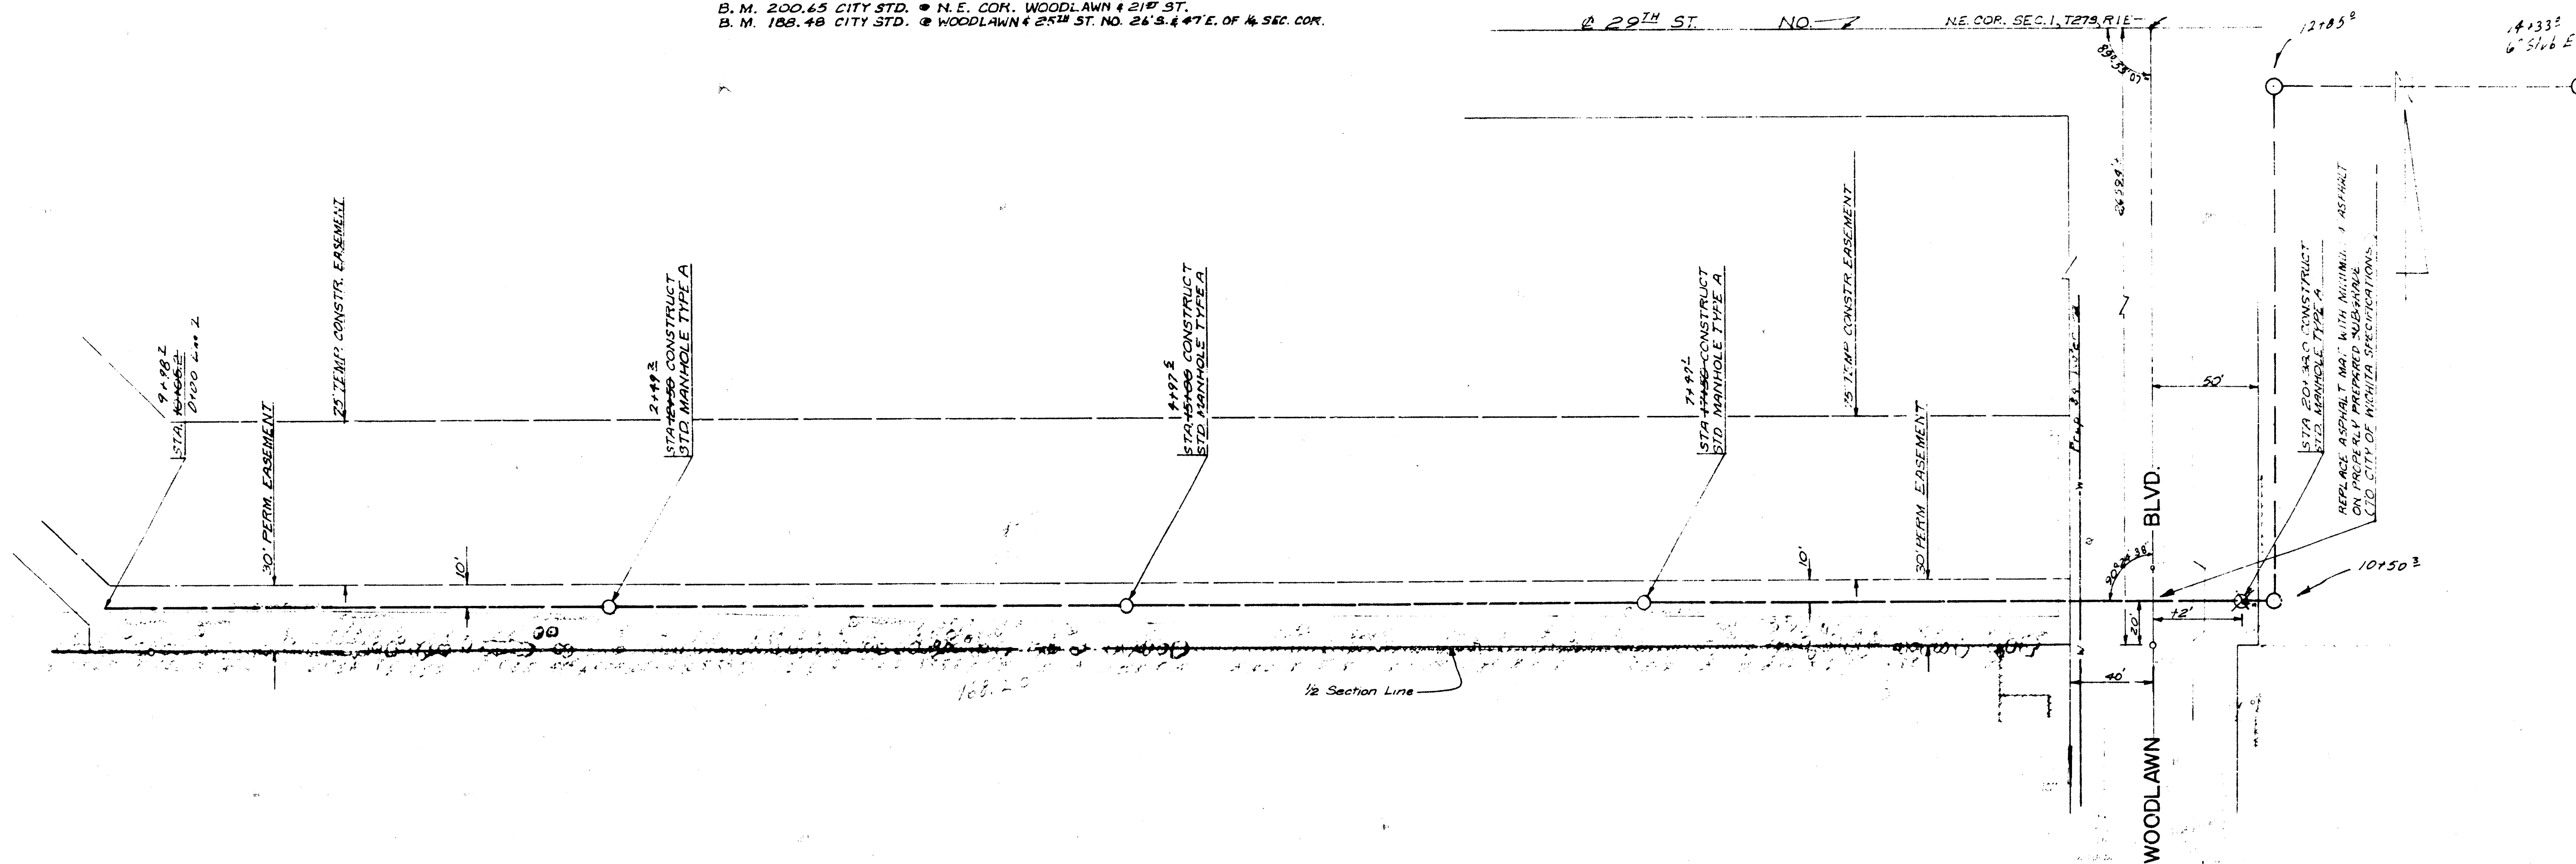

LAT. 32, MAIN 5, S.S. NO. 23
PROJECT NO. AAKB 502027
SHEET NO. 2 of 2
Revised 10-20-72