



LAT 36 MAIN 5 S.S. NO. 23
CITY OF WICHITA, KS.

R. W. LINN ——— CITY ENGINEER

PROJECT NUMBER: DBKL577071
PLANS

SANITARY SEWER EXTENSIONS


WOODLAWN PLACE 3rd ADDITION

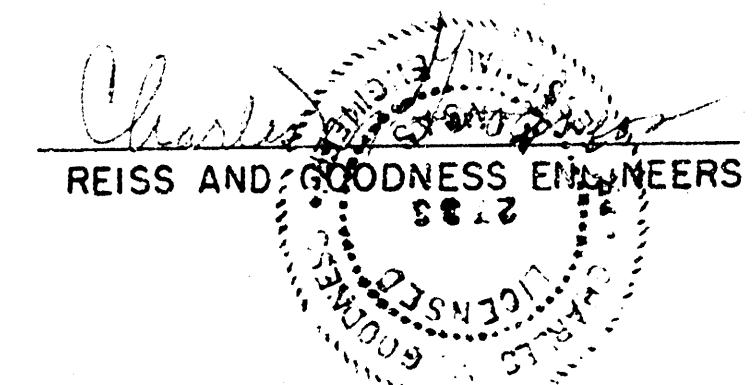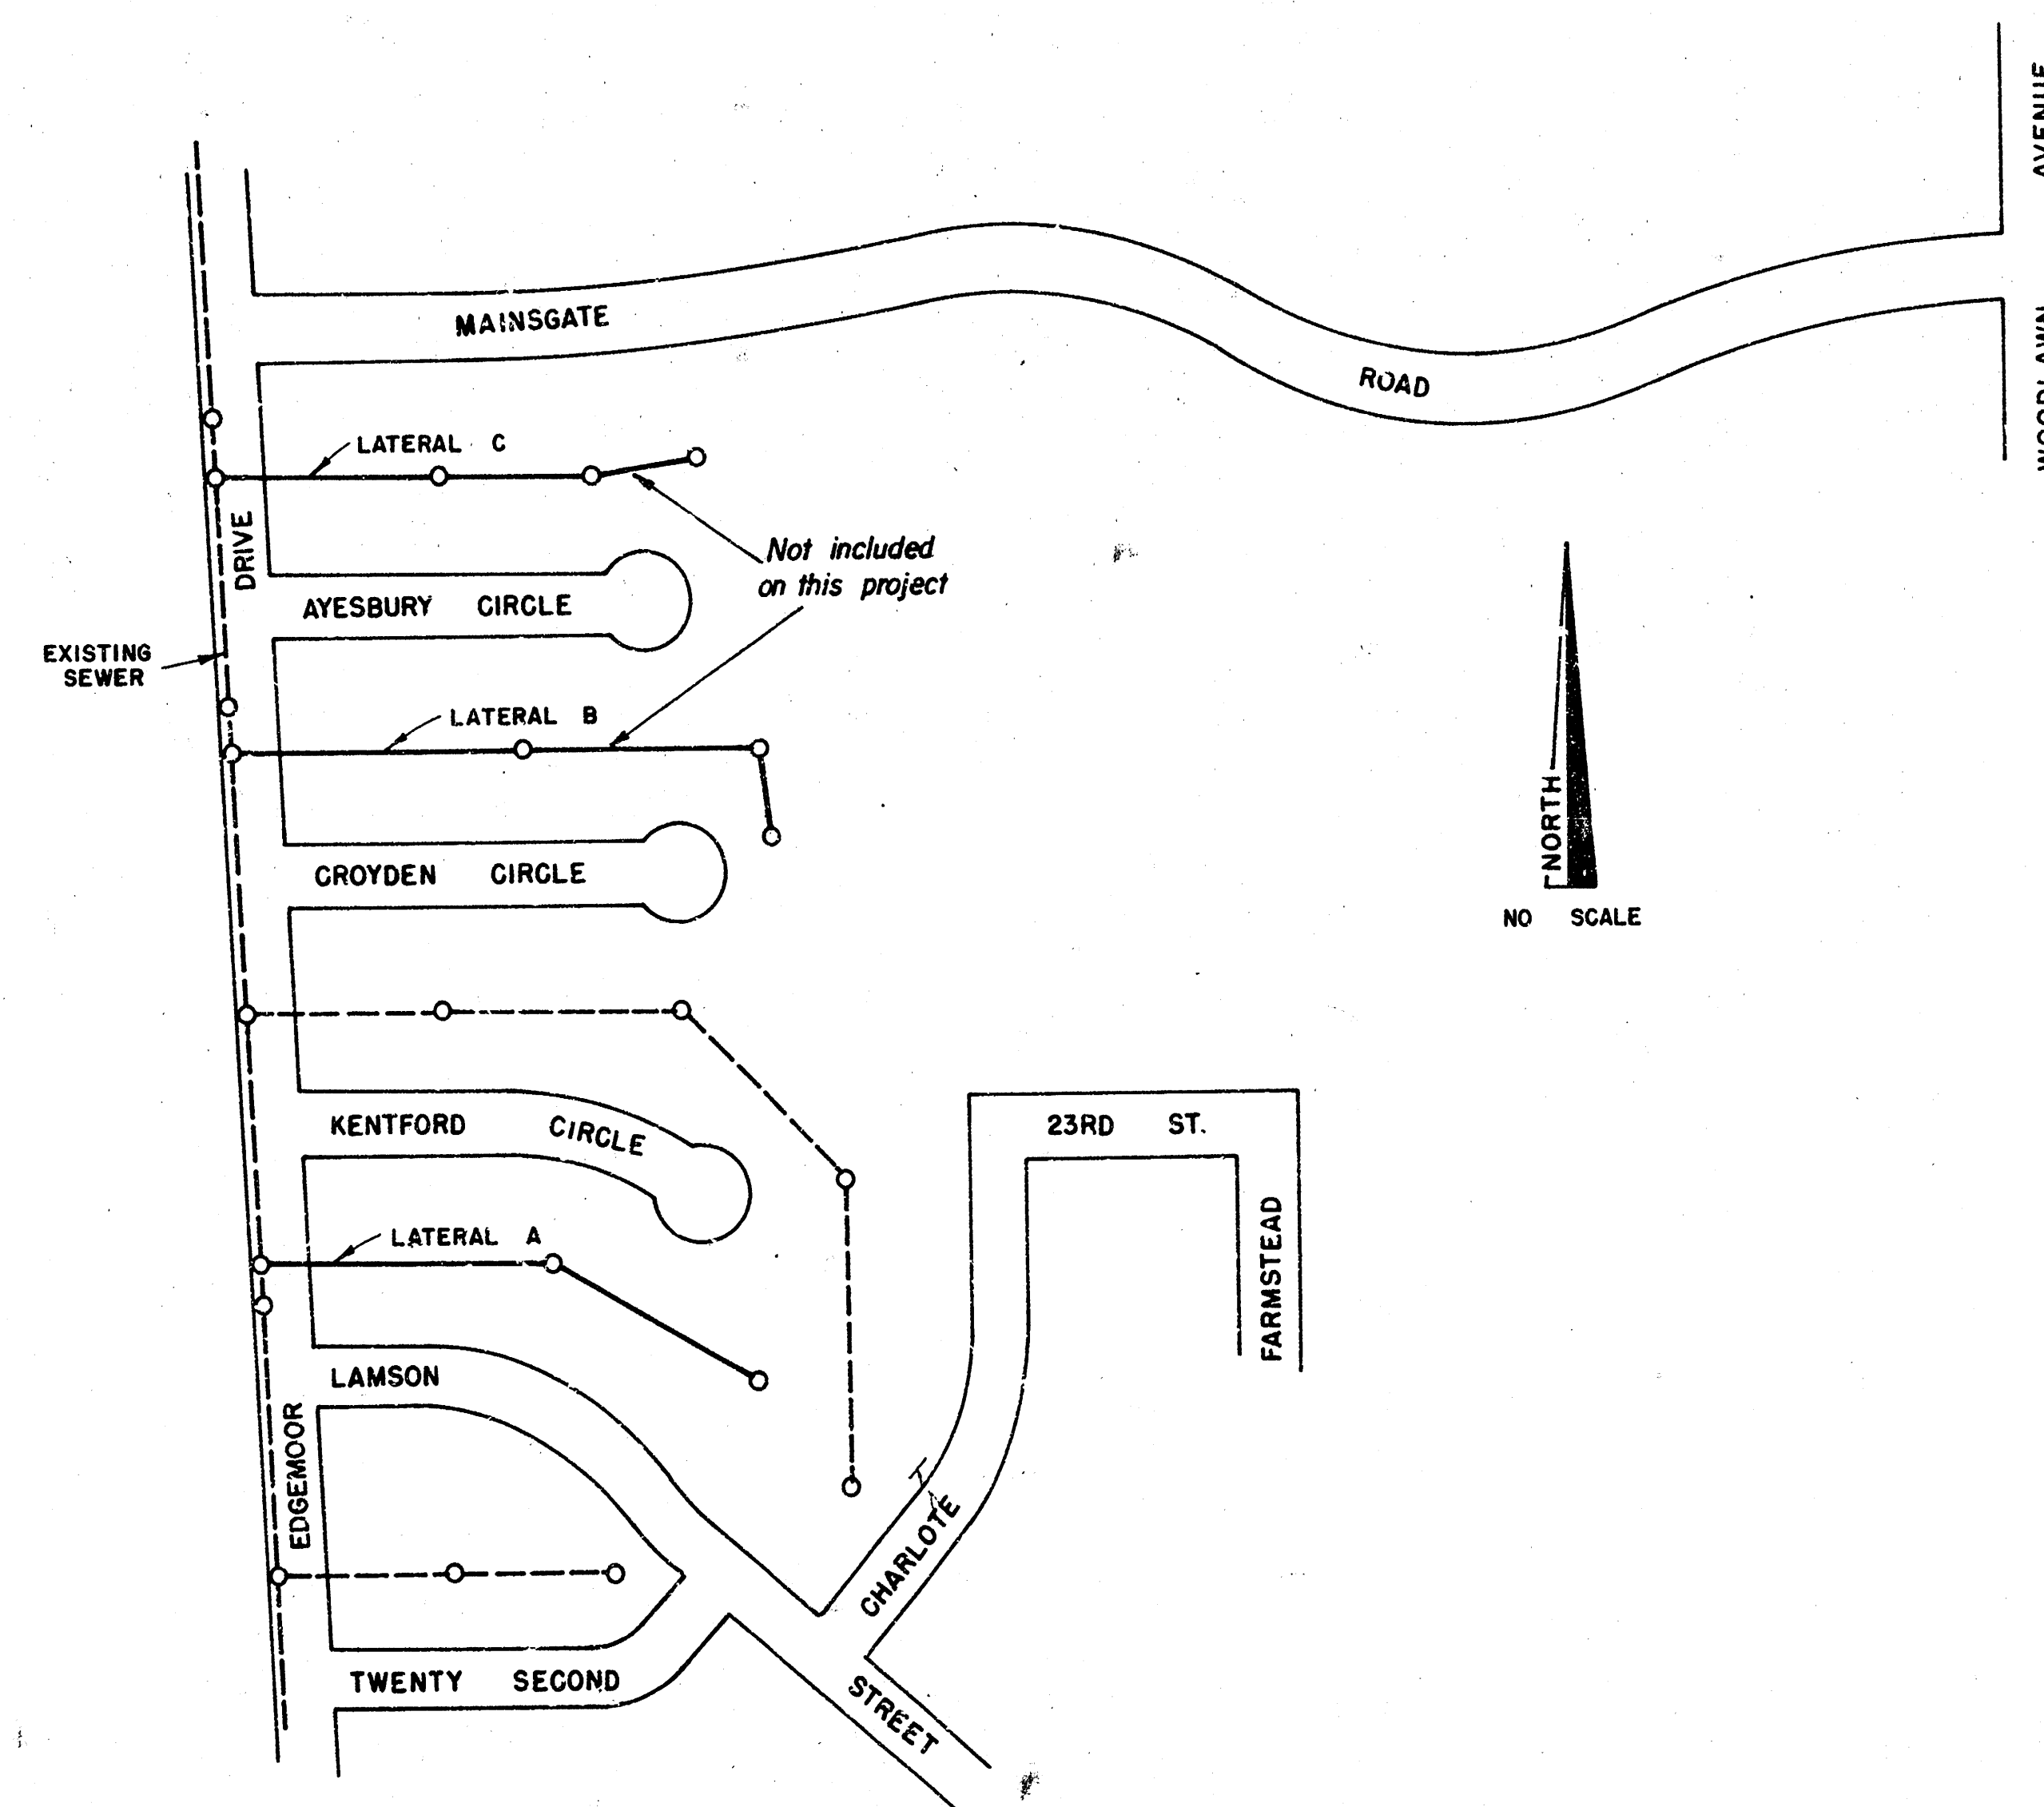

REISS & GOODNESS ENGINEERS
2160 WEST 21ST STREET
WICHITA, KANSAS 67204
(316) 832-0235



Note: Laterals B and C are not included on this project

NORTH
Scale 1" = 60'

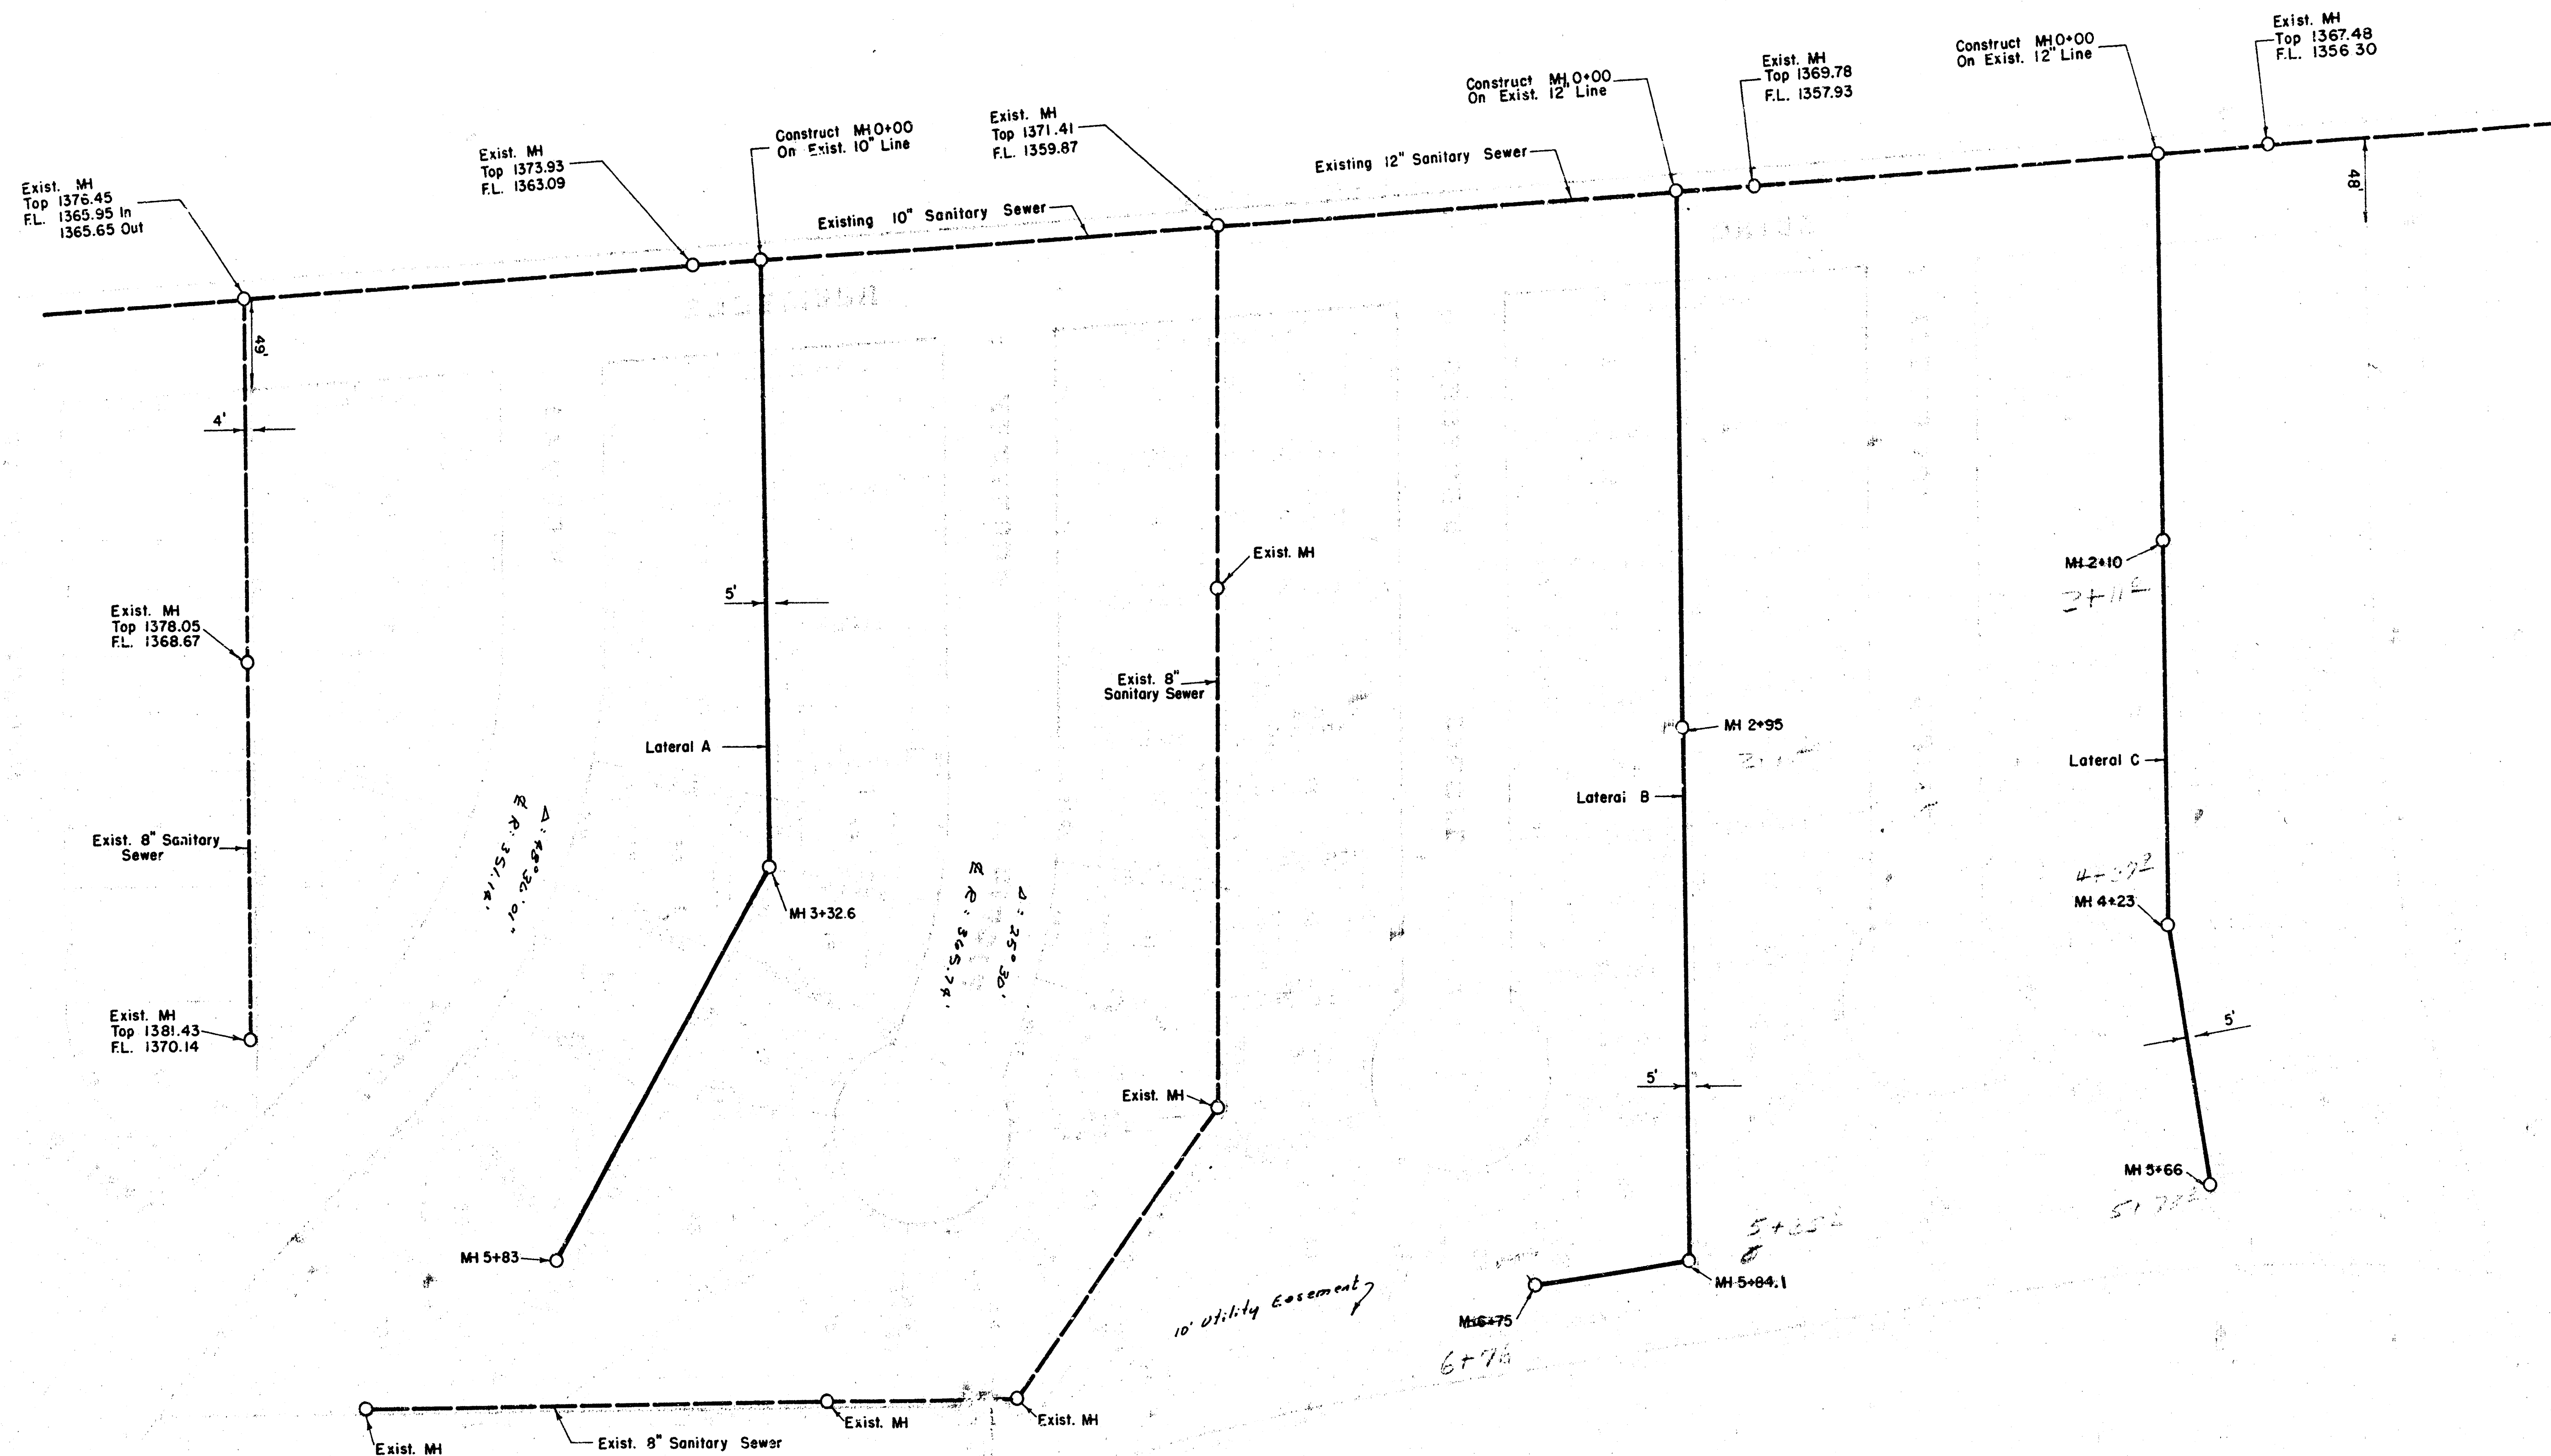



B.M. 1 1367.58 "□" Center Corc. Abutment N. Side
RCBG Mainsgate & 130' Drainage Easmt

B.M. 2 1368.43 Top Of Top Flange Bolt Mueller
Fire Hydrant At Mainsgate & Edgemoor

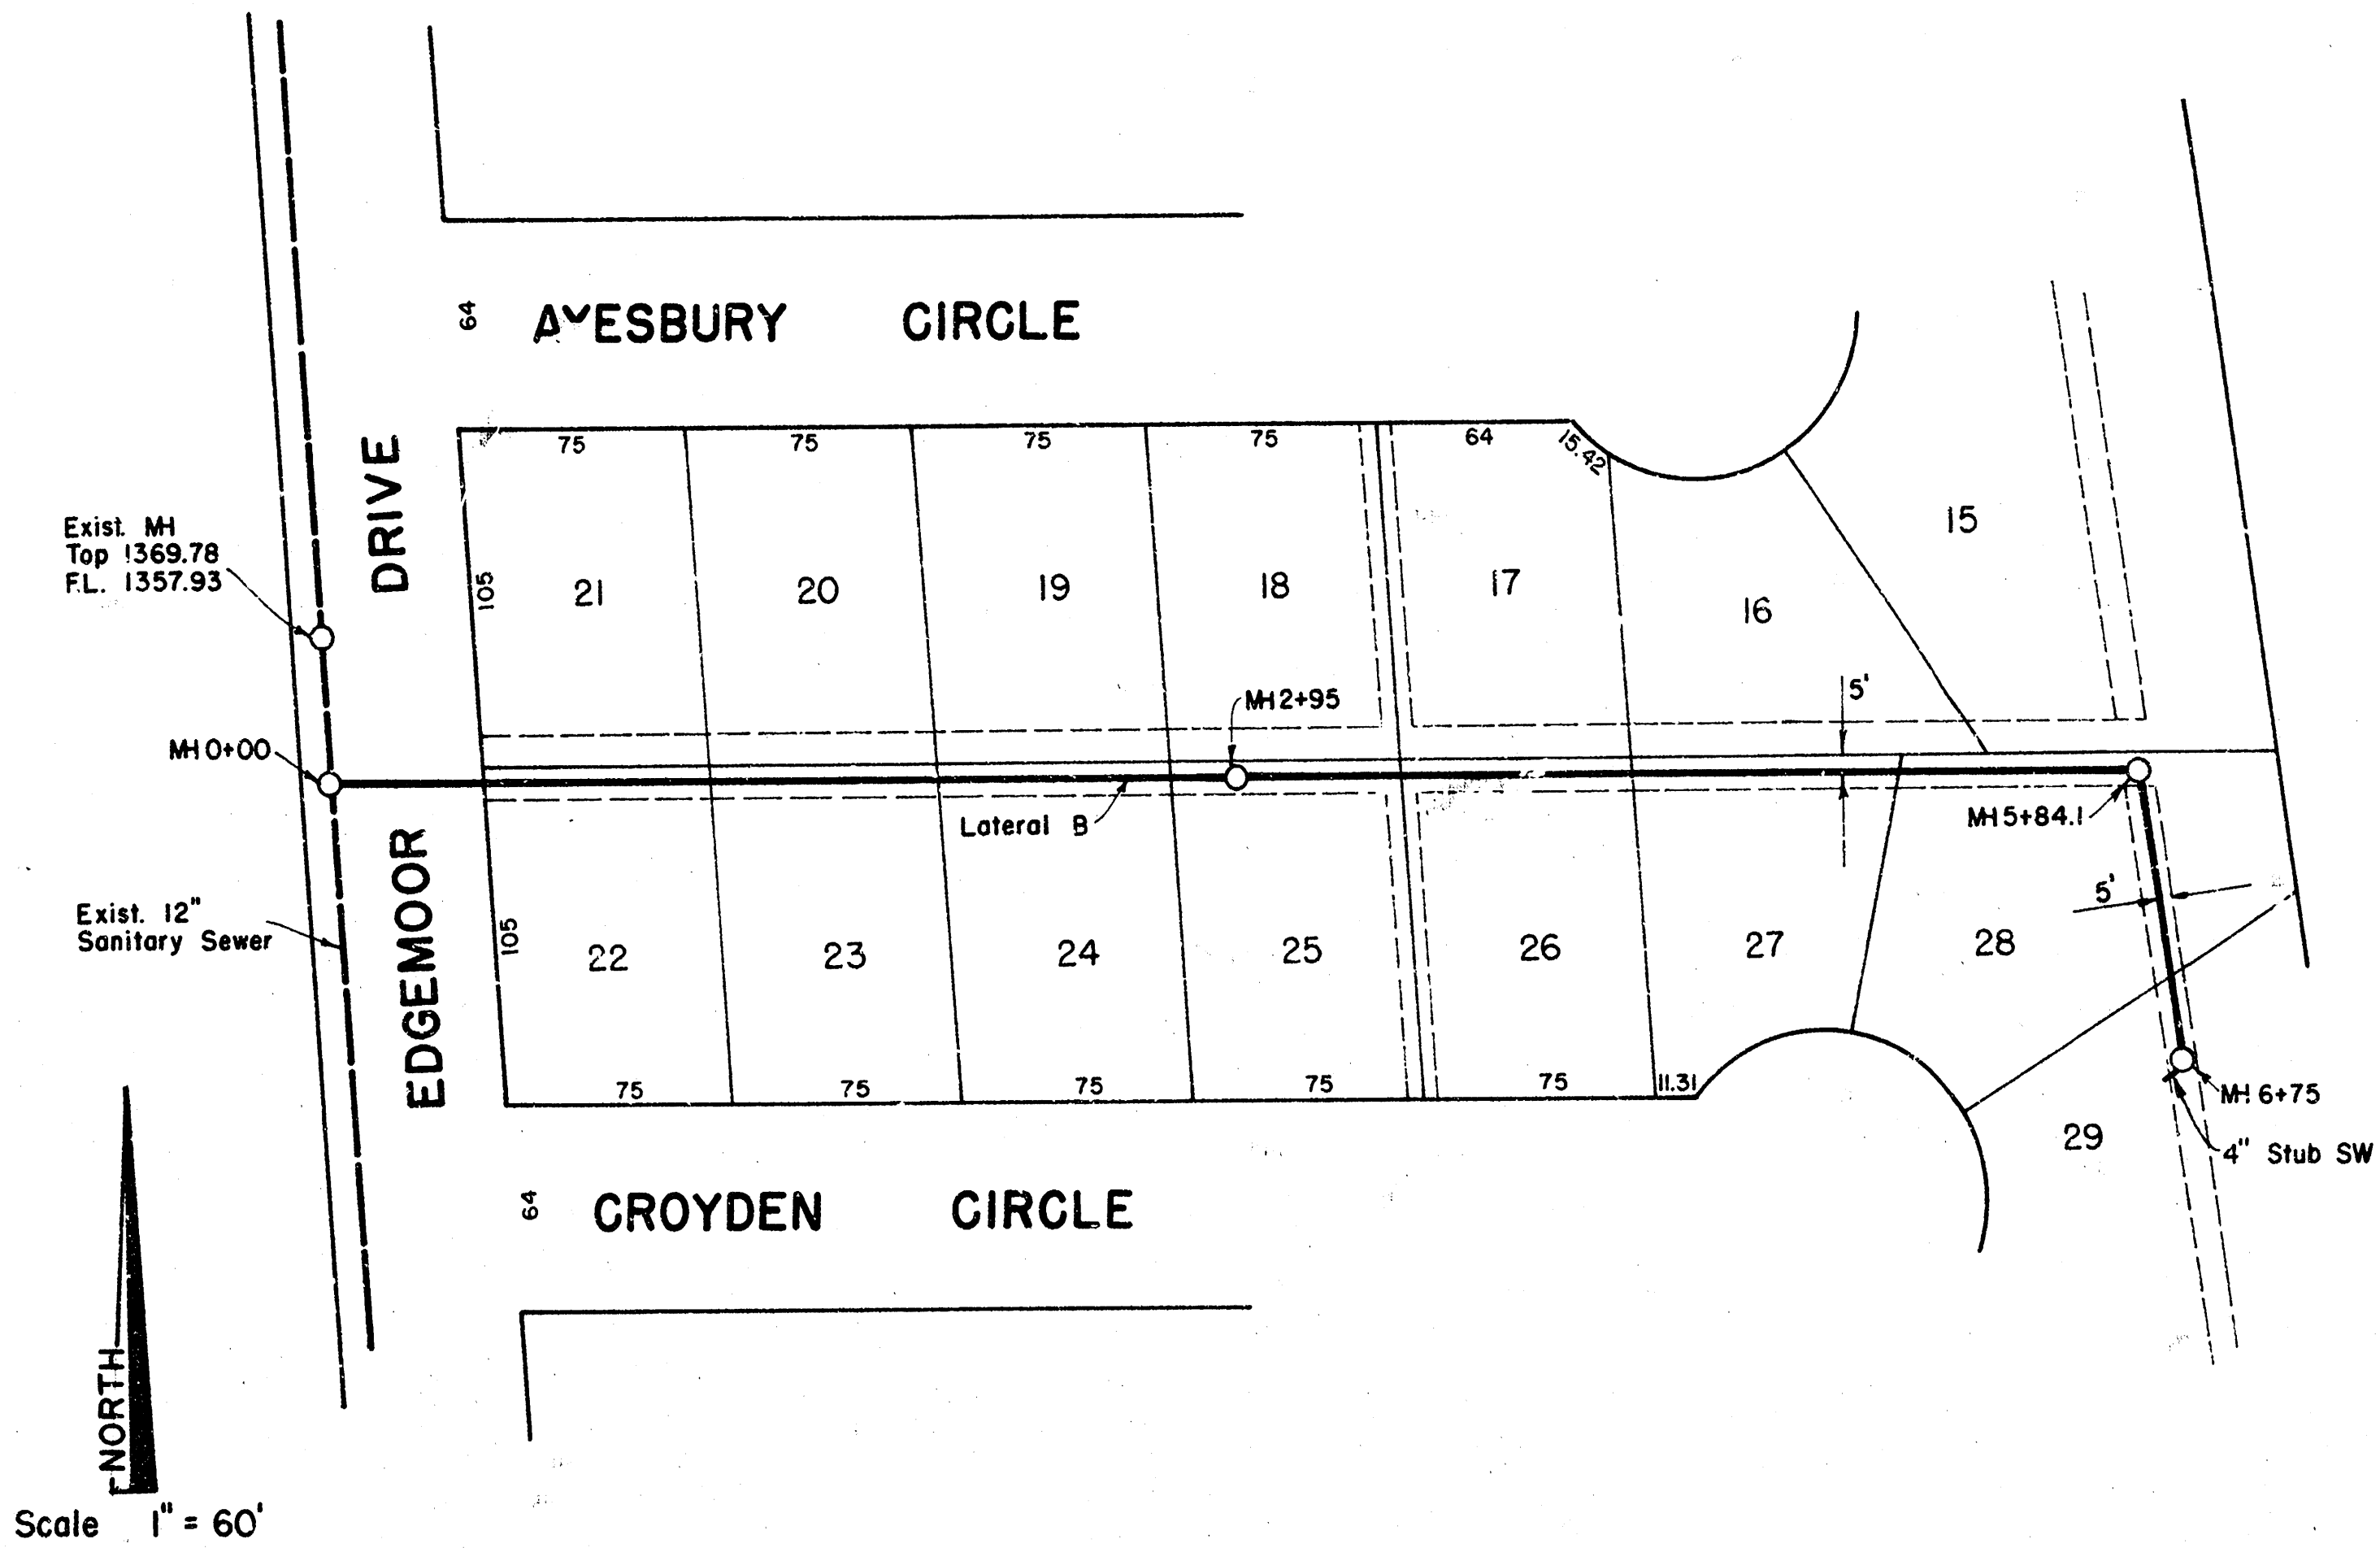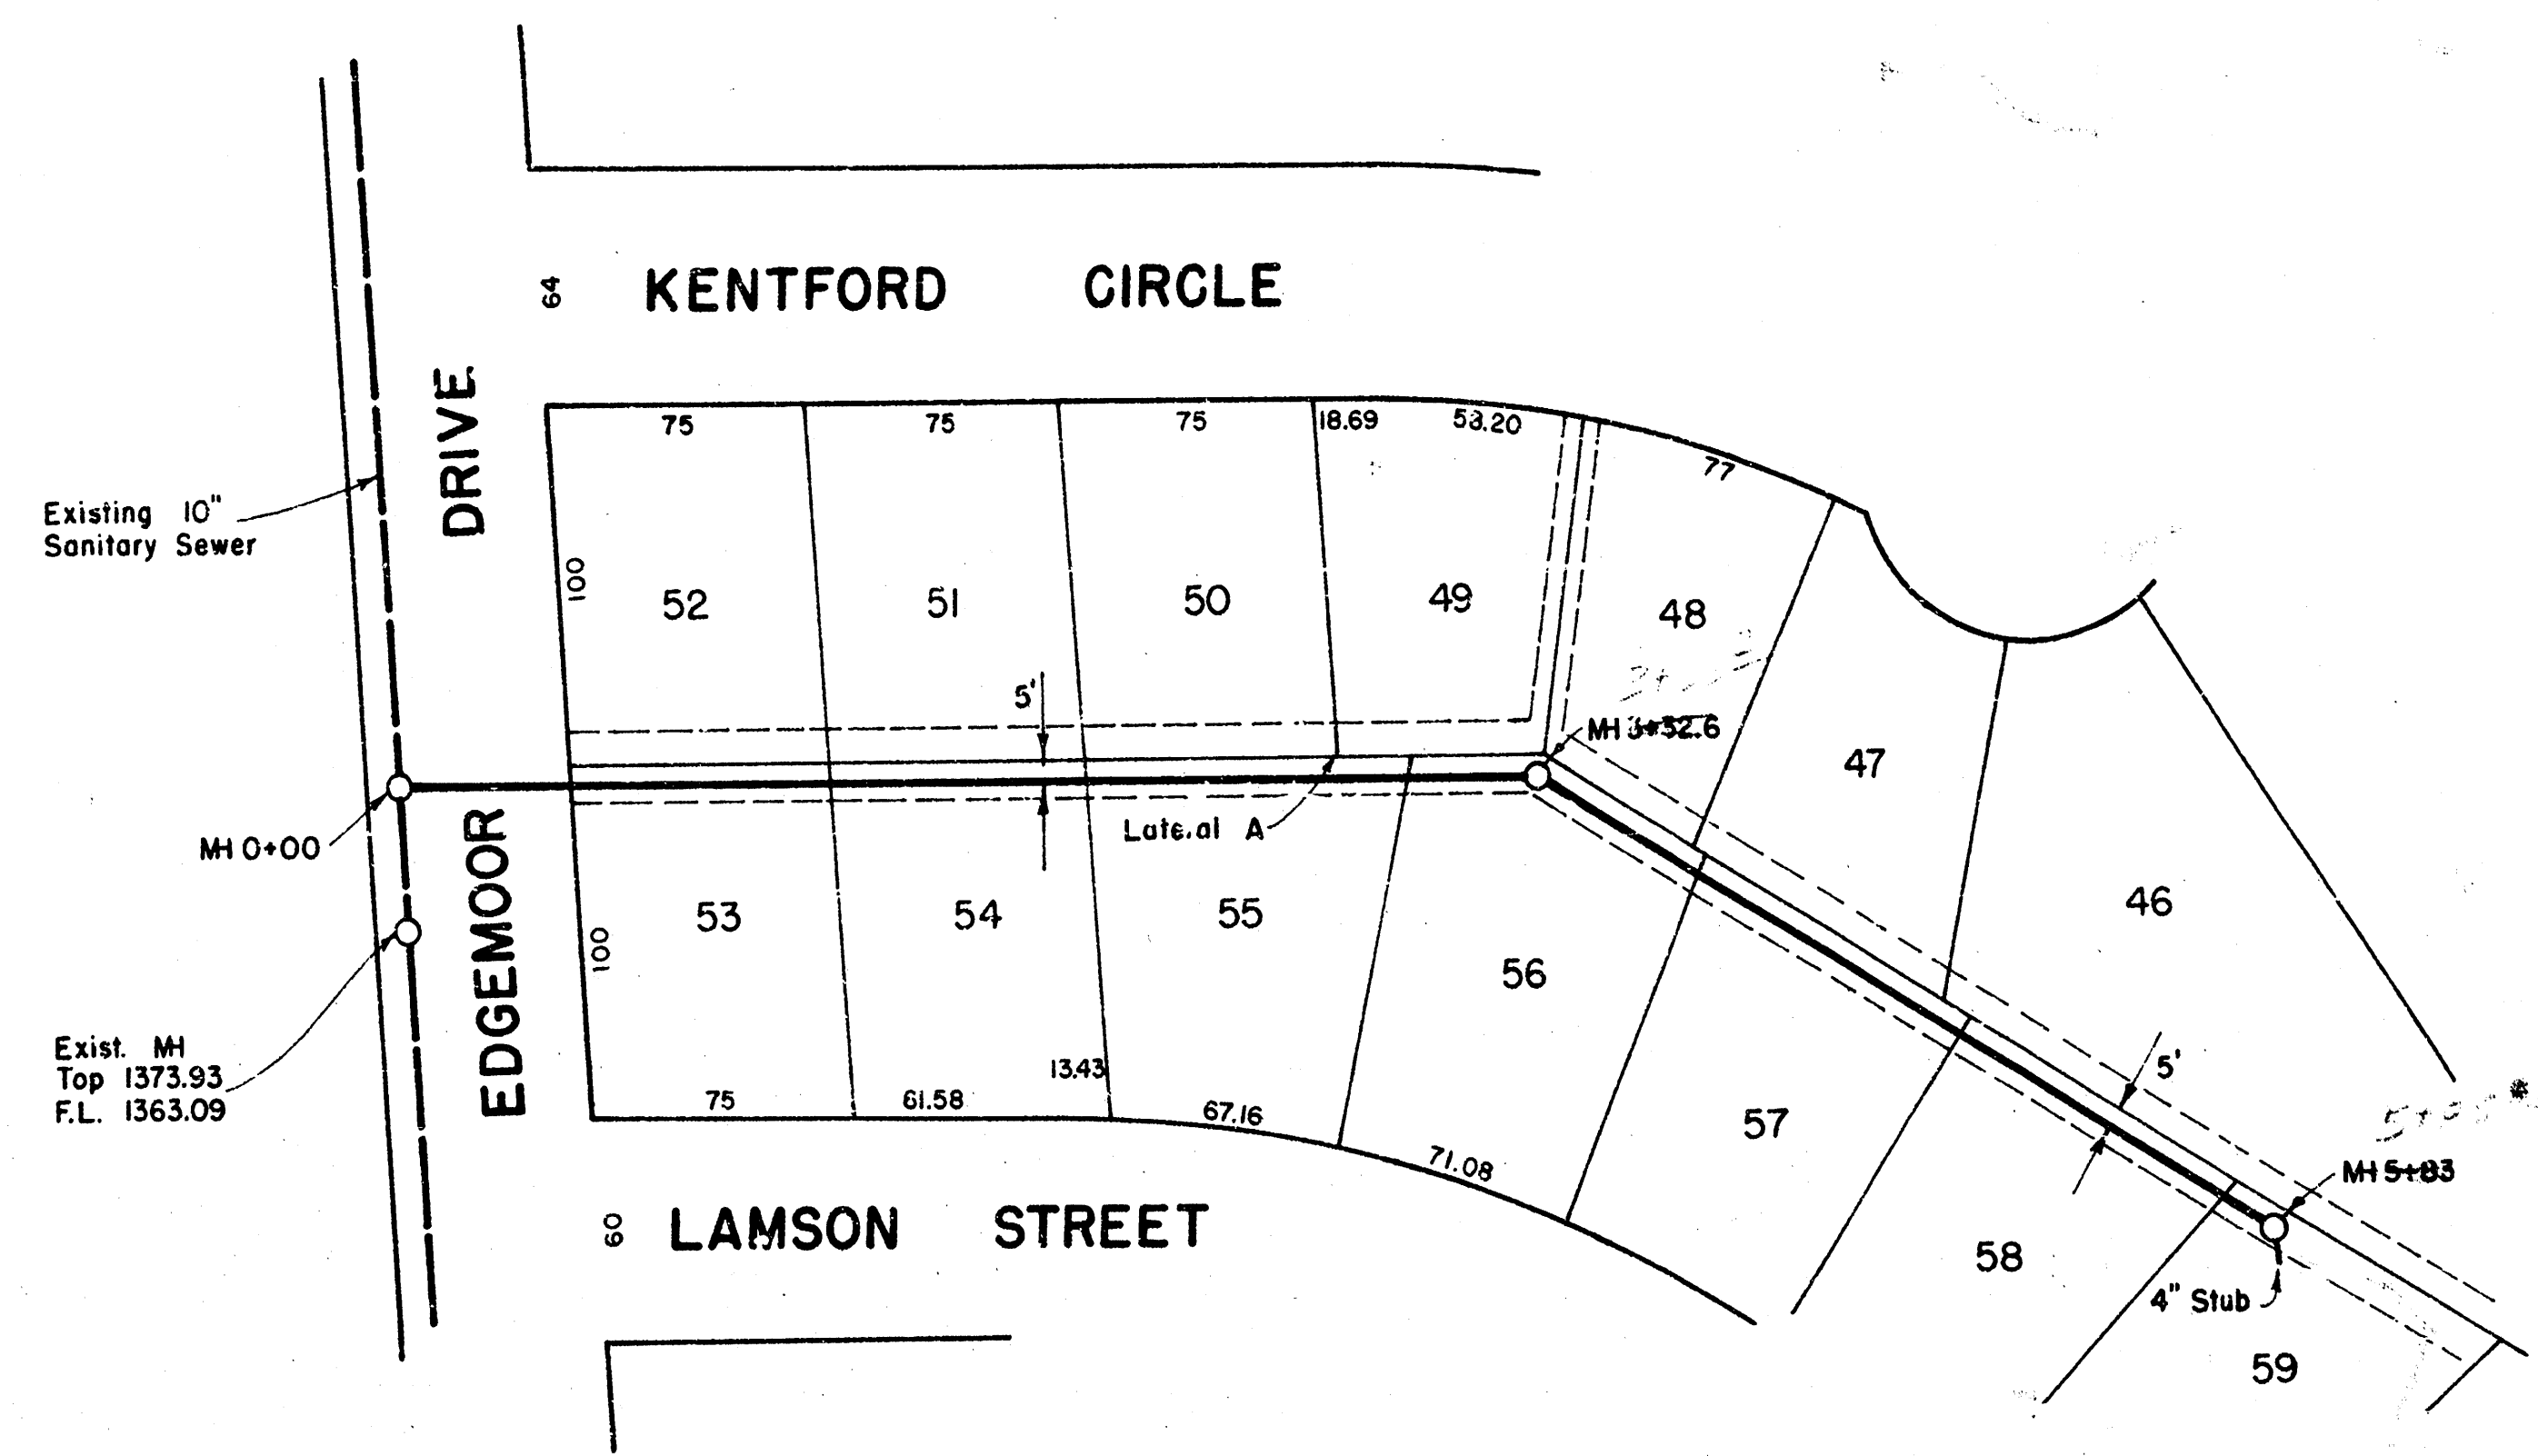

Lateral A
Scale 1" = 60' Horiz.
1" = 4' Vert.

Lateral B
Scale 1" = 60' Horiz.
1" = 4' Vert.

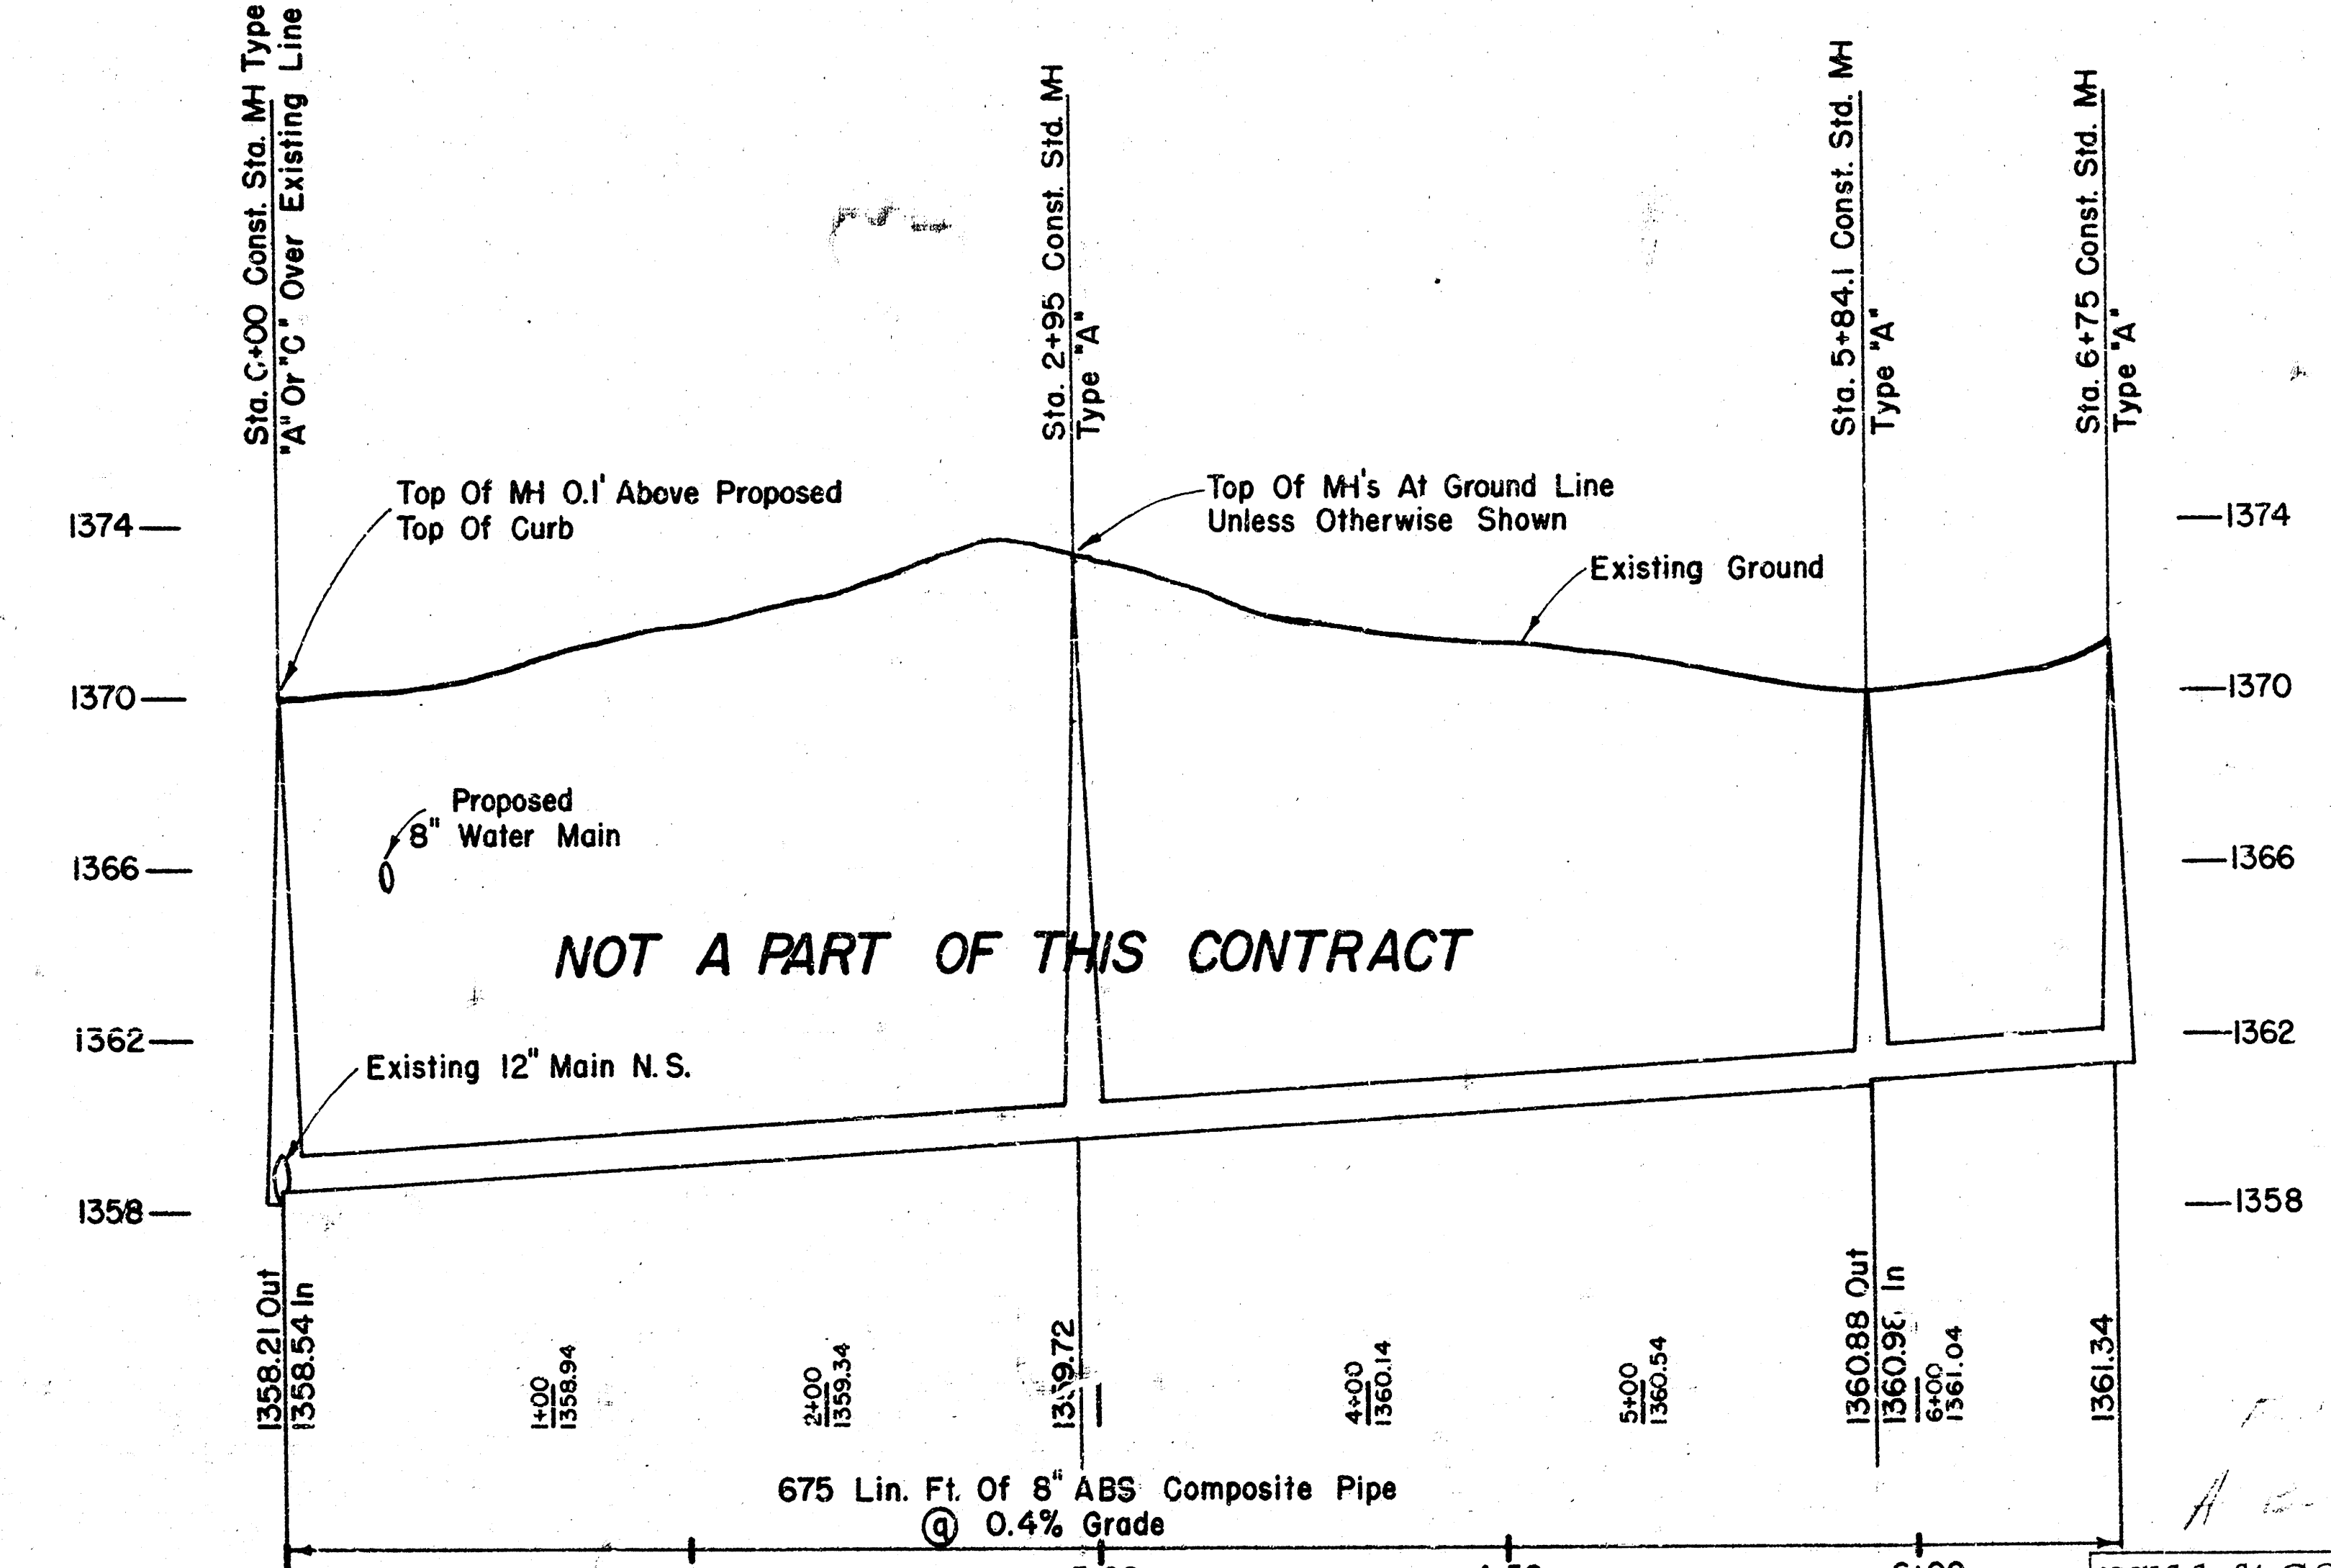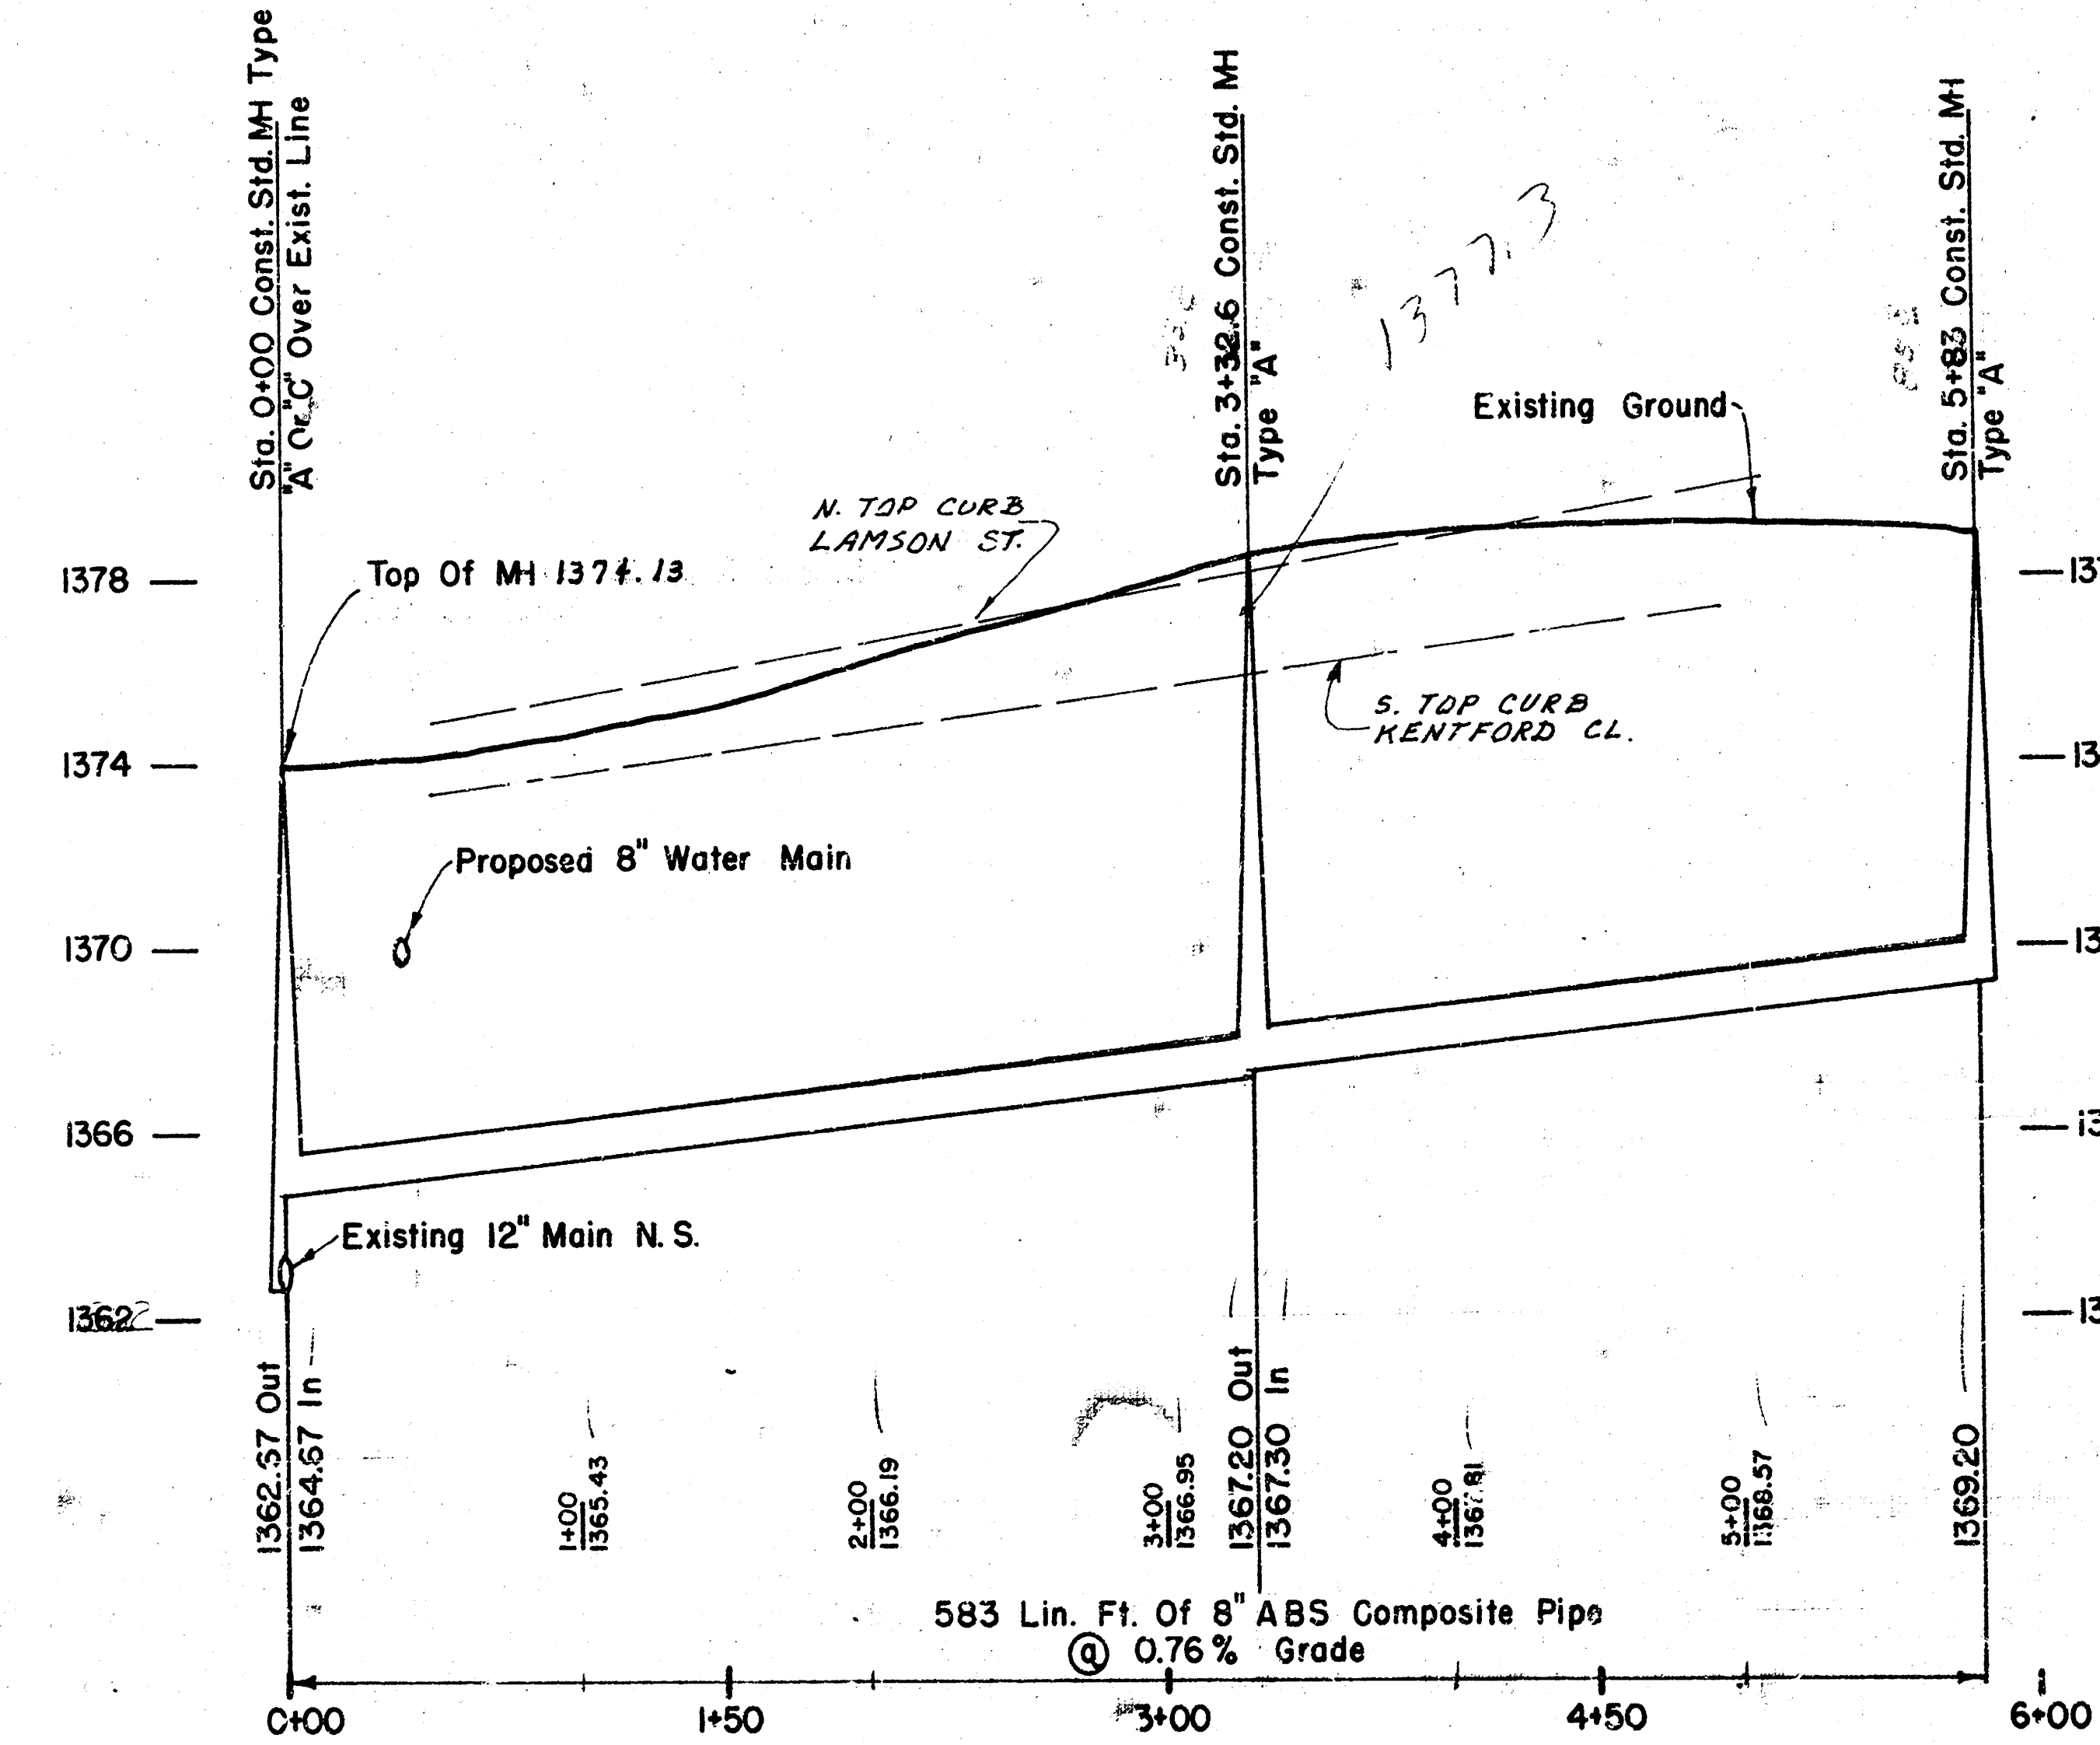

REISS & GOODNESS ENGINEERS
2100 WEST 21ST STREET
WICHITA, KANSAS 67204
(316) 832-0212