


B. M. 188.73 "M" in Mueller Fire Hydrant
W-side Woodlawn N.E. cor. Old English
Manor.

Plan Scale 1" = 40'
Profile Scale 1" = 40' Horiz.
1" = 5' Vert.

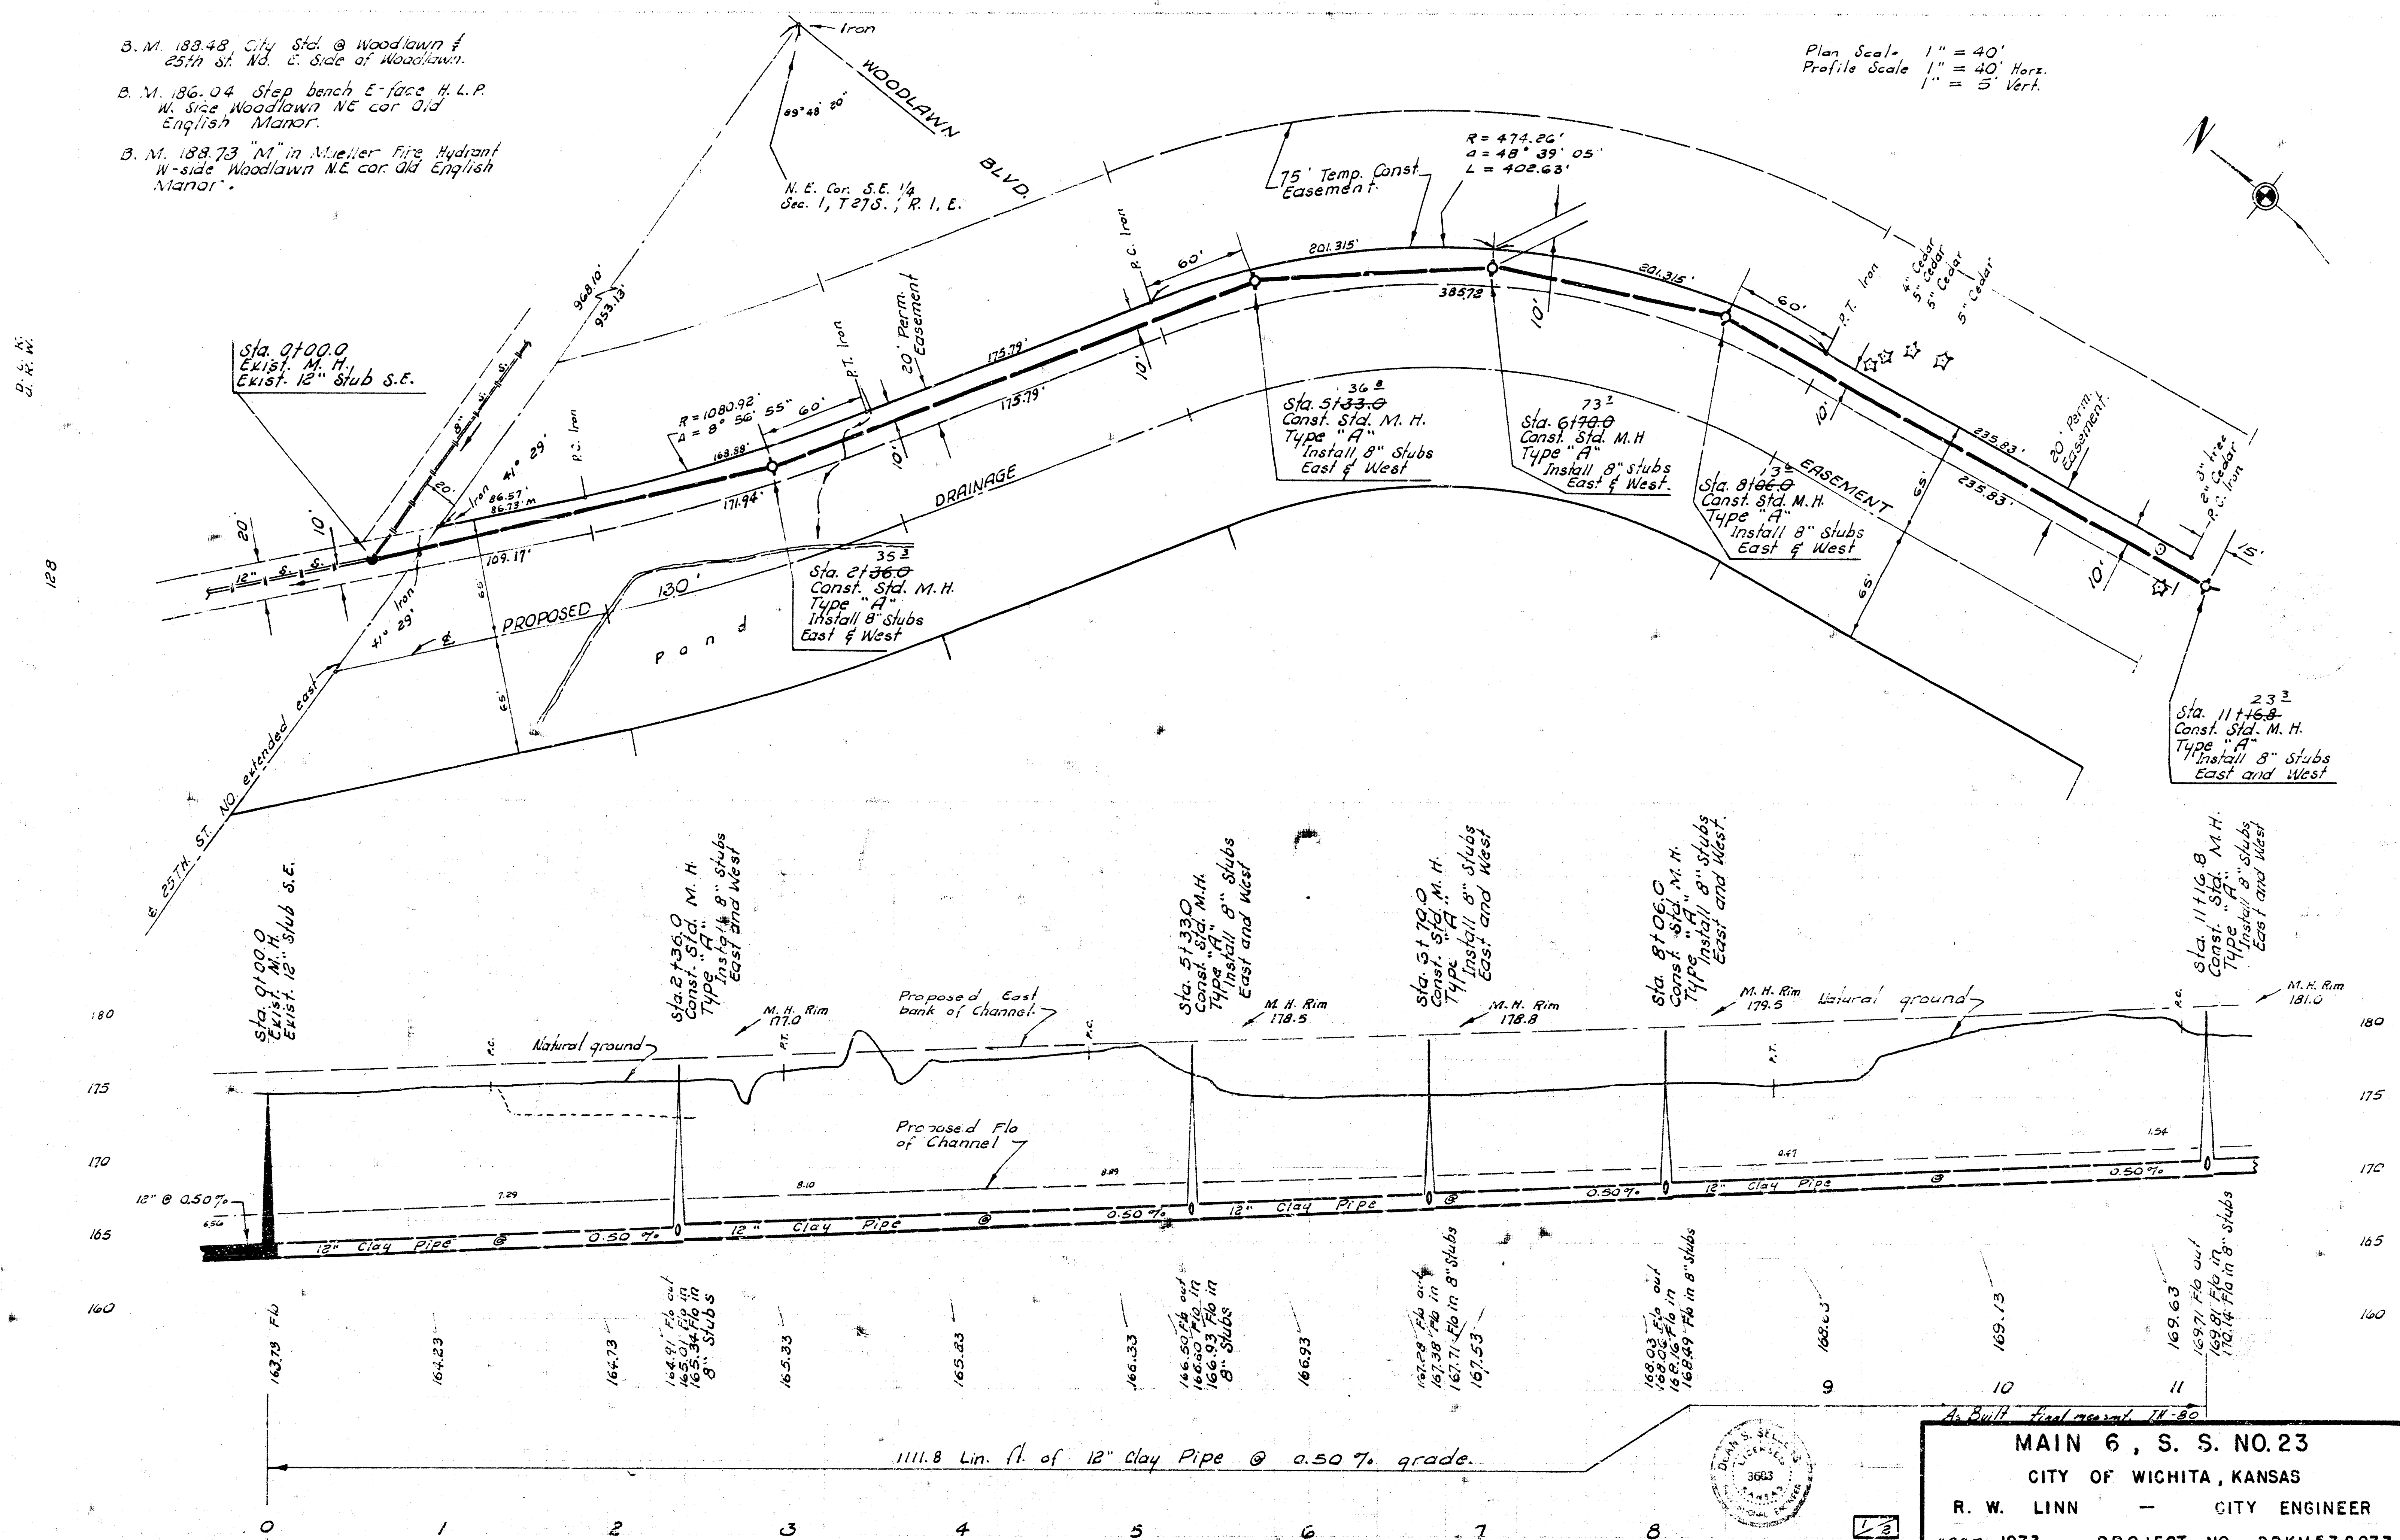

3. M. 186.04 Step bench E-face H. L. P.
W-side Woodlawn N.E. cor. Old English
Manor.



