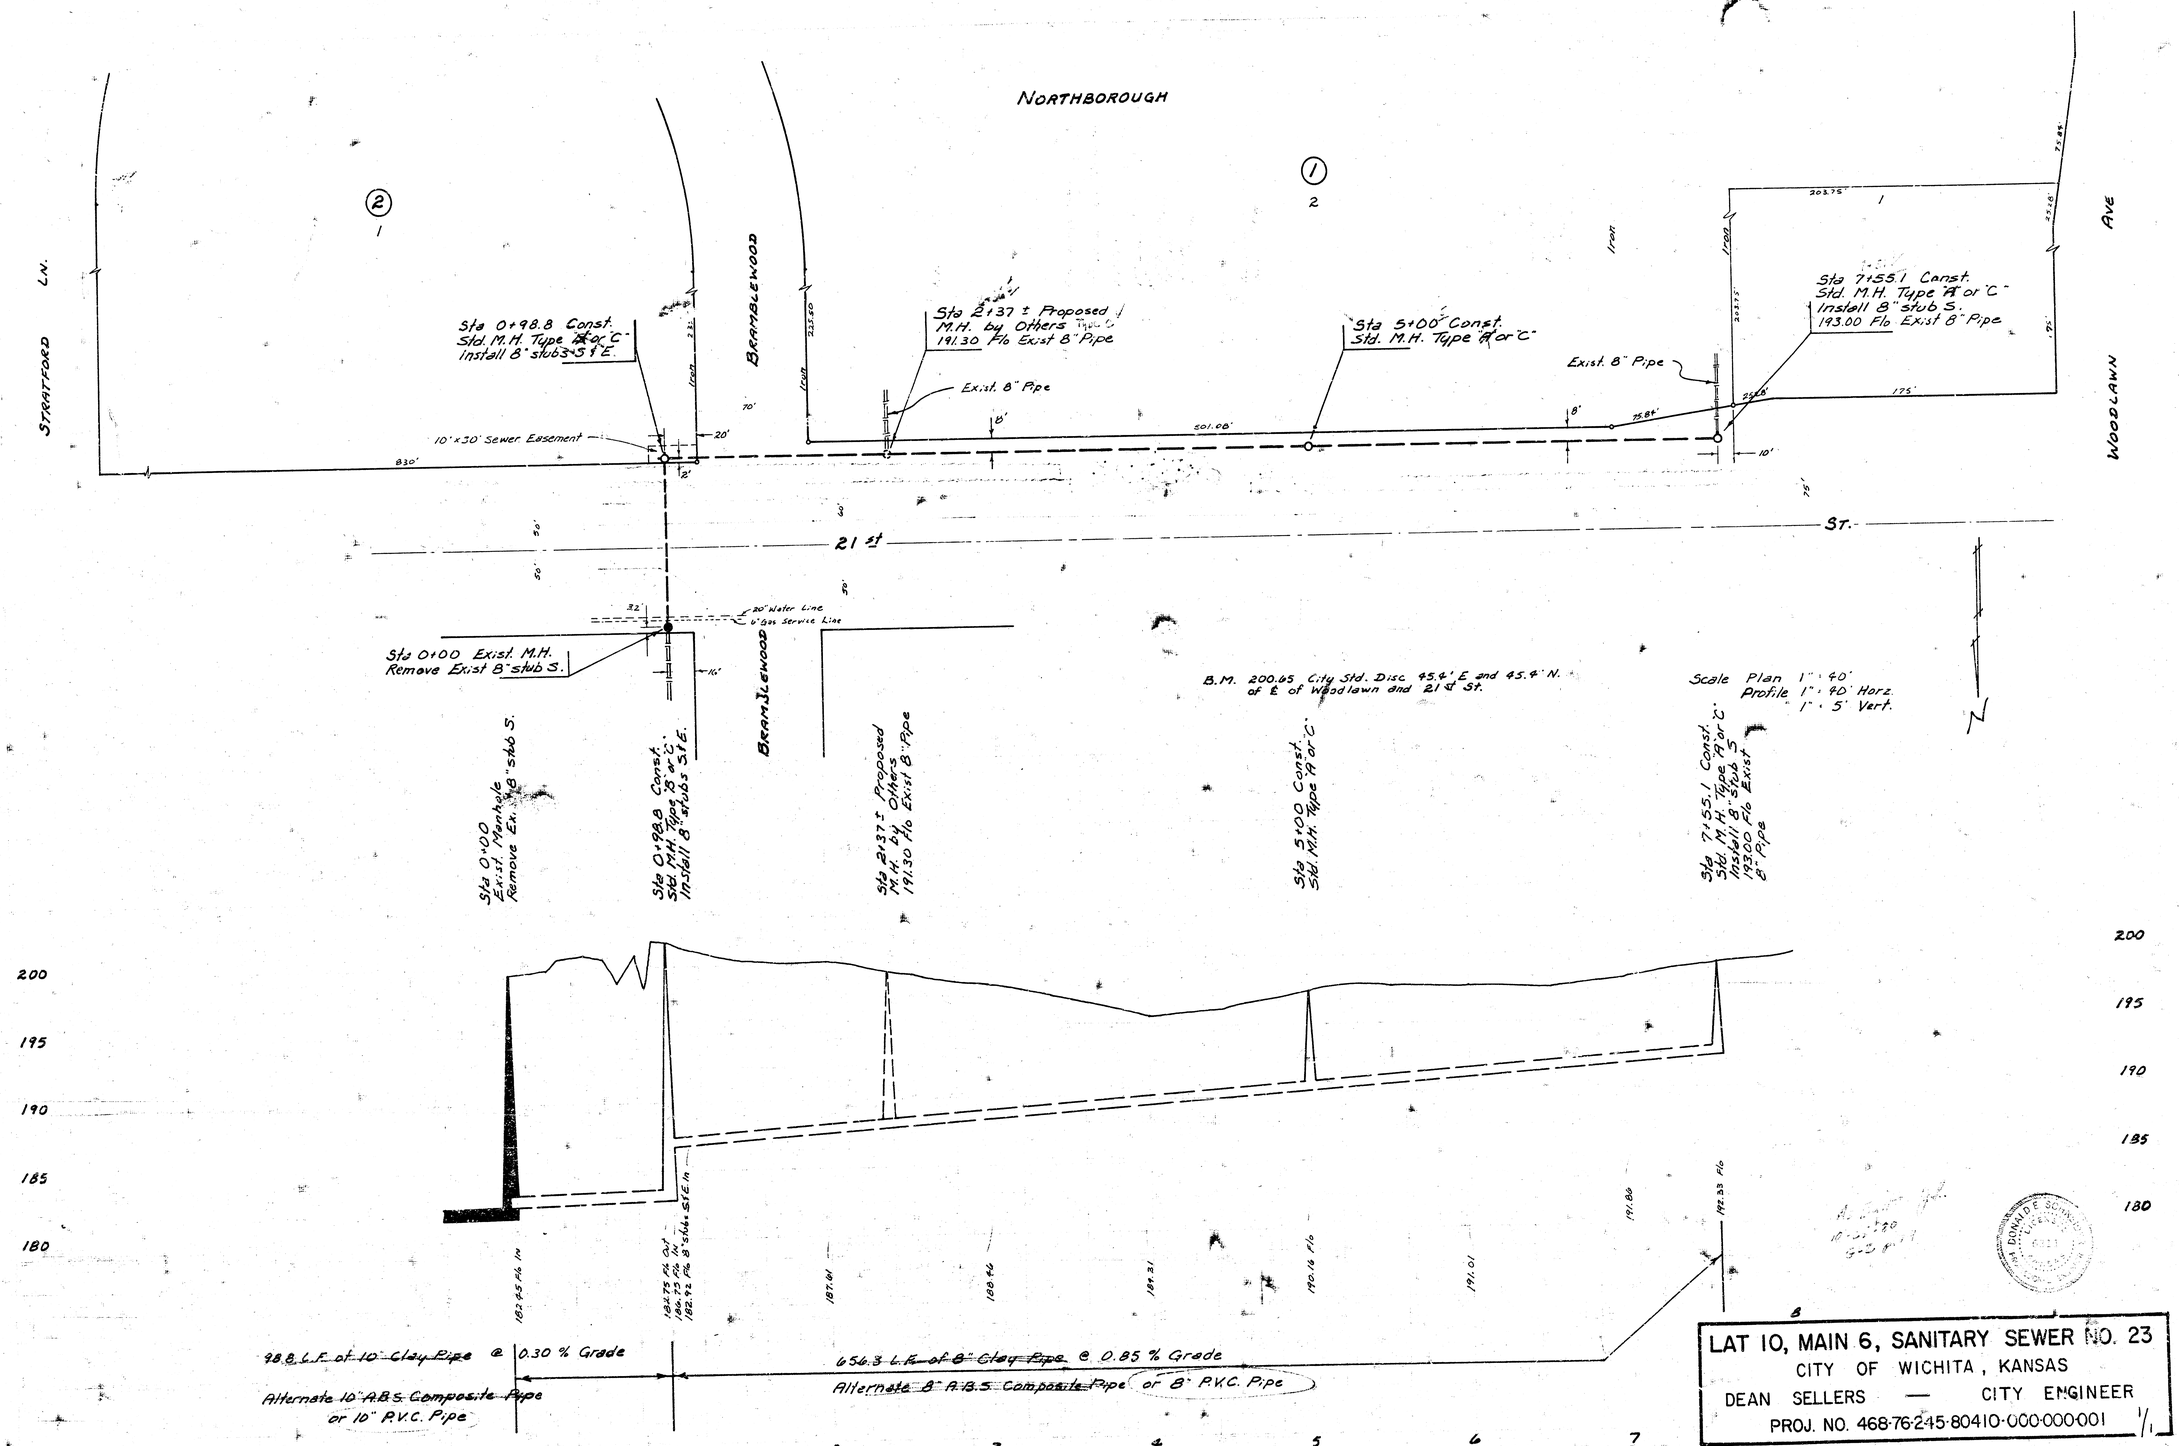

LAT 10, MAIN 6, SANITARY SEWER NO. 23
CITY OF WICHITA, KANSAS
DEAN SELLERS — CITY ENGINEER
PROJ. NO. 468-76-245-80410-000-000-001
1/1