B.M. 219.80 R.R. SPIKE N. FACE P.P. SW. COR. 37th ST. NO. & COMOTARA.

N

SCALE PLAN 1" = 40'
PROFILE 1" = 40' HORZ.
1" = 5' VERT.

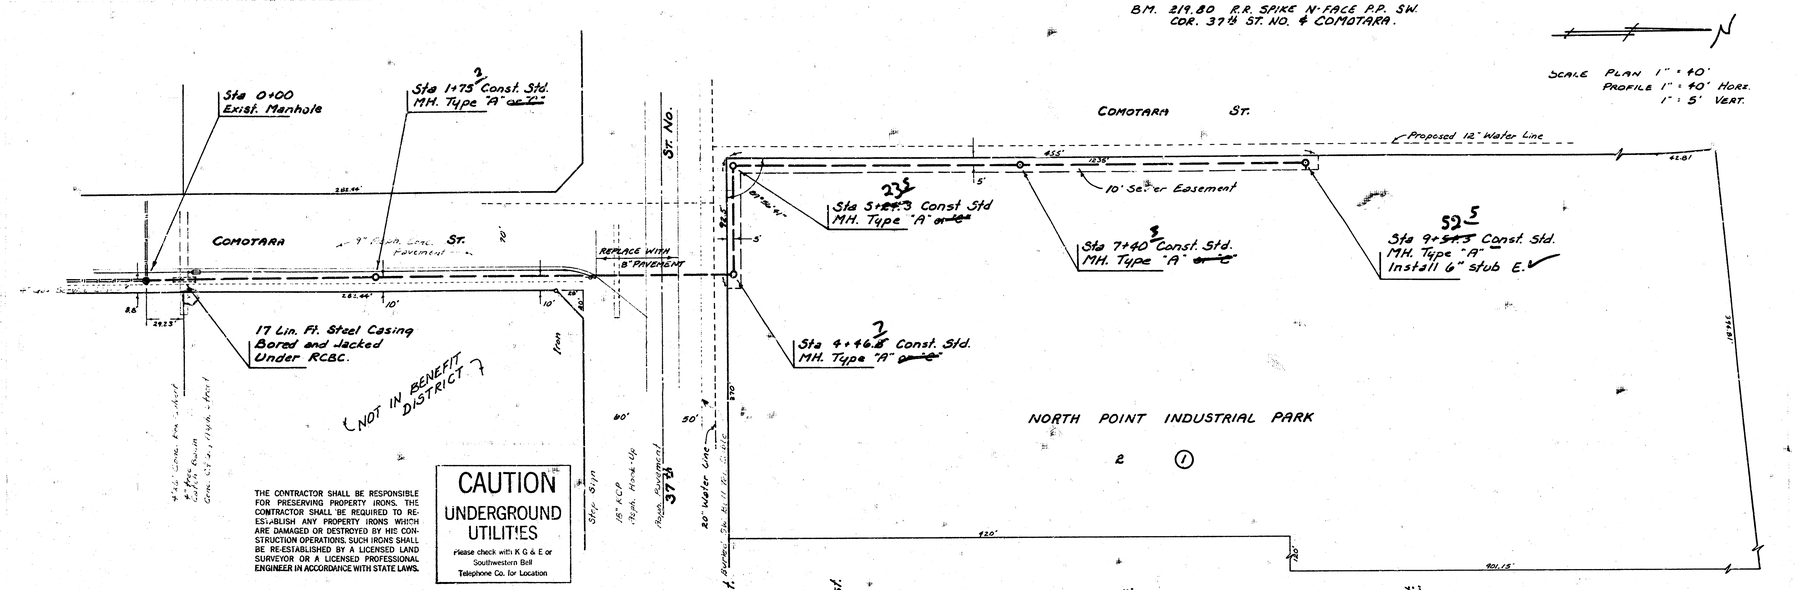

As Built 1/82 Jdd

DONALD E. SCHNUDER LICENSED 6311 KANSAS PROFESSIONAL ENGINEER

LAT 2, MAIN 9, SAN. SEWER NO. 23
CITY OF WICHITA, KANSAS
R. W. BRUGGEMAN
DIRECTOR OF ENGINEERING - CITY ENGINEER
PROJ. NO. 468-76-245-81125-000-000-001

12