
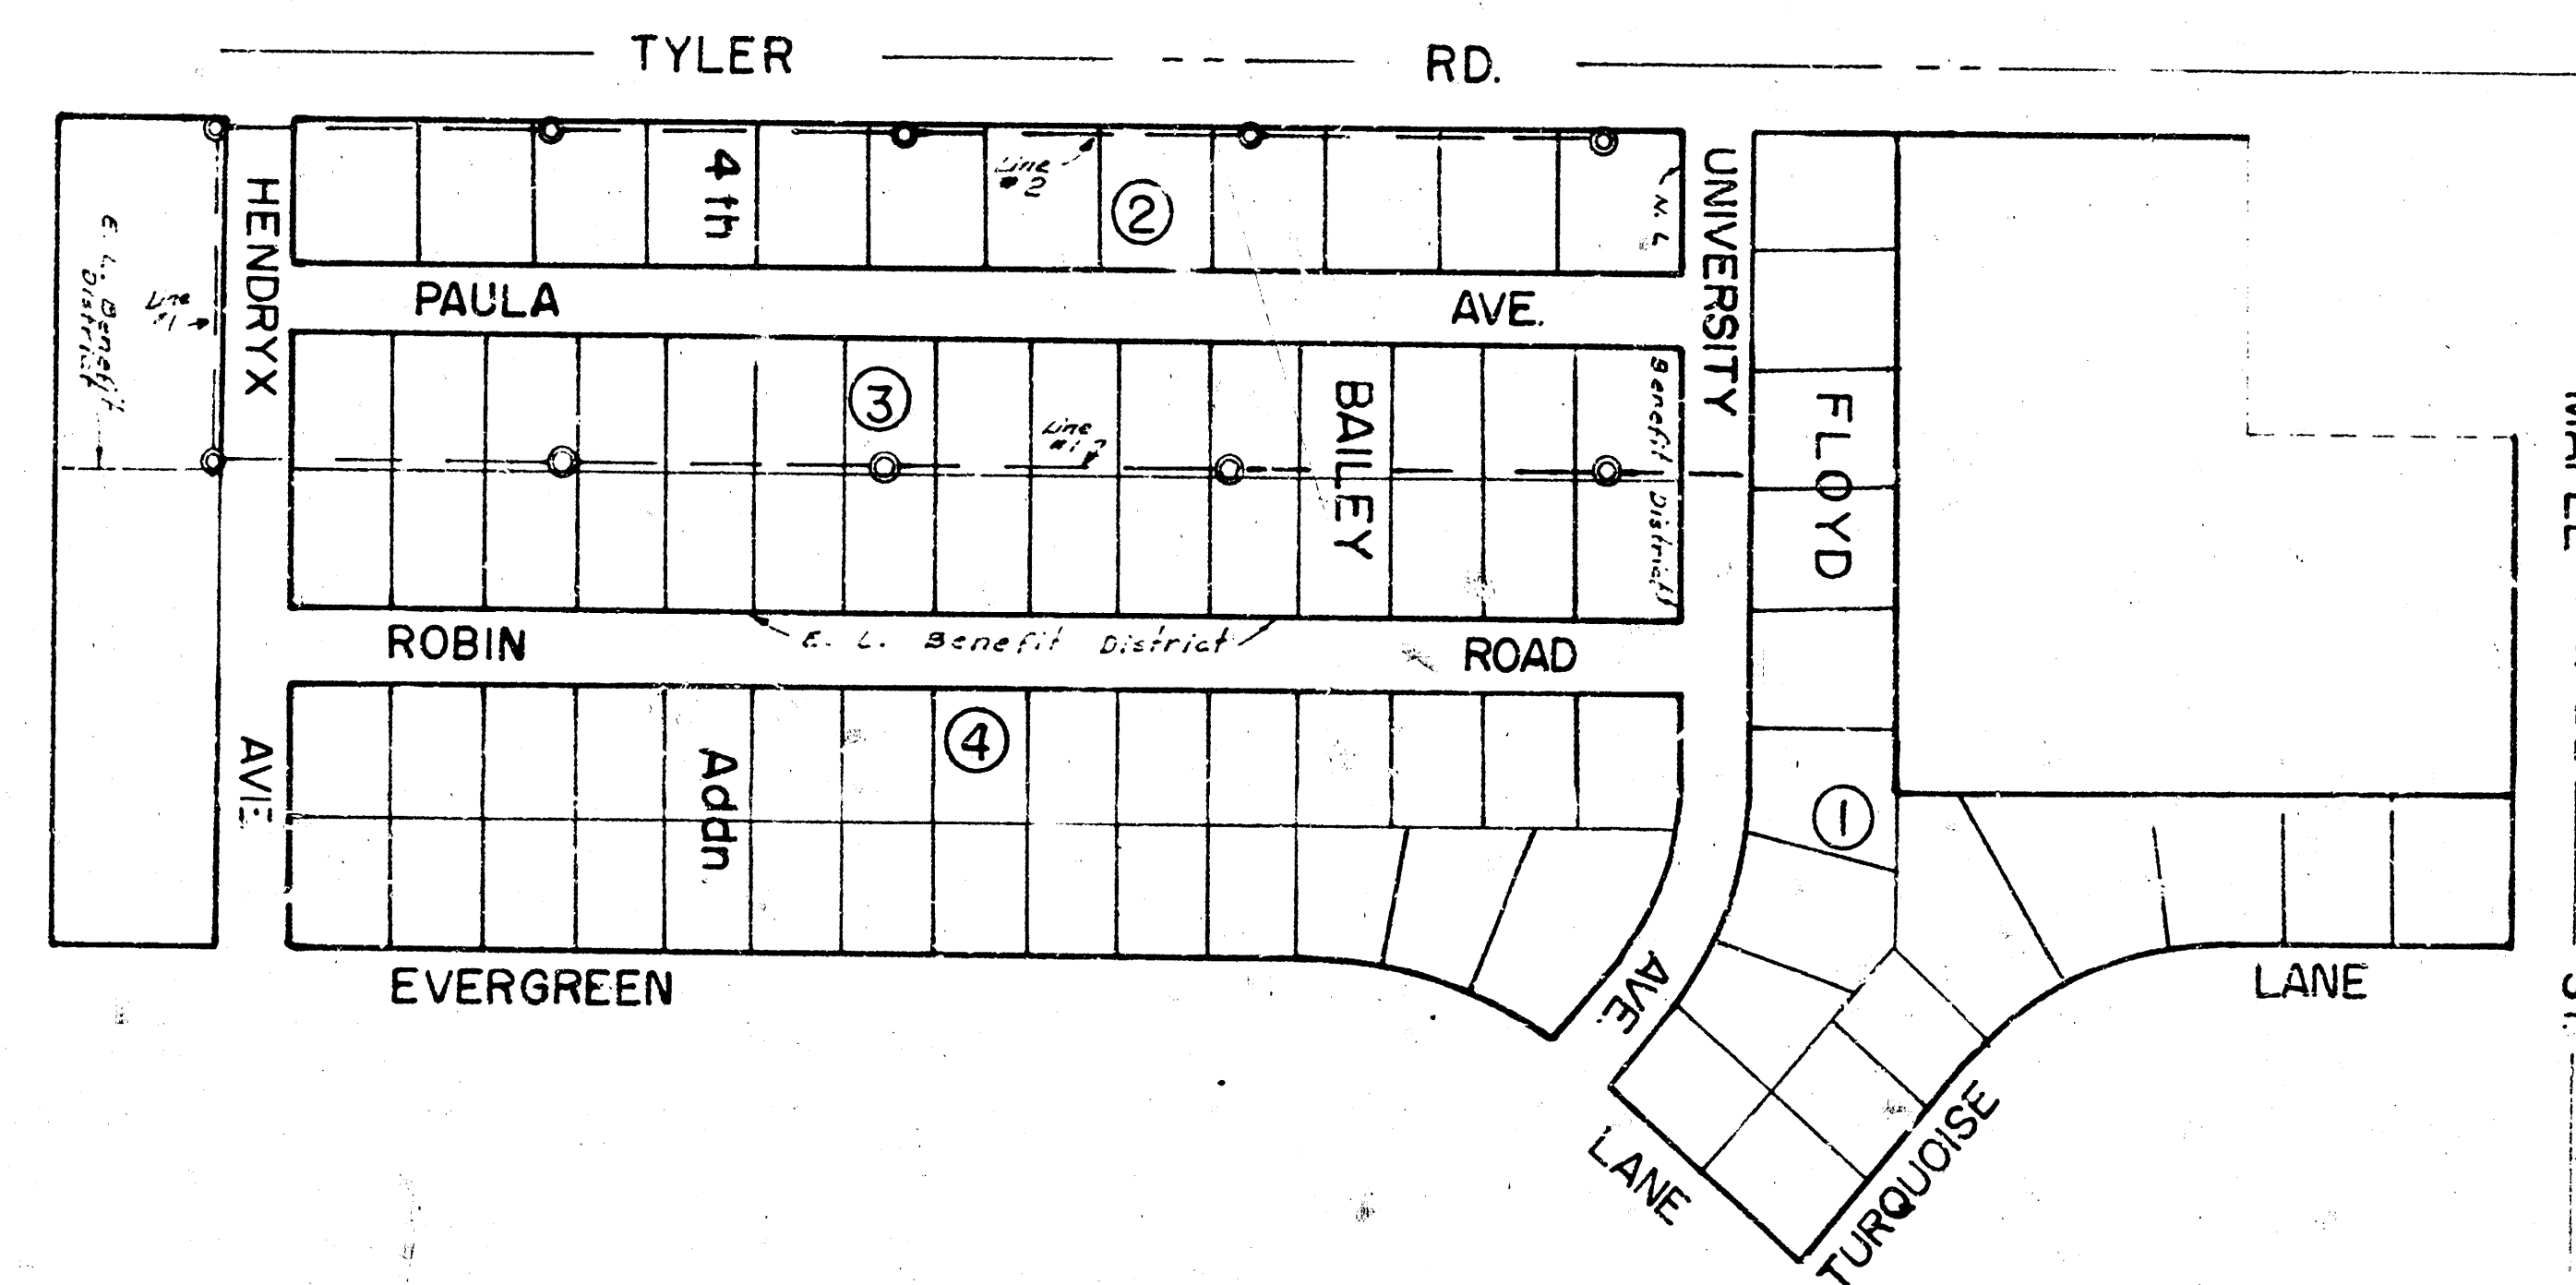


Lateral 7, Southwest Main

Project No. DBKL 568030

R. W. Linn City Engineer

City of Wichita, Kansas

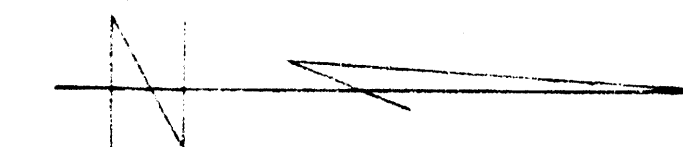



Line No.


1
2



Sheet No.

2 of 3
4

For Building Department
11-105

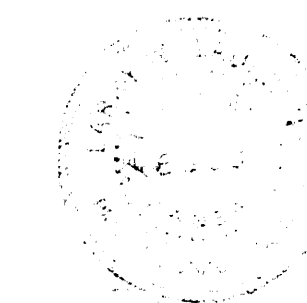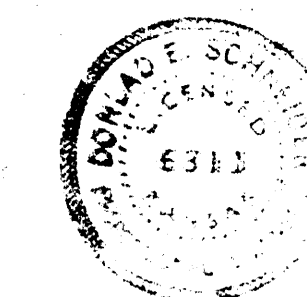

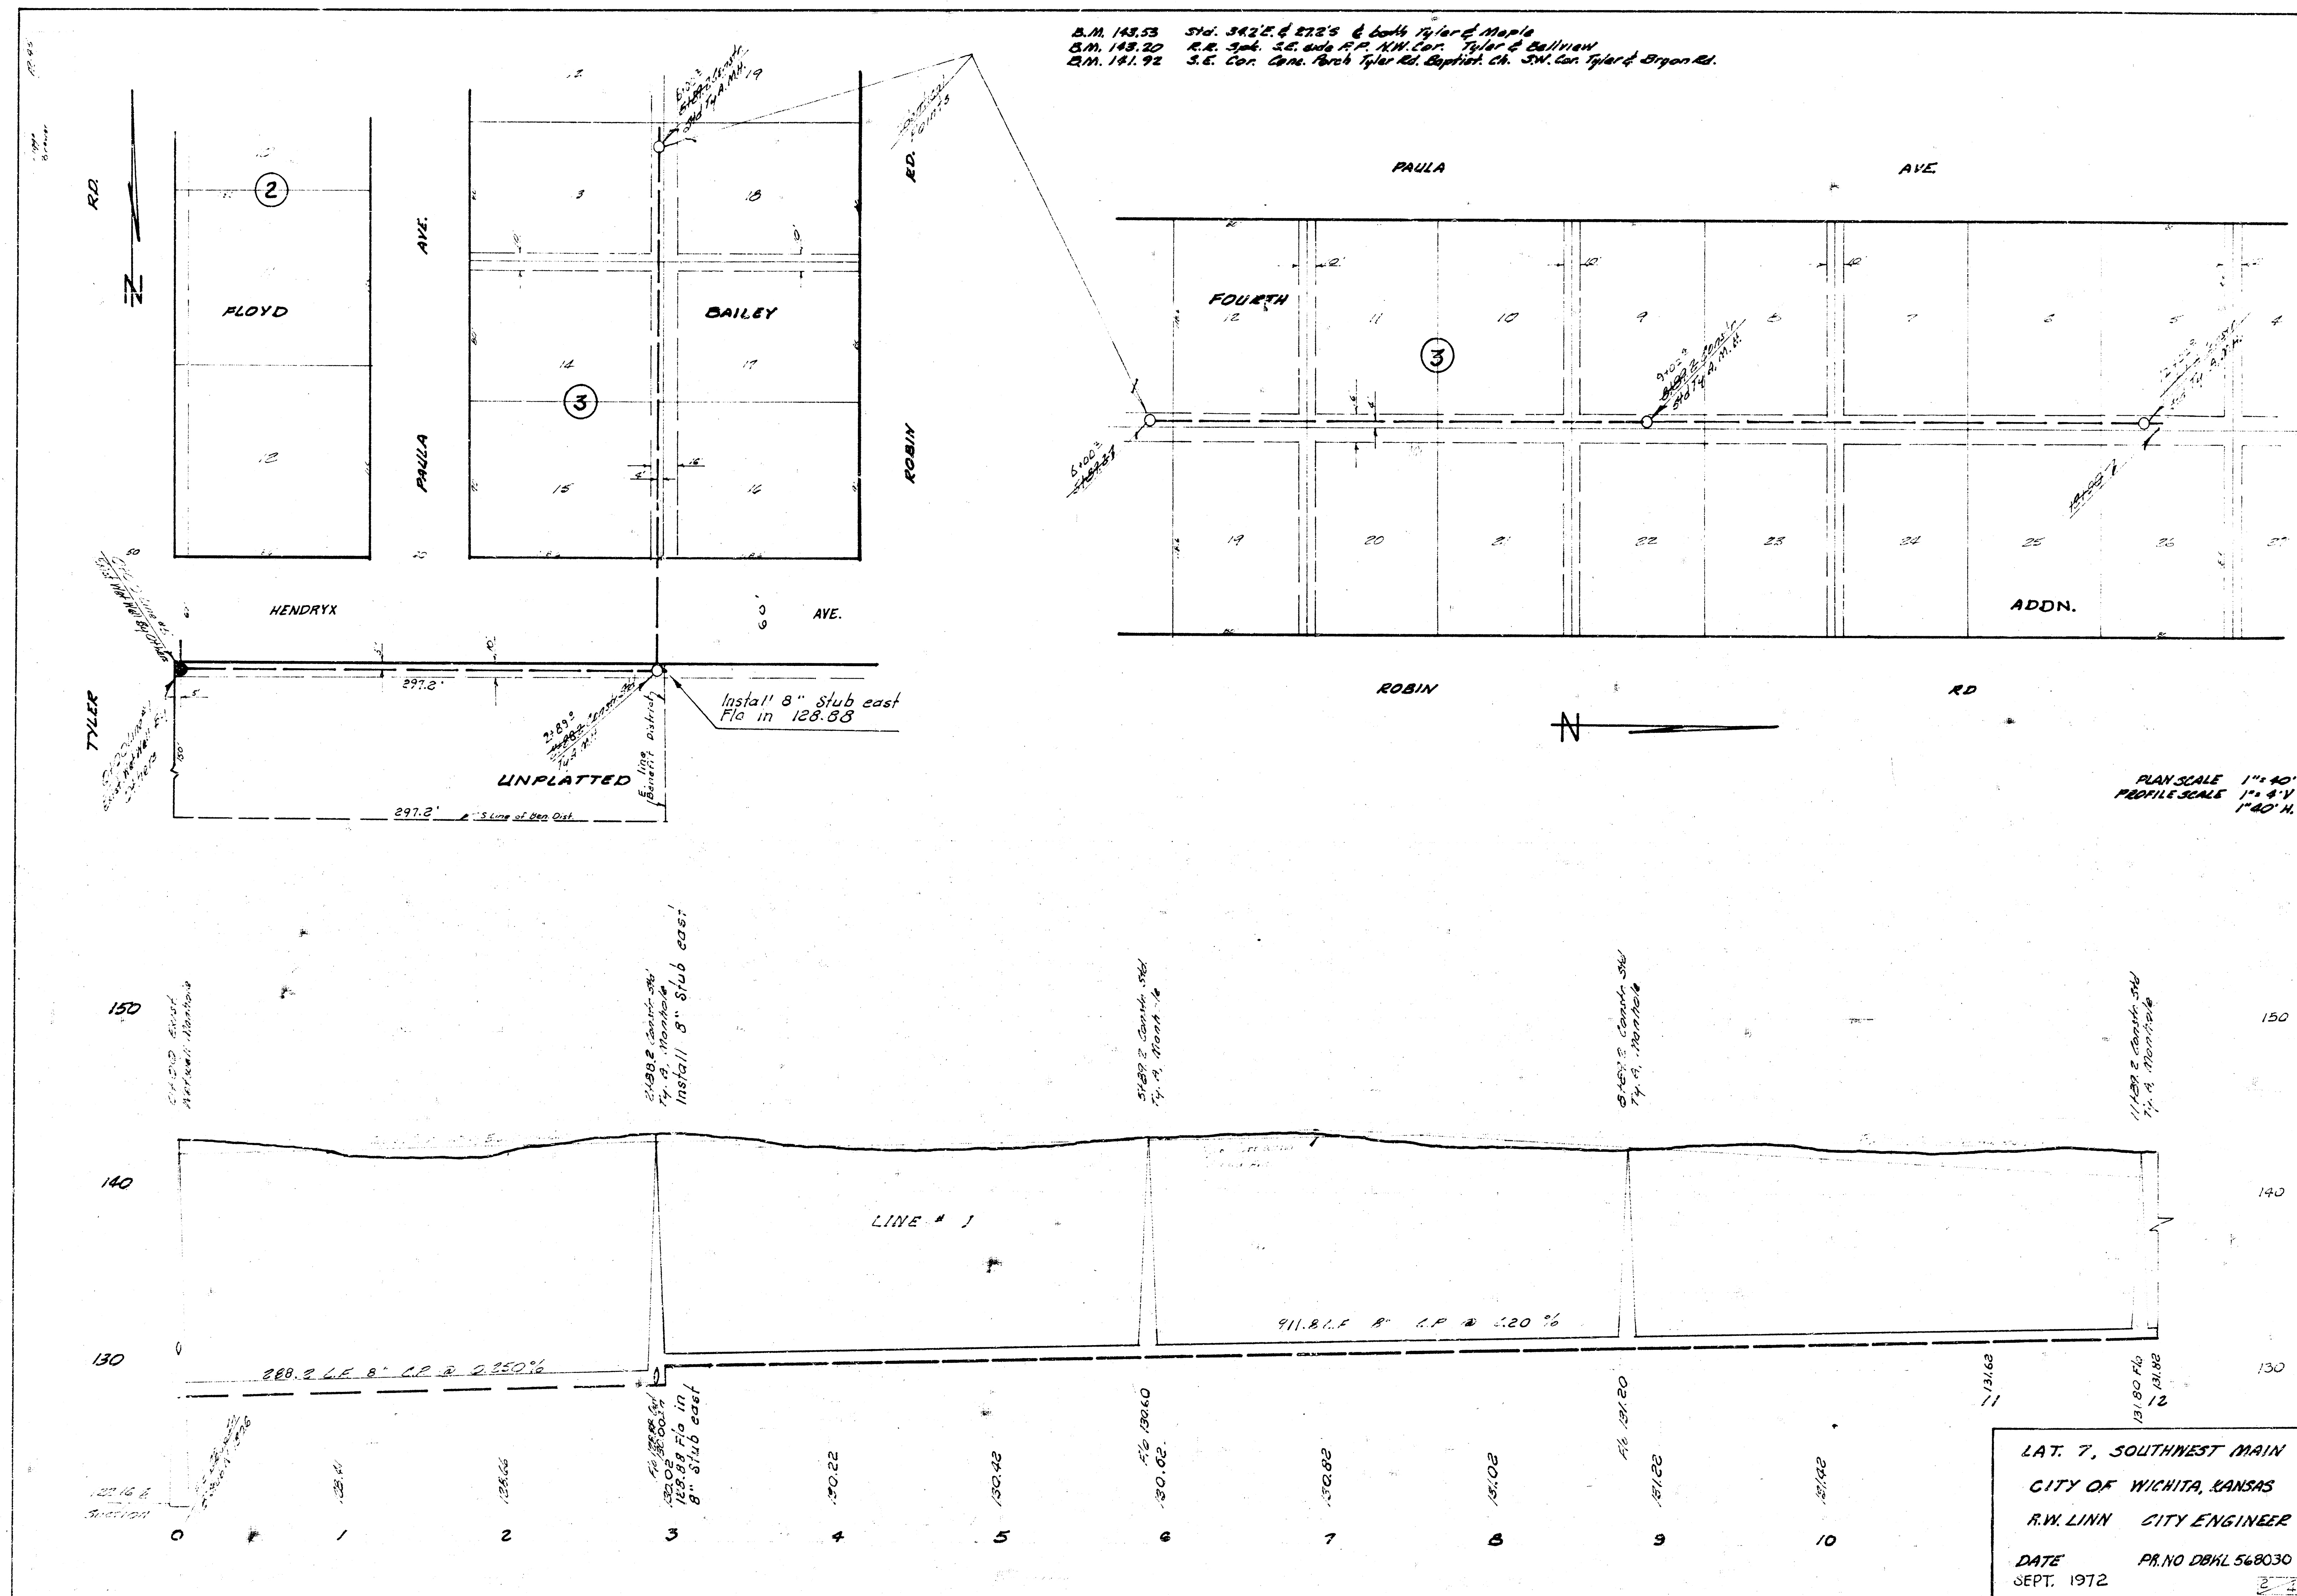

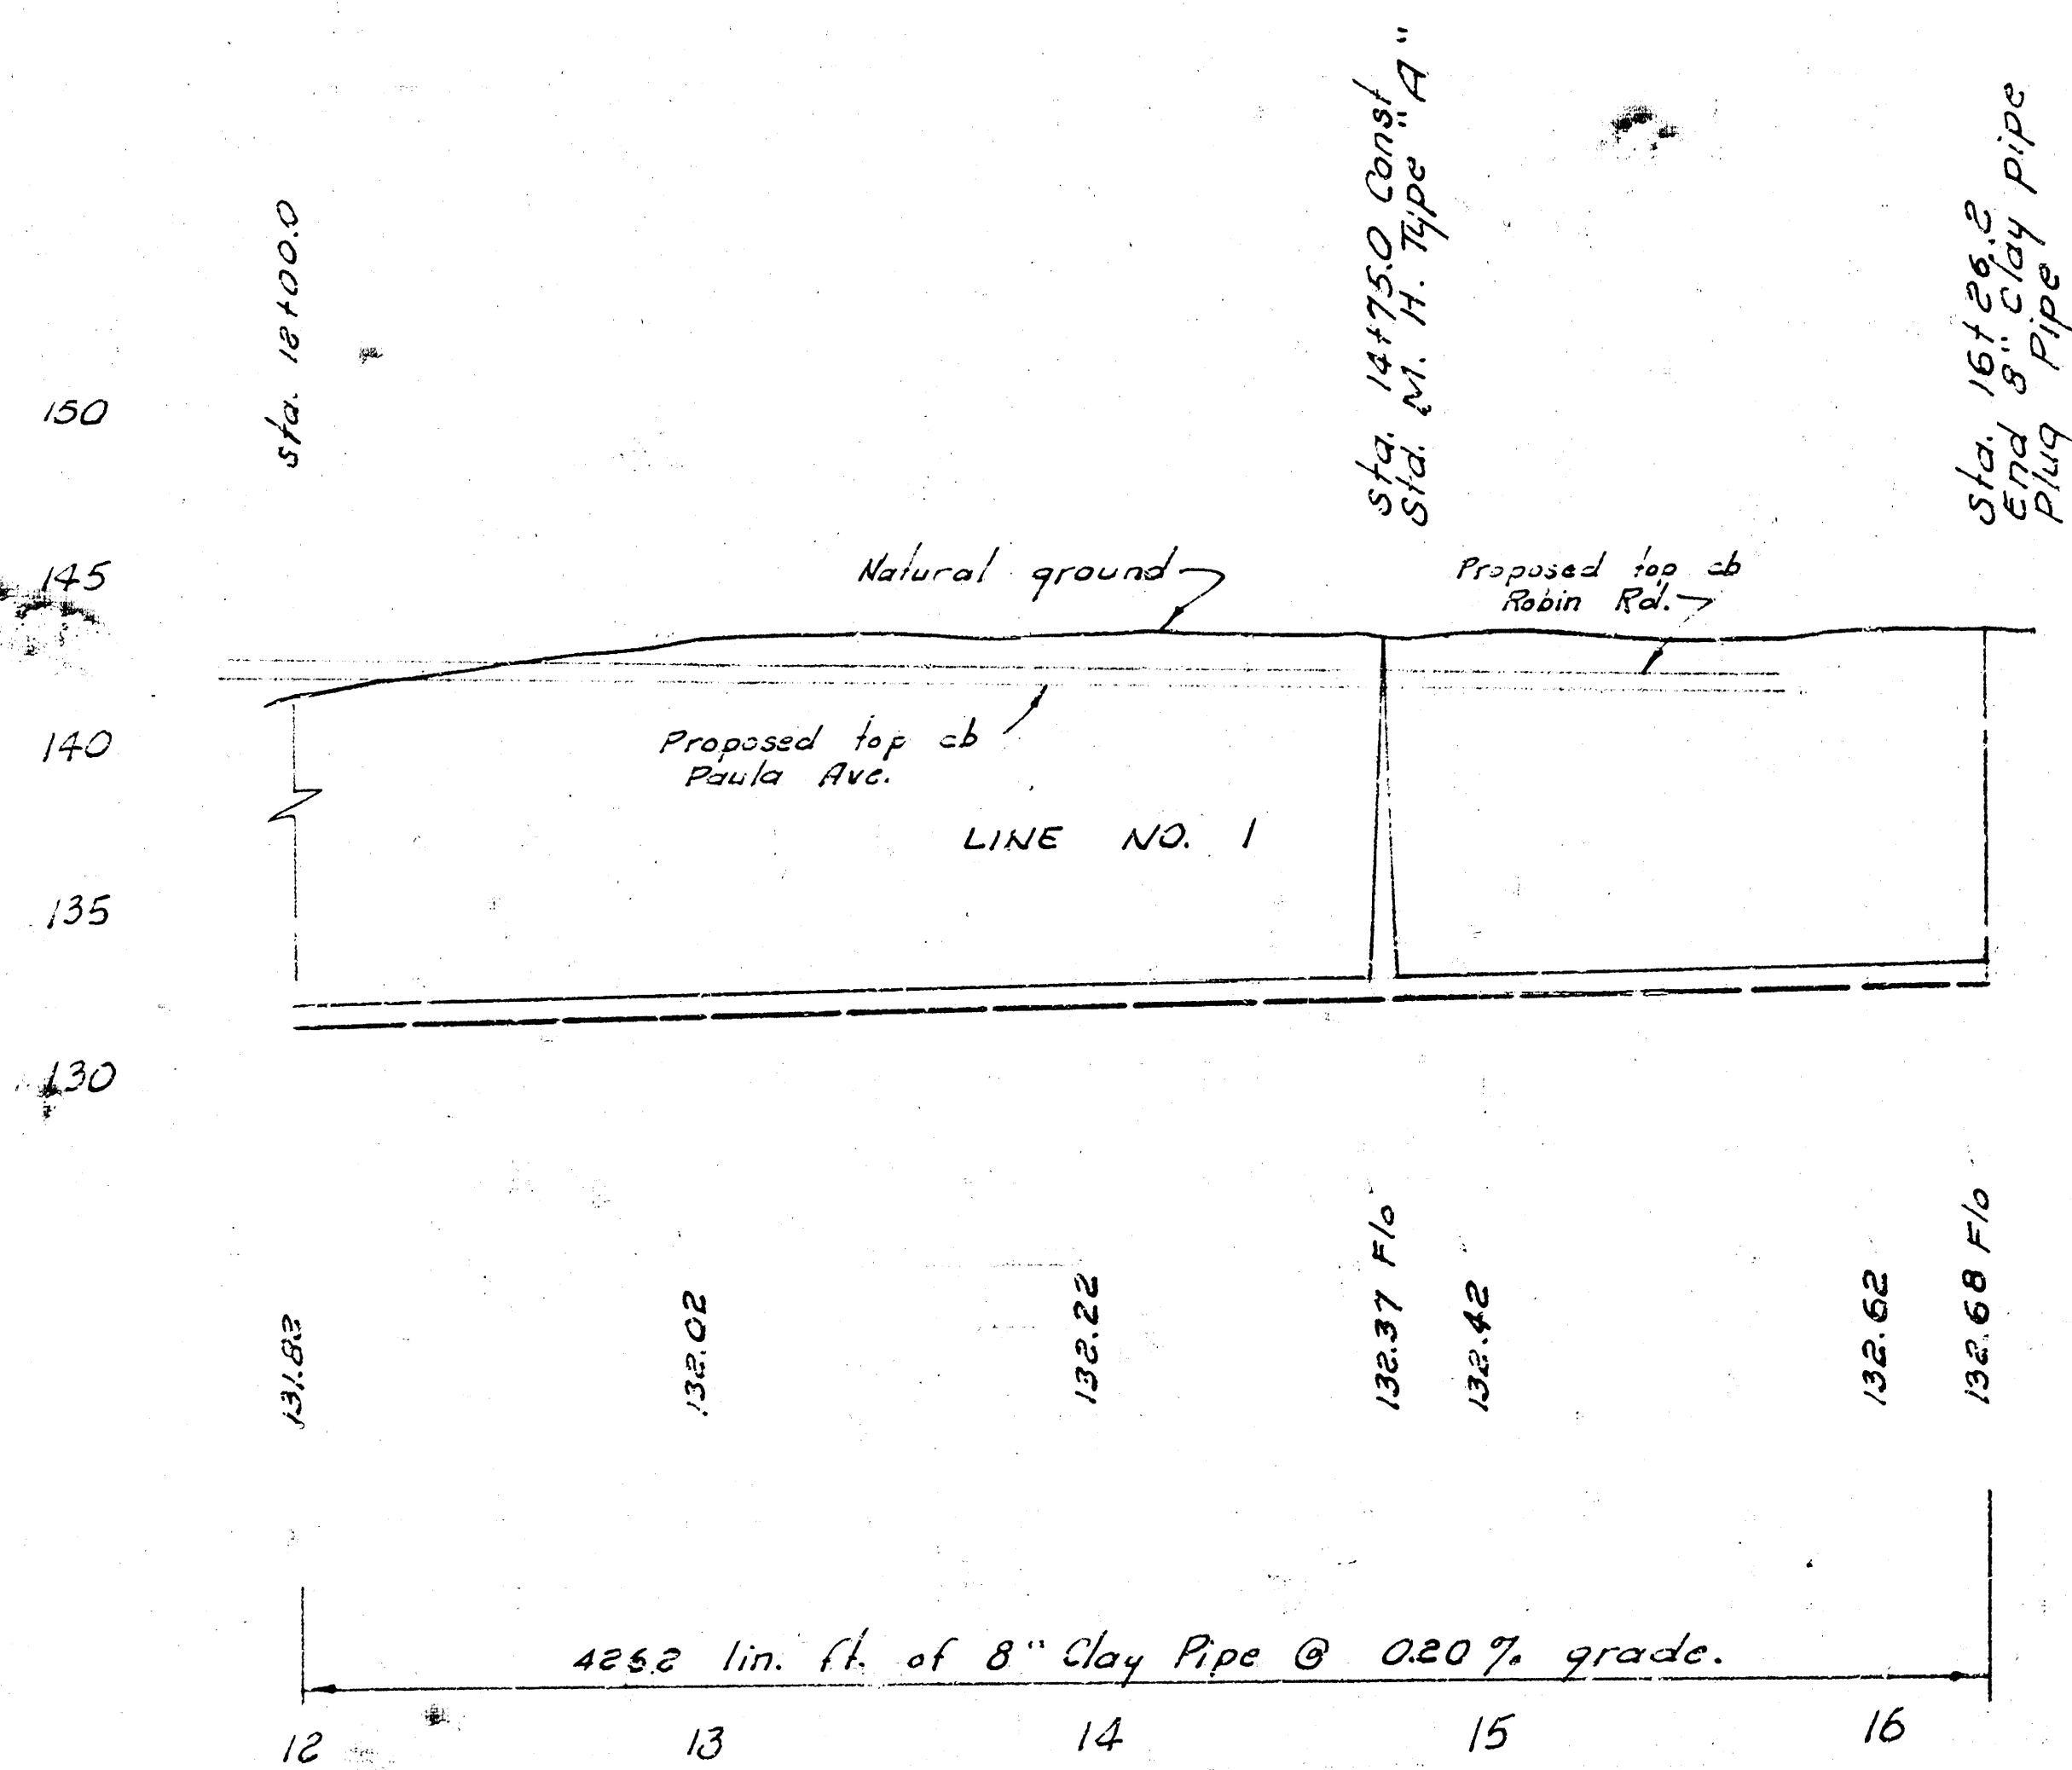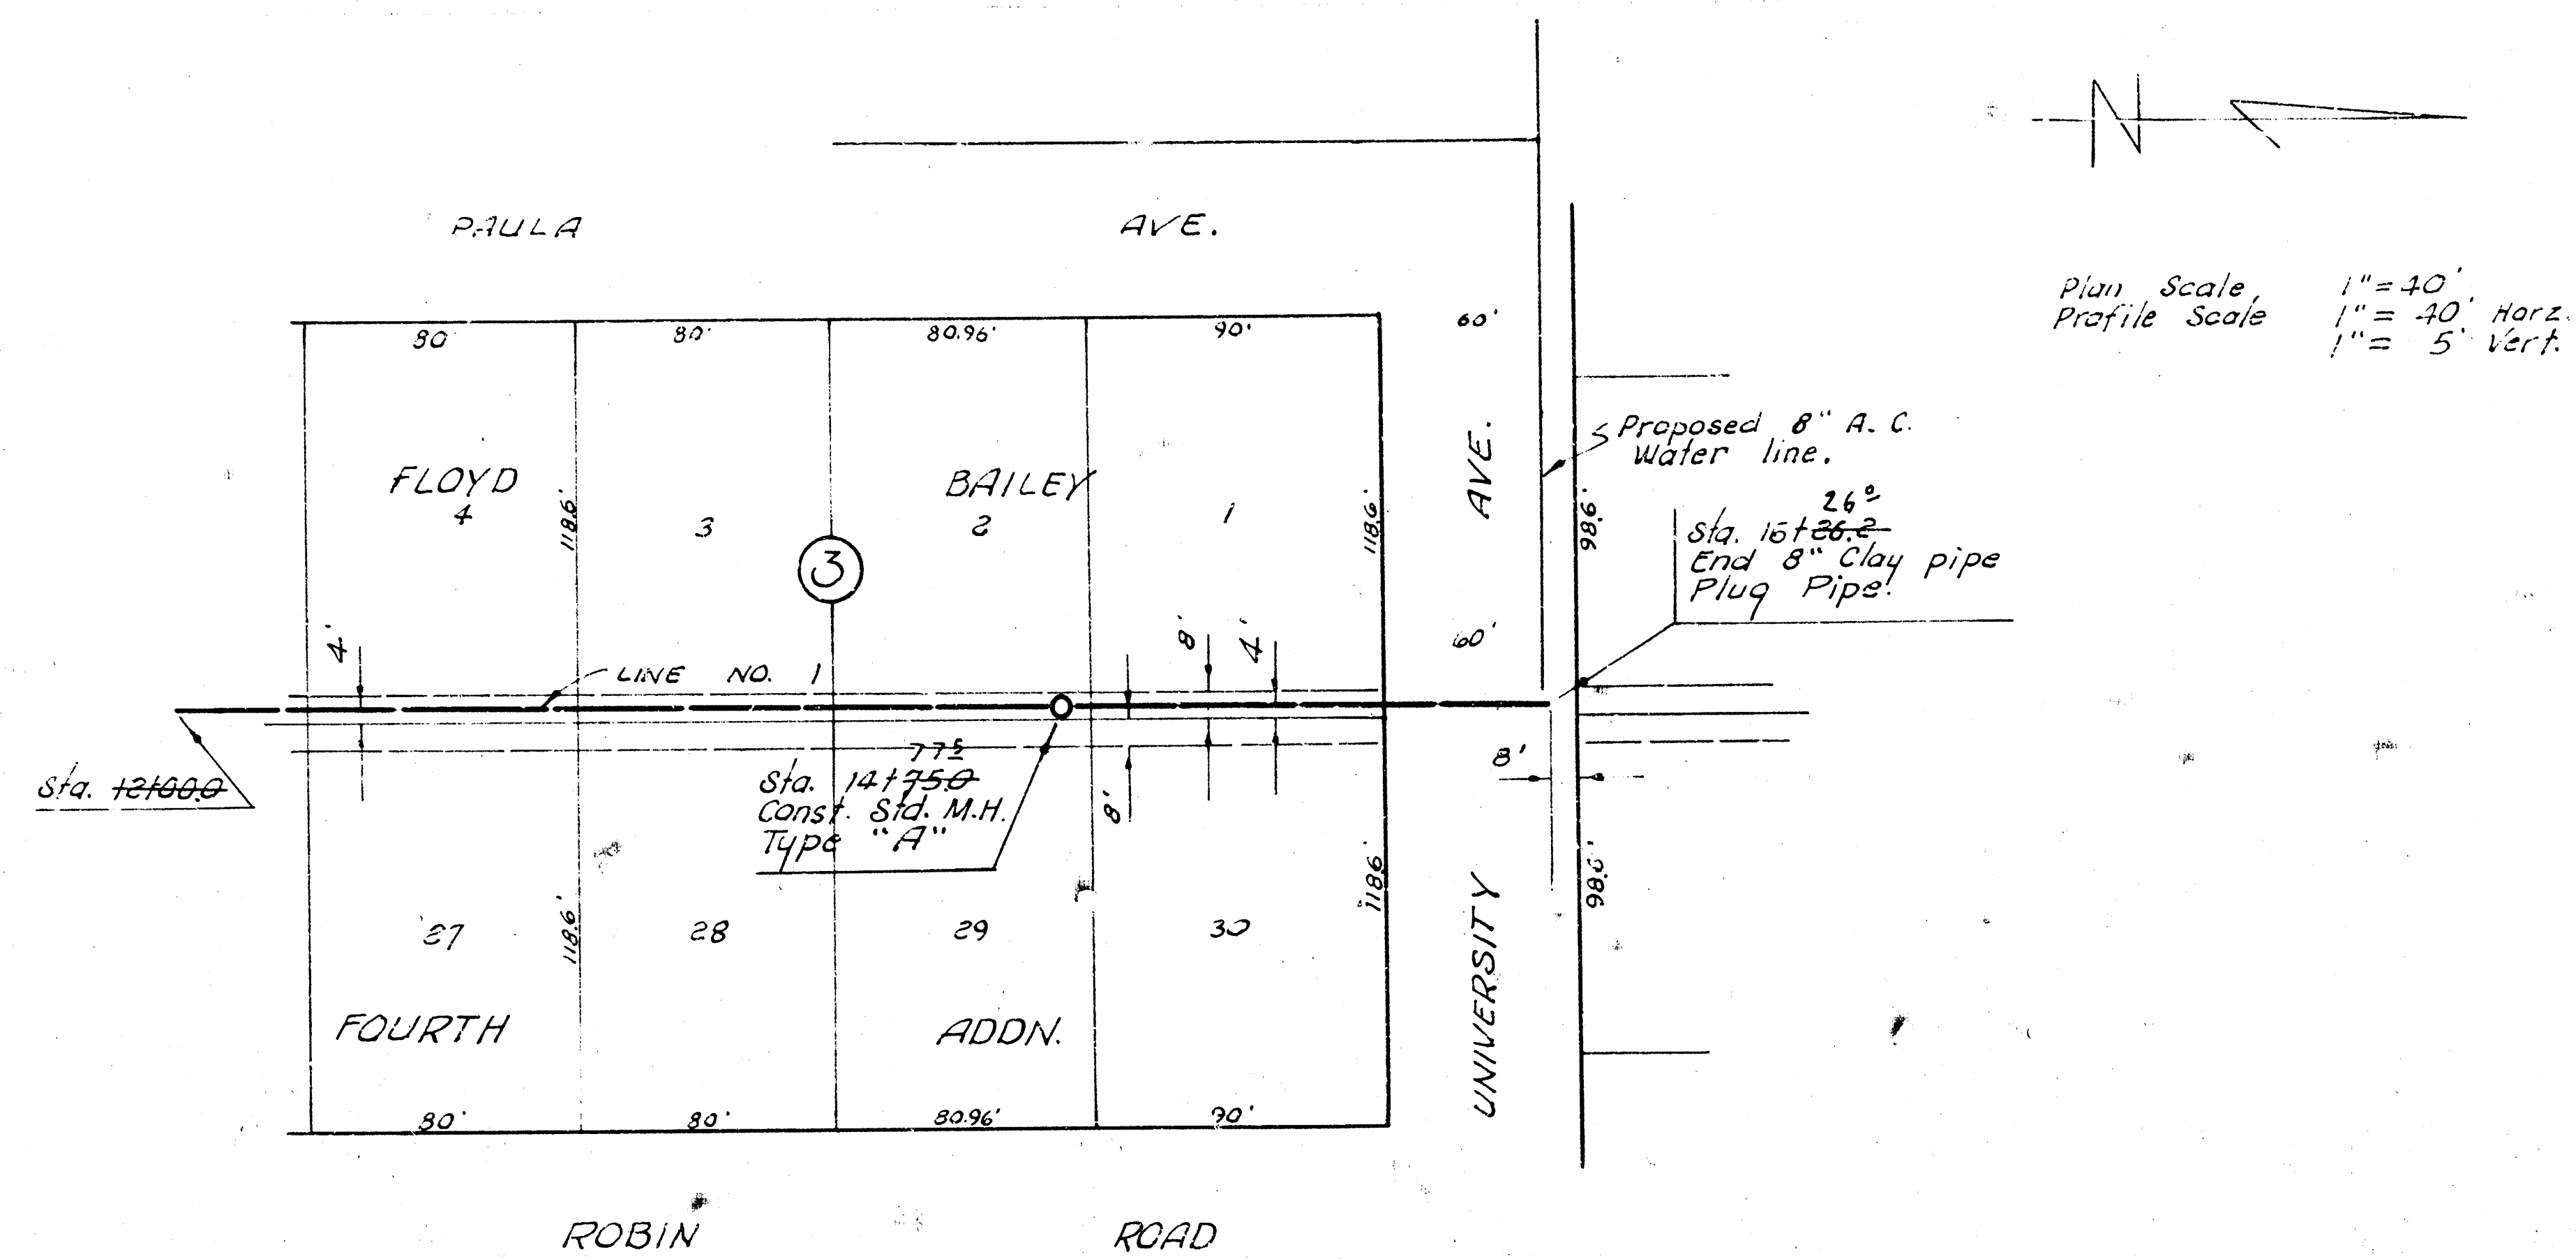

LAT. 7 S. W. MAIN
 PROJECT NO. DBK L568030

