
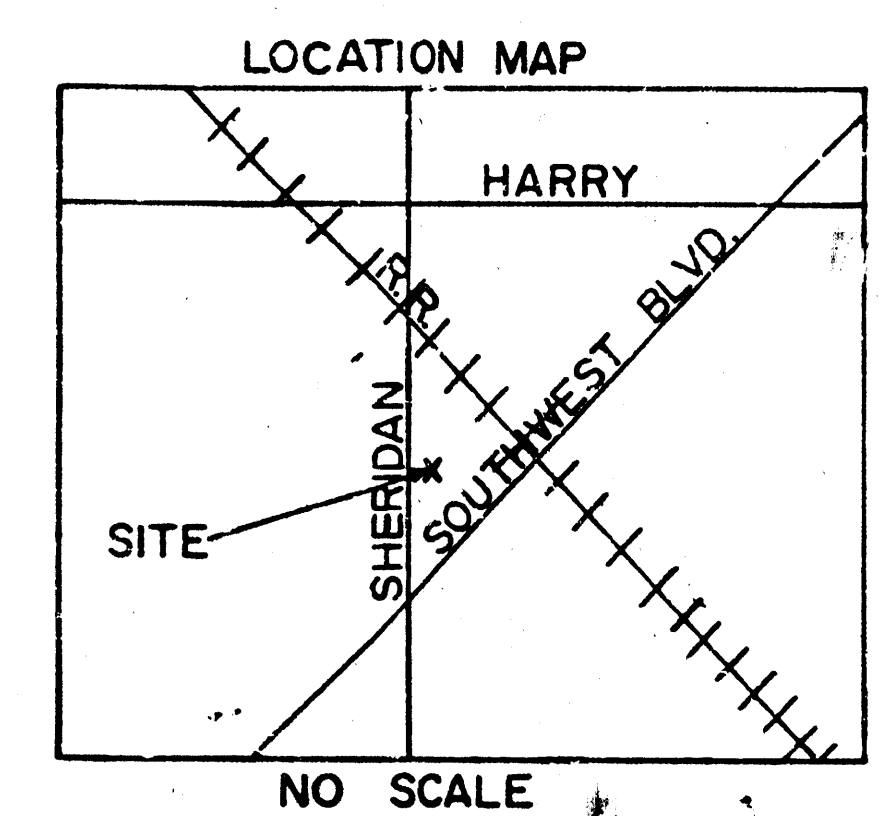
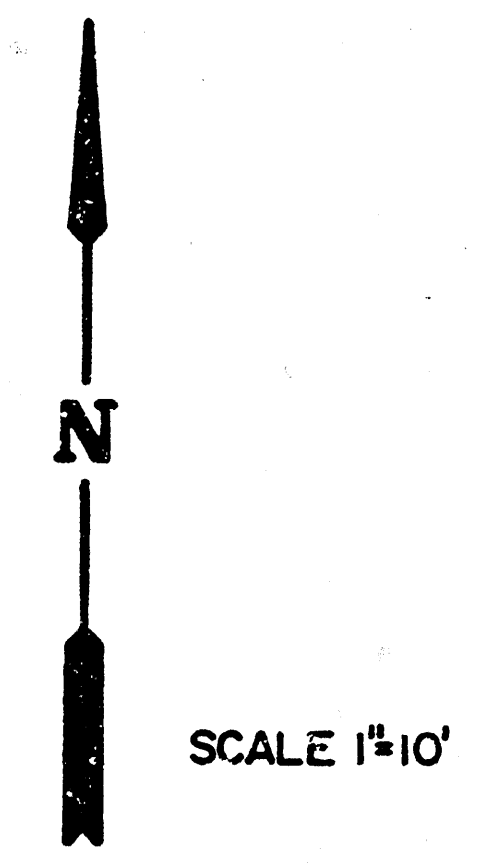



AIR CAPITOL PRINTING
 SANITARY SEWER EXTENSION

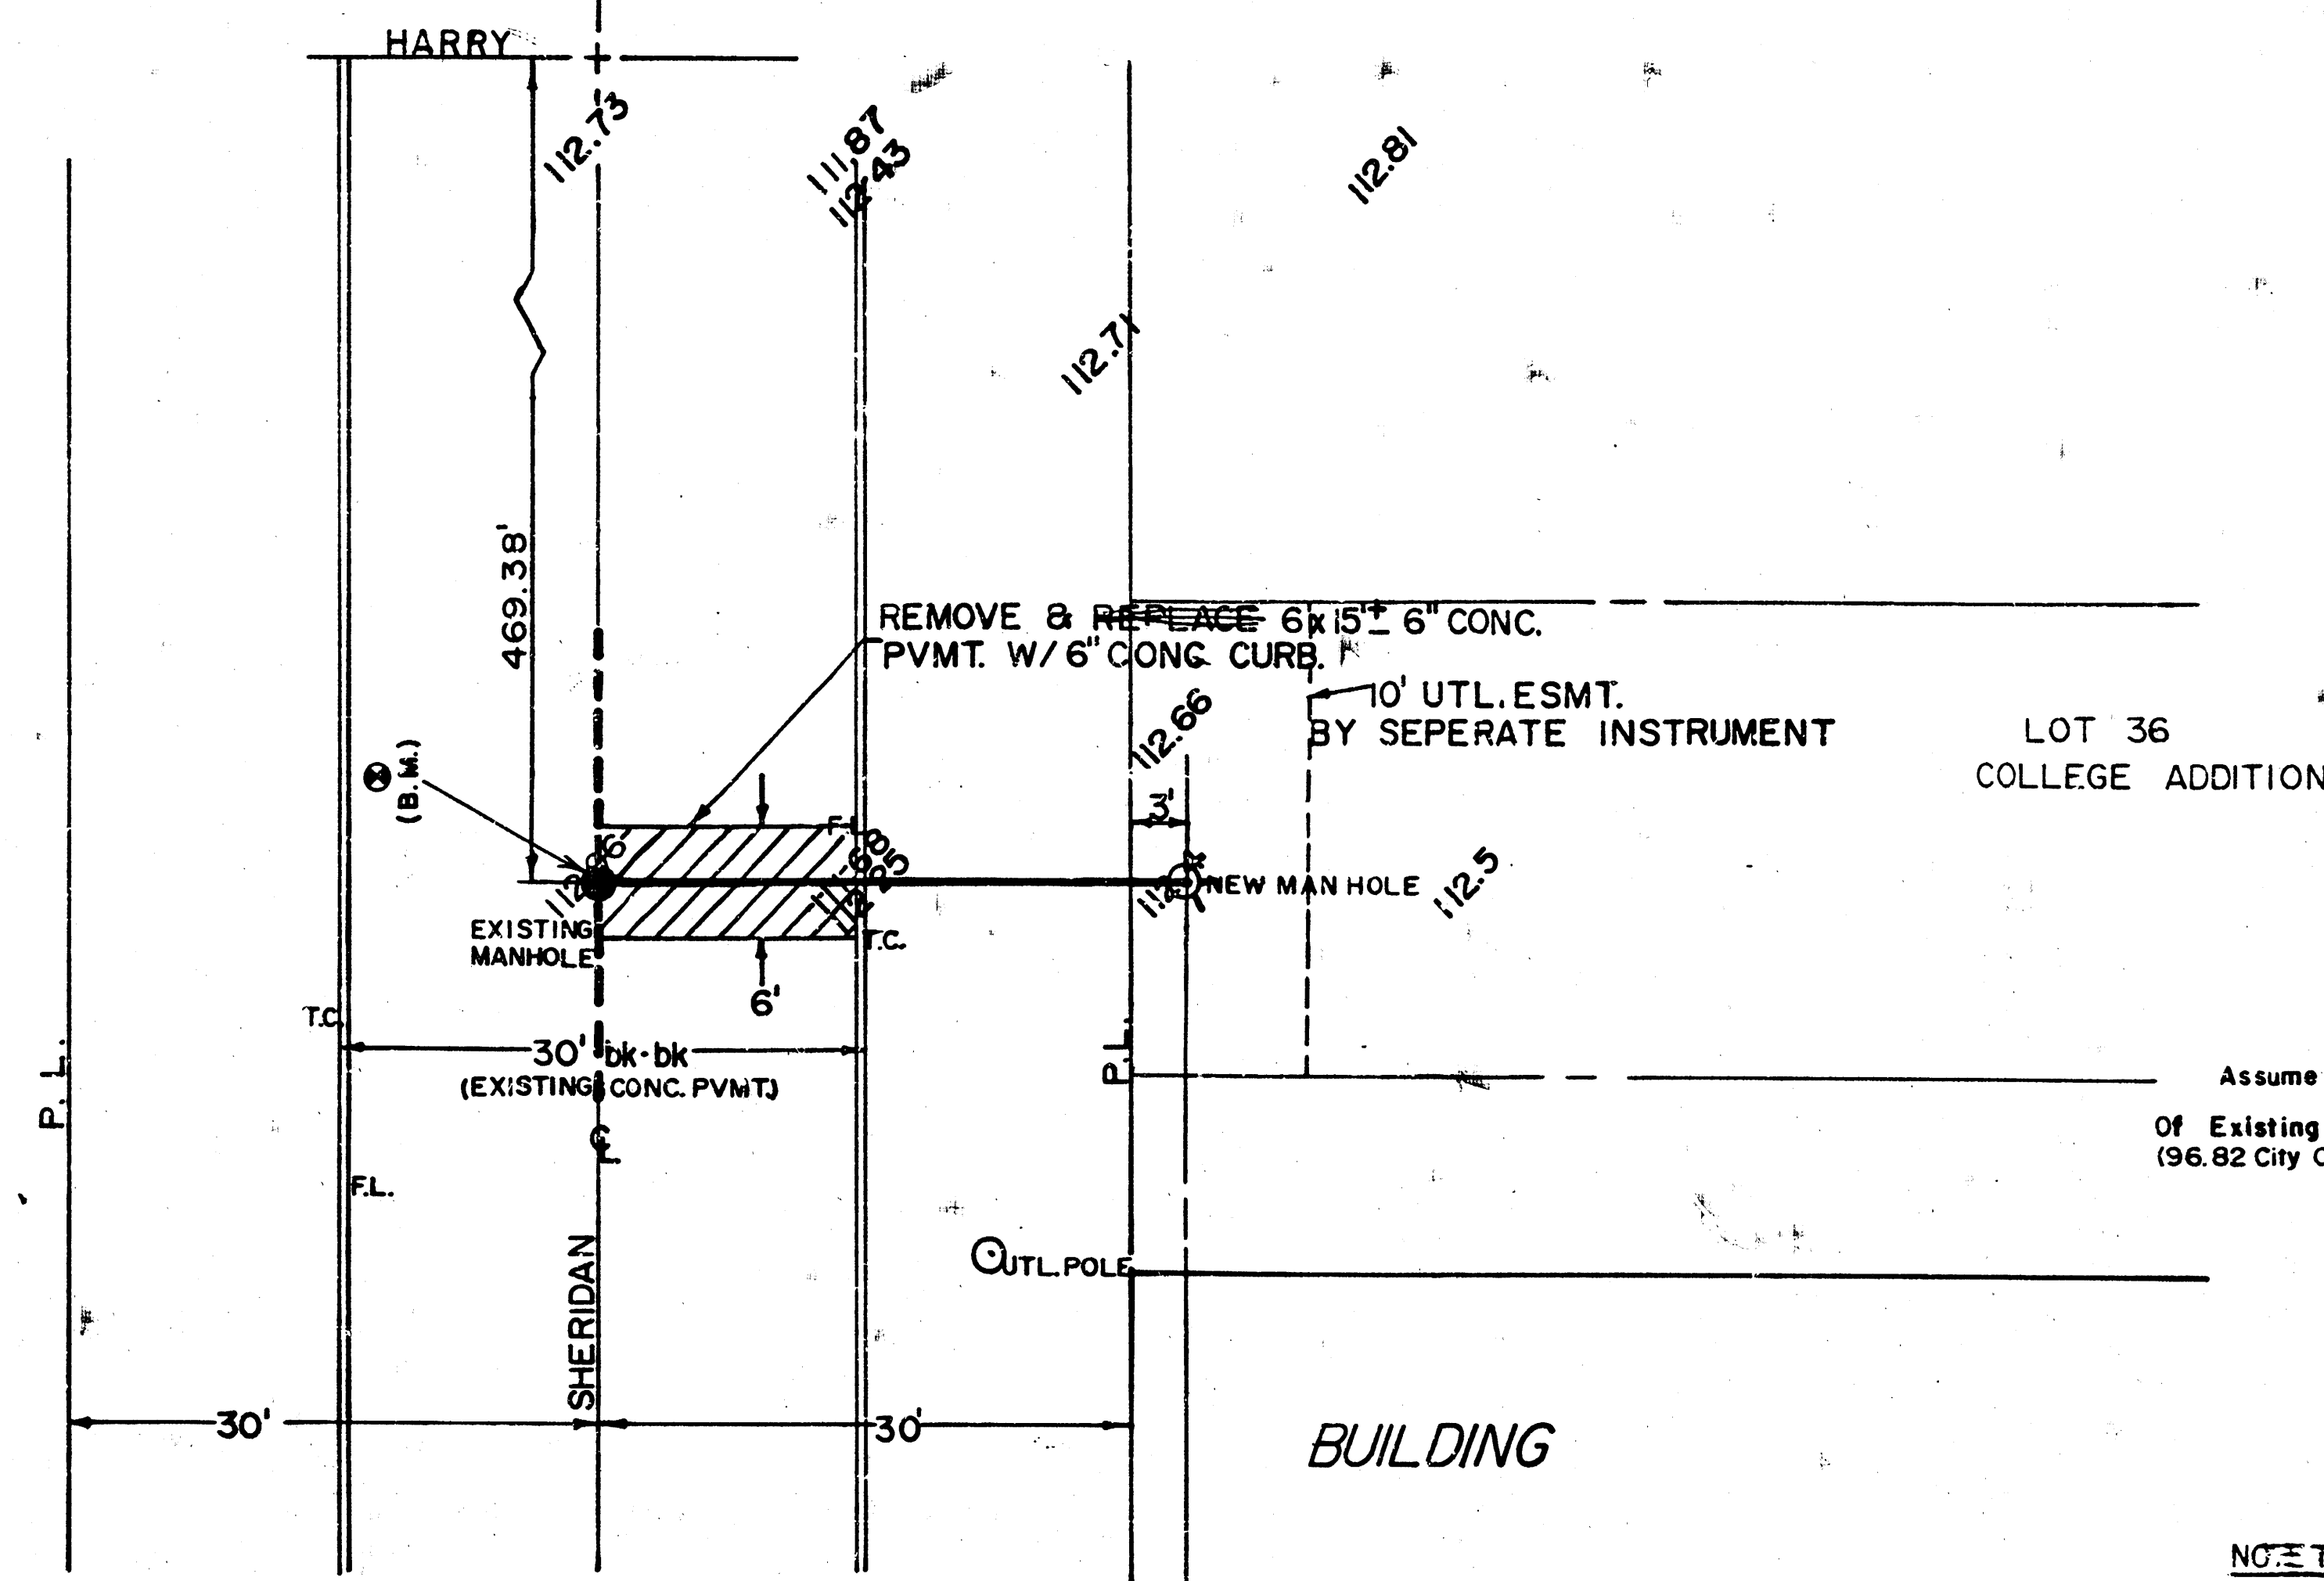

BENCH MARK
 Assume Elev. 100.00 on E.
 Of Existing Manhole At STA 0+00
 (96.82 City Of Wichita Datum)

NOTE TO CONTRACTOR


This project will be constructed under the supervision of the CITY ENGINEER and conforming to the SPECIFICATIONS of the CITY OF WICHITA. The CONTRACTOR will pay the City of Wichita for all plan review, inspection and testing per contract.

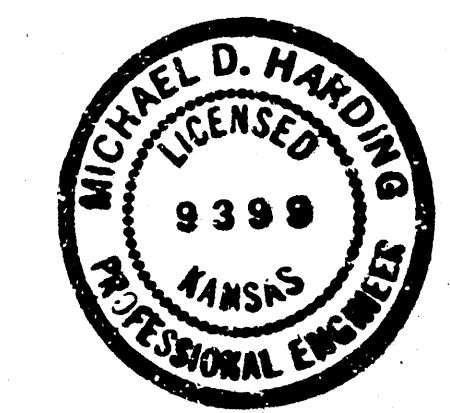

APPROVED AS NOTED
 By CITY ENGINEER OF WICHITA
 Sanitary Sewers *4/8 3/25/85*
 Storm Sewers _____
 Driveway Approaches _____

PLAN LINE 1

PROFILE LINE 1

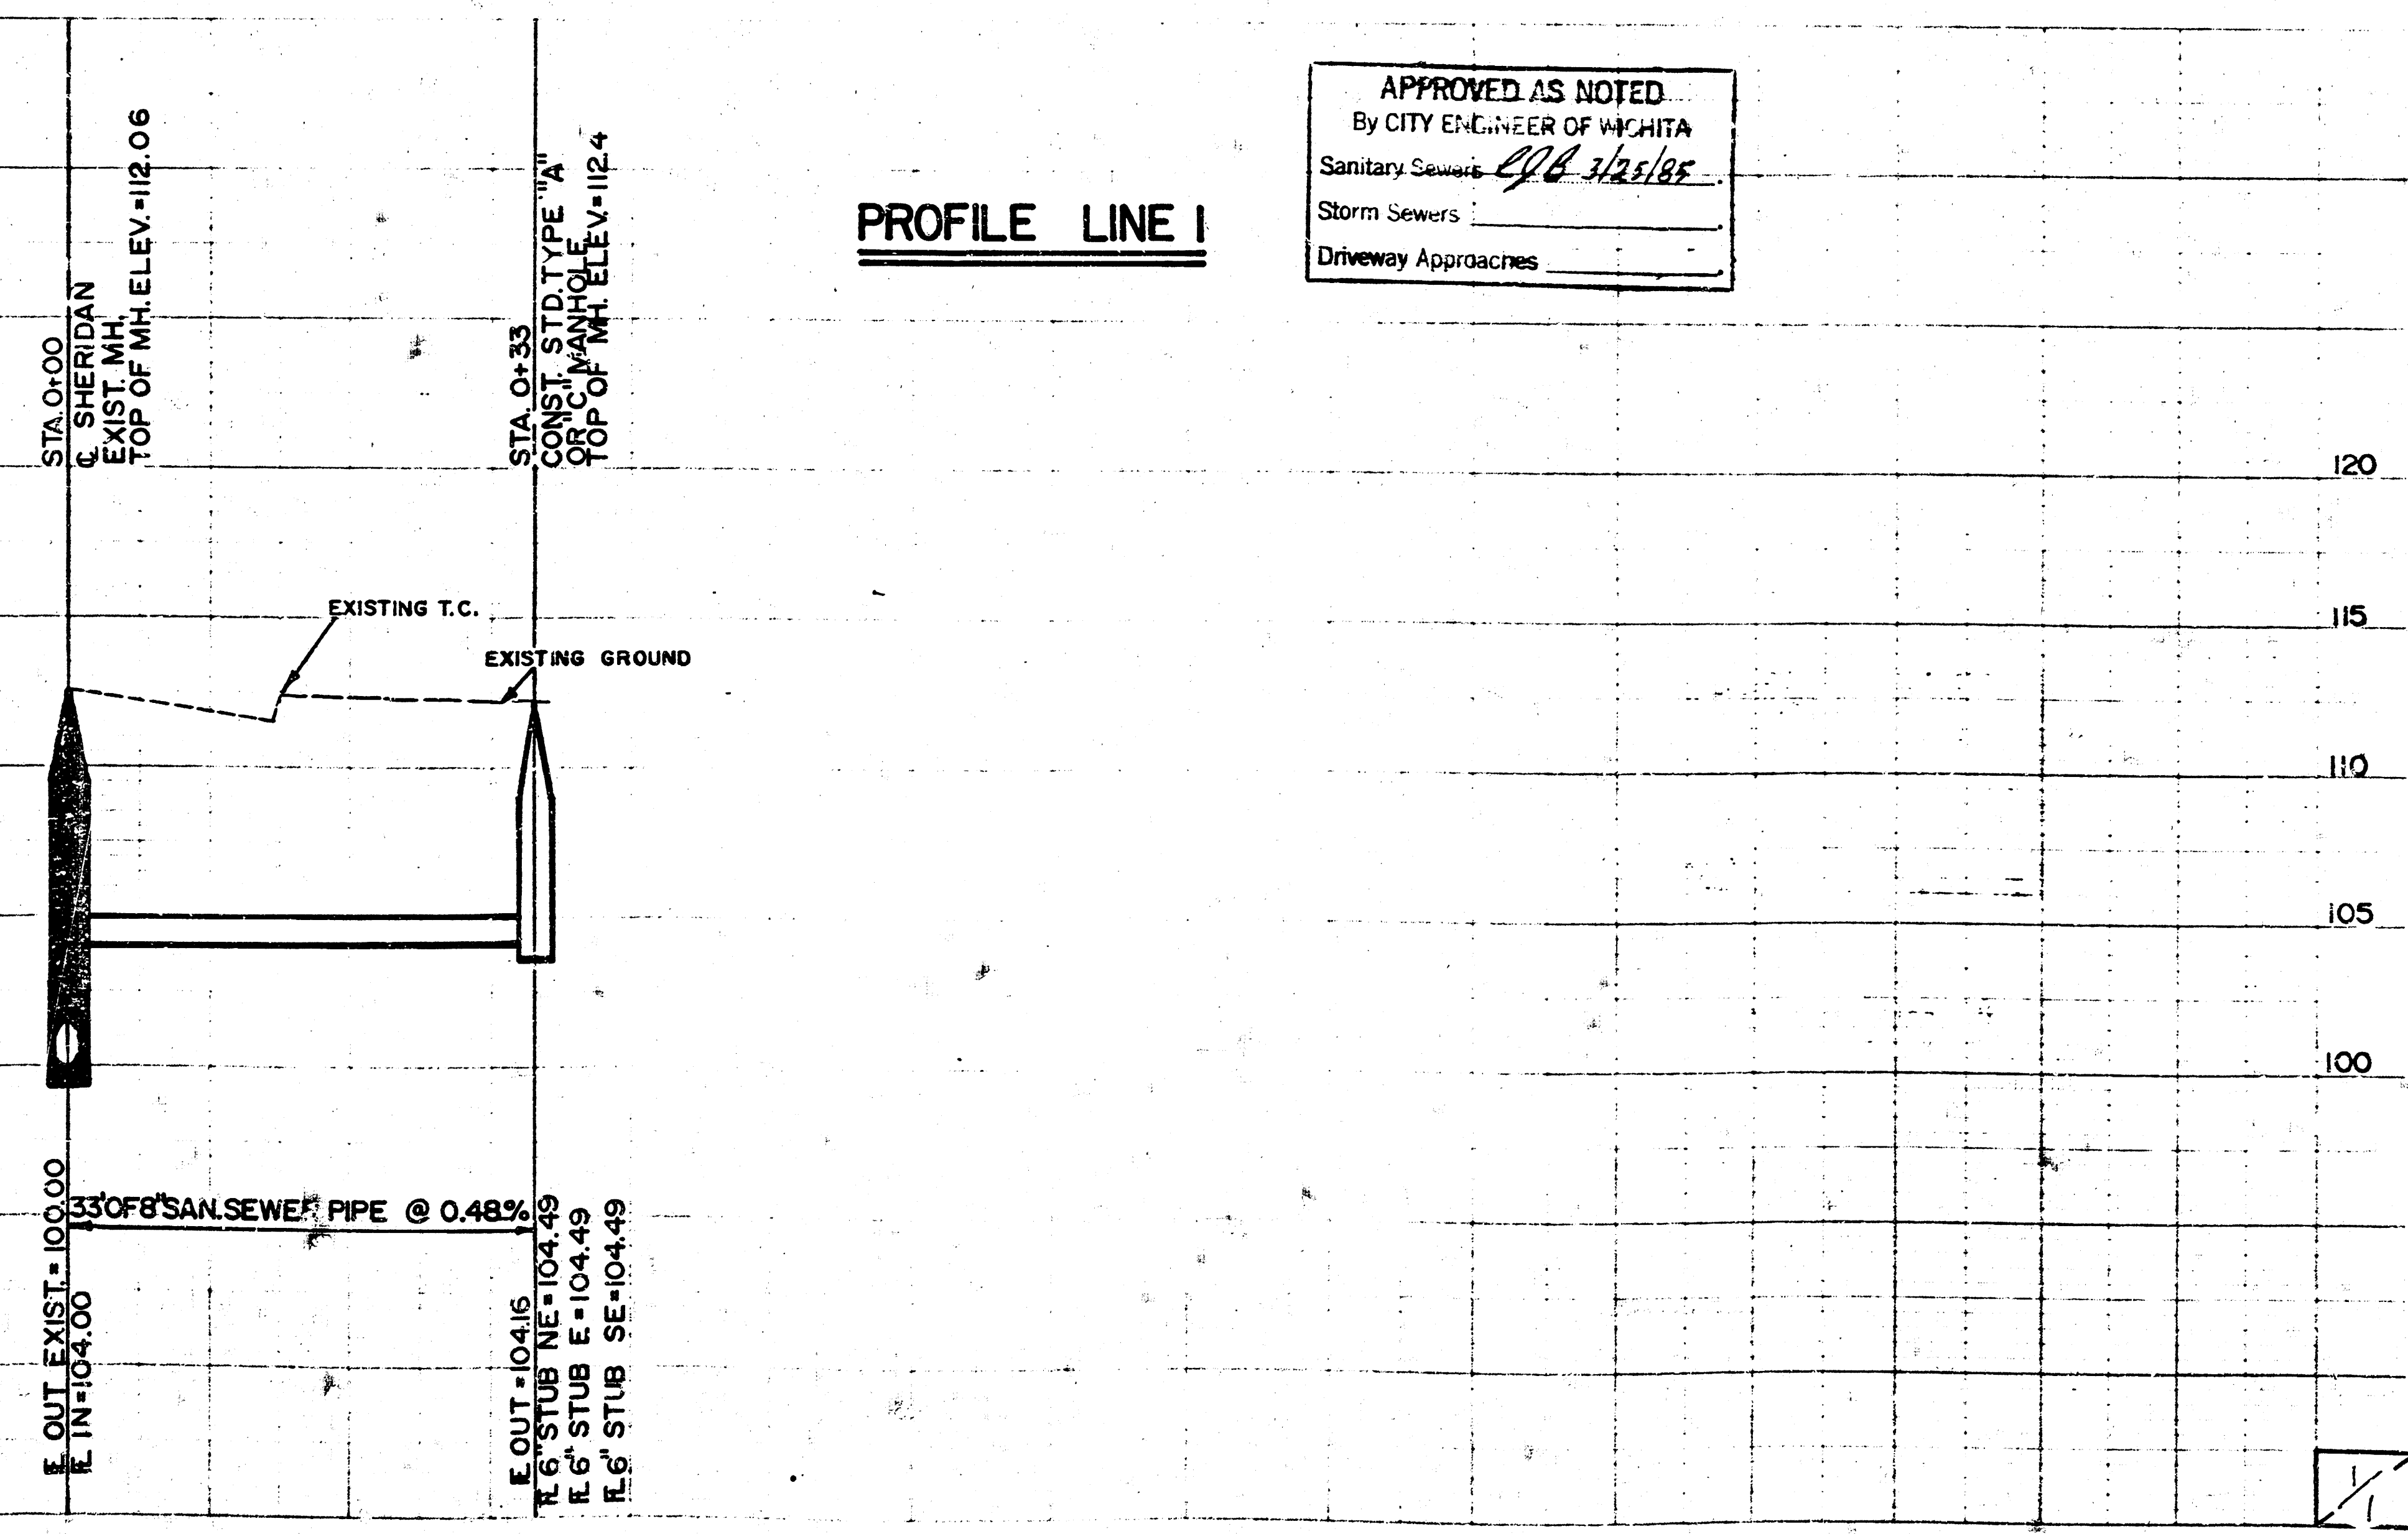

M.K.E.C.