AIRPORT INDUSTRIAL PARK ADDITION
(BLOCK 2)

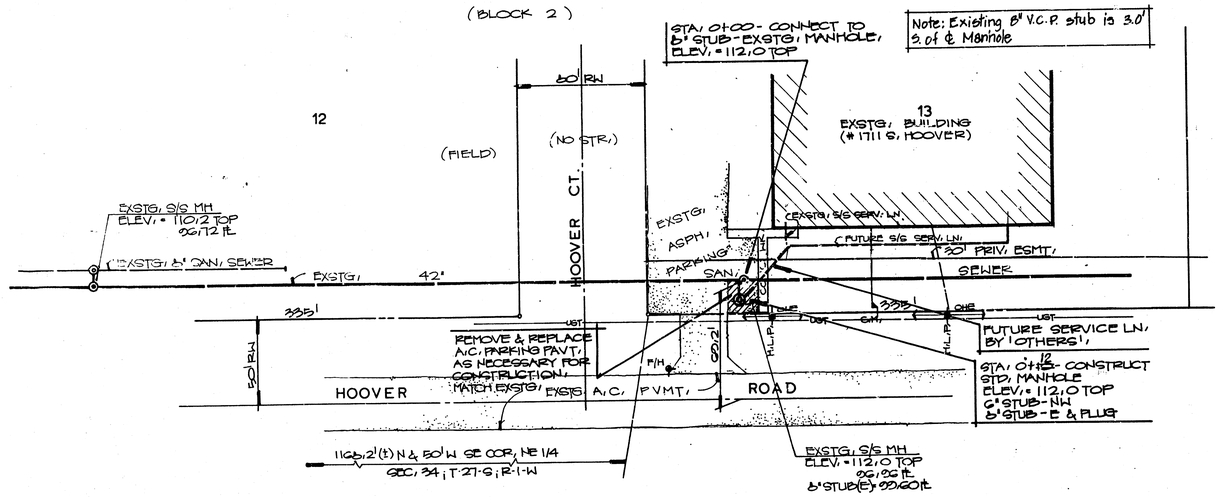

N
1" = 90' HORZ,
1" = 5' VERT,

NOTE TO CONTRACTOR

INSPECTION AND TESTING FOR THIS PROJECT IS TO BE PROVIDED BY A LICENSED CONSULTING ENGINEERING FIRM UNDER CONTRACT WITH THE OWNER/DEVELOPER. SAID INSPECTION TO BE IN ACCORDANCE WITH THE CITY OF WICHITA STANDARD CONSTRUCTION ENGINEERING PRACTICES AND CERTIFIED BY A LICENSED PROFESSIONAL ENGINEER. NO WORK SHALL BE PERFORMED IN DEDICATED EASEMENTS OR THE PUBLIC RIGHT-OF-WAY BY THE CONTRACTOR WITHOUT SUCH INSPECTION NOR SHALL ANY WORK BE COMMENCED IN DEDICATED EASEMENTS OR PUBLIC RIGHT-OF-WAY WITHOUT WRITTEN AUTHORIZATION BY THE CITY ENGINEER.

APPROVED AS NOTED
By CITY ENGINEER OF WICHITA

Sanitary Sewers VRH 5/7/90
Storm Sewers
Driveway Approaches
Water Mains
Paving

• BENCHMARKS •
1. CITY DISC - 44' S. & 45' W. ℄ INTERSECTION HARRY ST. @ HOOVER RD, ELEV, = 111.94 C.D.
2. CITY DISC - 45' E & 5' S SEC, 1/4 COR, (℄ MAY AVE @ HOOVER RD, ELEV, = 110.87 C.D.

PLAN
SURVEYED
PLOTTED
NOTE BOOK
No.
ALIGNMENT CHECKED
ELEVATIONS CHECKED

PROFILE
SURVEYED
PLOTTED
NOTE BOOK
GRADES CHECKED
S.W.I. NOTED
LOCATIONS/ELEVATIONS CHECKED
No.

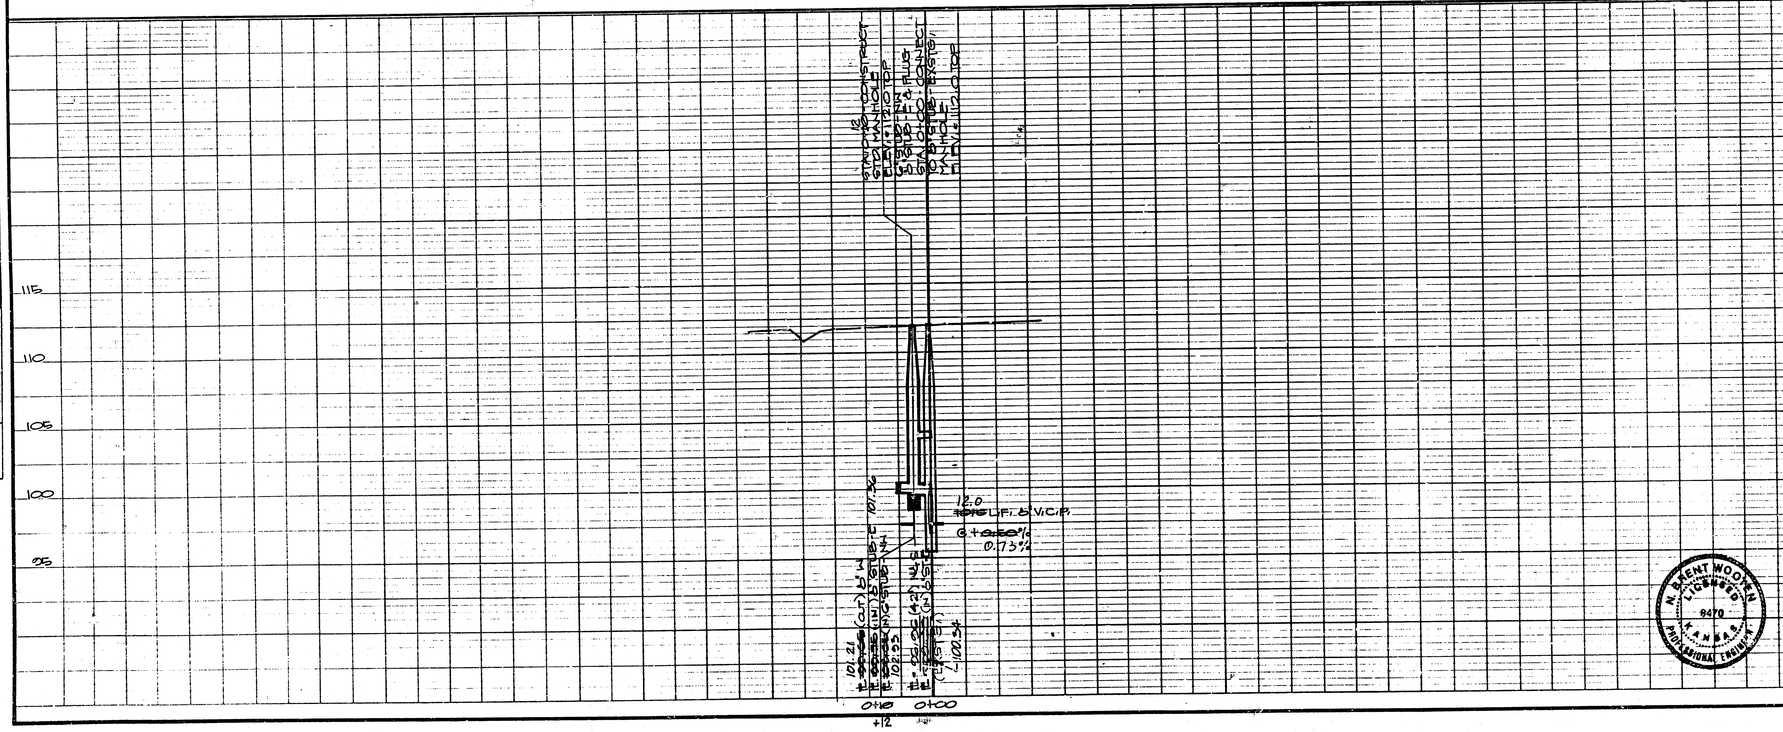
115
110
105
100
95
0+12
0+00
0+10
EXSTG, 8" SAN, SEWER
EXSTG, 42"
EXSTG, 8" SAN, SEWER
EXSTG, MANHOLE
ELEV, = 110.2 TOP
EXSTG, 8" SAN, SEWER
EXSTG, 42"

AIRPORT INDUSTRIAL PARK ADDITION
(BLOCK 2)

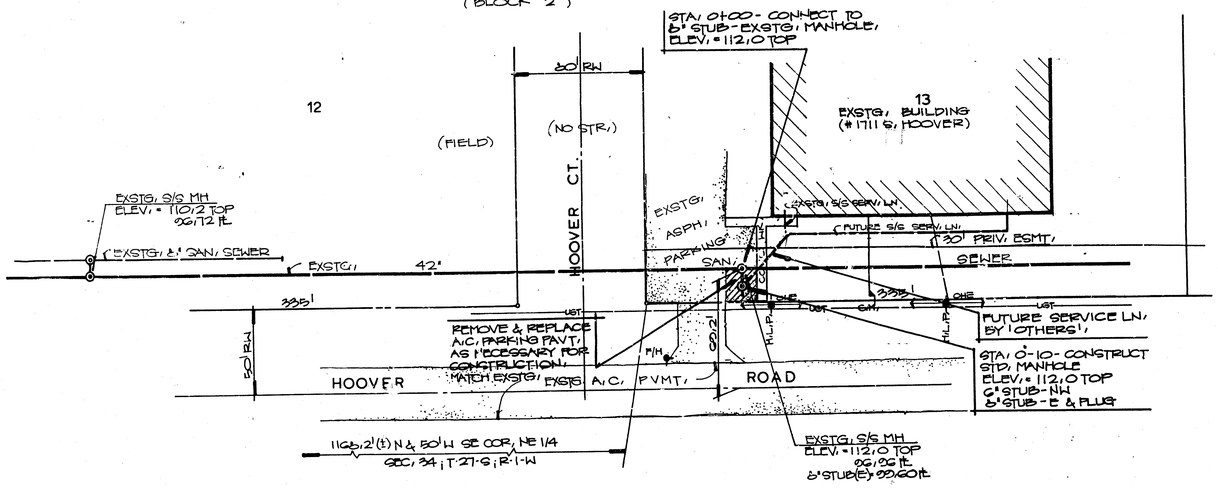

N
1" = 90' HORZ,
1" = 5' VERT,

NOTE TO CONTRACTOR

INSPECTION AND TESTING FOR THIS PROJECT IS TO BE PROVIDED BY A LICENSED CONSULTING ENGINEERING FIRM UNDER CONTRACT WITH THE OWNER/DEVELOPER. SAID INSPECTION TO BE IN ACCORDANCE WITH THE CITY OF WICHITA STANDARD CONSTRUCTION ENGINEERING PRACTICES AND CERTIFIED BY A LICENSED PROFESSIONAL ENGINEER. NO WORK SHALL BE PERFORMED IN DEDICATED EASEMENTS OR THE PUBLIC RIGHT-OF-WAY BY THE CONTRACTOR WITHOUT SUCH INSPECTION AND SHALL ANY WORK BE COMMENCED IN DEDICATED EASEMENTS OR PUBLIC RIGHT-OF-WAY WITHOUT WRITTEN AUTHORIZATION BY THE CITY ENGINEER.

APPROVED AS NOTED
By CITY ENGINEER OF WICHITA

Sanitary Sewers VRH 5/7/90
Storm Sewers
Driveway Approaches
Water Mains
Paving

• BENCHMARKS •

1, CITY DISC - 44'S, & 45'W OF E INTERSECTION HARRY ST, @ HOOVER RD, ELEV, = 111,94 C,D,
2, CITY DISC - 45'E & 5'S SEC, 1/4 COR, (E MAY AVE @ HOOVER RD, ELEV, = 110,37 C,D,

PLAN — SURVEYED / PLOTTED / NOTE BOOK / No. — DRAWN / CHECKED / CROSS CHECKED

PROFILE — SURVEYED / PLOTTED / NOTE BOOK / No. — GRADES CHECKED / R-W'S NOTED / STRUCTURE LOCATIONS CHECKED

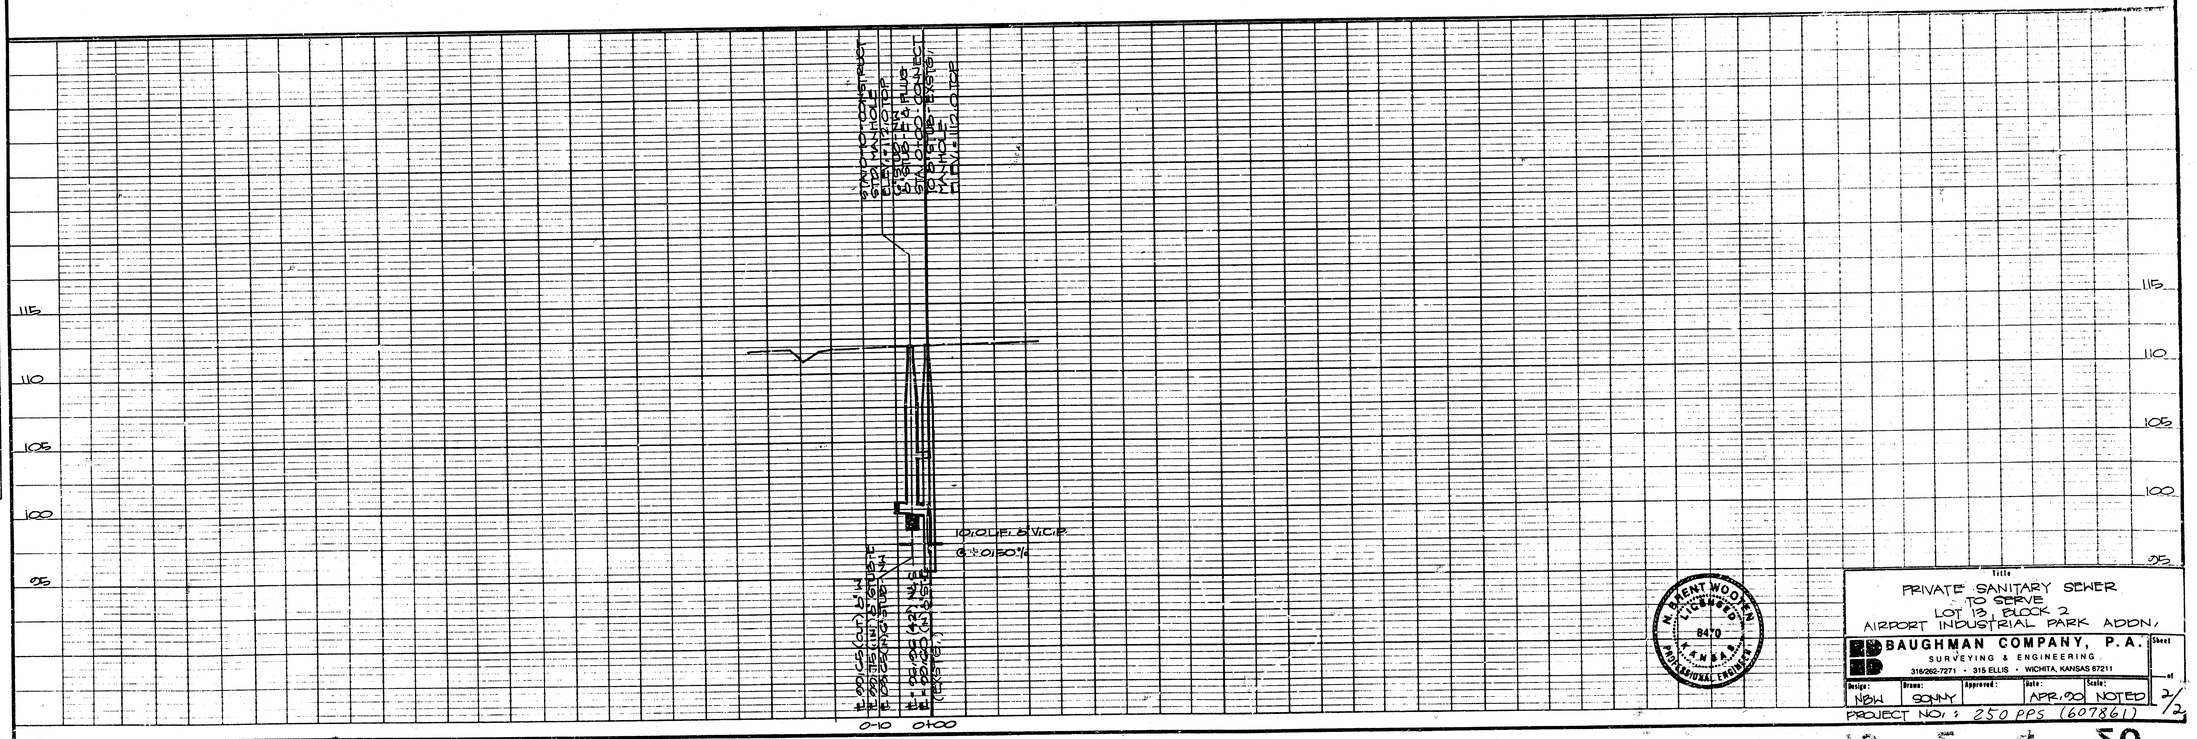


Title
PRIVATE SANITARY SEWER TO SERVE LOT 13, BLOCK 2 AIRPORT INDUSTRIAL PARK ADDN,

BAUGHMAN COMPANY, P.A.
SURVEYING & ENGINEERING
316/262-7271 • 315 ELLIS • WICHITA, KANSAS 67211

Design:	Drawn:	Approved:	Date:	Scale:	Sheet
NBW	SONNY		APR. '90	NOTED	2/2

PROJECT NO, : 250 PPS (607861)

12 5 4 50