7

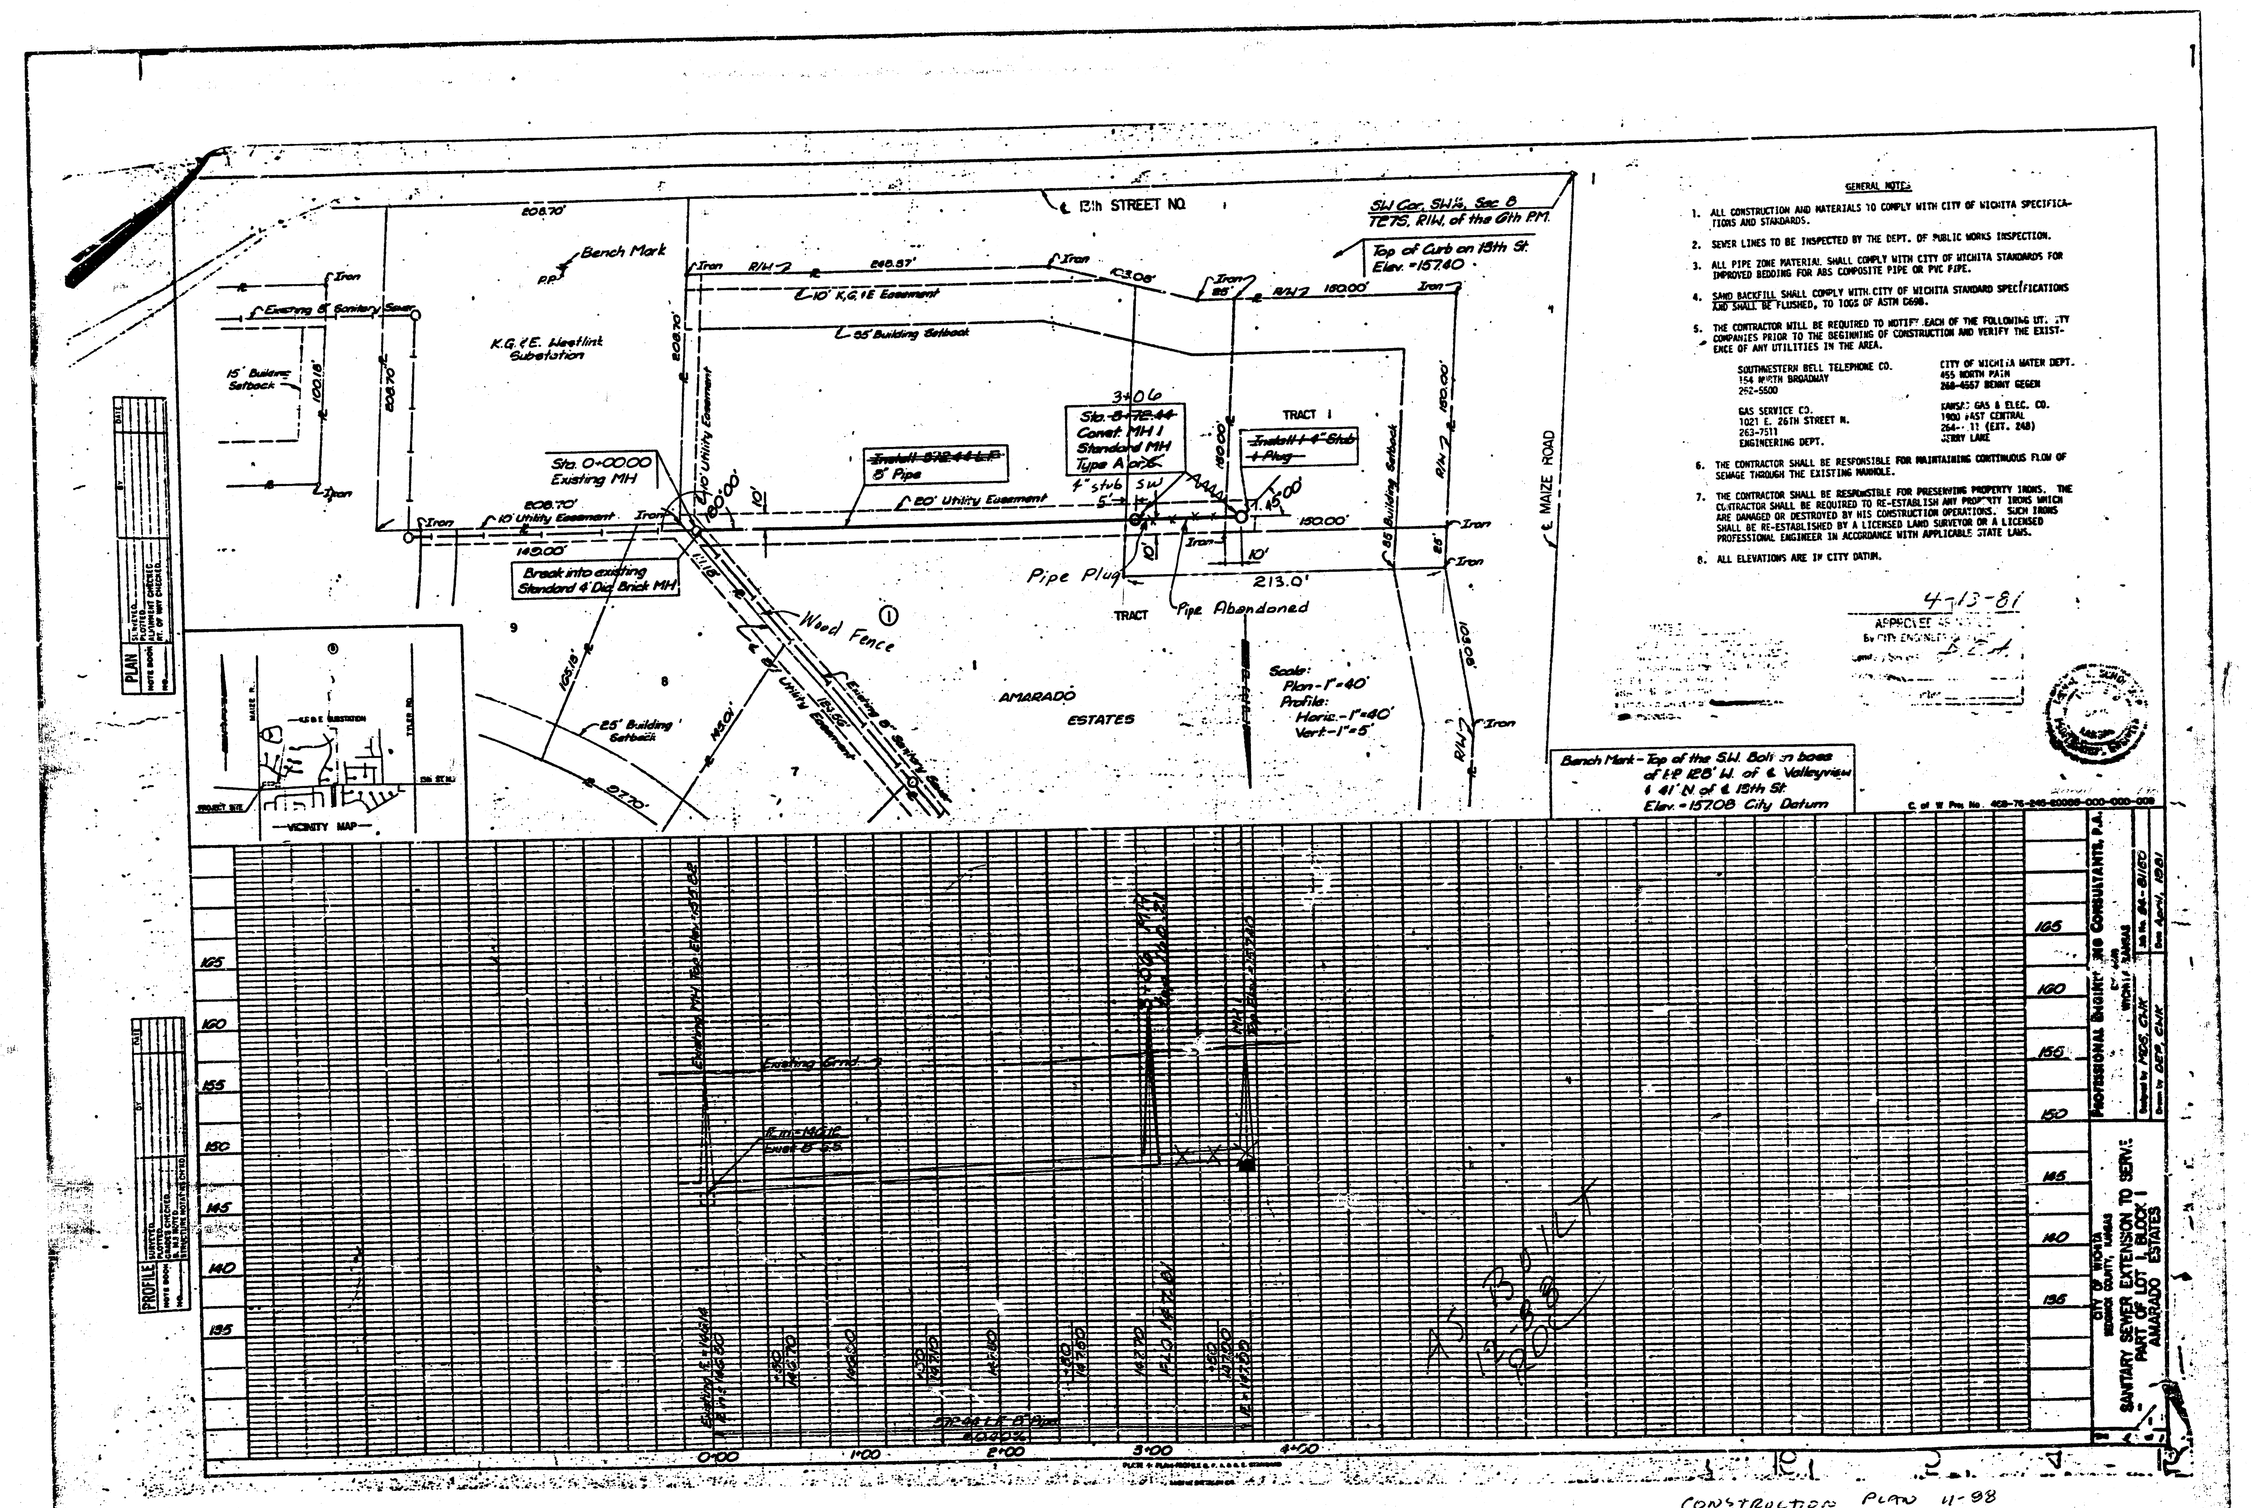

CONSTRUCTION PLAN 11-98
DO NOT CHARGE TIME TO THIS PROJECT 1/1

Private S.S.
Original &
As Built
FILM

FILMED FROM THE BEST AVAILABLE COPY.....