

APPROVED AS NOTED
 BY CITY ENGINEER OF WICHITA
 Sanitary Sewers 6-8-78
 Storm Sewers
 Utility Approaches

NOTE TO CONTRACTOR
 This project was designed under the supervision of the CITY ENGINEER and conforming to the SPECIFICATIONS of the CITY OF WICHITA. The CONTRACTOR will reimburse the City of Wichita for all cost of Engineering, Plans, and Inspection.



EISENHOWER AVENUE

EISENHOWER COURT

8

16" UTILITY Easement

303.81

Sta. 267.50
 Const. std. M.H.
 for forced main


4" forced main
 Av. Ed. Center
 located at
 20th Eisen

AIRPORT

INDUSTRIAL

7
 PARK

378.21

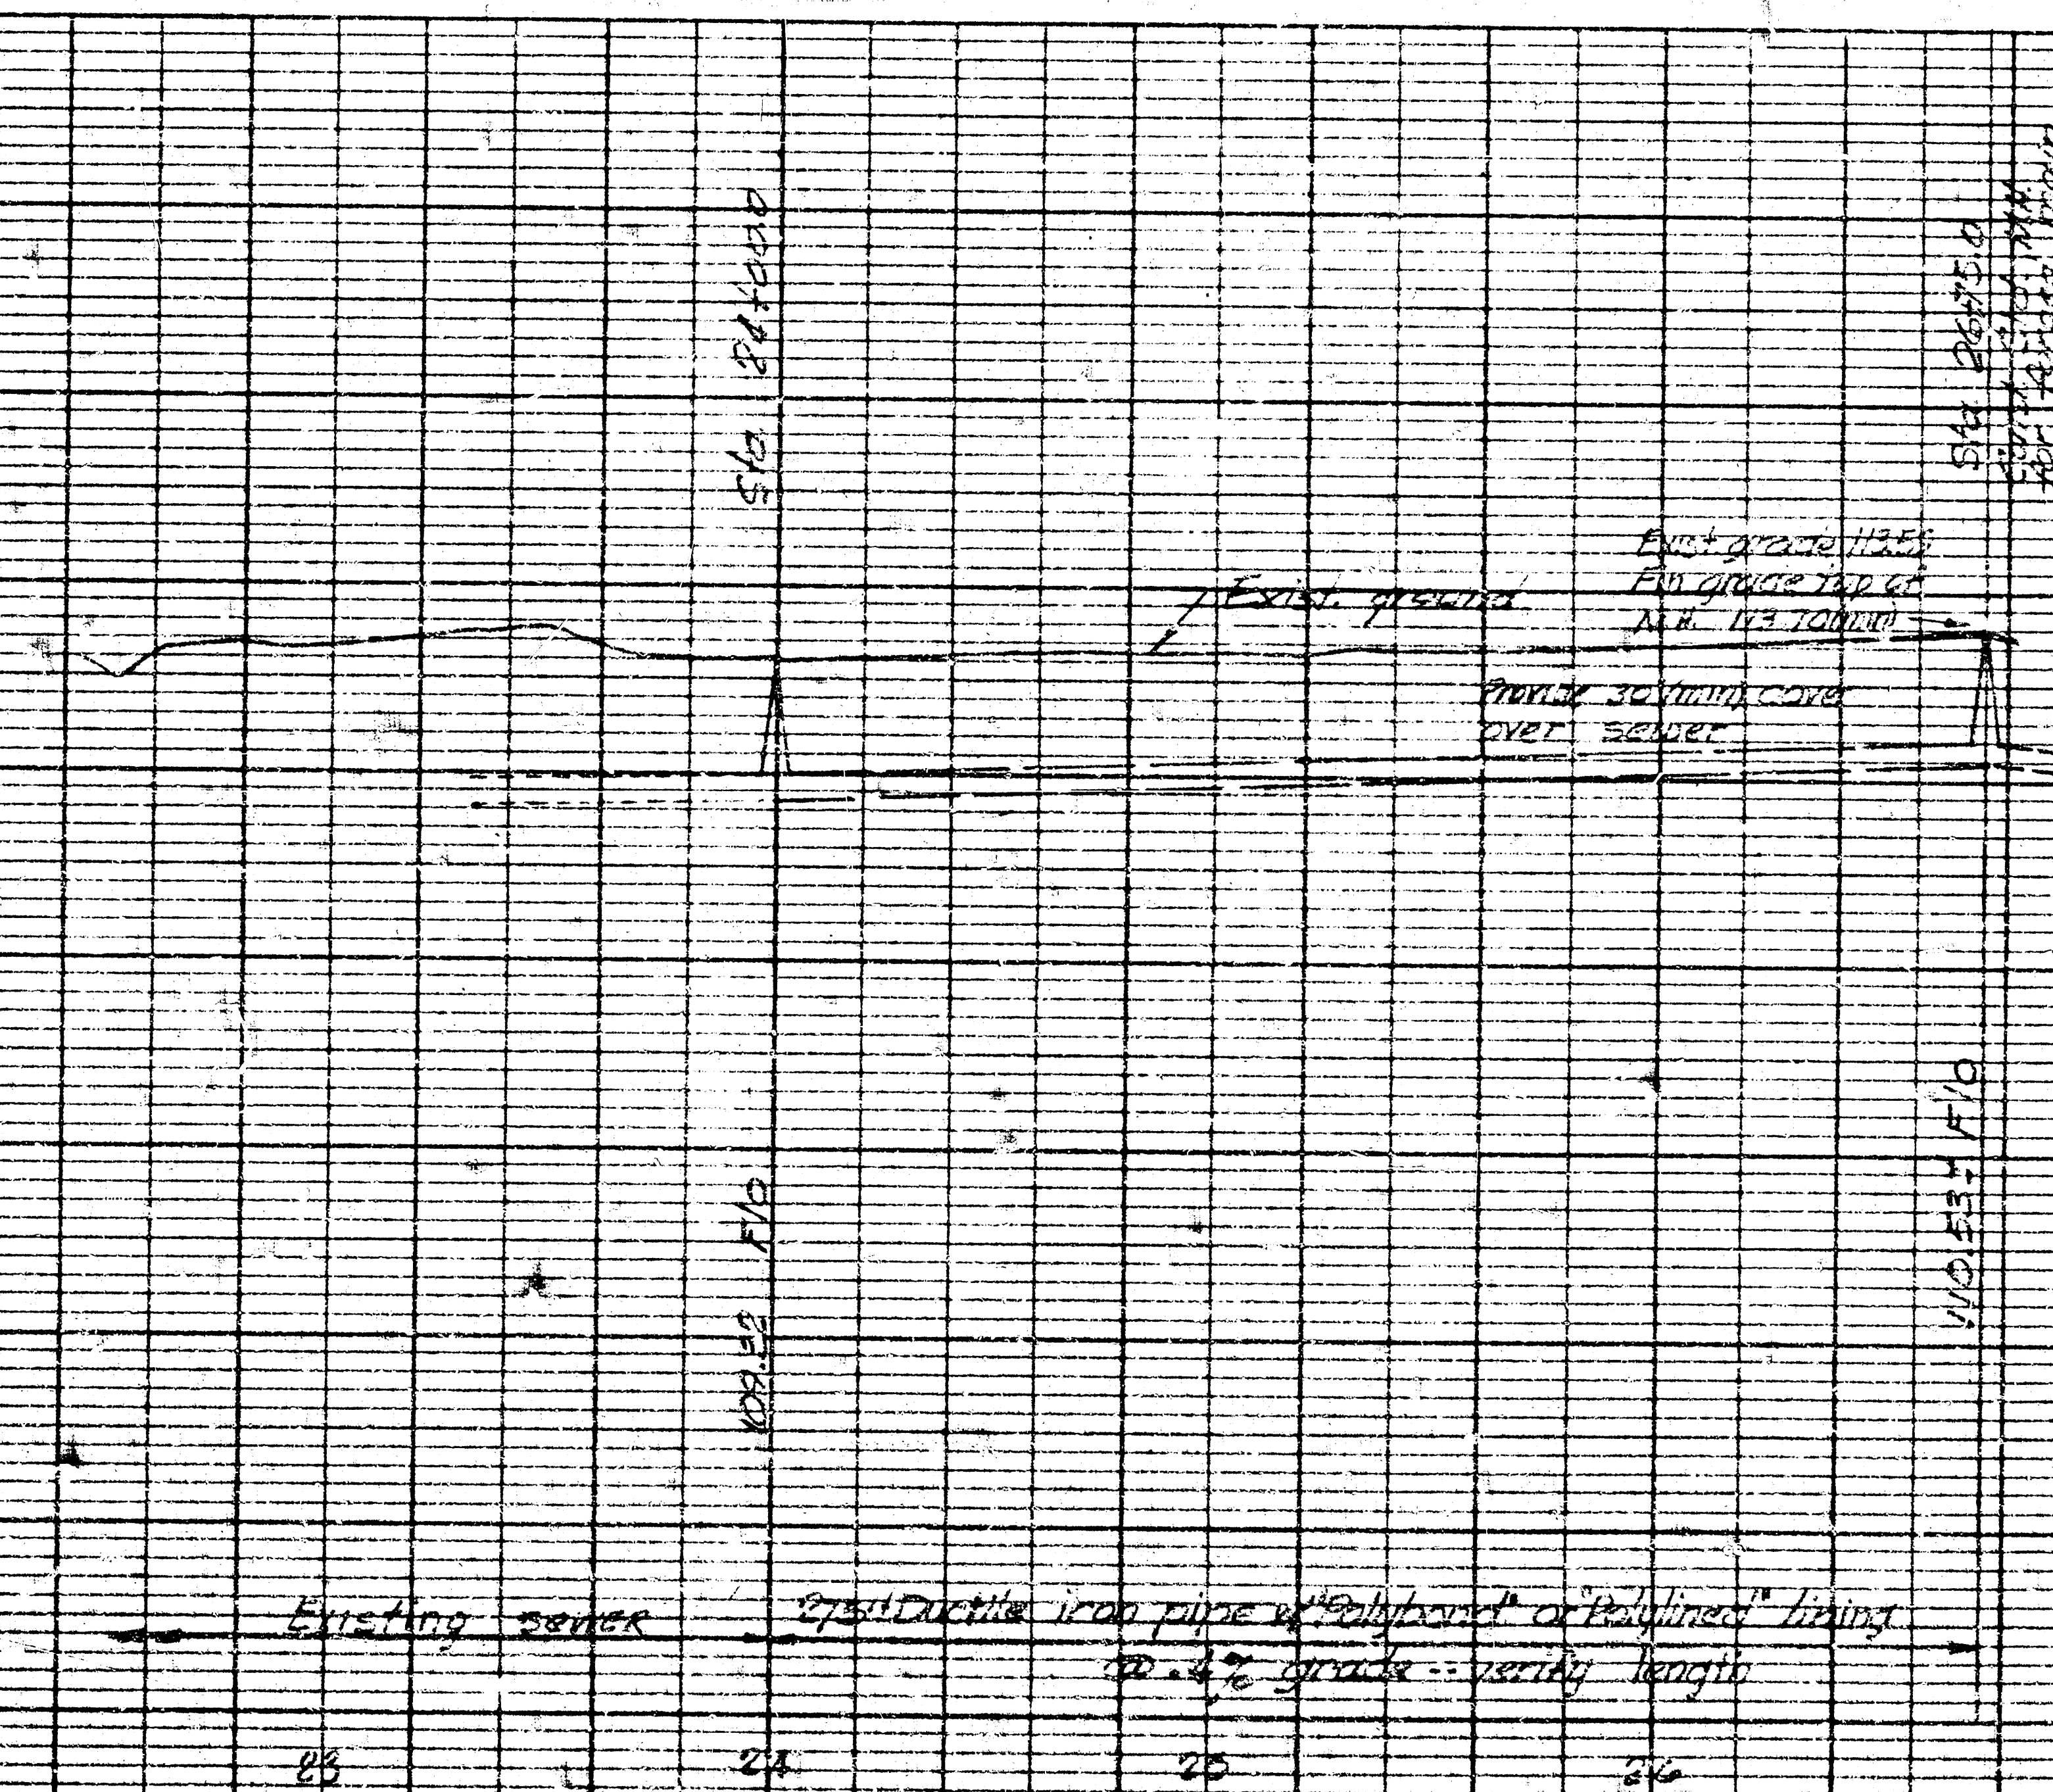

EXTENSION OF EXISTING SW INTERCEPTOR SEWER