


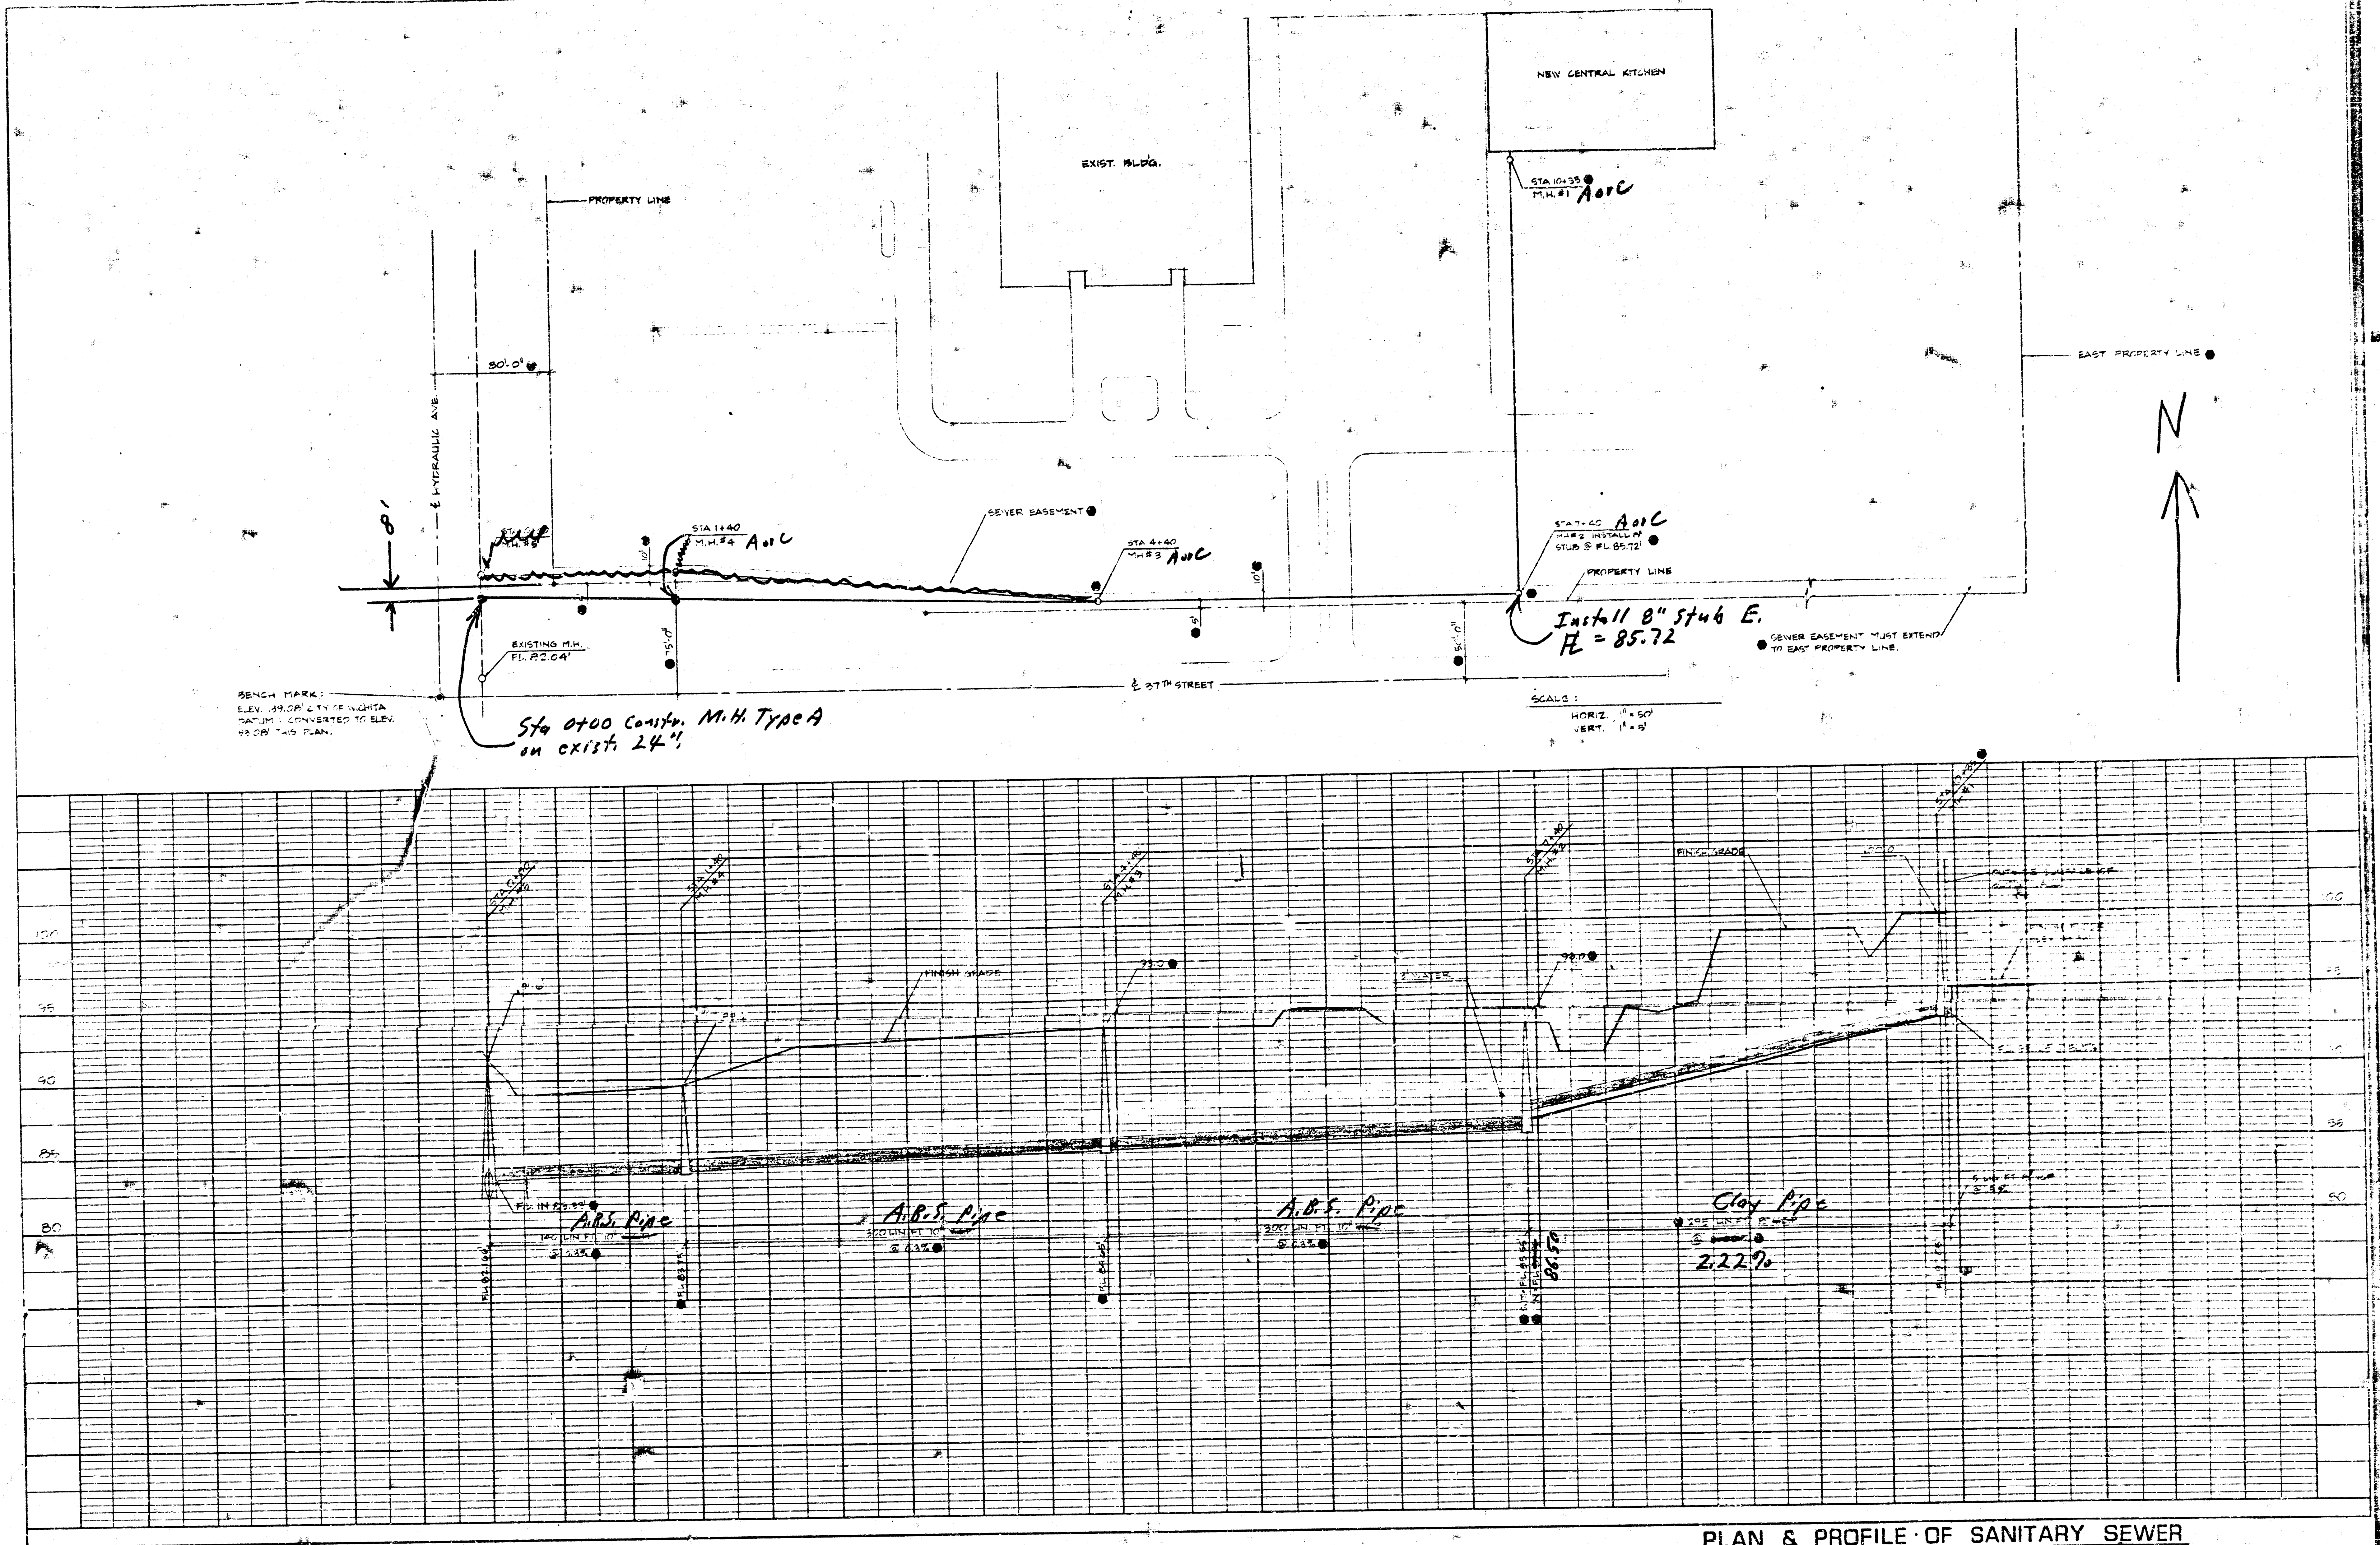

PLAN & PROFILE OF SANITARY SEWER
BOARD OF EDUCATION
FOOD PRODUCTION CENTER
CITY PROJ. # 468-76-245-80495-000-000-008

3-9-78
APPROVED AS NOTED
By CITY ENGINEER OF WICHITA
Sanitary Sewers *per*
Storm Sewers
Driveway Approaches

NOTE TO CONTRACTOR
This project will be constructed under

ARCHITECTURE PLANNING
ENGINEERING INTERIORS
LANDSCAPE ARCHITECTURE
WICHITA
SCHAEFER & ASSOCIATES P.A.

SCHAEFER & ASSOCIATES P.A.

A NEW CENTRAL FOOD
PRODUCTION FACILITY
FOR U.S.D. 259
KANSAS
WICHITA

EDA PROJECT
NUMBER:
05-51-26616