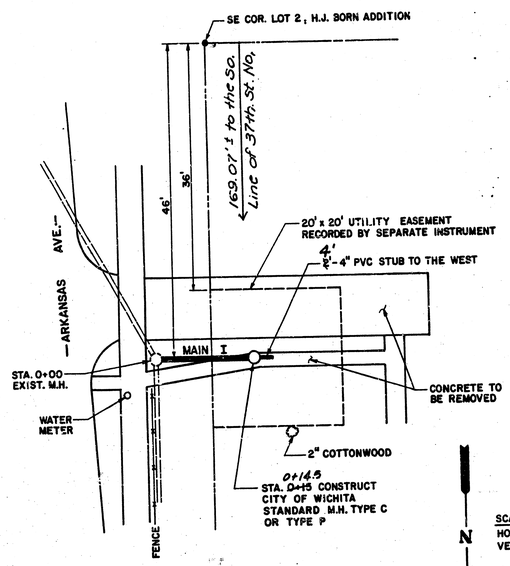

N

SCALE
HORIZONTAL: 1" = 10'
VERTICAL: 1" = 5'

B.M. = CITY DISC WEST FACE WALK EAST SIDE ARKANSAS ON FLOOD CONTROL DIKE, 100.4' NORTH OF 37th ST.
ELEV. – 135.75

PLANS
FOR
SANITARY SEWER SYSTEM
FOR
E. 150' OF LOT 2 EXCEPT S. 0.19' THEREOF
H.J. BORN ADD.
SEDGWICK COUNTY, KANSAS
CITY OF WICHITA PRIVATE PROJECT NO. 468-76-245-80001-000-000-175
1988

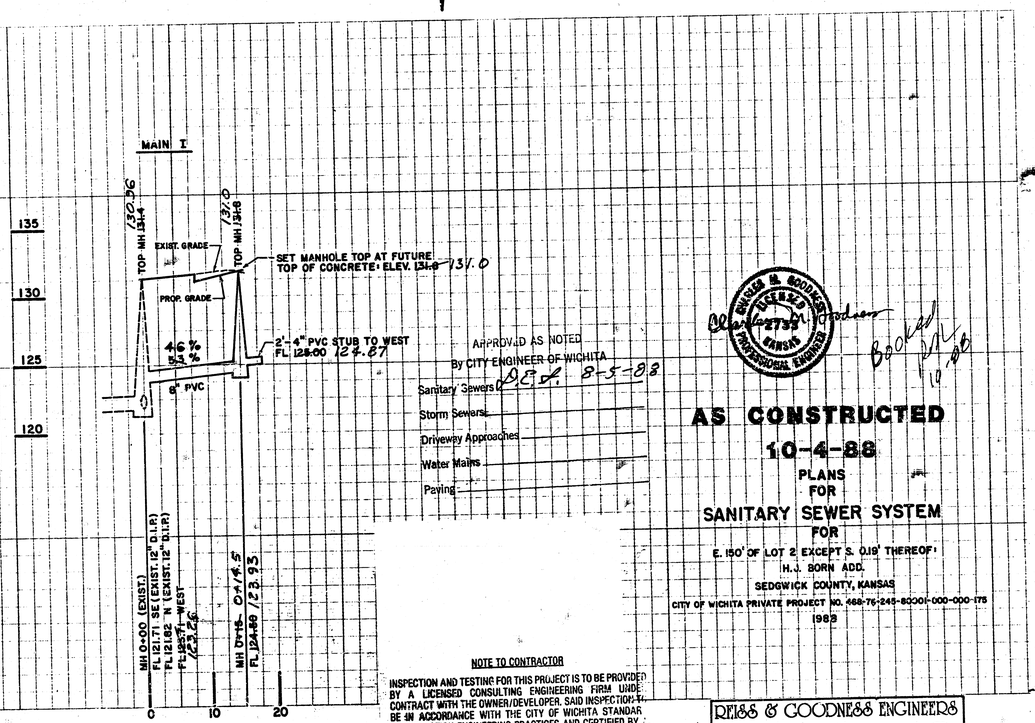

FID 1265 - PLAN PROFILE PLATE A
"CLEARPRINT PAPER CO."
MADE IN U.S.A.

APPROVED AS NOTED
By CITY ENGINEER OF WICHITA
Sanitary Sewers DEH 8-5-88
Storm Sewers
Driveway Approaches
Water Mains
Paving

NOTE TO CONTRACTOR

INSPECTION AND TESTING FOR THIS PROJECT IS TO BE PROVIDED BY A LICENSED CONSULTING ENGINEERING FIRM UNDER CONTRACT WITH THE OWNER/DEVELOPER. SAID INSPECTION TO BE IN ACCORDANCE WITH THE CITY OF WICHITA STANDARD CONSTRUCTION ENGINEERING PRACTICES AND CERTIFIED BY A LICENSED PROFESSIONAL ENGINEER. NO WORK SHALL BE PERFORMED IN DEDICATED EASEMENTS OR THE PUBLIC RIGHT-OF-WAY BY THE CONTRACTOR WITHOUT SUCH INSPECTION NOR SHALL ANY WORK BE COMMENCED IN DEDICATED EASEMENTS OR PUBLIC RIGHT-OF-WAY WITHOUT WRITTEN AUTHORIZATION BY THE CITY ENGINEER.



Booked 10/88

AS CONSTRUCTED
10-4-88

PLANS
FOR
SANITARY SEWER SYSTEM
FOR
E. 150' OF LOT 2 EXCEPT S. 0.19' THEREOF
H.J. BORN ADD.
SEDGWICK COUNTY, KANSAS
CITY OF WICHITA PRIVATE PROJECT NO. 468-76-245-80001-000-000-175
1988

REISS & GOODNESS ENGINEERS
2160 WEST 21st STREET
WICHITA, KANSAS 67204
(316) 832-0213

FILMED FROM THE BEST AVAILABLE COPY