

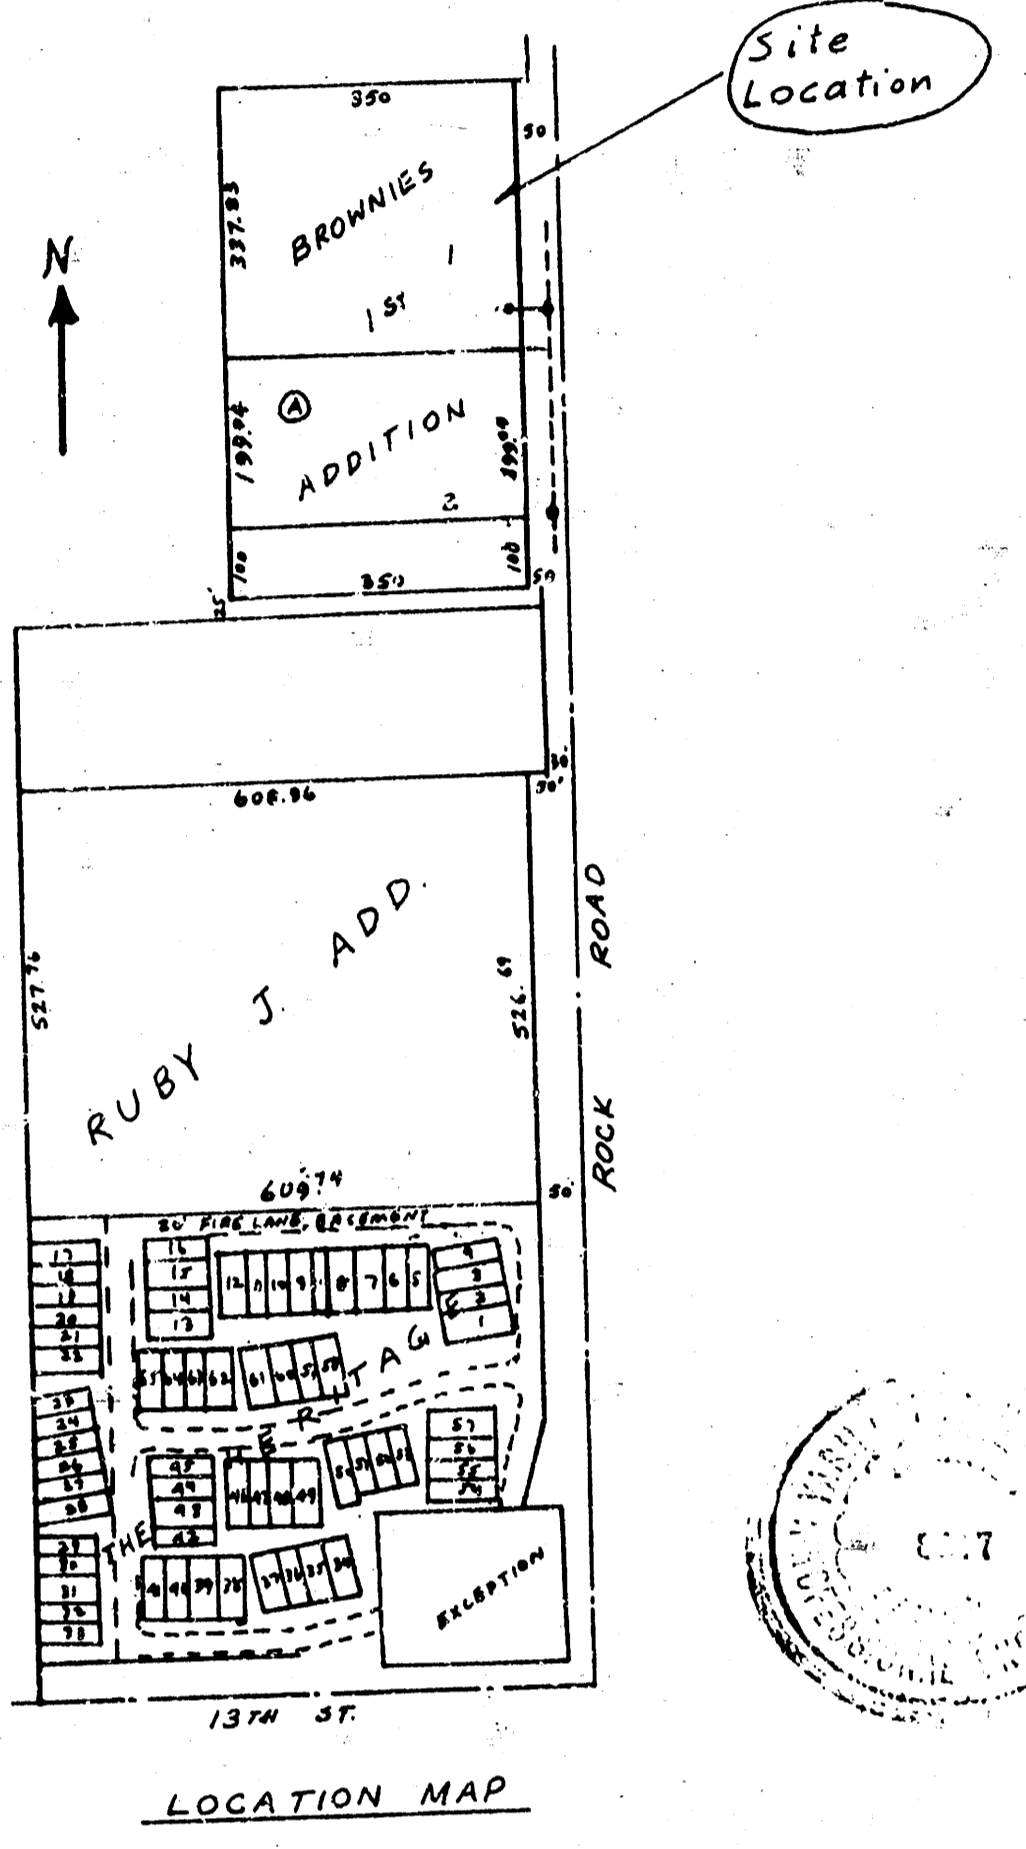


FILMED FROM THE BEST AVAILABLE COPY

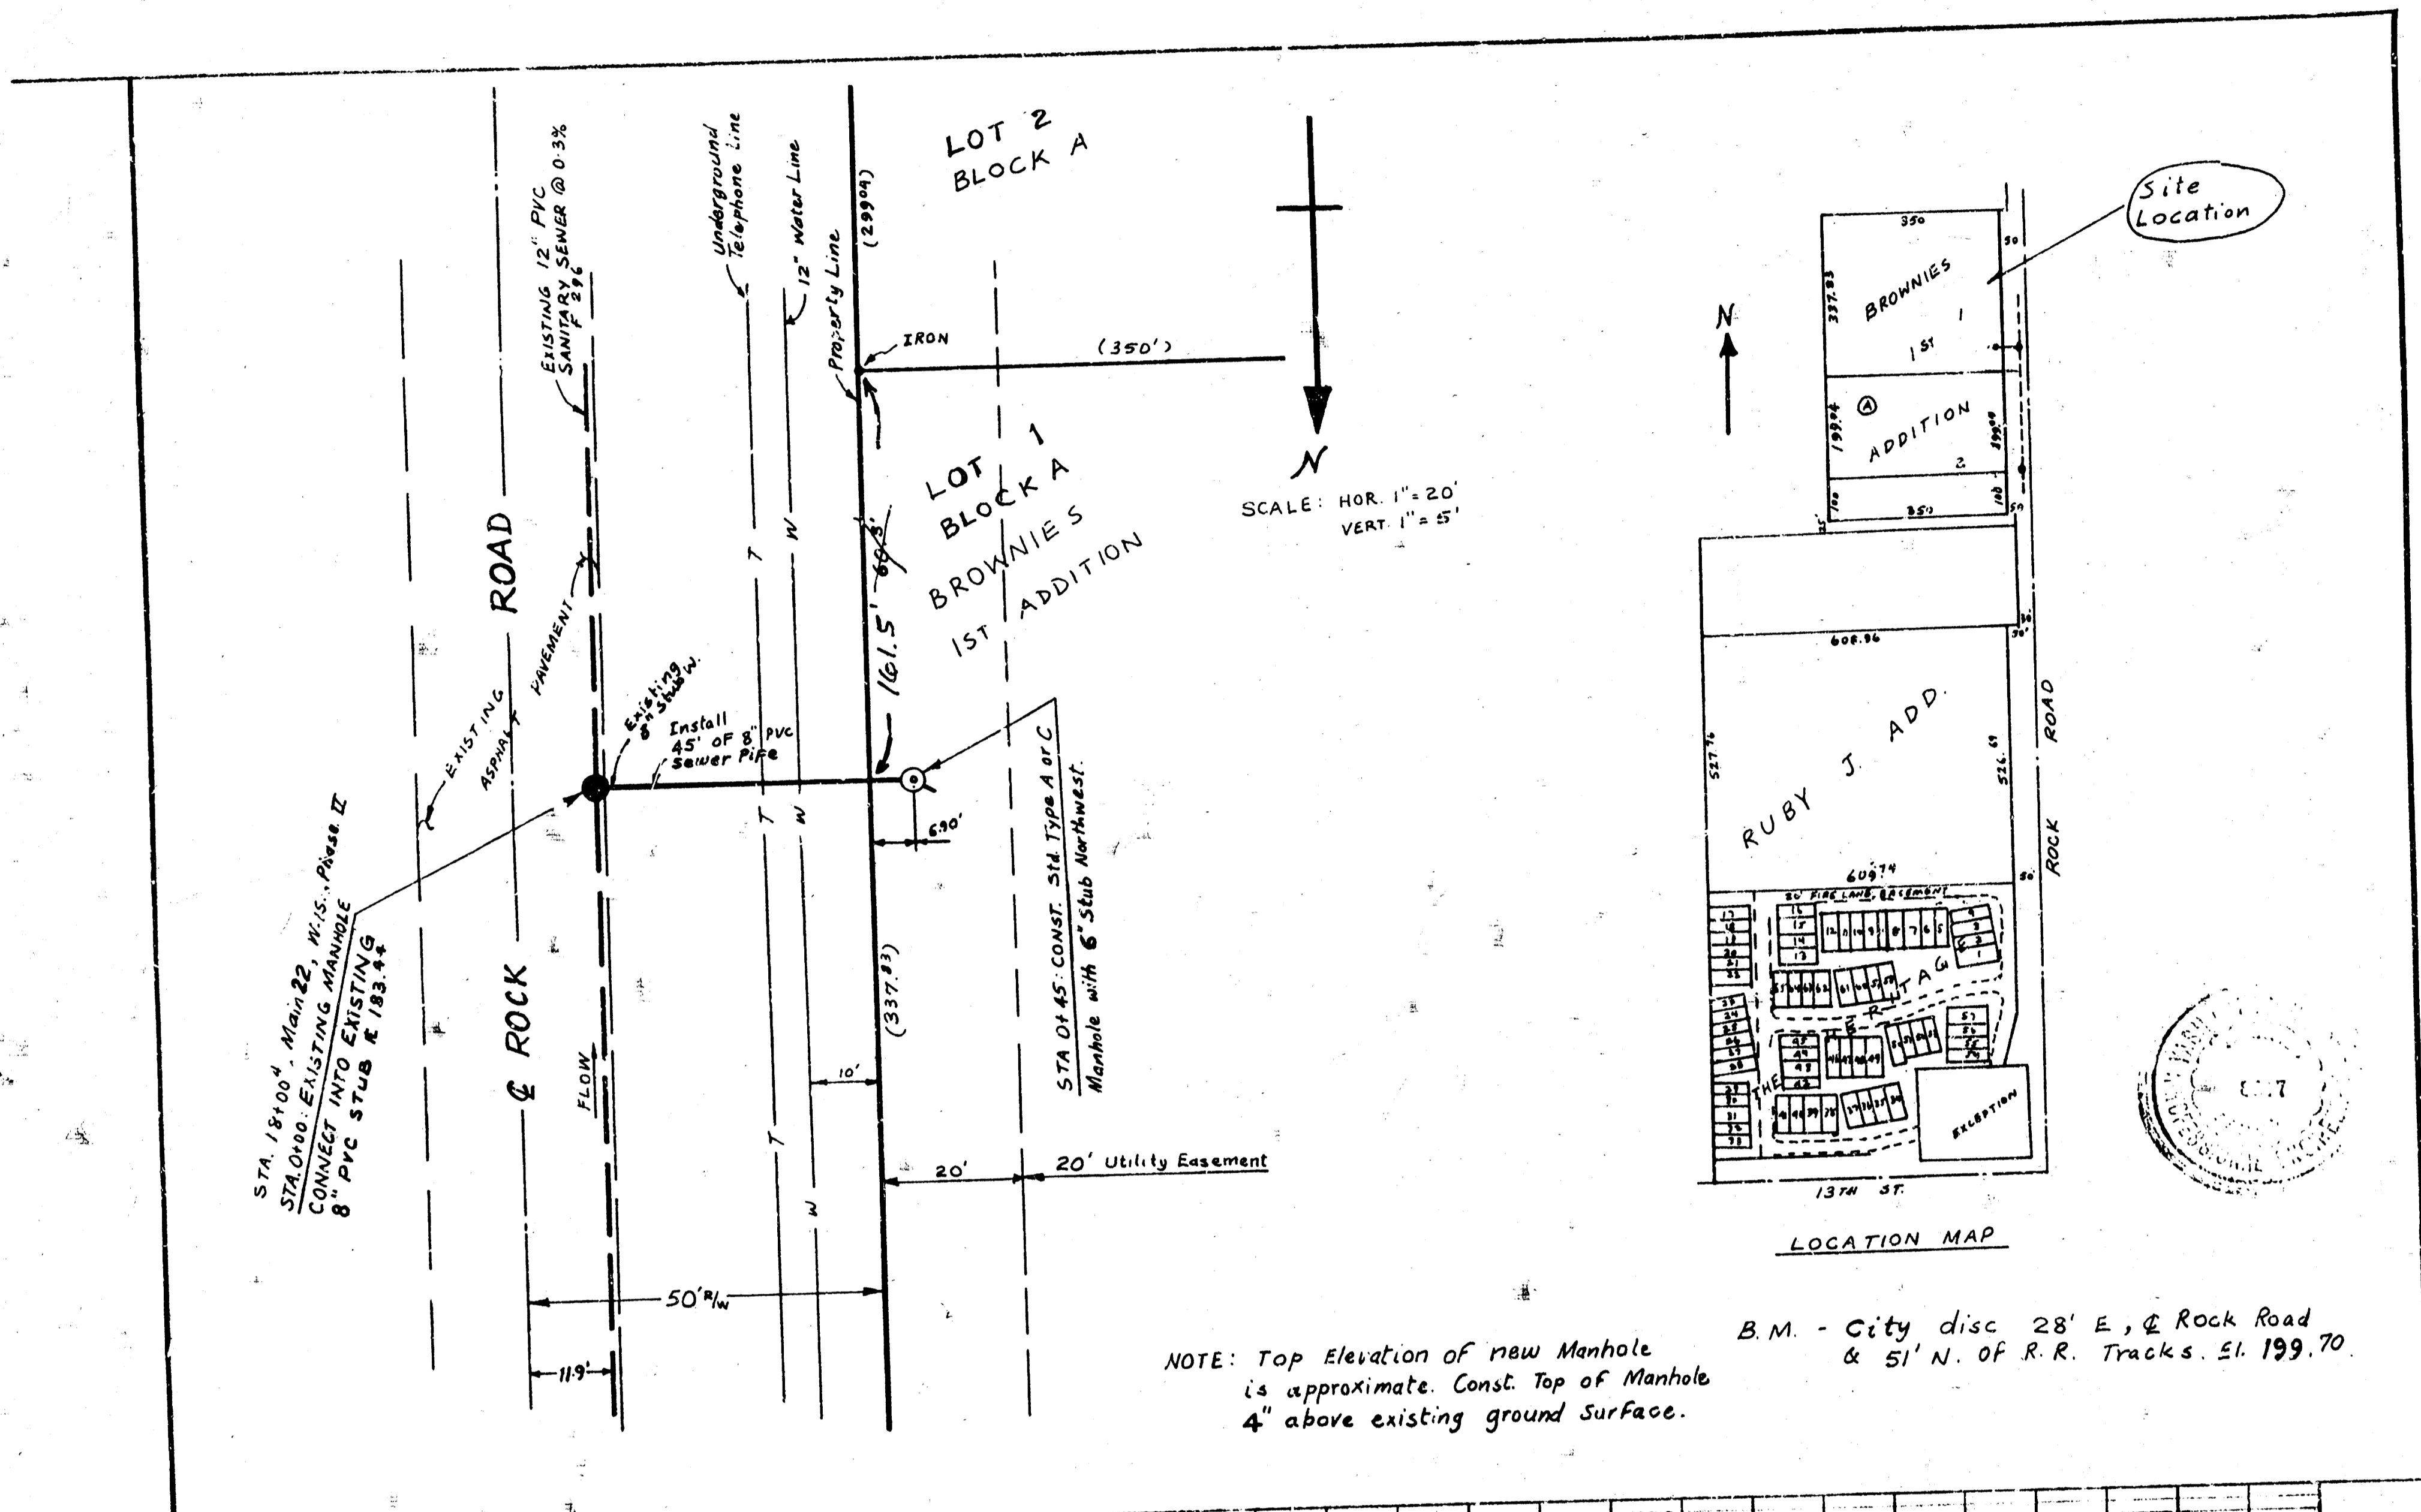

NOTE: Top Elevation of new Manhole is approximate. Const. Top of Manhole 4' above existing ground surface.
 B.M. - City disc 28' E, & Rock Road & 51' N. of R.R. Tracks. Sl. 199.70.

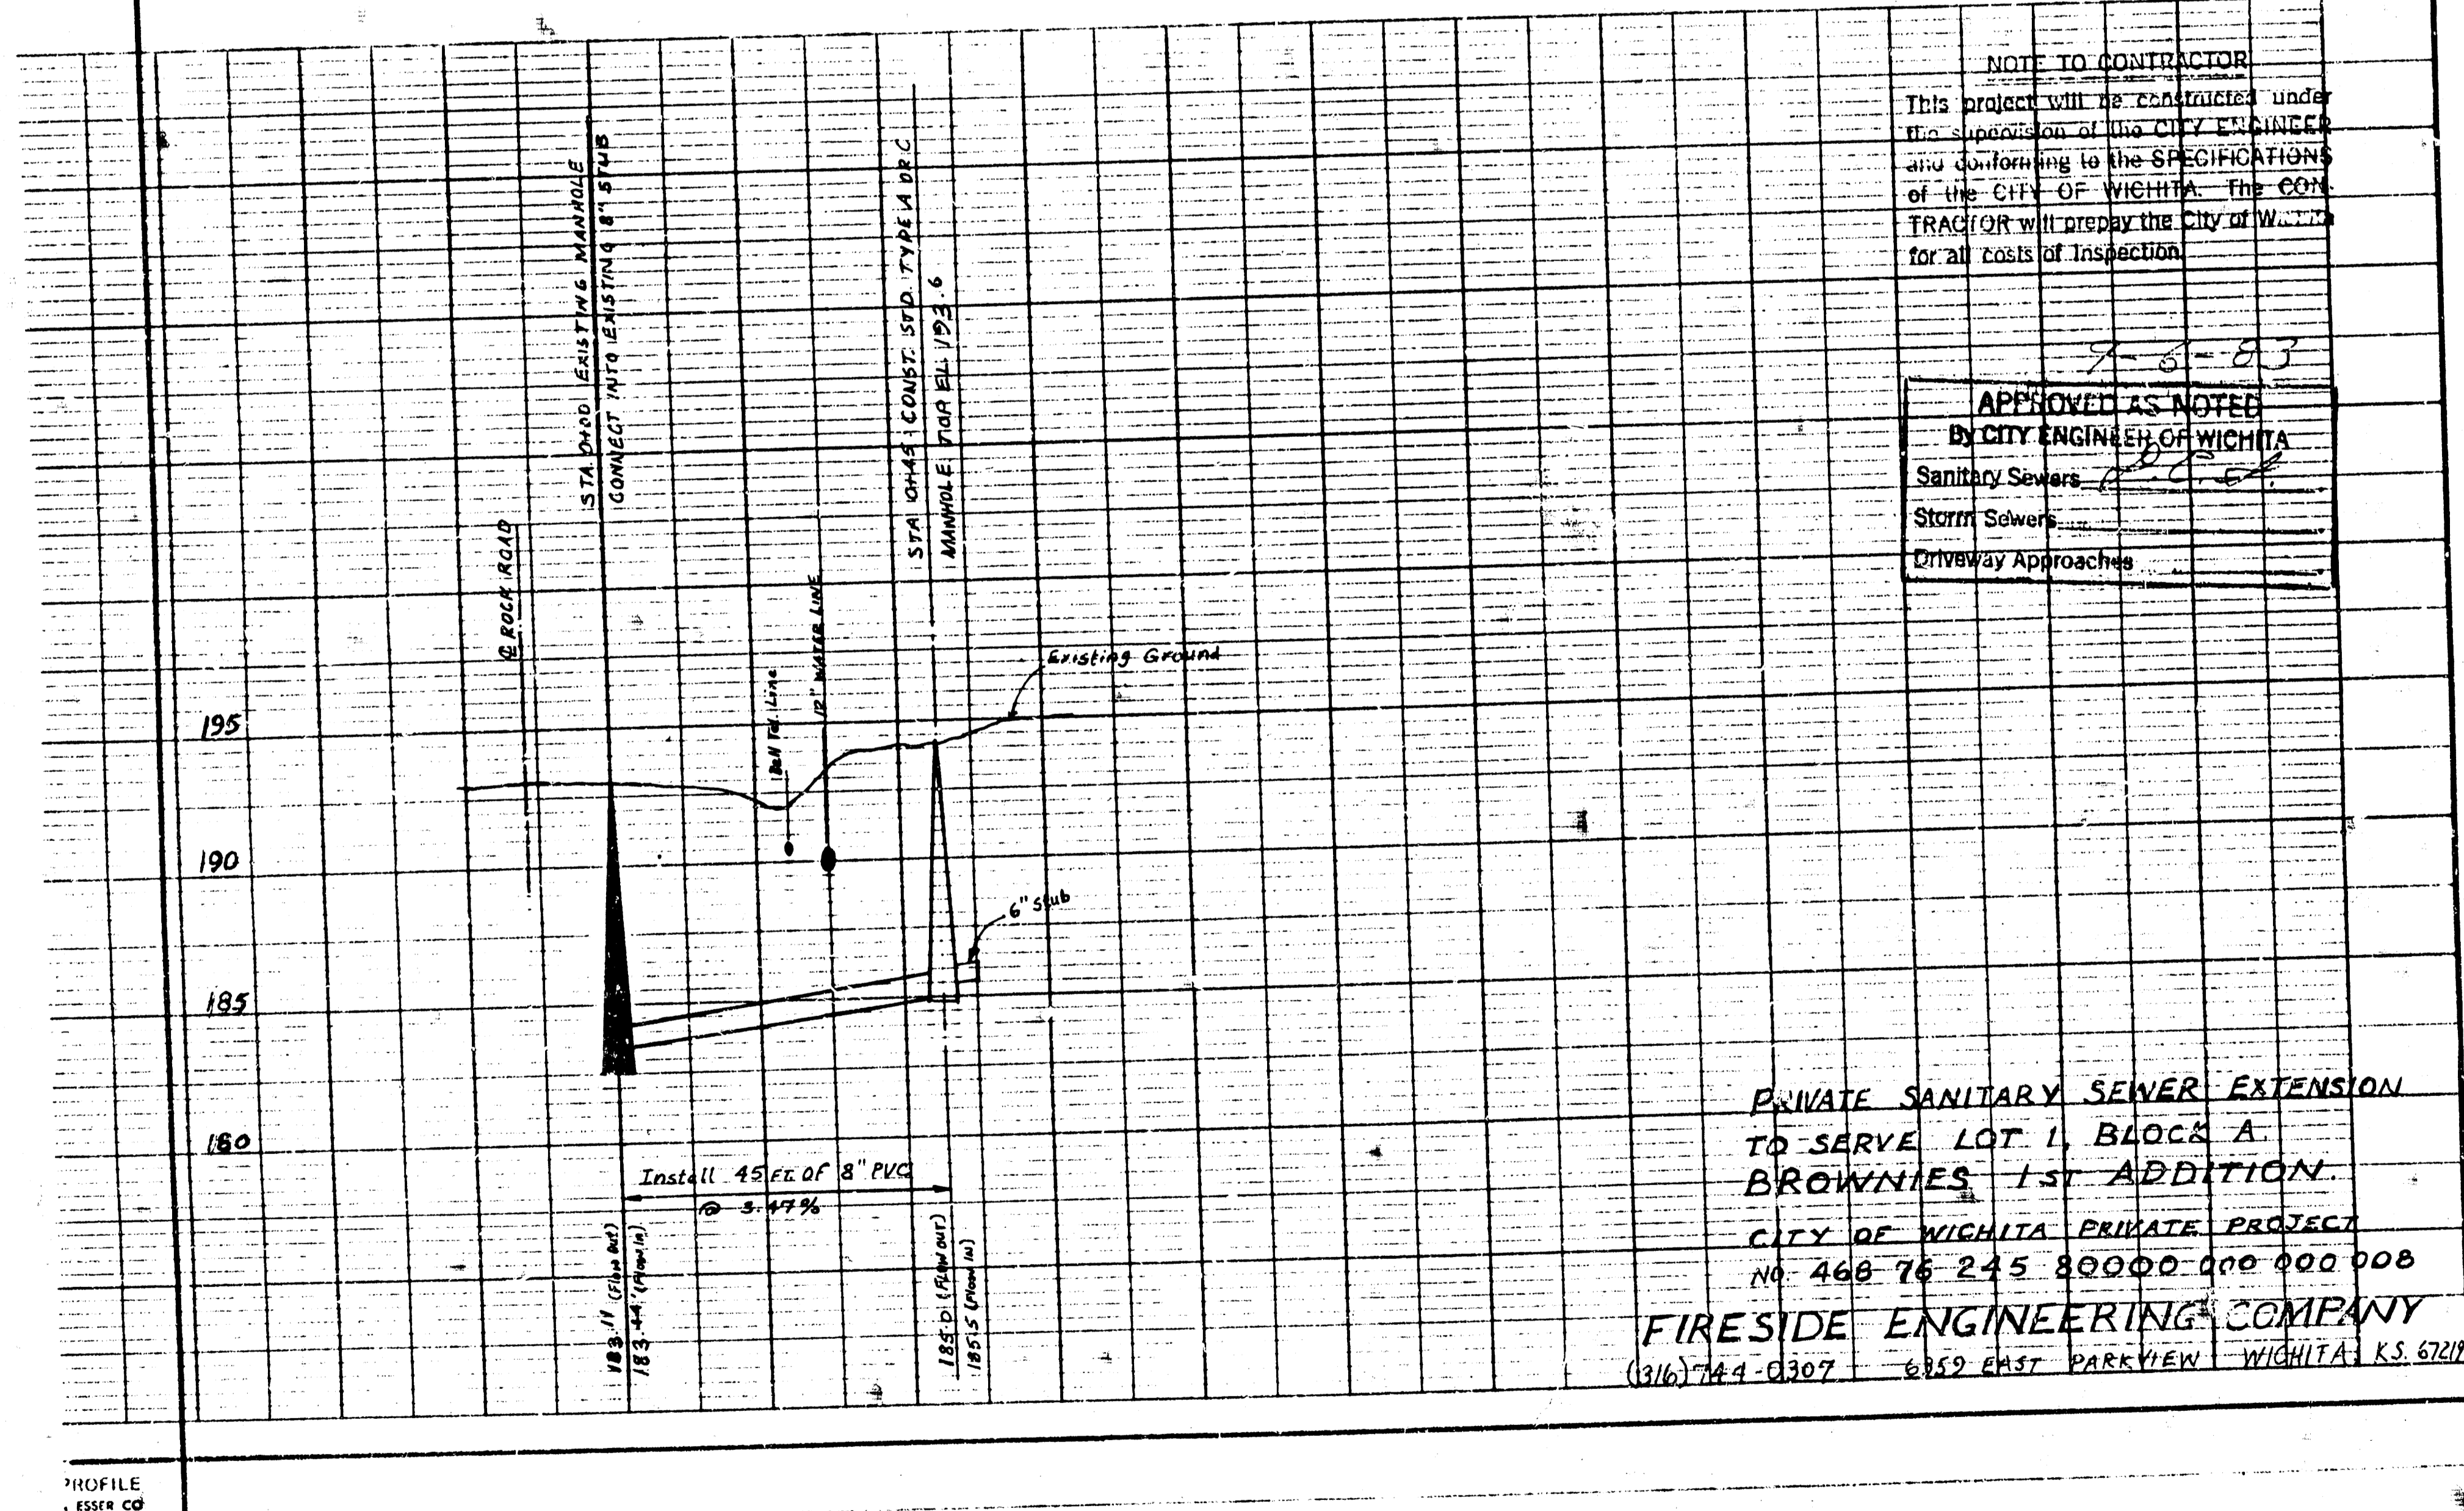

NOTE TO CONTRACTOR
 This project will be completed under the supervision of the CITY ENGINEER and conforming to the SPECIFICATIONS of the CITY OF WICHITA. THE CONTRACTOR will display the CITY OF WICHITA for all costs of inspection.

APPROVED AS NOTED
 BY CITY ENGINEER OF WICHITA
 Sanitary Sewers
 Storm Sewers
 Driveway Approaches

PRIVATE SANITARY SEWER EXTENSION
 TO SERVE LOT 1, BLOCK A
 BROWNIES 1ST ADDITION
 CITY OF WICHITA PRIVATE PROJECT
 NO. 468 76 245 80000-000 000 008
 FIRE SIDE ENGINEERING COMPANY
 (316) 744-0307 6859 EAST PARKVIEW WICHITA K.S. 67218

PROFILE
 ESSRE CO