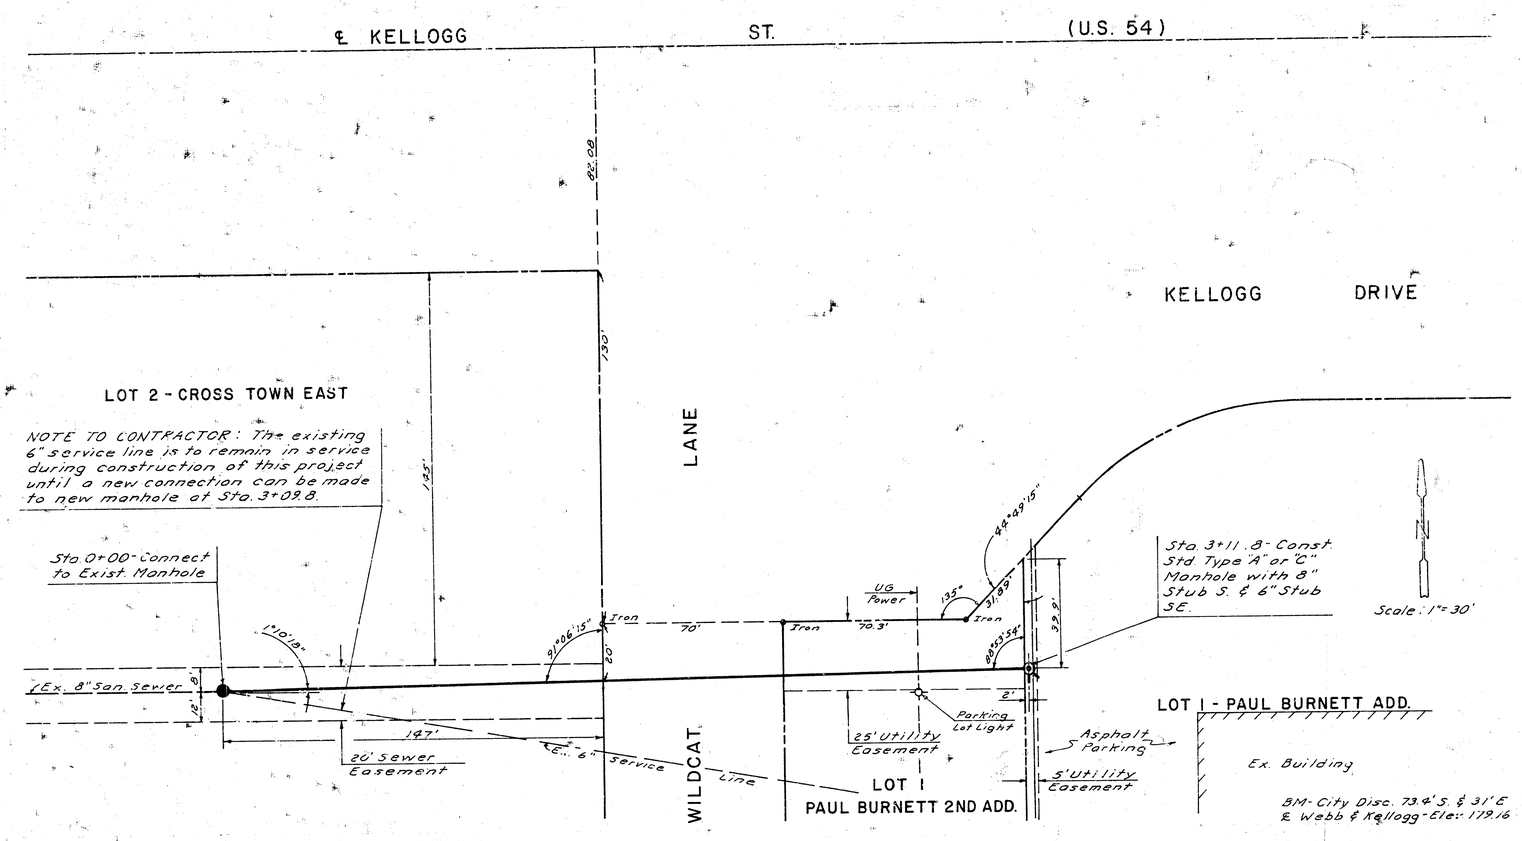

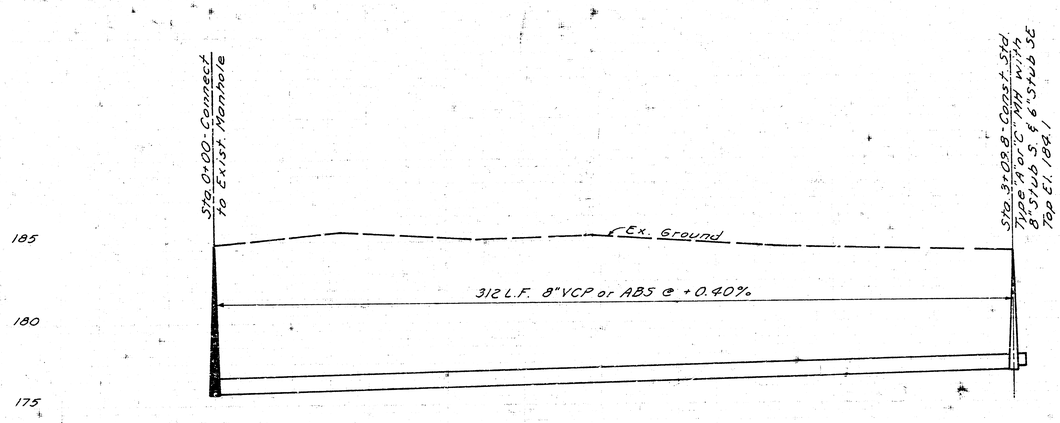

NOTE TO CONTRACTOR

This project will be constructed under the supervision of the CITY ENGINEER and conforming to the SPECIFICATIONS of the CITY OF WICHITA. The CONTRACTOR will reimburse the City of Wichita for all cost of ~~engineering, inspection~~ and Inspection.

APPROVED AS NOTED
By CITY ENGINEER OF WICHITA
Sanitary Sewers 11-11-77
Storm Sewers
Driveway Approaches

Project Number: 468-76-295-80936-000-000001

CITY PROJ. NO. DBKW 707079
SANITARY SEWER EXTENSION
TO SERVE LOT 1, PAUL BURNETT
ADDITION