


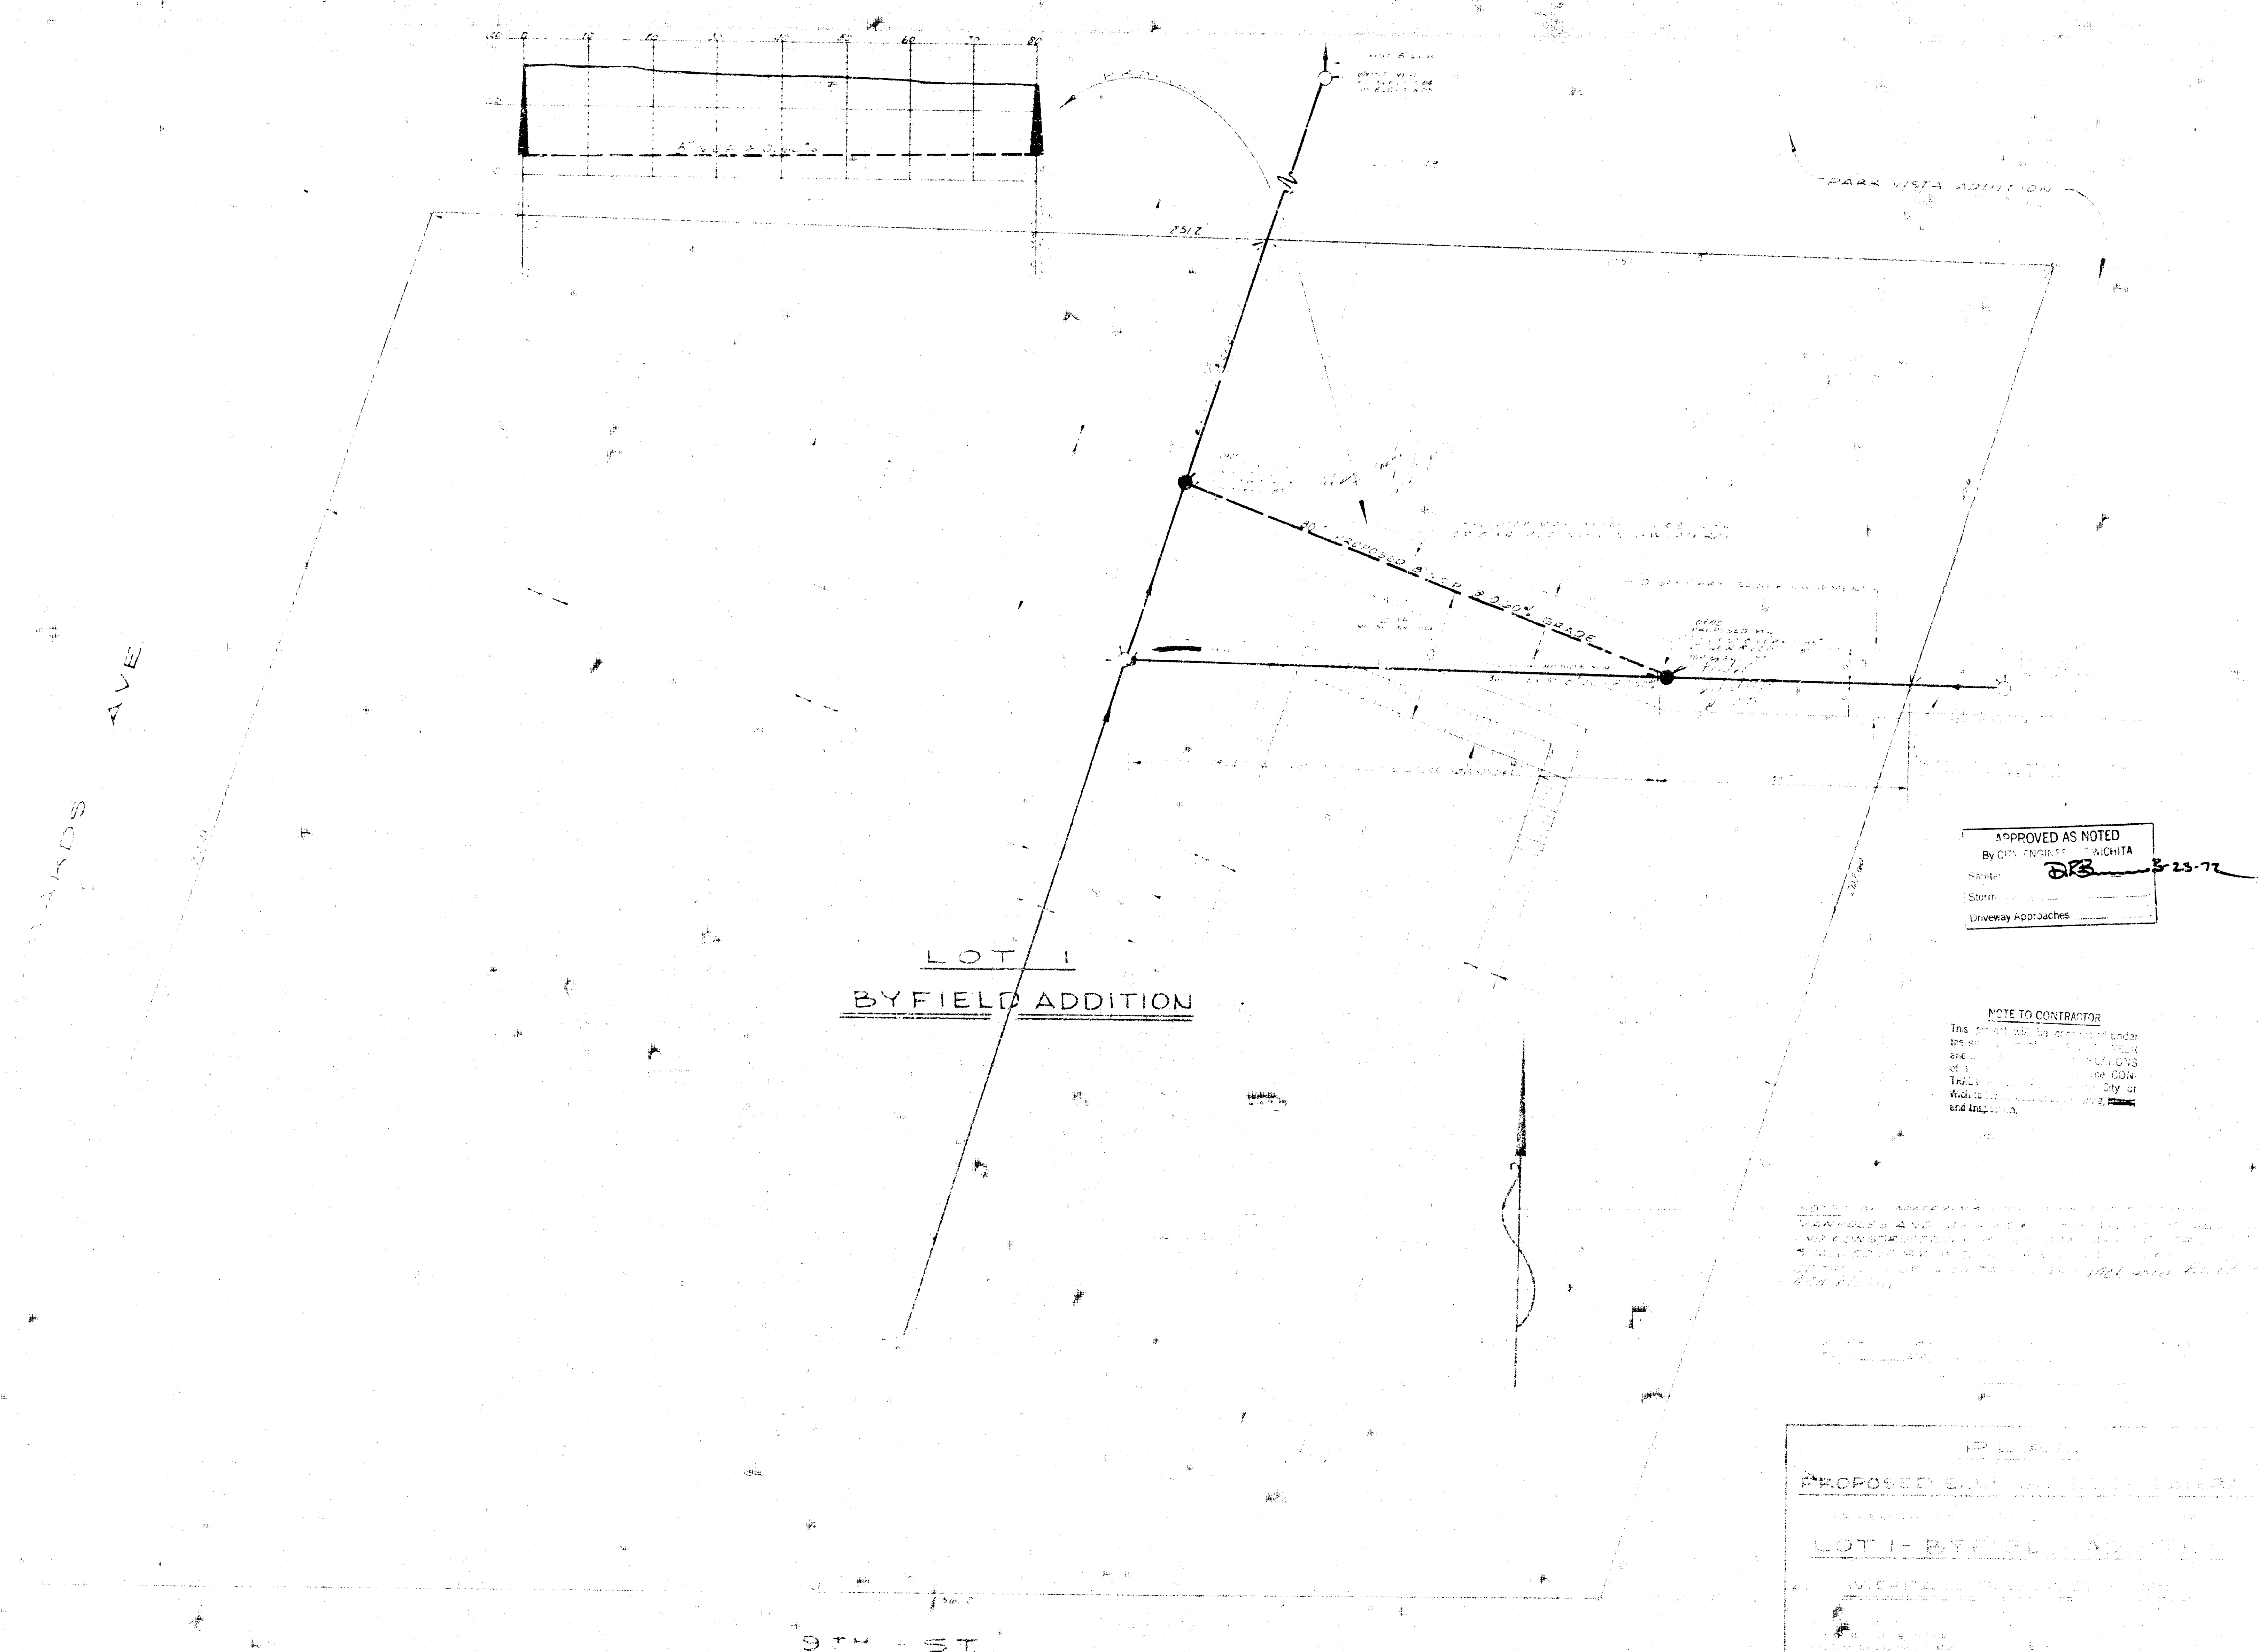

APPROVED AS NOTED
By City Engineer WICHITA
Date: 8-25-72
Storm: _____
Driveway Approaches: _____

NOTE TO CONTRACTOR


PROPOSED LOT 1 - BYFIELD ADDITION
WICHITA, KANSAS
City Engineer
Date: _____