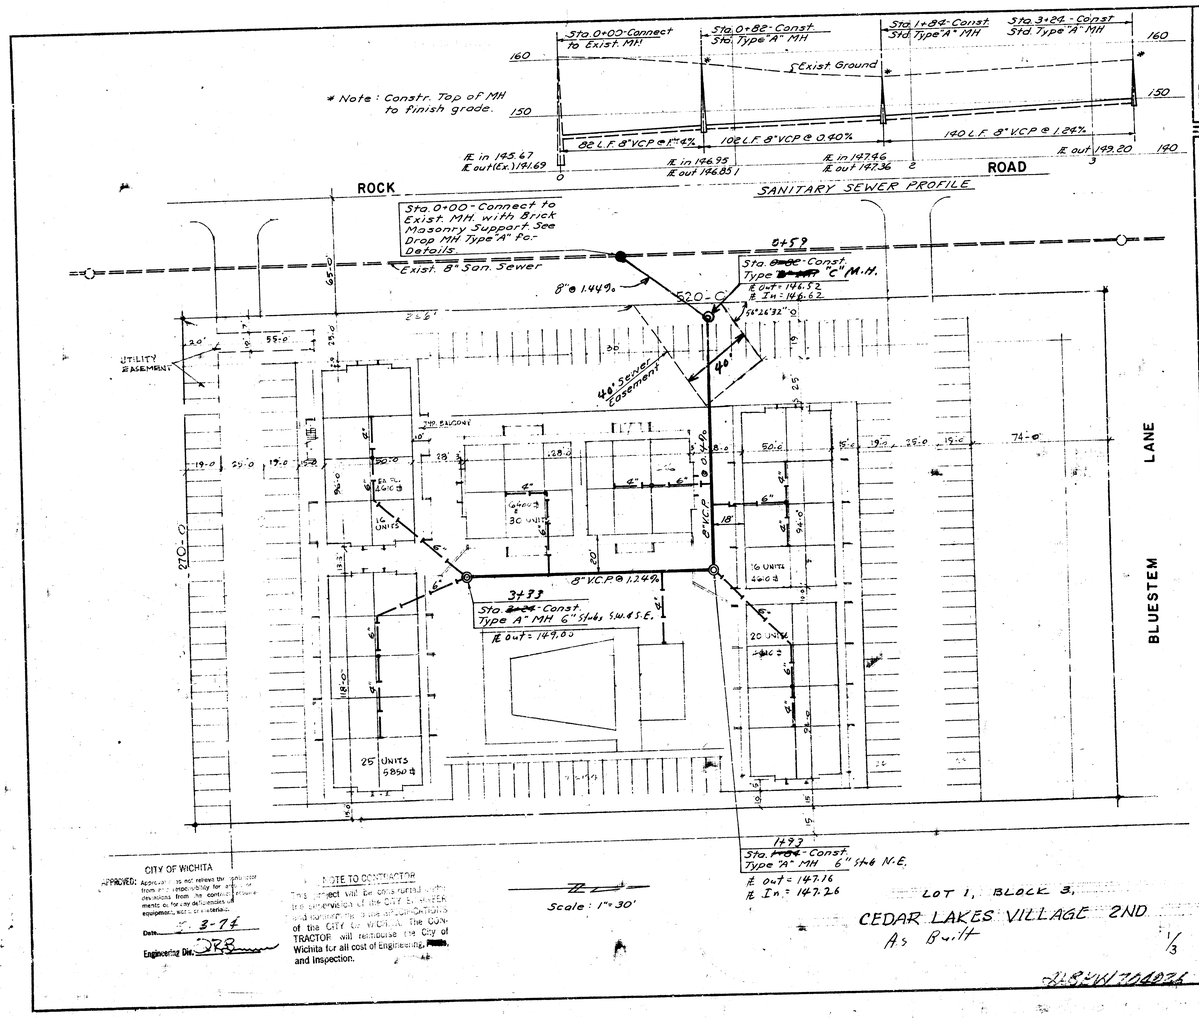

FILMED FROM THE BEST AVAILABLE COPY

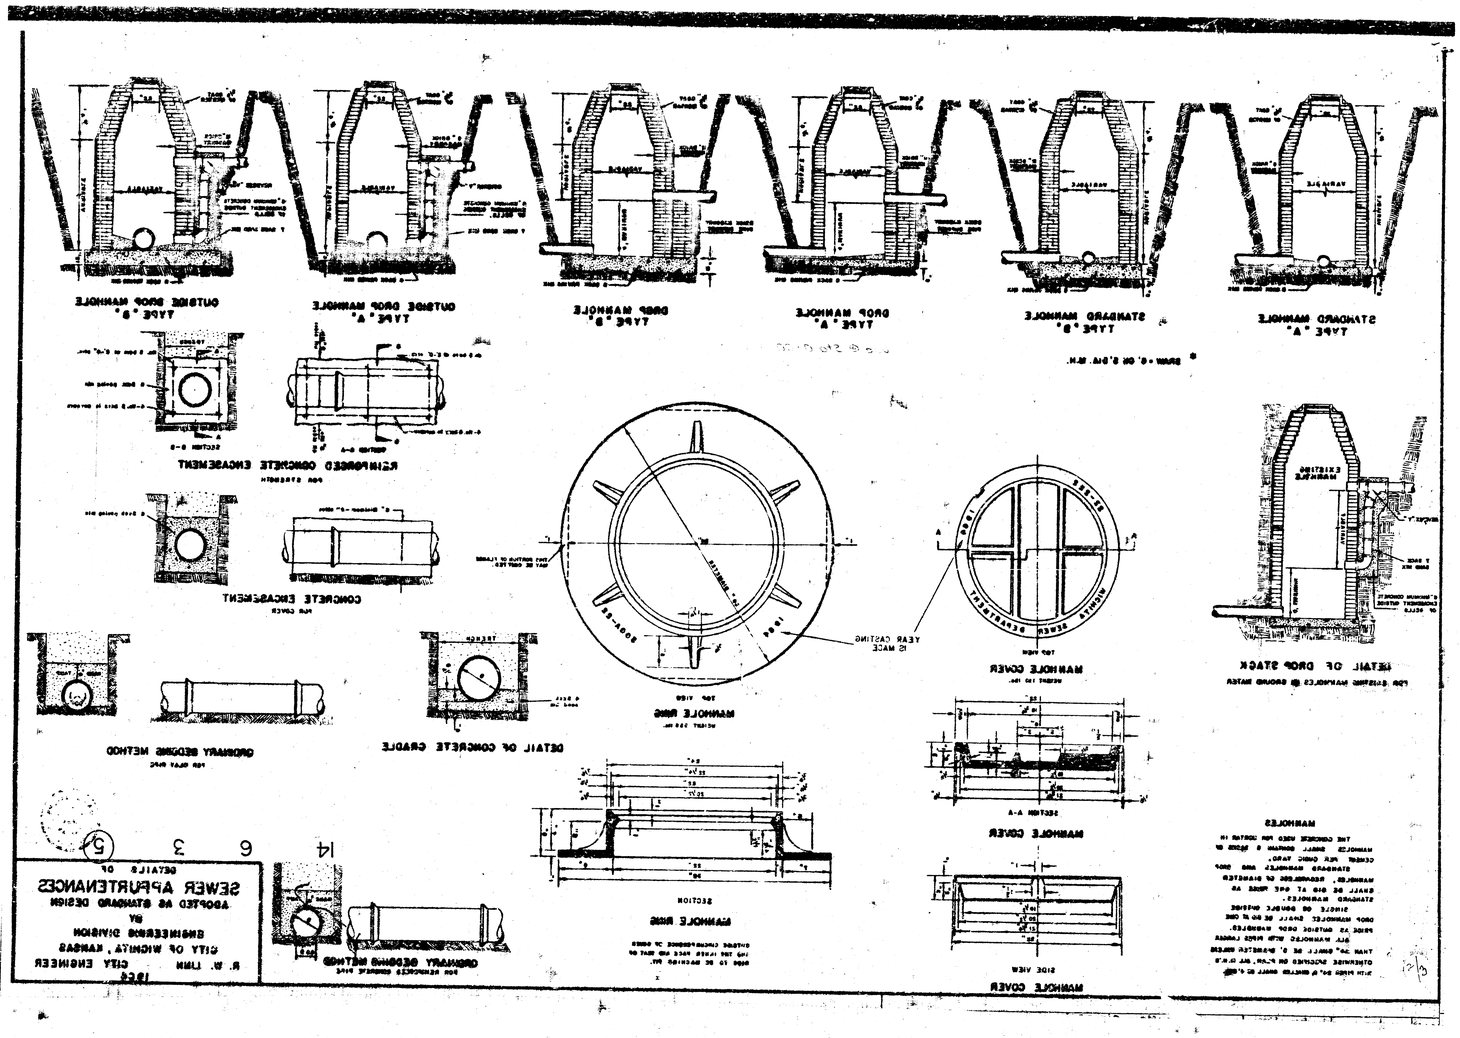

FILMED FROM THE BEST AVAILABLE COPY

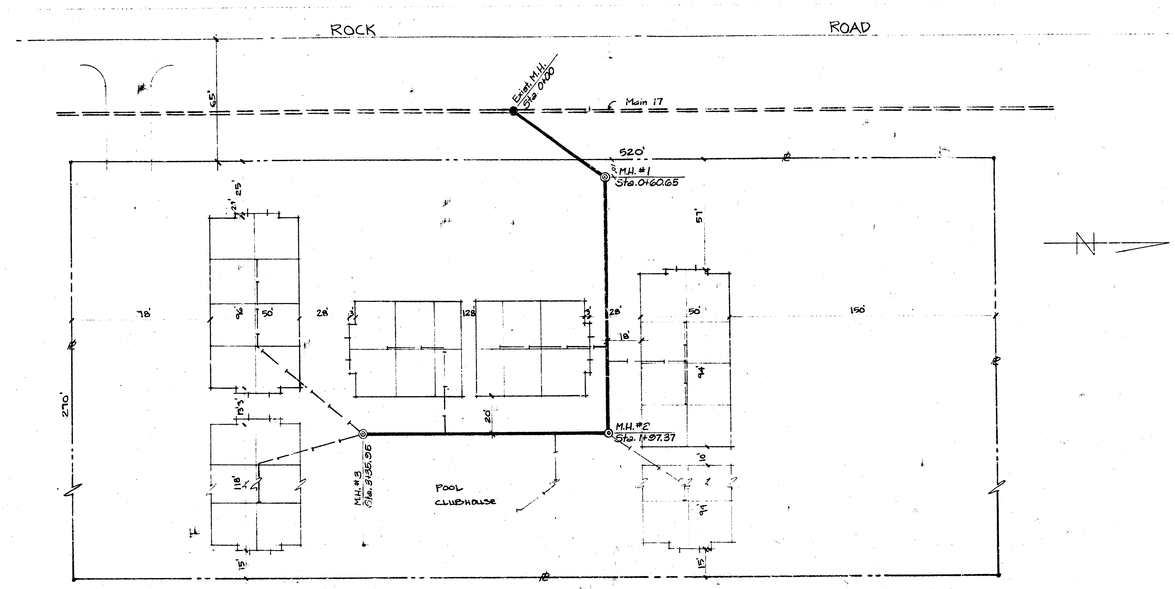

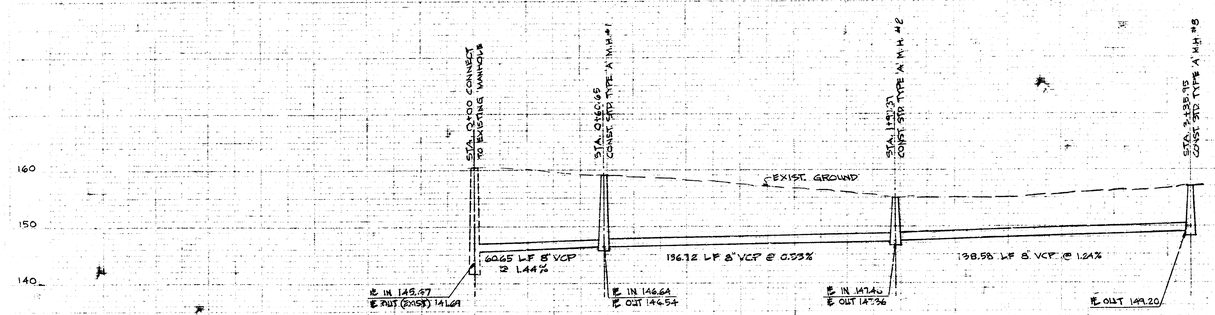

AS BUILT PLAN FOR
CEDAR LAKES VILLAGE APARTMENTS

June 6, 1975

2/3

FILMED FROM THE BEST AVAILABLE COPY ....