


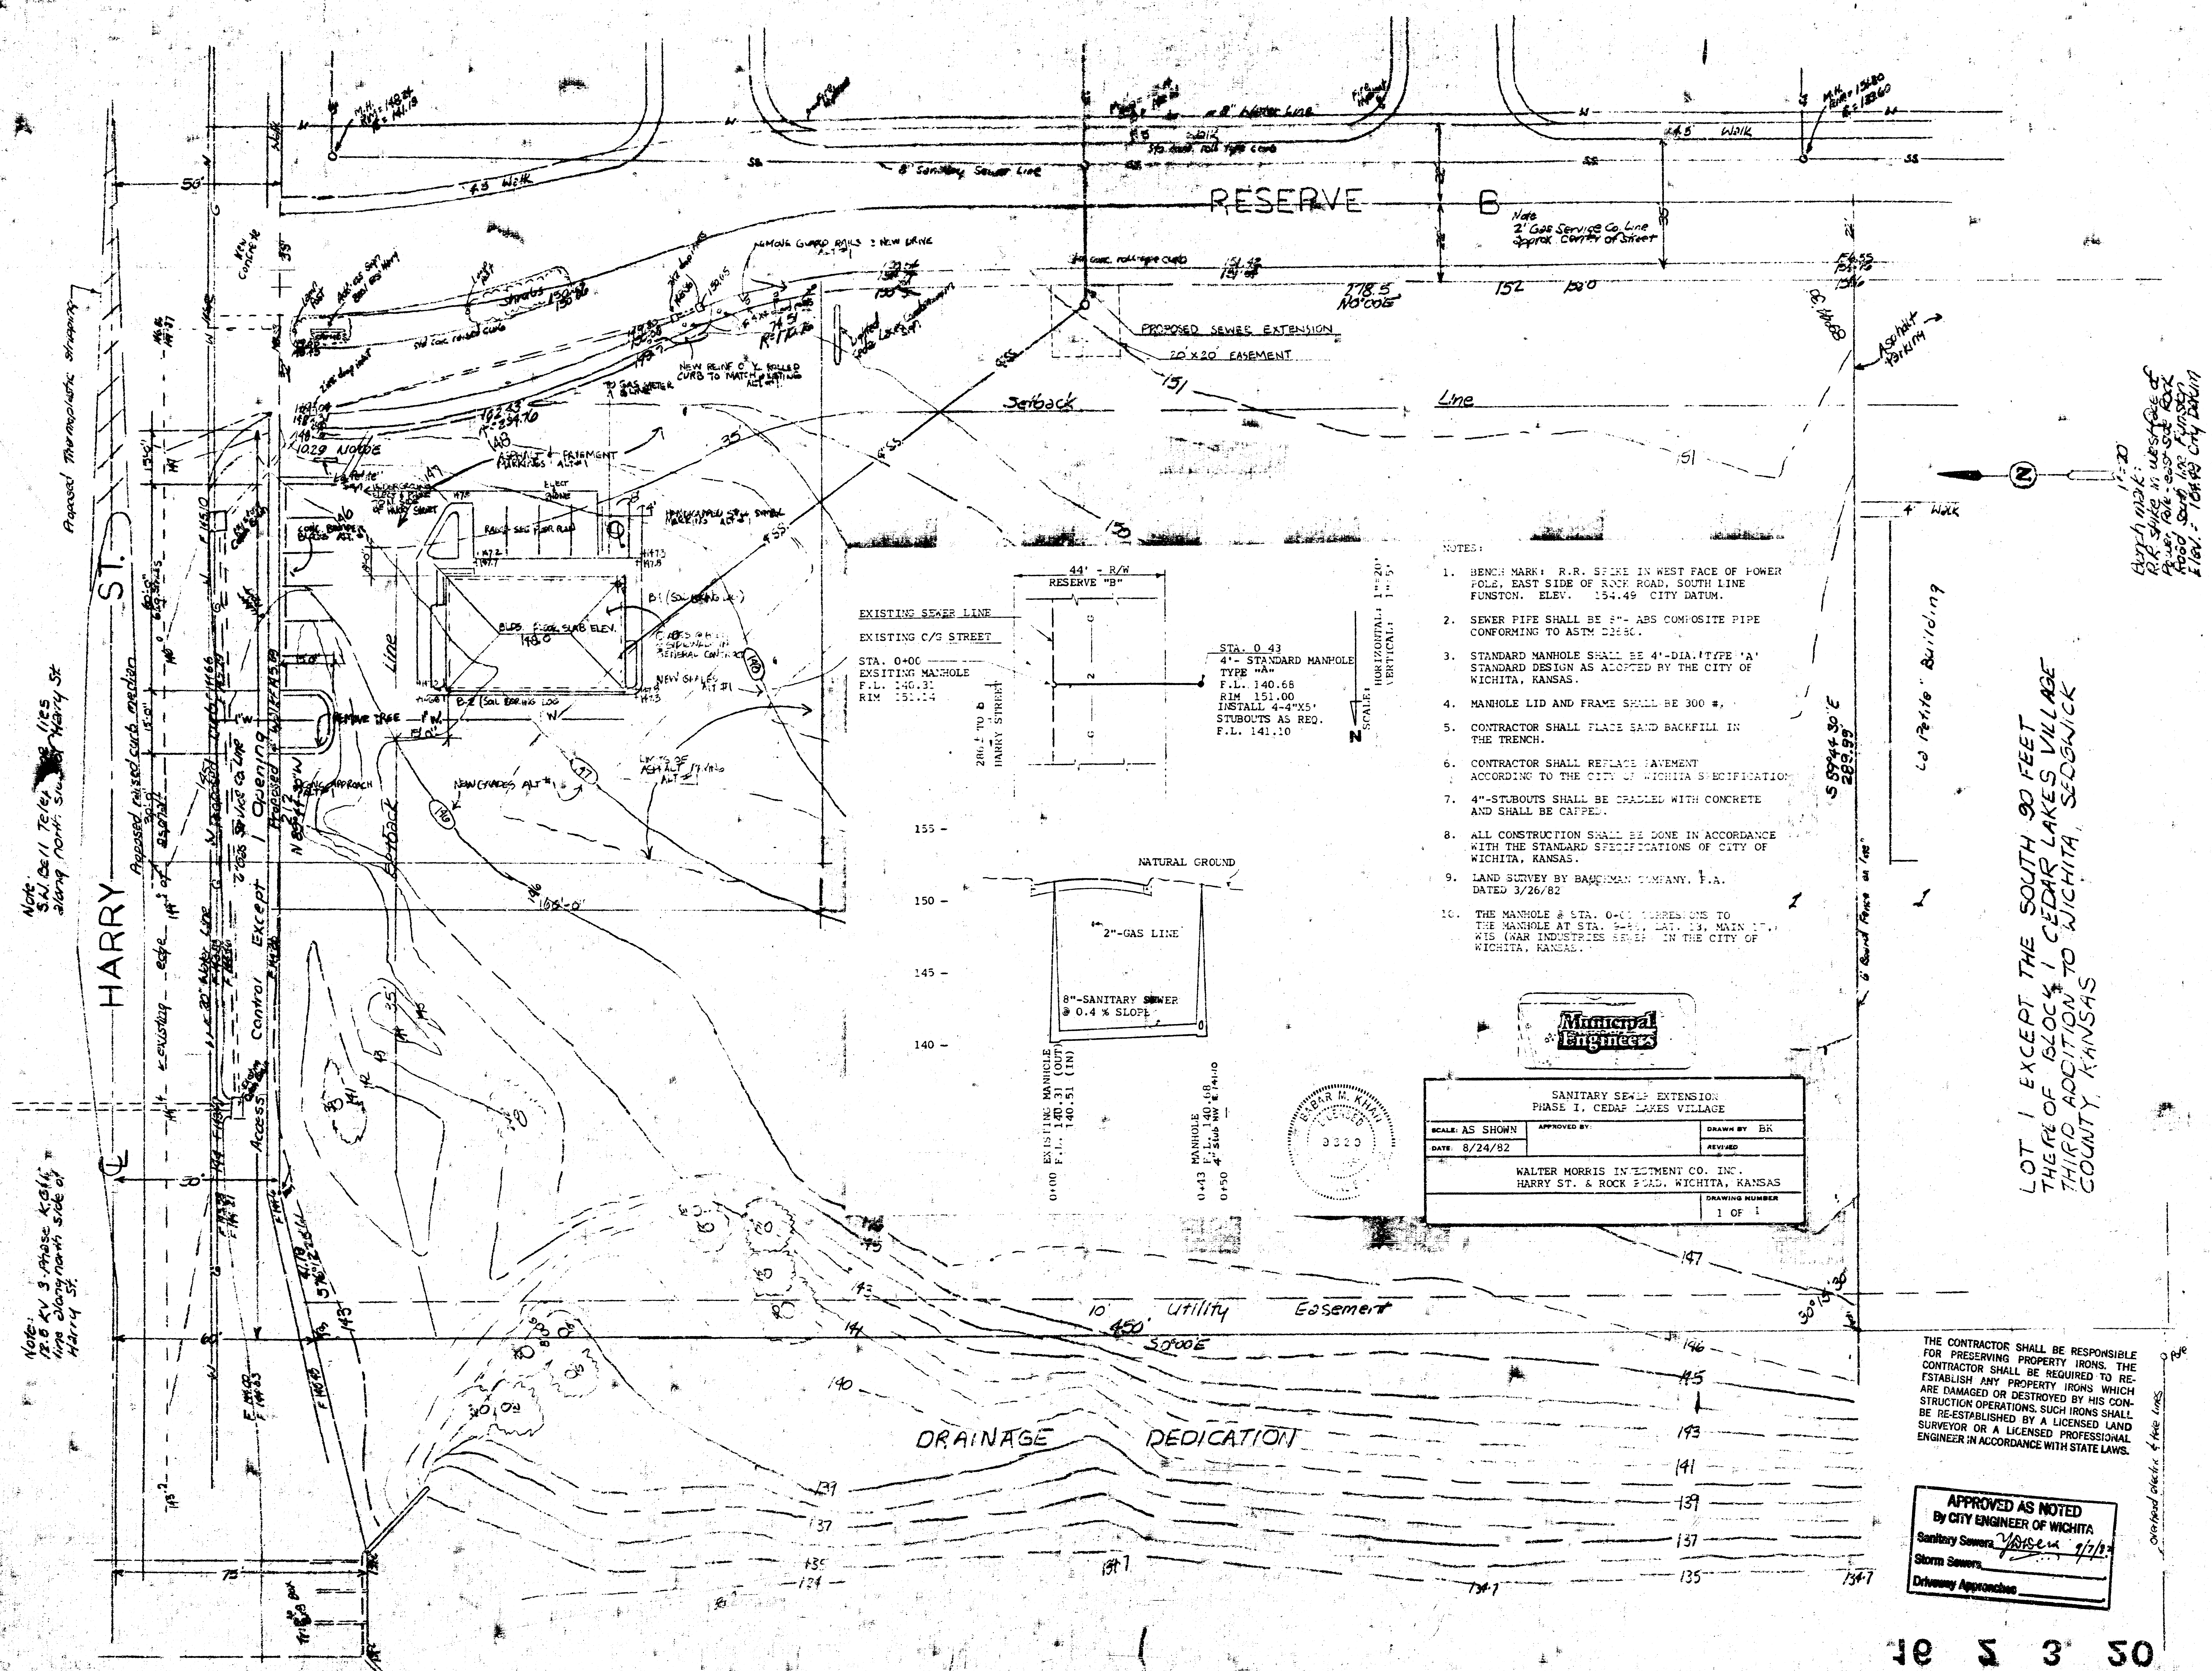

- NOTES:
1. BENCH MARK: R.R. SPIKE IN WEST FACE OF POWER POLE, EAST SIDE OF ROCK ROAD, SOUTH LINE FUNSTON. ELEV. 154.49 CITY DATUM.
 2. SEWER PIPE SHALL BE 8" ABS COMPOSITE PIPE CONFORMING TO ASTM D2168.
 3. STANDARD MANHOLE SHALL BE 4'-DIA. TYPE 'A' STANDARD DESIGN AS ADOPTED BY THE CITY OF WICHITA, KANSAS.
 4. MANHOLE LID AND FRAME SHALL BE 300 #.
 5. CONTRACTOR SHALL PLACE SAND BACKFILL IN THE TRENCH.
 6. CONTRACTOR SHALL REPLACE PAVEMENT ACCORDING TO THE CITY OF WICHITA'S SPECIFICATION.
 7. 4"-STUBOUTS SHALL BE CRADLED WITH CONCRETE AND SHALL BE CAPPED.
 8. ALL CONSTRUCTION SHALL BE DONE IN ACCORDANCE WITH THE STANDARD SPECIFICATIONS OF CITY OF WICHITA, KANSAS.
 9. LAND SURVEY BY BARNHART COMPANY, P.A. DATED 3/26/82.
 10. THE MANHOLE & STA. 0+00 CORRESPONDS TO THE MANHOLE AT STA. 0+00, LOT 19, MAIN ST. WIS (NAR INDUSTRIES SEWER IN THE CITY OF WICHITA, KANSAS).

Municipal Engineers

SANITARY SEWER EXTENSION
PHASE I, CEDAR LAKES VILLAGE

SCALE: AS SHOWN	APPROVED BY:	DRAWN BY: BK
DATE: 8/24/82	REVIEWED:	REVIEWED:
WALTER MORRIS INVESTMENT CO., INC. HARRY ST. & ROCK ROAD, WICHITA, KANSAS		
DRAWING NUMBER 1 OF 1		

THE CONTRACTOR SHALL BE RESPONSIBLE FOR PRESERVING PROPERTY IRONS. THE CONTRACTOR SHALL BE REQUIRED TO RE-ESTABLISH ANY PROPERTY IRONS WHICH ARE DAMAGED OR DESTROYED BY HIS CONSTRUCTION OPERATIONS. SUCH IRONS SHALL BE RE-ESTABLISHED BY A LICENSED LAND SURVEYOR OR A LICENSED PROFESSIONAL ENGINEER IN ACCORDANCE WITH STATE LAWS.

APPROVED AS NOTED
By CITY ENGINEER OF WICHITA
Sanitary Sewer
Storm Sewer
Driveway Approaches