


ORIGINAL	DATE
SURVEYED	BY
PLOTTED	
TEMPLATE	
NOTE BOOK	

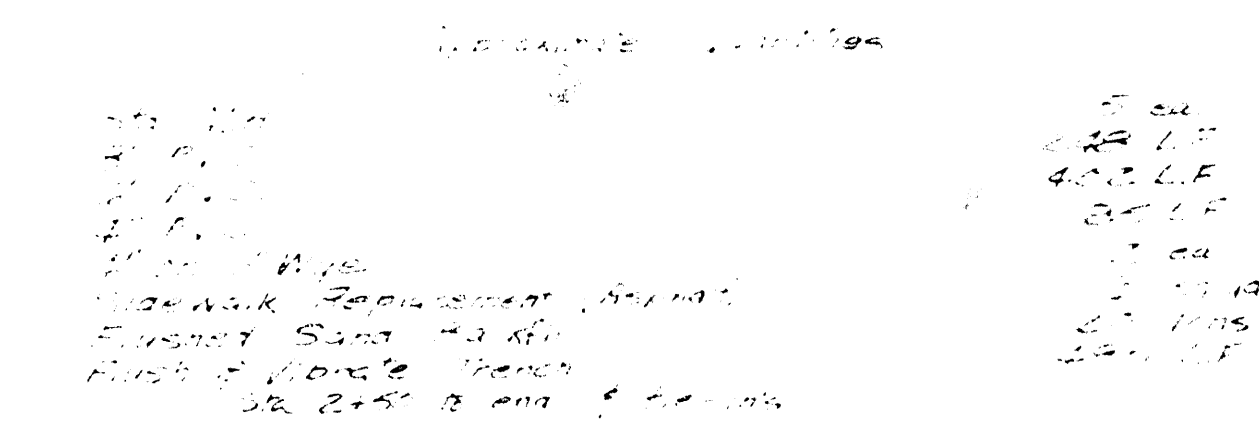

1° 50'

NOTE TO CONTRACTOR

the supervision of the CITY ENGINEER and conforming to the SPECIFICATIONS of the CITY OF WICHITA. The CONTRACTOR will reimburse the City of Wichita for all cost of Engineering, Plans, and Inspection.


CITY OF WICHITA

APPROVED: Approval does not relieve the contractor from any responsibility for any deviations from the contract documents or for any deficiencies of equipment, work, or materials.

Date: 6/14/66

Engineering Div. *D. J. Sullivan*

B.M. #2. S.E. Cor. conc. slab
septic tank cover. Elev: 1278.02

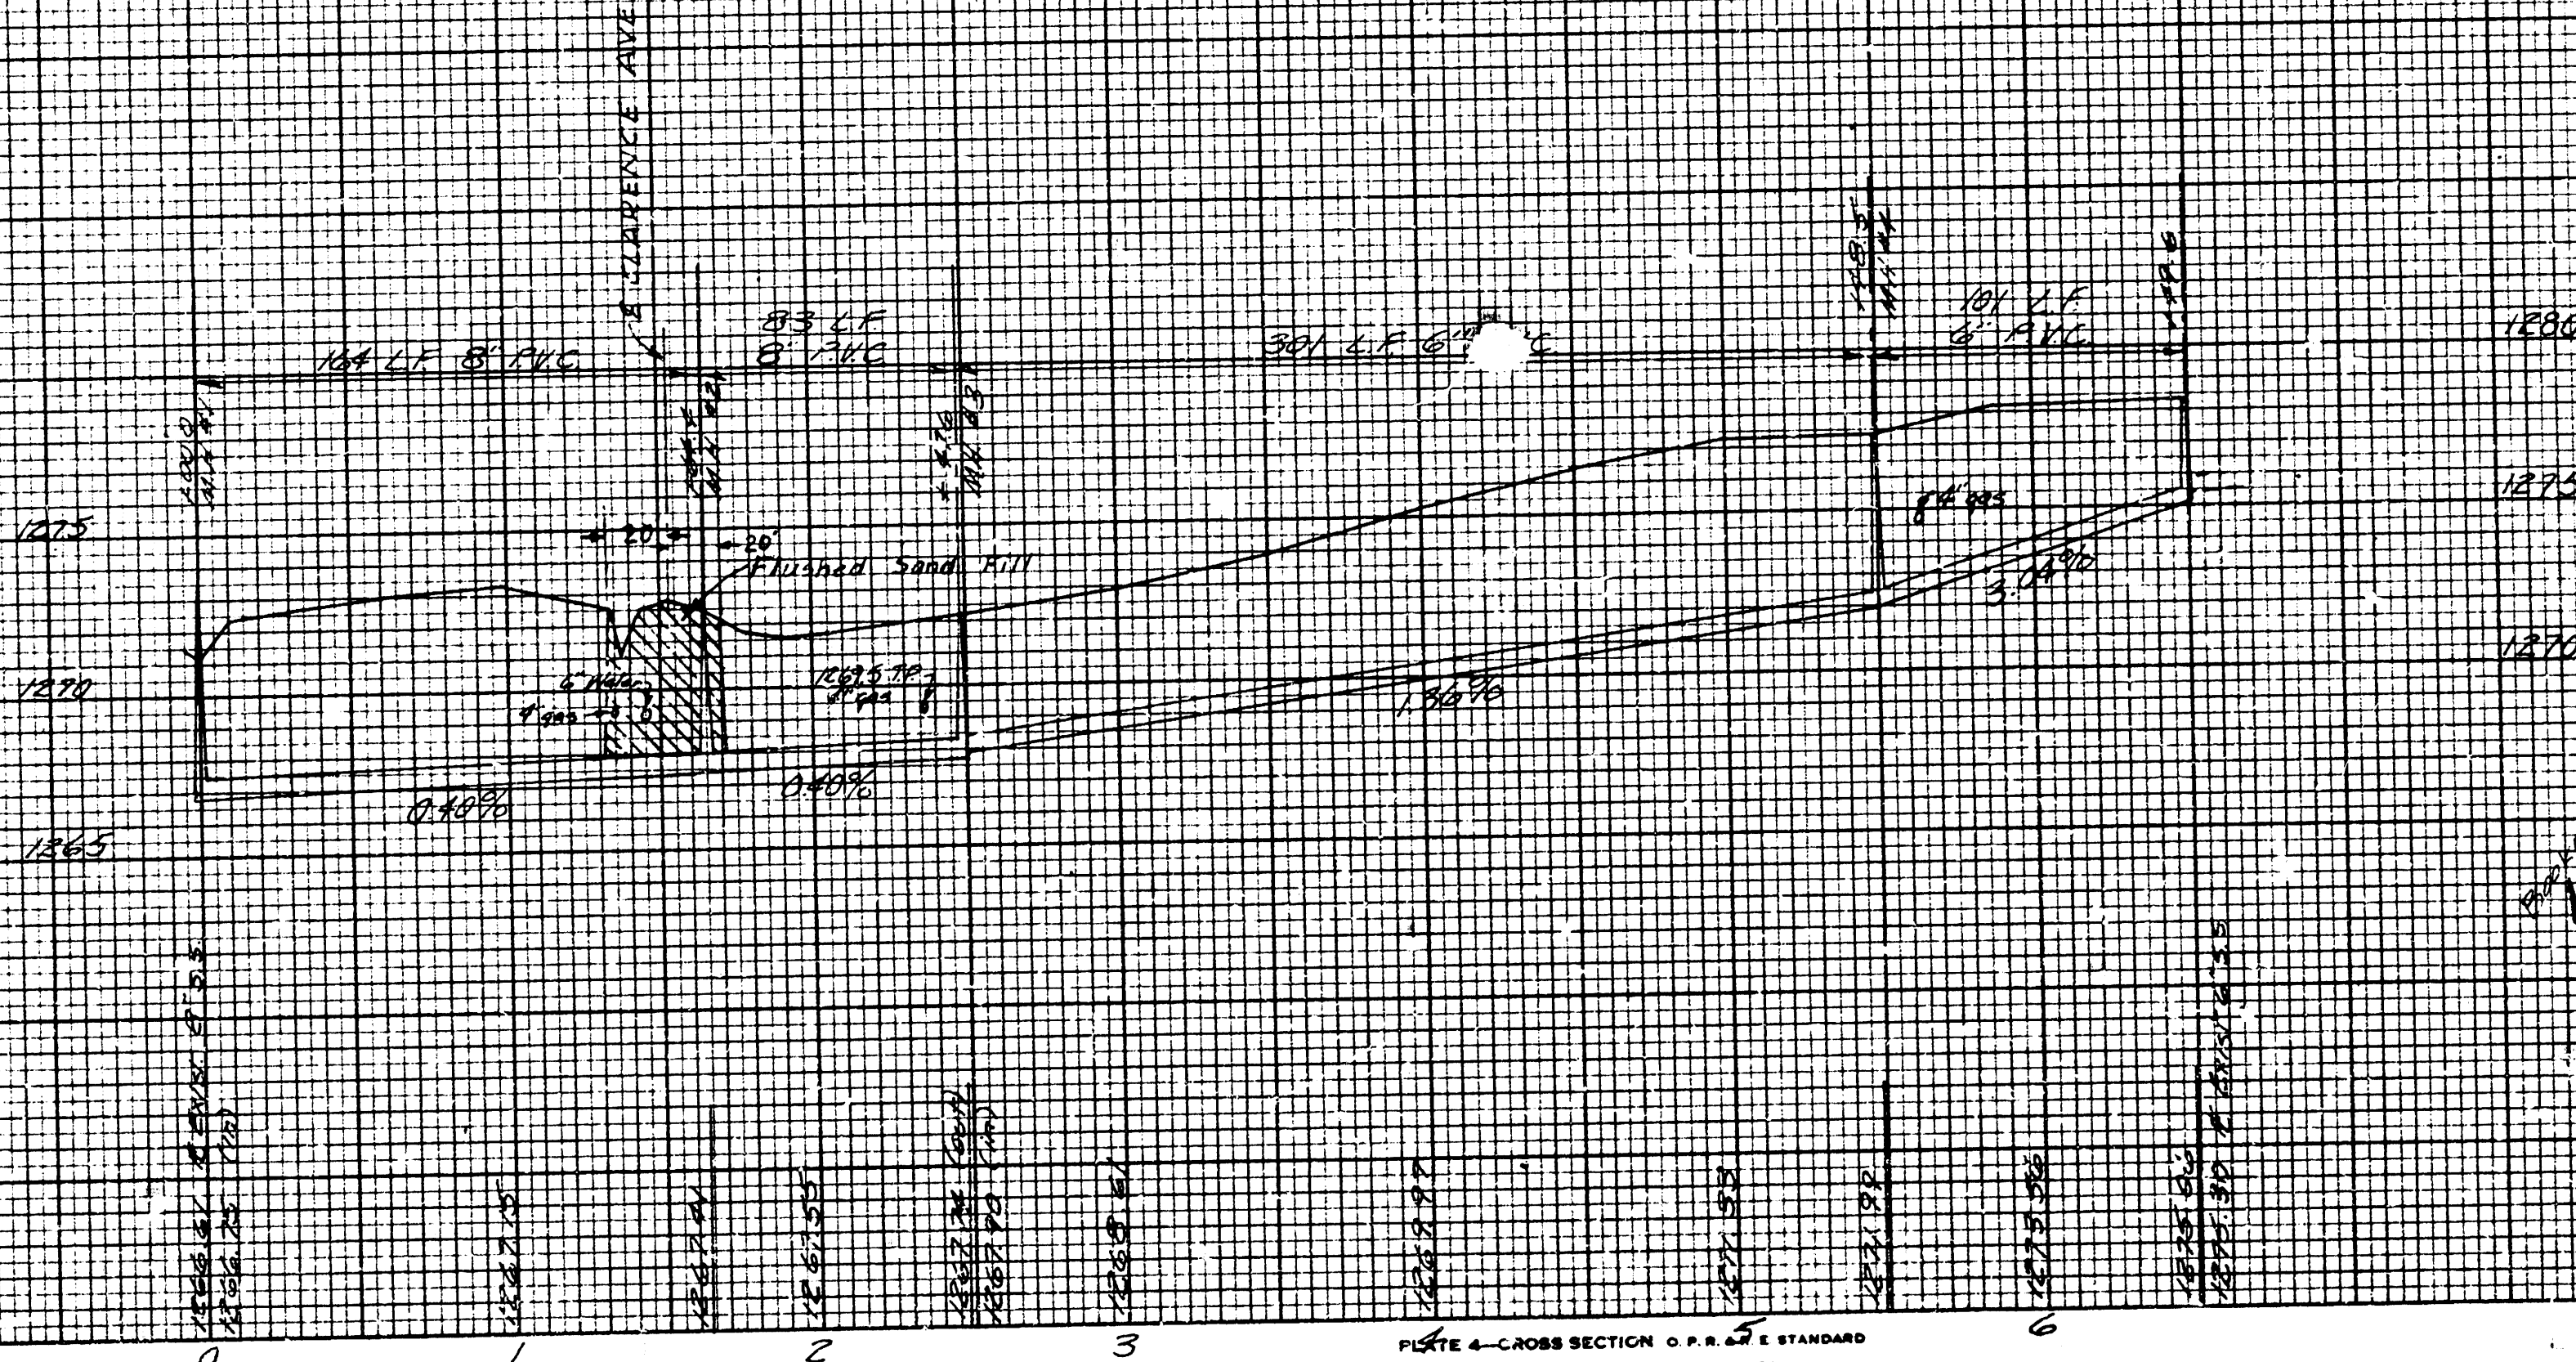

K. O. TAYLOR, DE
OCT 1965