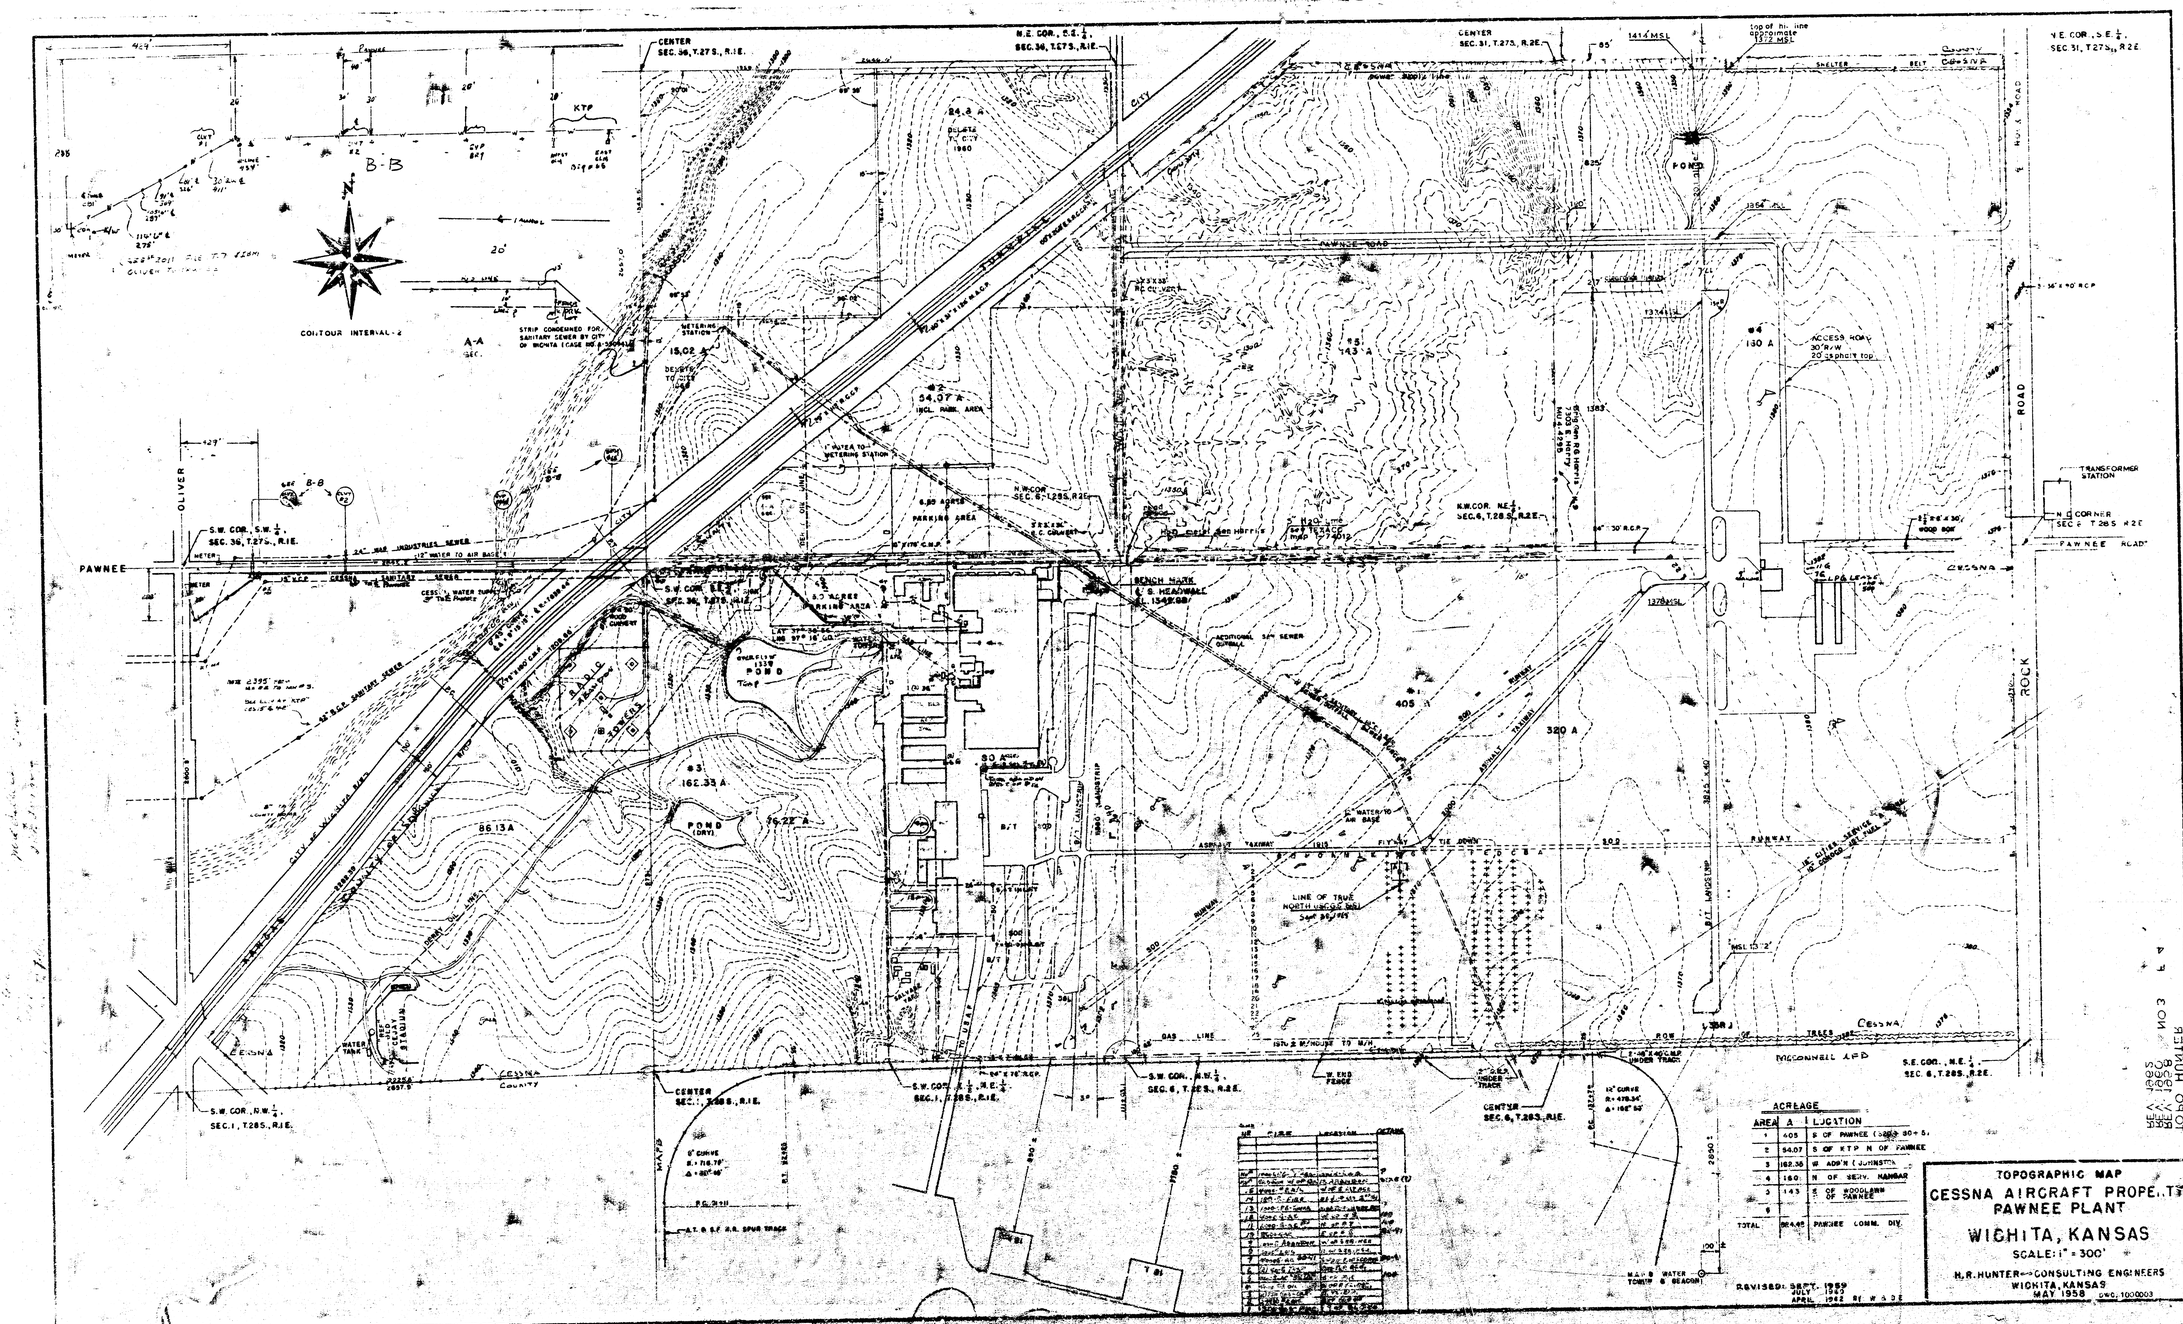
CONTOUR INTERVAL - 2
CENTER SEC. 36, T.27S., R.1E.
N.E. COR., S.E. 1/4 SEC. 36, T.27S., R.1E.
CENTER SEC. 31, T.27S., R.2E.
N.E. COR., S.E. 1/4 SEC. 31, T.27S., R.2E
S.W. COR., S.W. 1/4 SEC. 36, T.27S., R.1E.
S.W. COR., N.W. 1/4 SEC. 1, T.28S., R.1E.
CENTER SEC. 1, T.28S., R.1E.
S.W. COR., N.W. 1/4 SEC. 6, T.28S., R.2E.
S.W. COR., N.E. 1/4 SEC. 1, T.28S., R.1E.
CENTER SEC. 6, T.28S., R.1E.
S.E. COR., N.E. 1/4 SEC. 6, T.28S., R.2E.
N.W. COR. SEC. 6, T.28S., R.2E.
N.W. COR., N.E. 1/4 SEC. 6, T.28S., R.2E.
N.E. CORNER SEC. 6, T.28S., R.2E
PAWNEE
PAWNEE ROAD
OLIVER
ROCK ROAD
CESSNA
CESSNA COUNTY
MCCONNELL AFB
A.T. & S.F. R.R. SPUR TRACK
A.T. & S.F. R.R. MAIN TRACK
SANITARY SEWER
WATER MAIN
GAS LINE
POND
POND (DRY)
WATER TANK
METERING STATION
TRANSFORMER STATION
SHELTER BELT
RUNWAY
TAXIWAY
ACCESS ROAD
BENCH MARK
B-B
A-A
8-8
#1 405 A
#2 54.07 A INCL. PARK. AREA
#3 162.33 A
#4 130 A
#5 143 A
86.13 A
76.22 A
320 A
6.80 ACRE PARKING AREA
80 ACRE PARKING AREA
ACREAGE
AREA A LOCATION
1 405 S OF PAWNEE (INCL 80+ S.
2 54.07 S OF KTP N OF PAWNEE
3 162.36 W ADD'N (JOHNSTON
4 130 N OF SERV. HANGAR
5 143 S OF WOODLAWN OF PAWNEE
6
TOTAL 904.65 PAWNEE COMM. DIV.
TOPOGRAPHIC MAP
CESSNA AIRCRAFT PROPERTY
PAWNEE PLANT
WICHITA, KANSAS
SCALE: 1" = 300'
H.R. HUNTER — CONSULTING ENGINEERS
WICHITA, KANSAS
MAY 1958
REVISED: SEPT. 1959
JULY 1962
APRIL 1962
MAIN WATER TOWER & BEACON

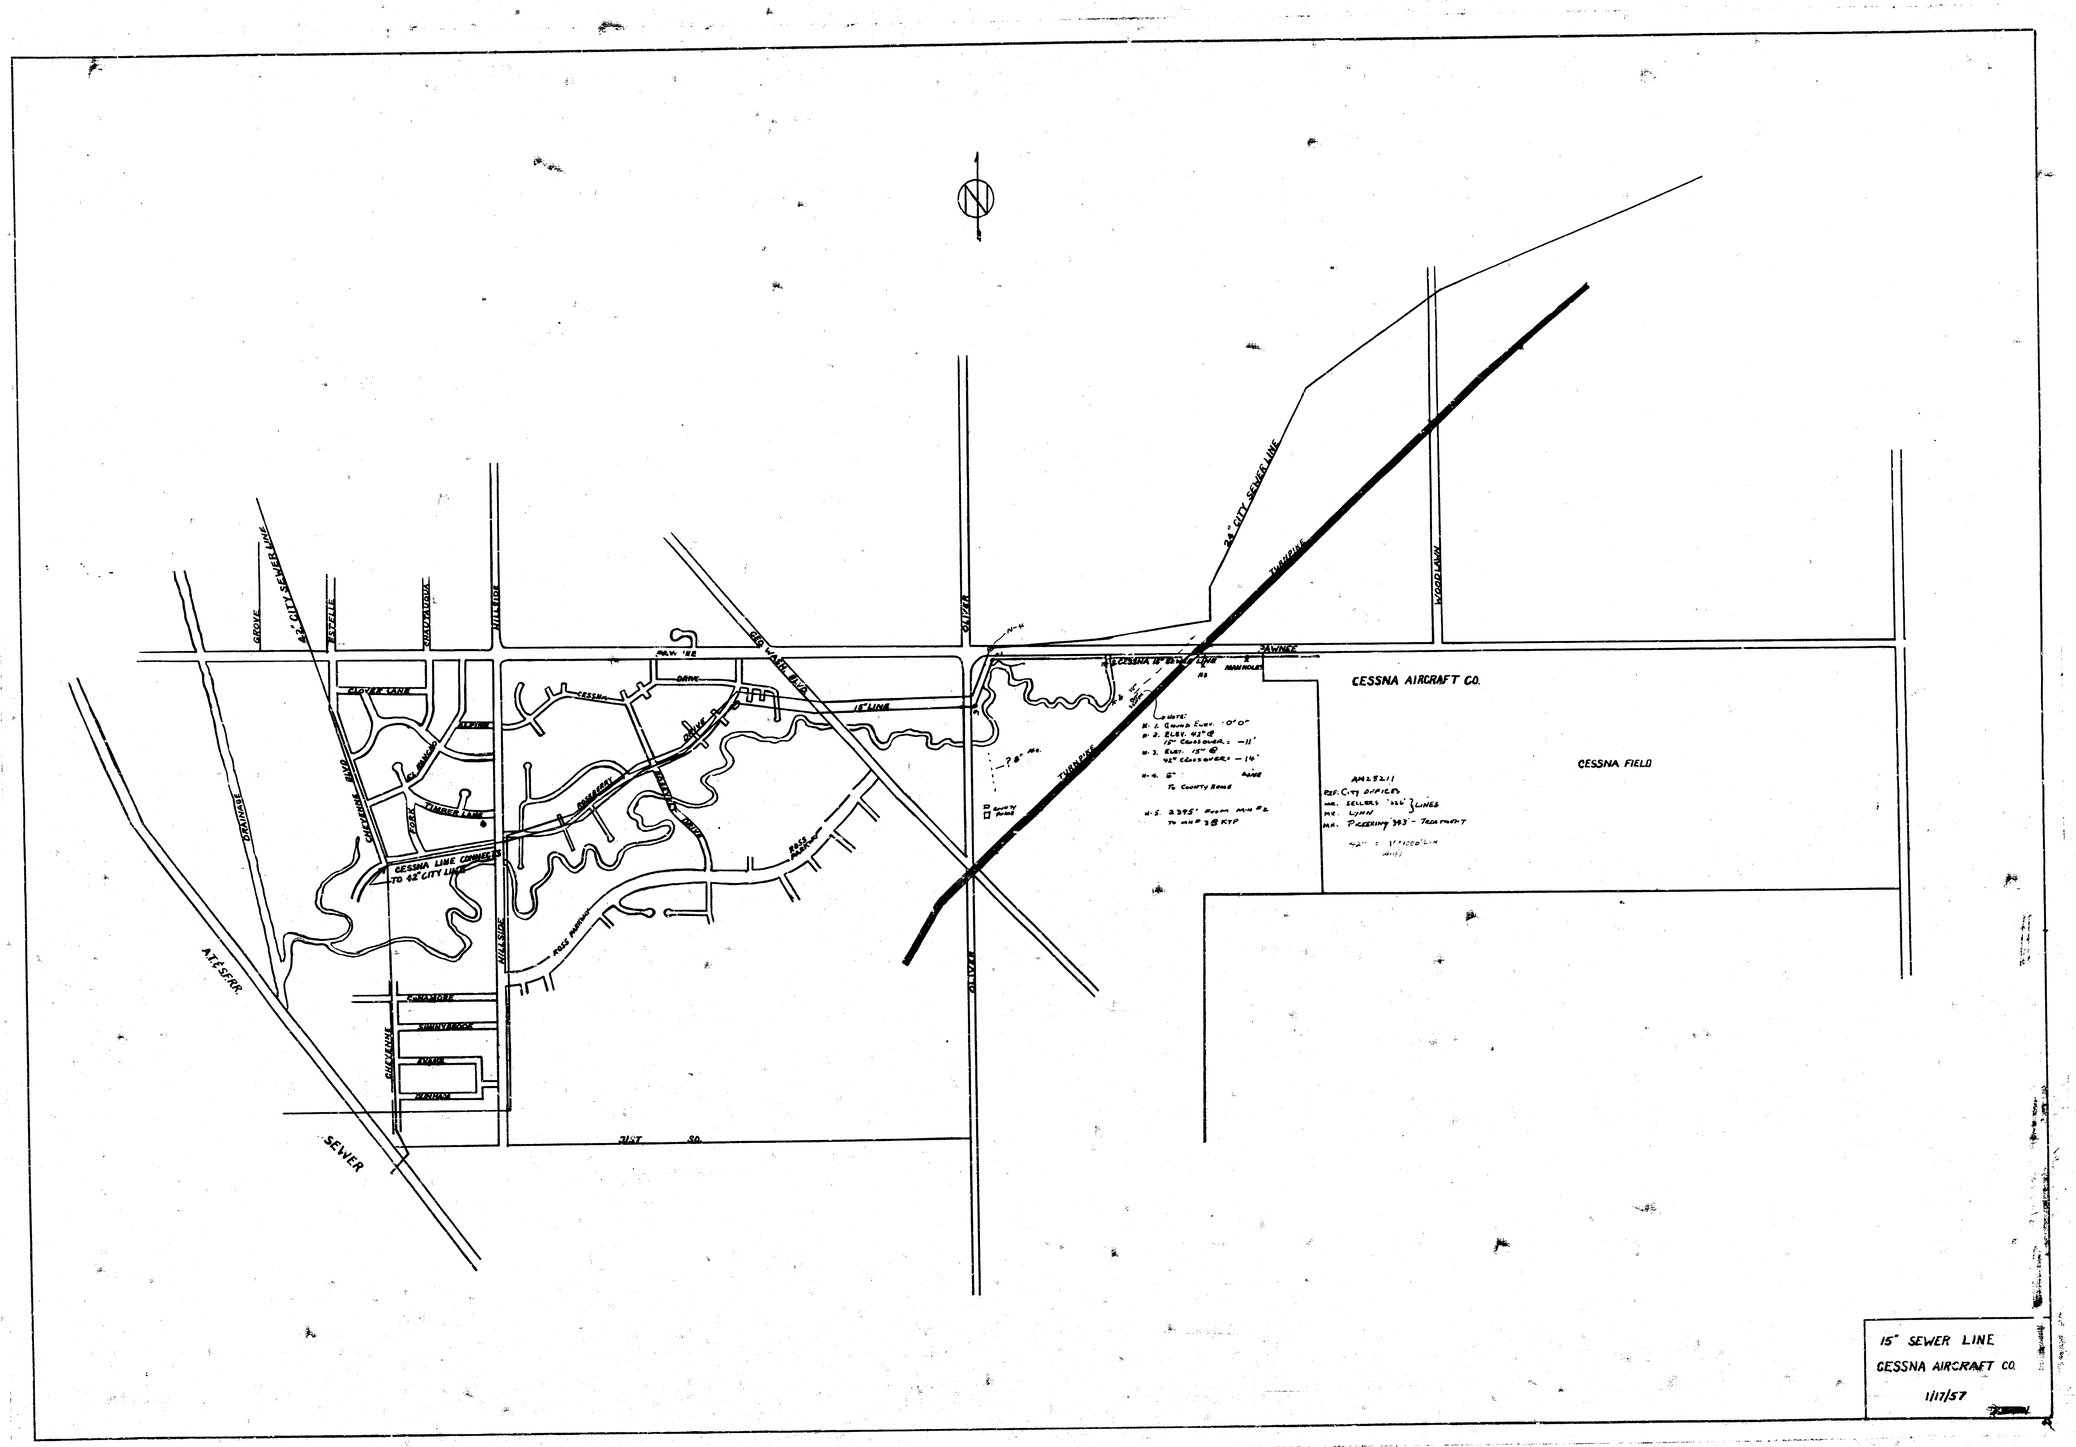
24" CITY SEWER LINE
TURNPIKE
WOODLAWN
DAWNEE
CESSNA AIRCRAFT CO.
CESSNA FIELD
CESSNA 18" & 24" LINE
MANHOLES
NOTES:
M. 1. GROUND ELEV. -0'0"
M. 2. ELEV. 42" @ 12" CROSSOVER: -11'
M. 3. ELEV. 15" @ 42" CROSSOVER: -14'
M. 4. 6" RISE
TO COUNTY ROAD
M-5 2395' FROM MH #2 TO MH #8 RTP
AM 2521
REF: CITY OFFICES
MR. SELLERS "SEW" LINES
MR. LYNN
MR. PICKERING 393 - TREATMENT
GROVE
ESTELLE
HILLSIDE
OLIVER
DAVIS
GLOVER LANE
CESSNA
DRIVE
18" LINE
CESSNA LINE CONNECTS TO 42" CITY LINE
BOULEVARD
ATESERR
CHAMBRE
SUNNYBROOK
AVENUE
PARKLANE
31ST ST.
SEWER
15" SEWER LINE
CESSNA AIRCRAFT CO.
1/17/57

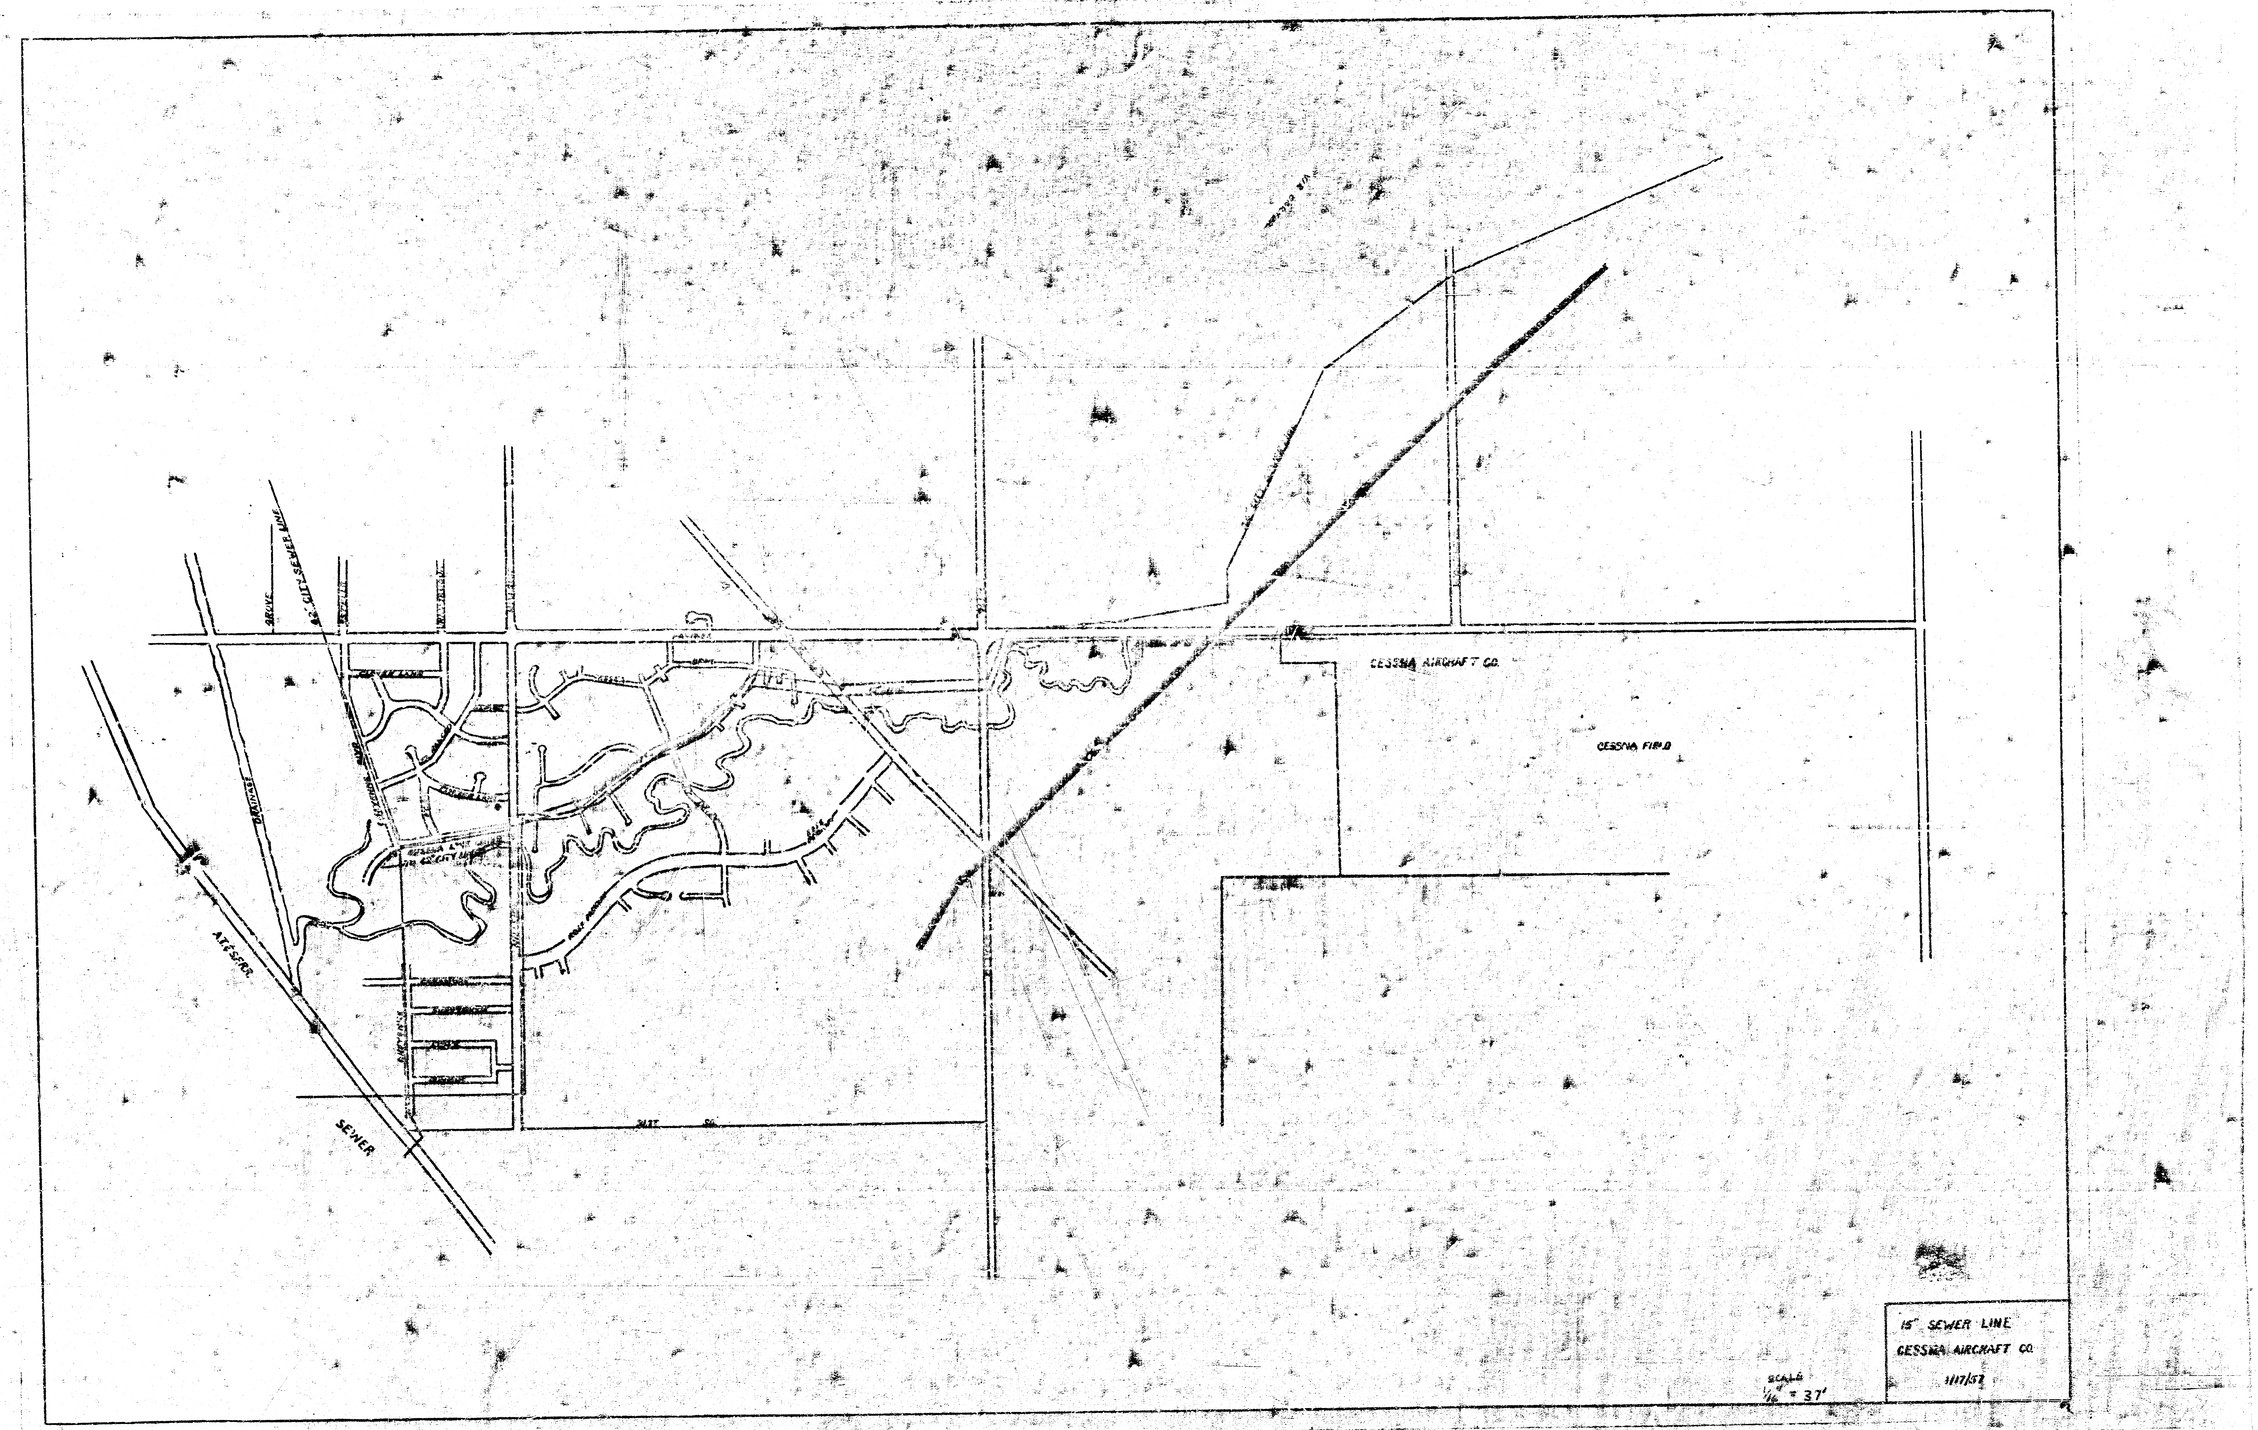
SEWER
CESSNA AIRCRAFT CO.
CESSNA FIELD
15" SEWER LINE
CESSNA AIRCRAFT CO
1117/57
SCALE
1/16" = 37'
