




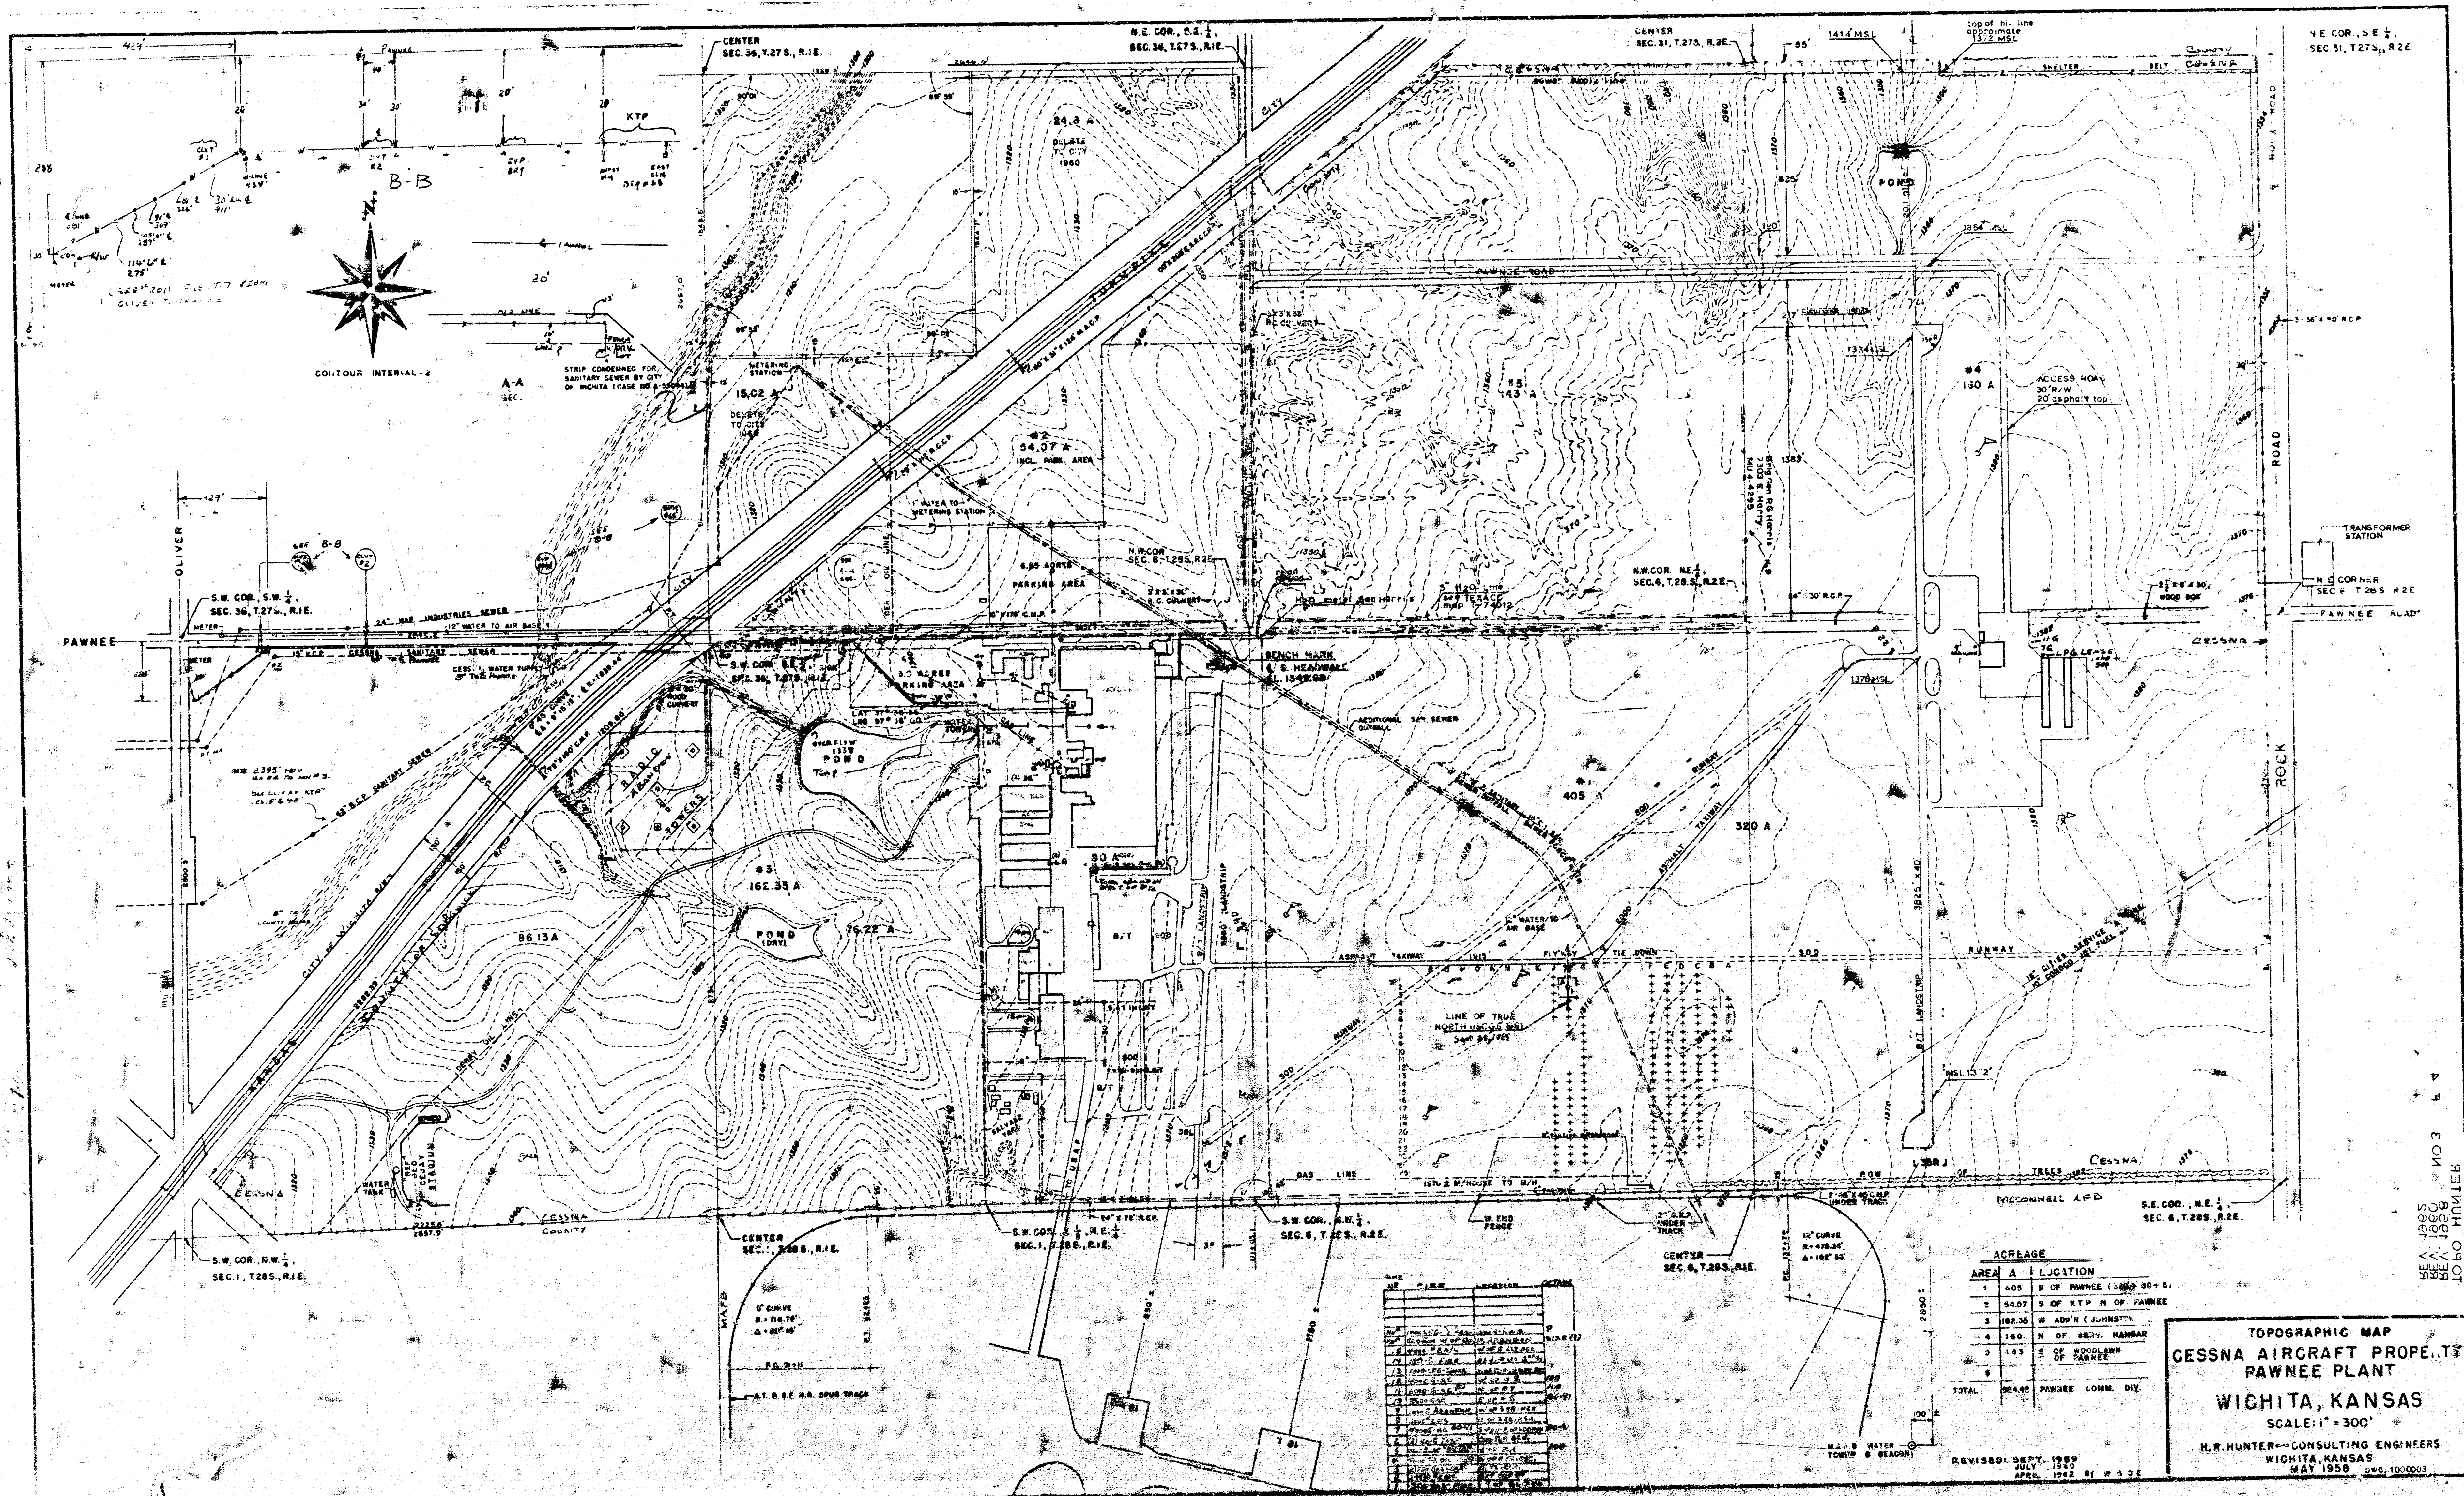

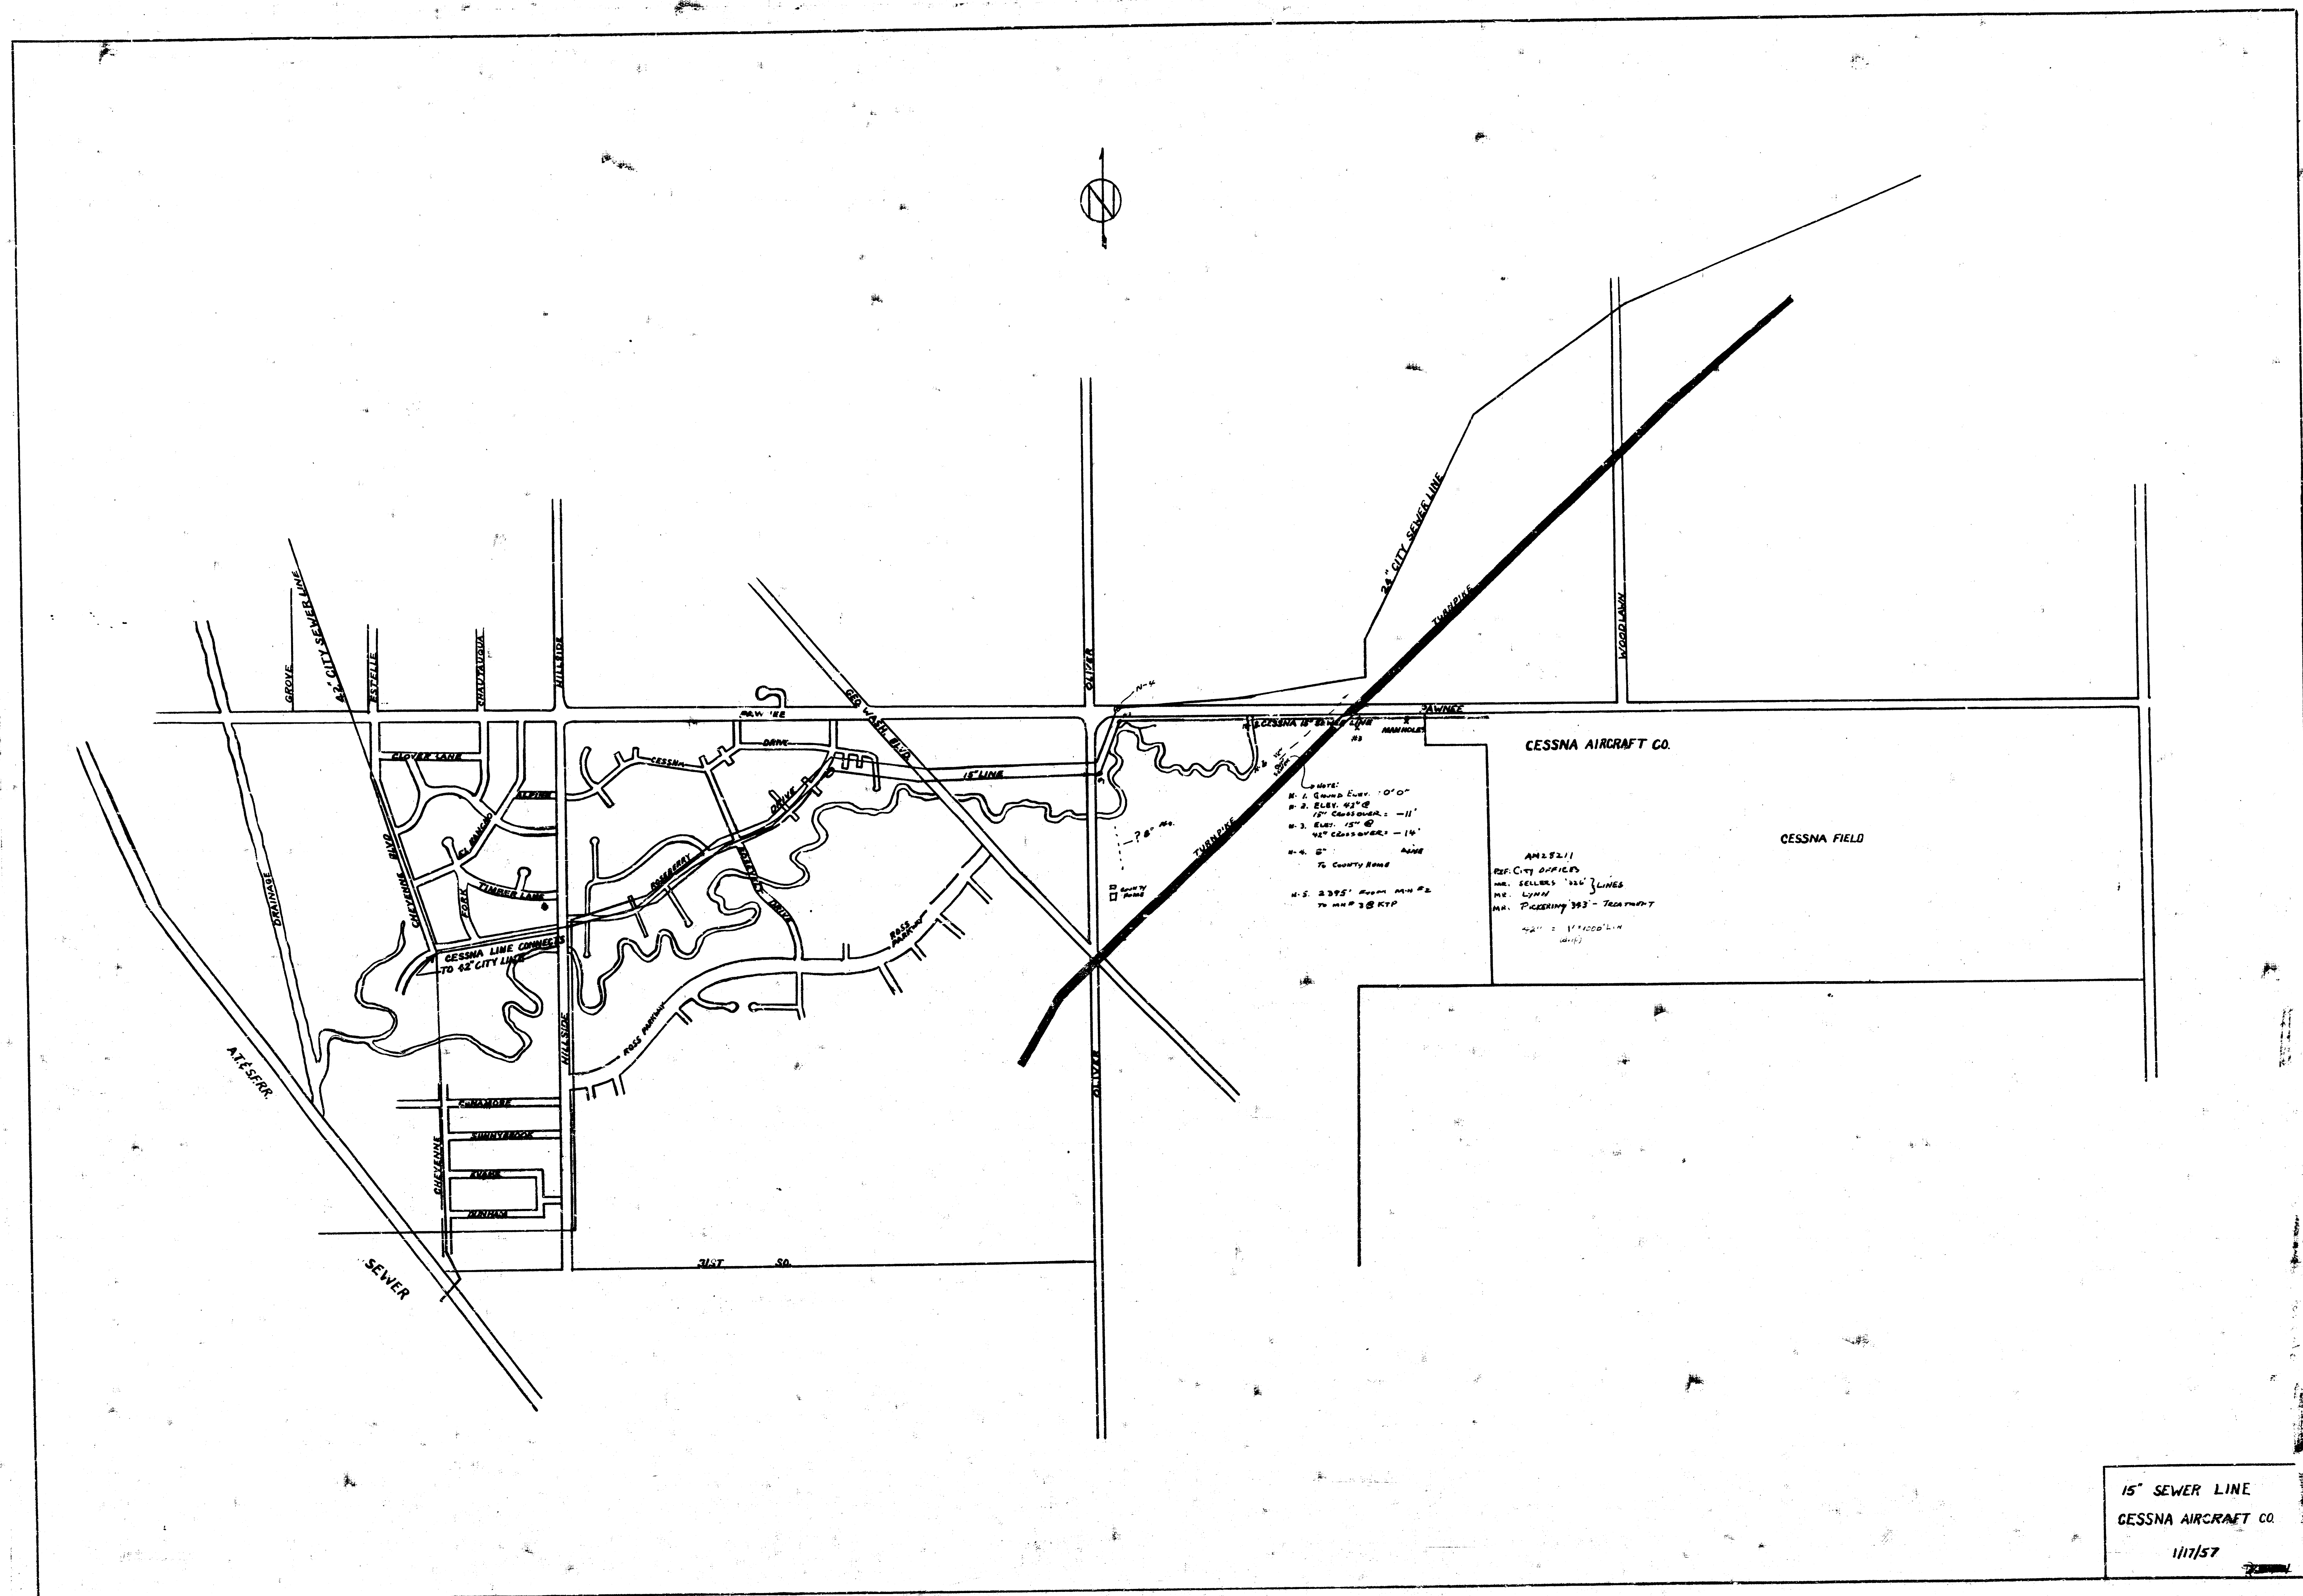

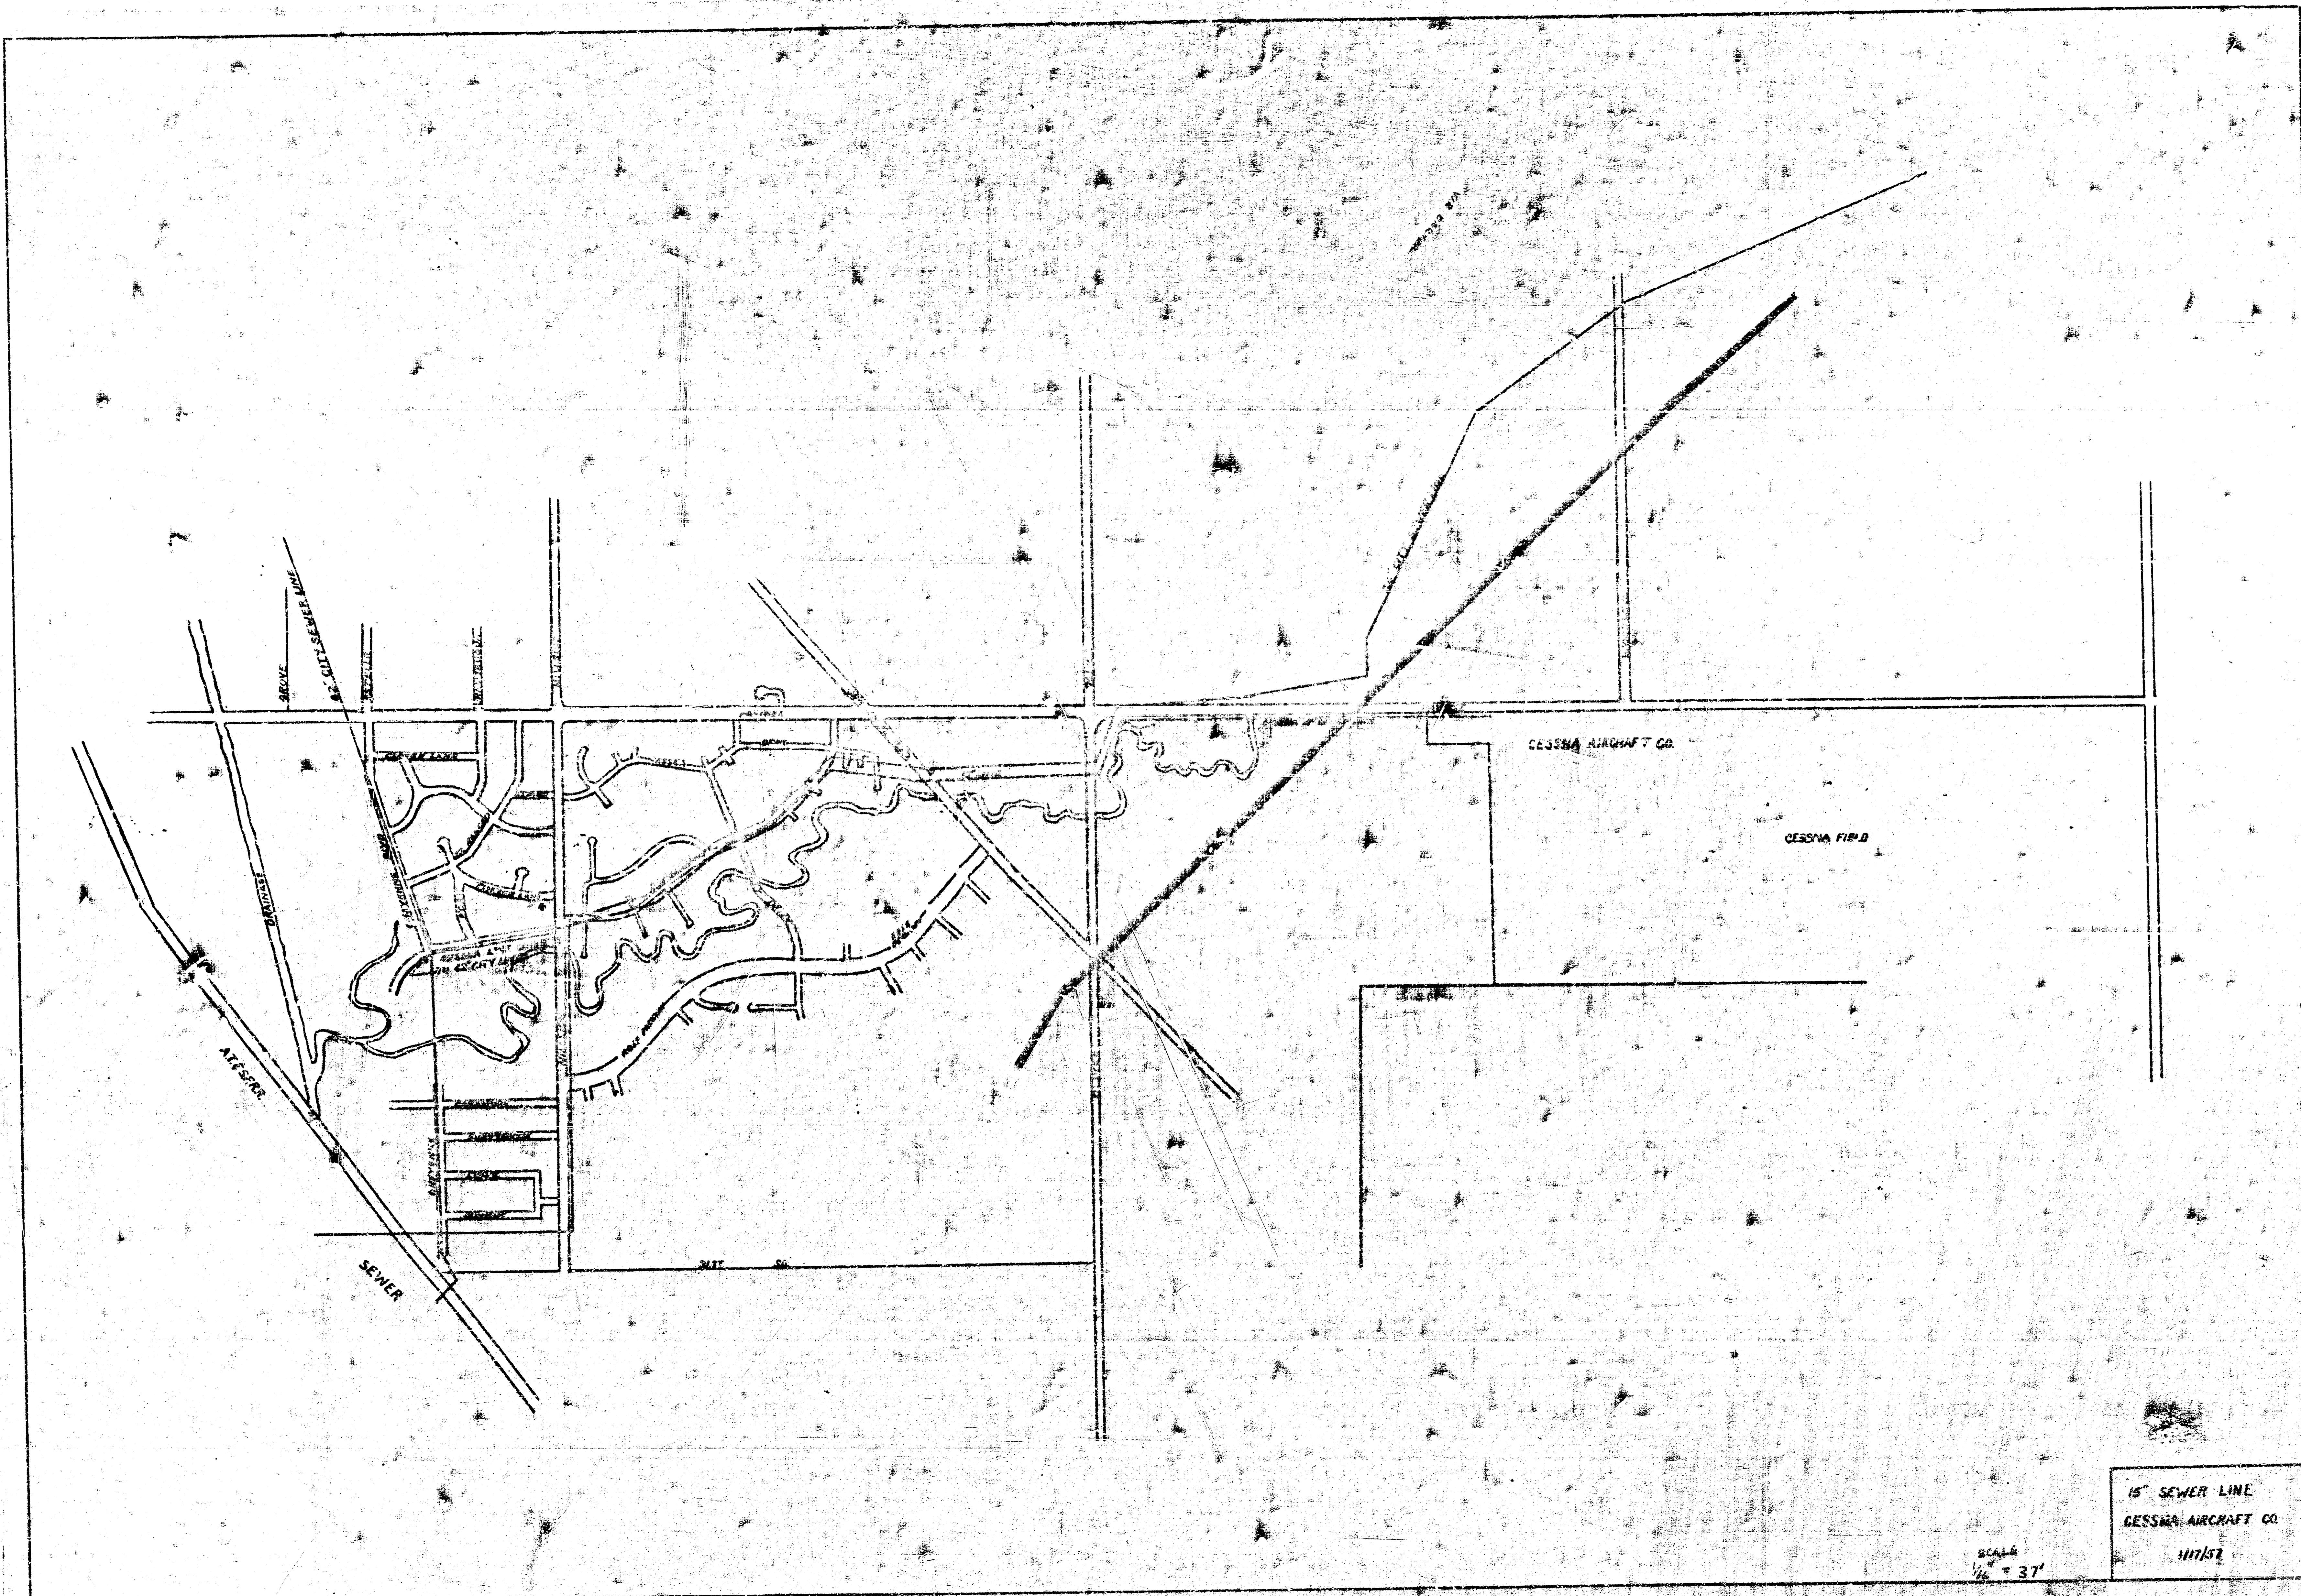

15" SEWER LINE
CESSNA AIRCRAFT CO.

SCALE
1/4" = 3'

SEWER LINE
WB CARTER
122-11-1-1
PC 3-5353
ON 2-5-53