


- LEGEND**
- POWER POLE
  - EXIST. SAN. SEWER
  - PROPOSED SAN. SEWER W/ M.H.
  - CLEAN-OUT
  - PROPOSED WATER
  - PROPOSED WATER VALVE
  - PROPOSED FIRE HYDRANT W/ VALVE
  - UNDERGROUND MISC. SEAM
  - TRANSFORMER

- NOTES**
1. ALL M.H.'S TO BE CONCR. AS PER CITY STDS. & SPECS.
  2. SAND FILL & FLUSH SAN. SEWER & WATER LINES DITCHES.
  3. TOP OF M.H. TO BE ESTABLISHED BY FINISHED GRADE.
  4. ALL M.H.'S TYPE A UNLESS OTHERWISE NOTED.

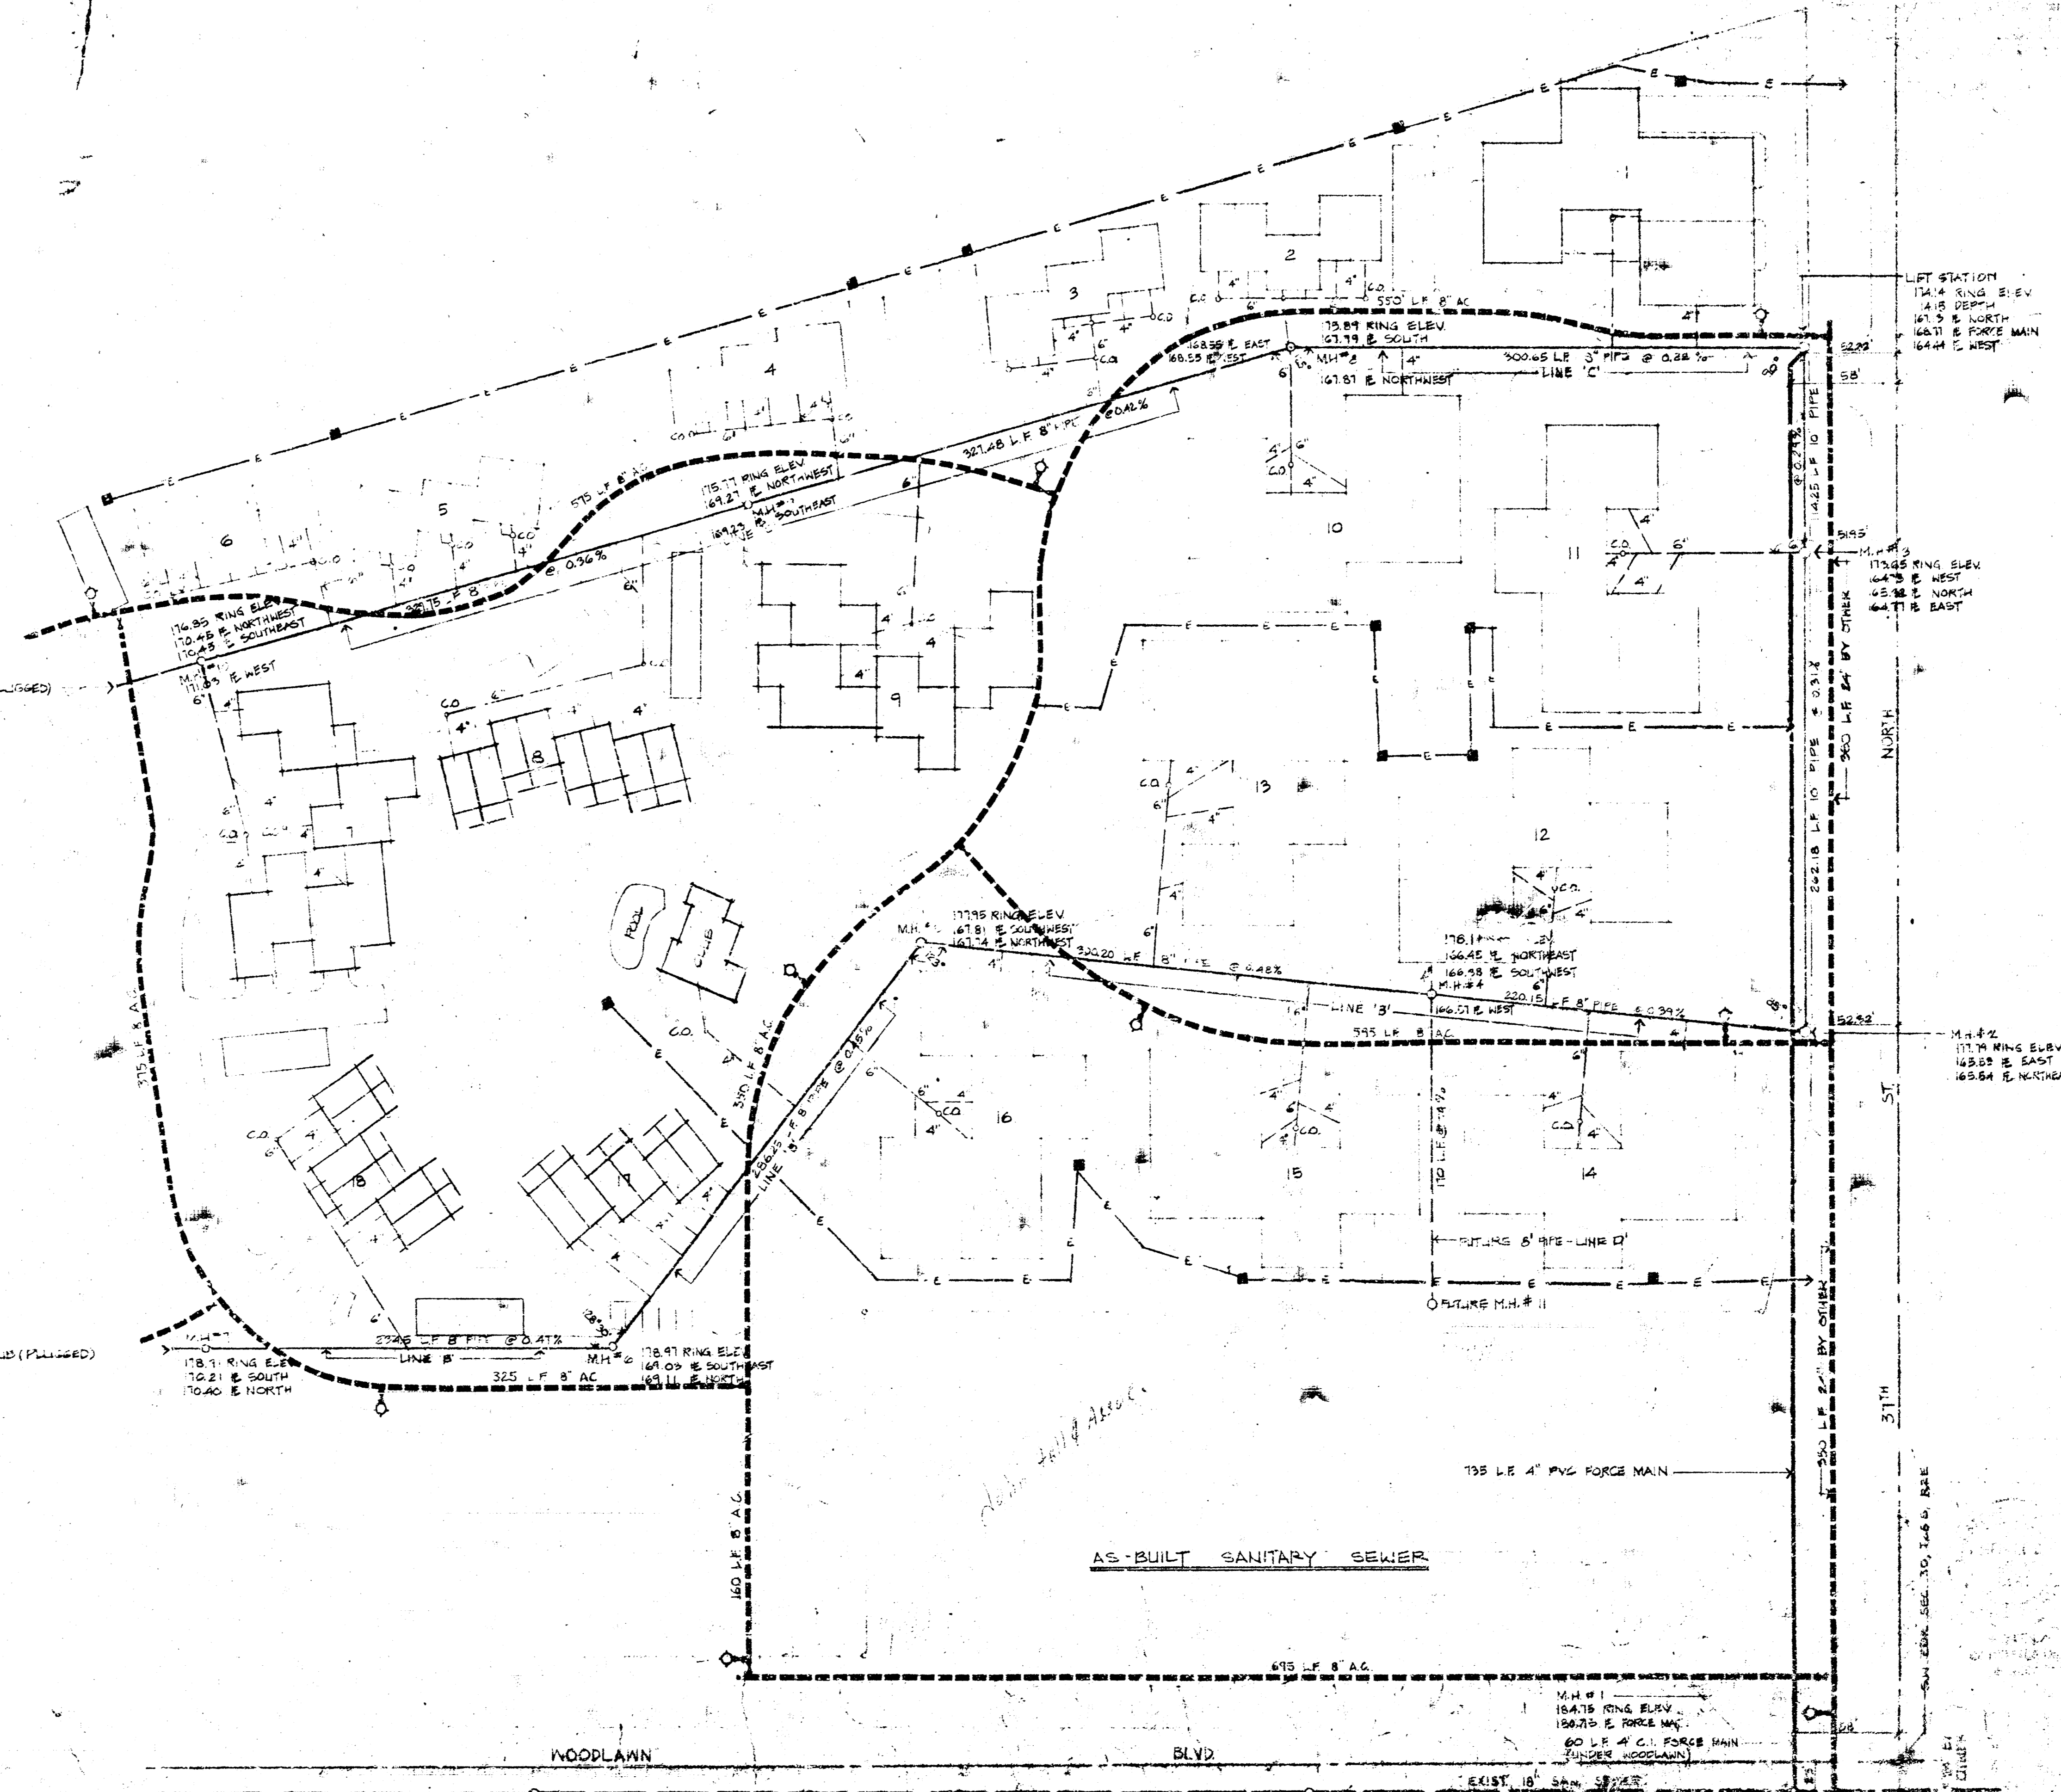

CHISHOLM CREEK UTILITY PLAN  

