


PLATE PLAN PROFILE (A-A)  
 QUANTITY PARTS (A-A)  
 30 NOV 1951

(3)

25

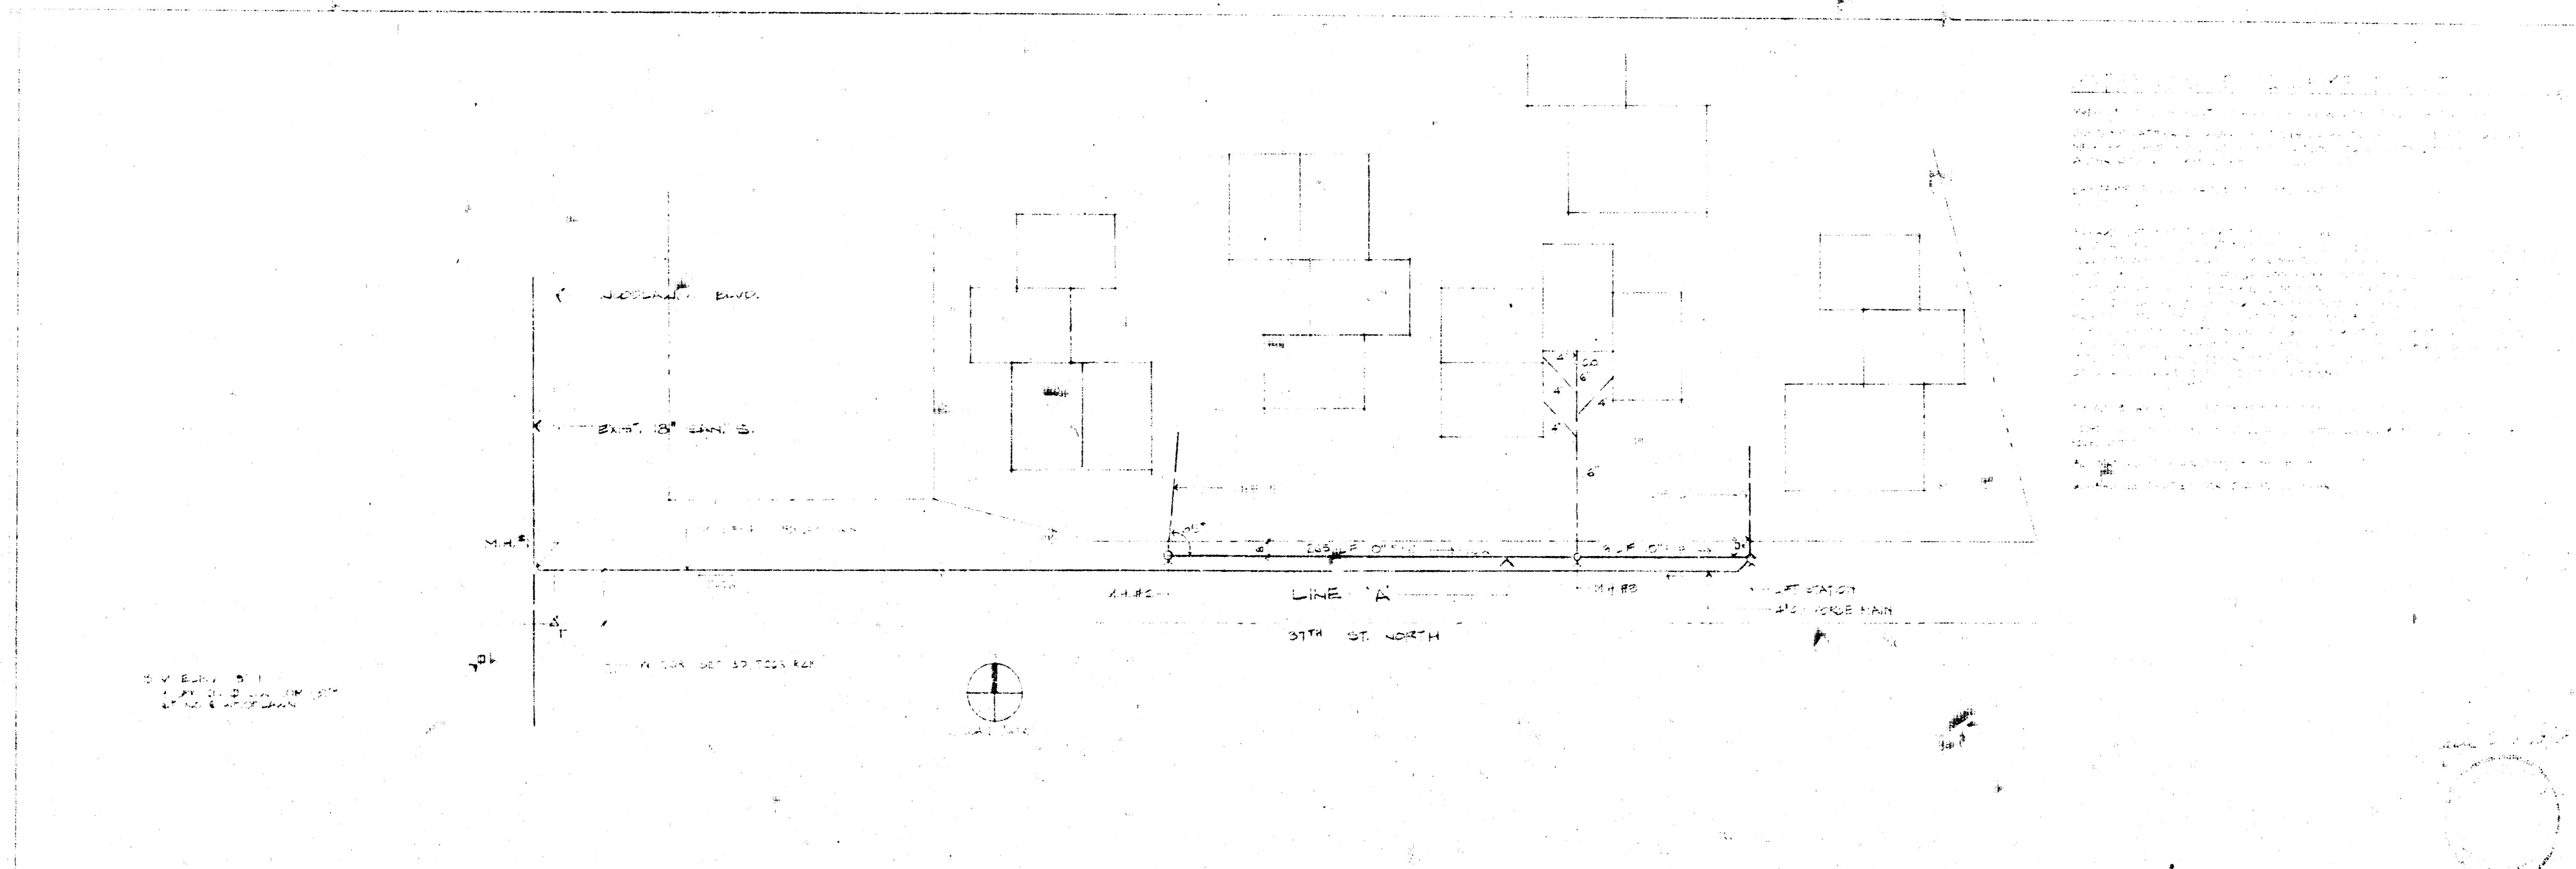




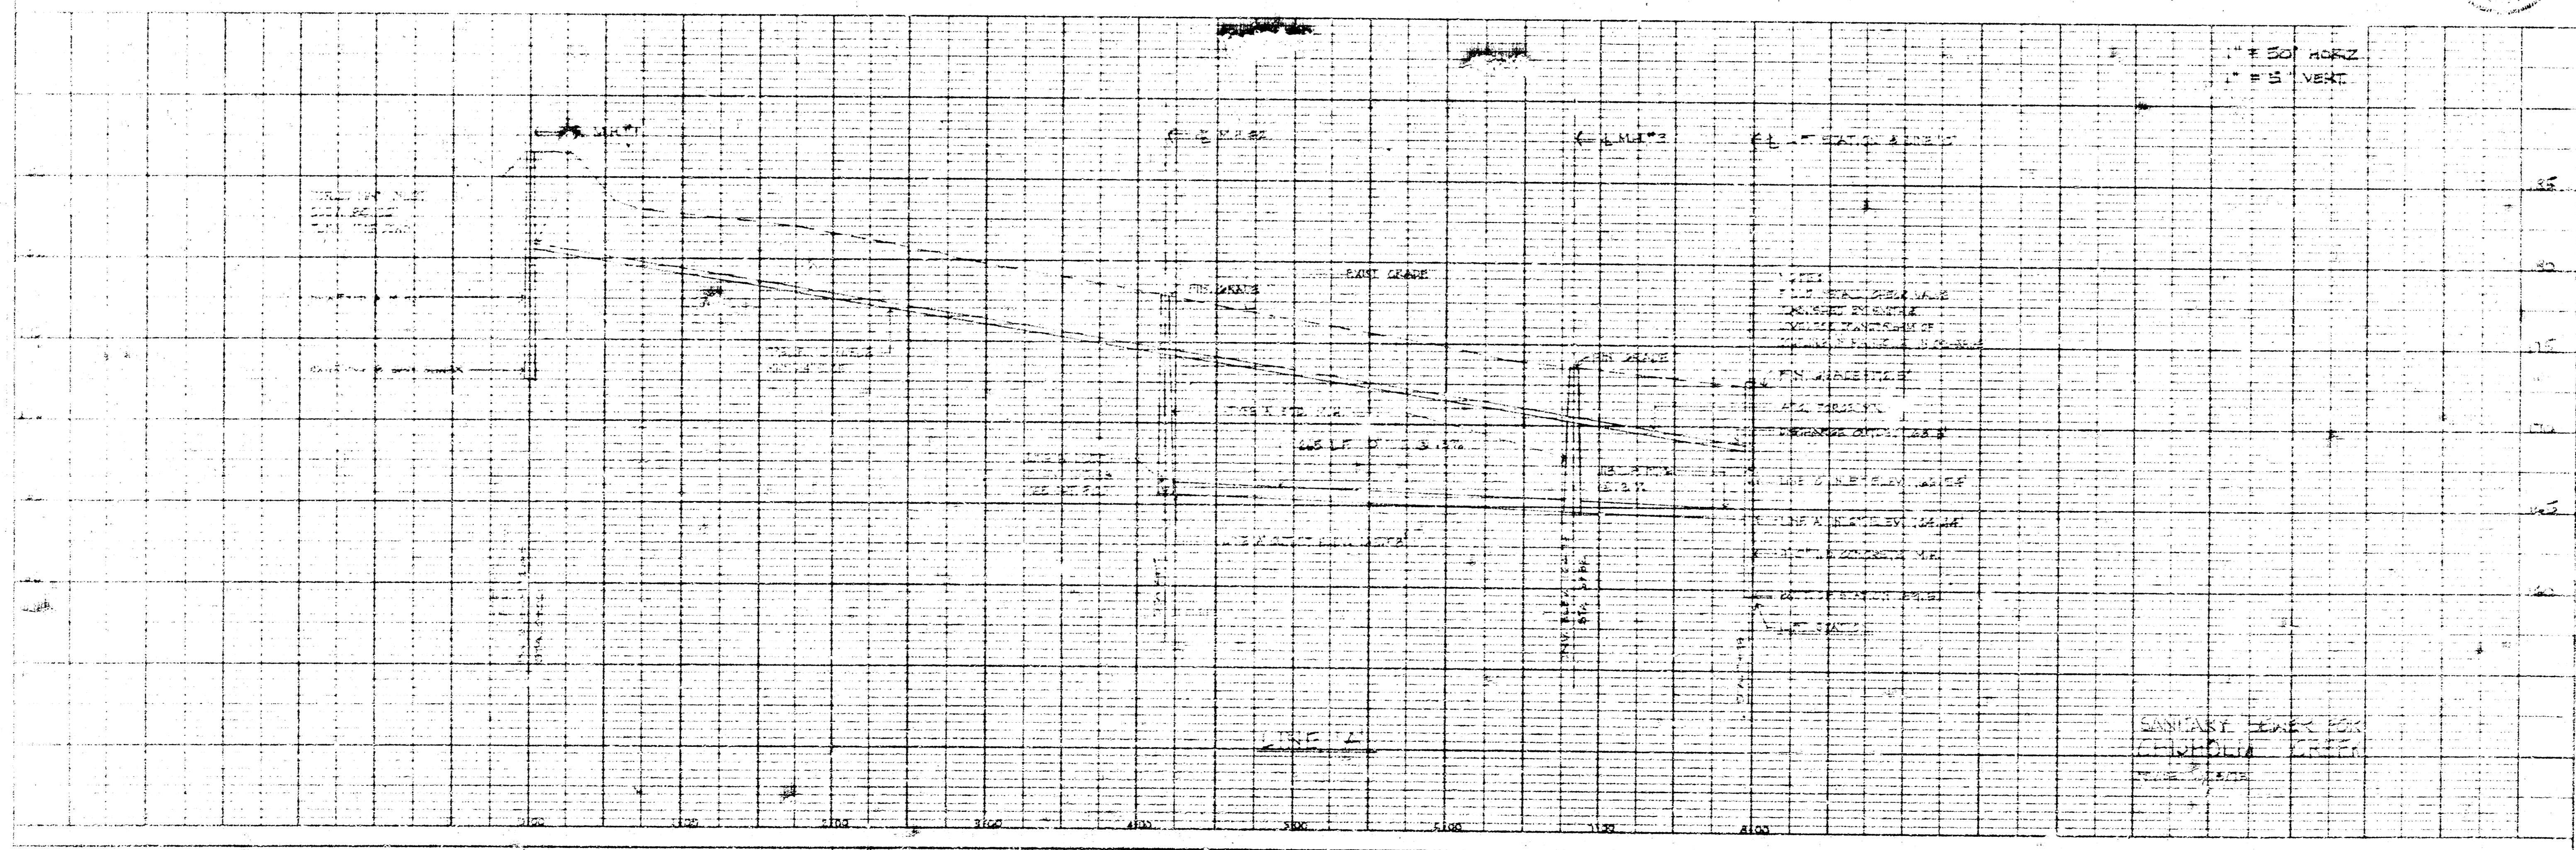


PLATE 1 PLAN PROFILE AND  
 CLEARANCE DATA FOR  
 5TH ST. NORTH

SUMMARY SHEET FOR  
 5TH ST. NORTH  
 10/1/20

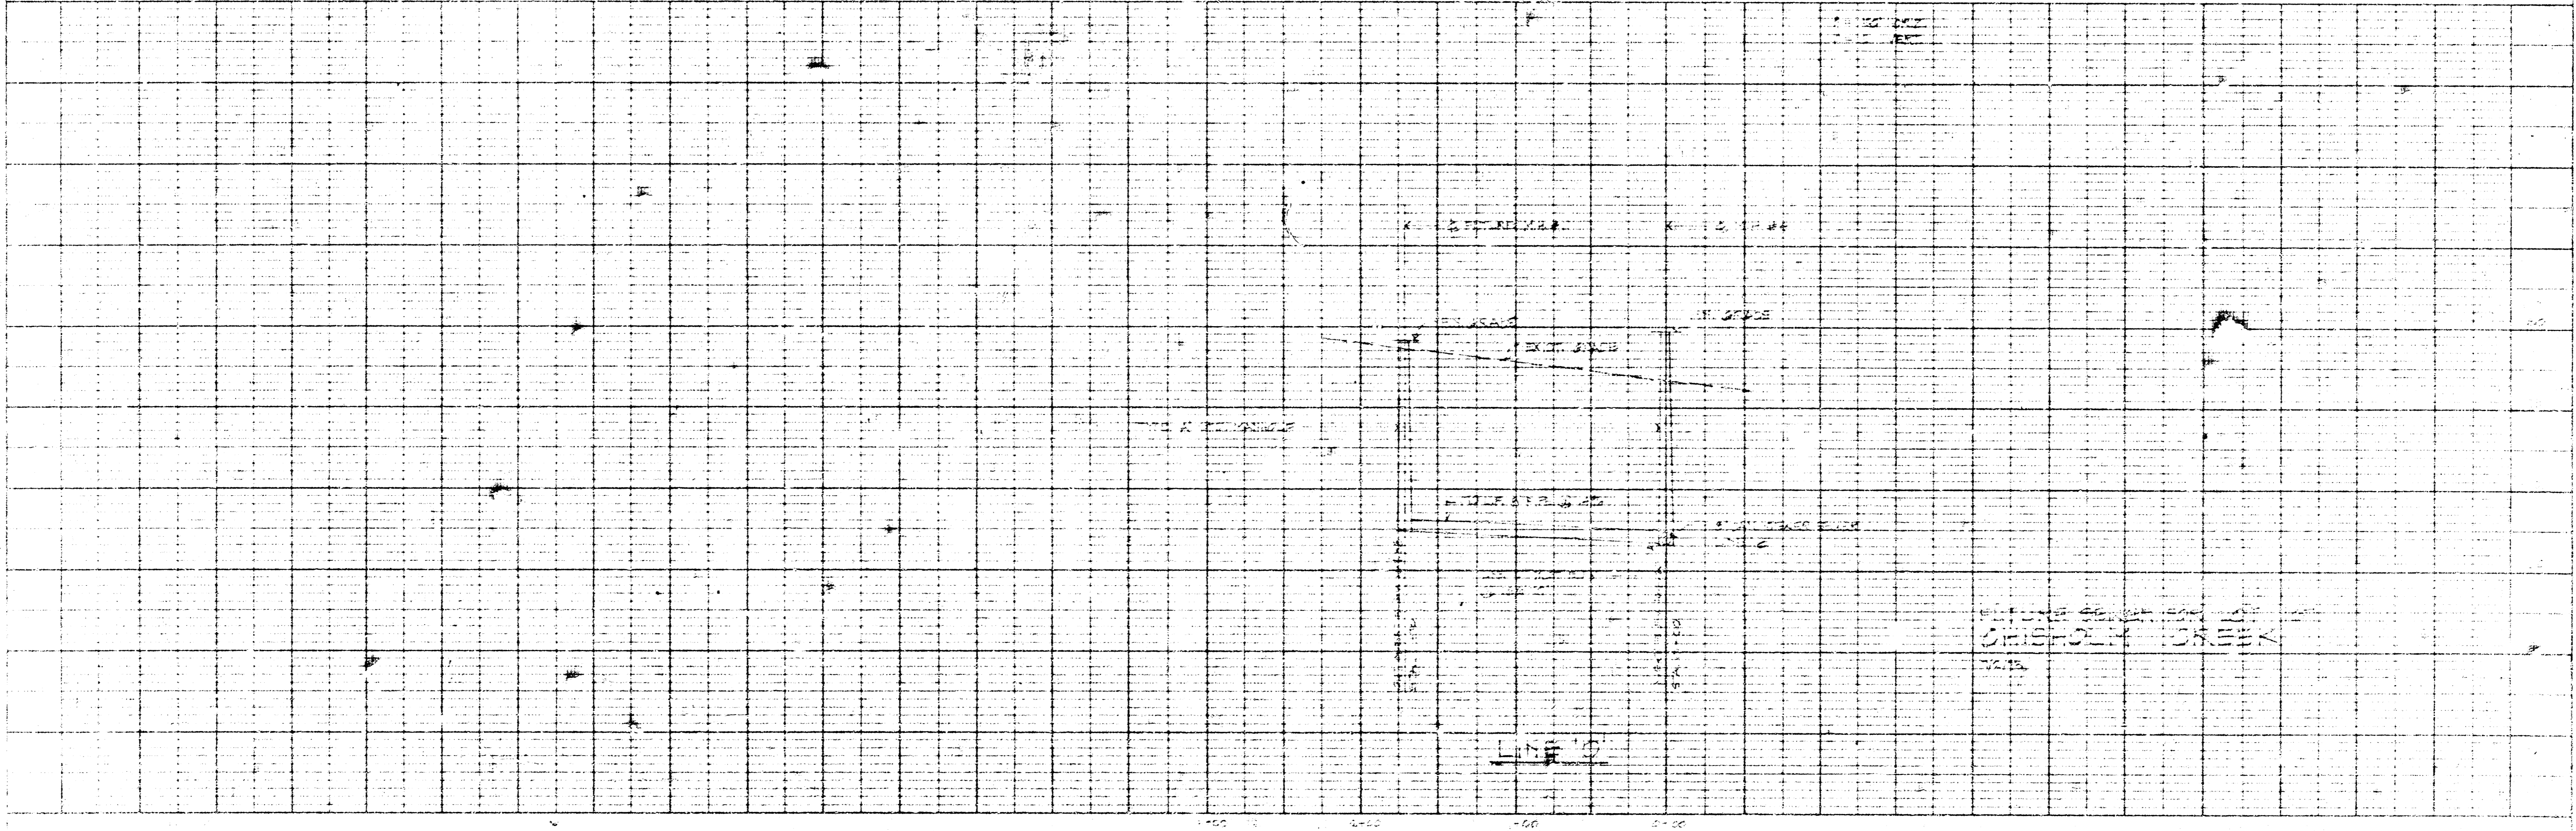

 

PLAN

PROFILE

PLATE 27A PROFILE P.A.B.  
CLEARANCE PANEL NO. 31 CAL.  
NO. 10001

14 2 4 27A  
13