


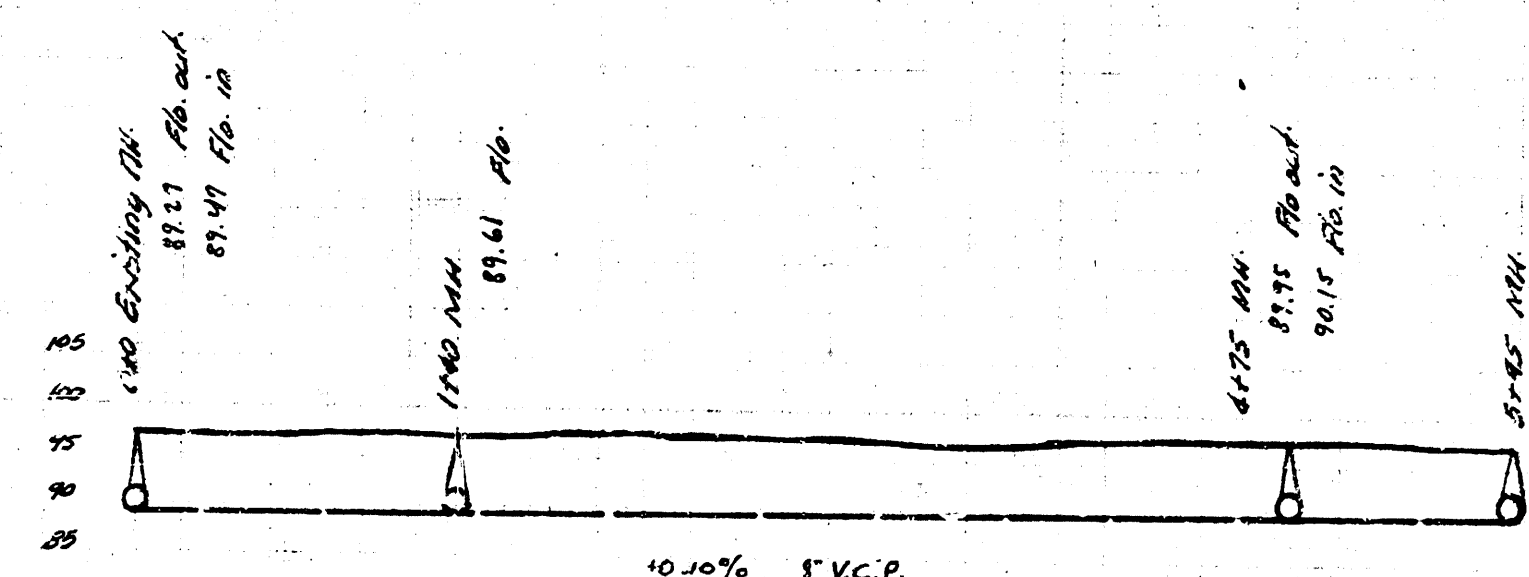
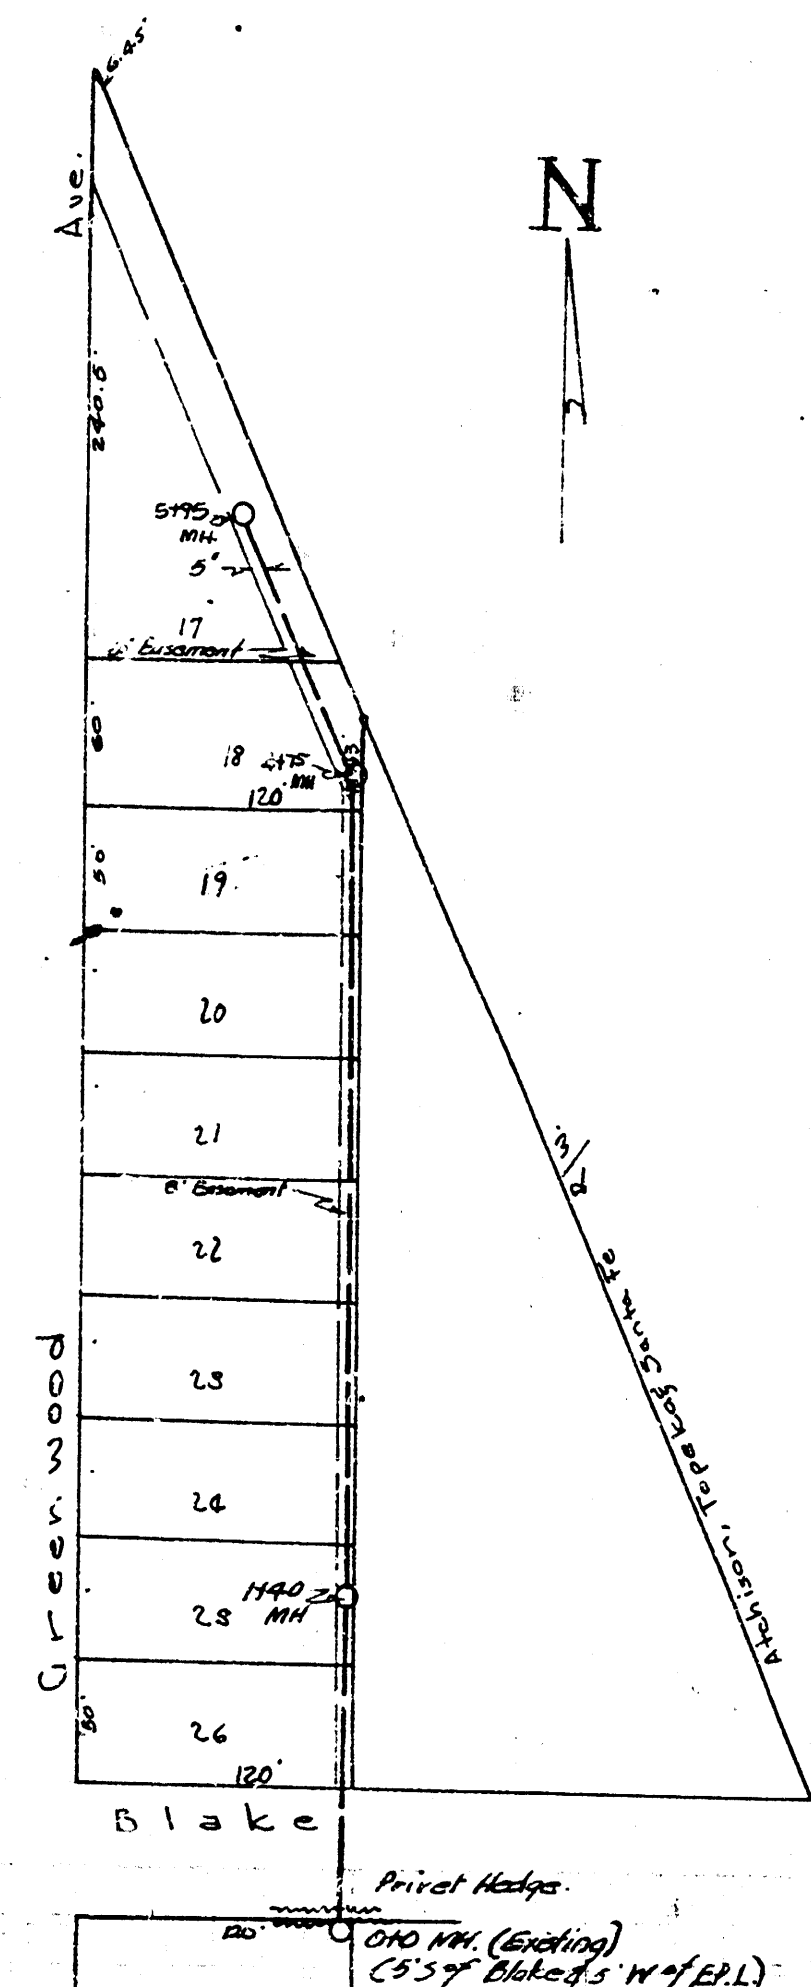


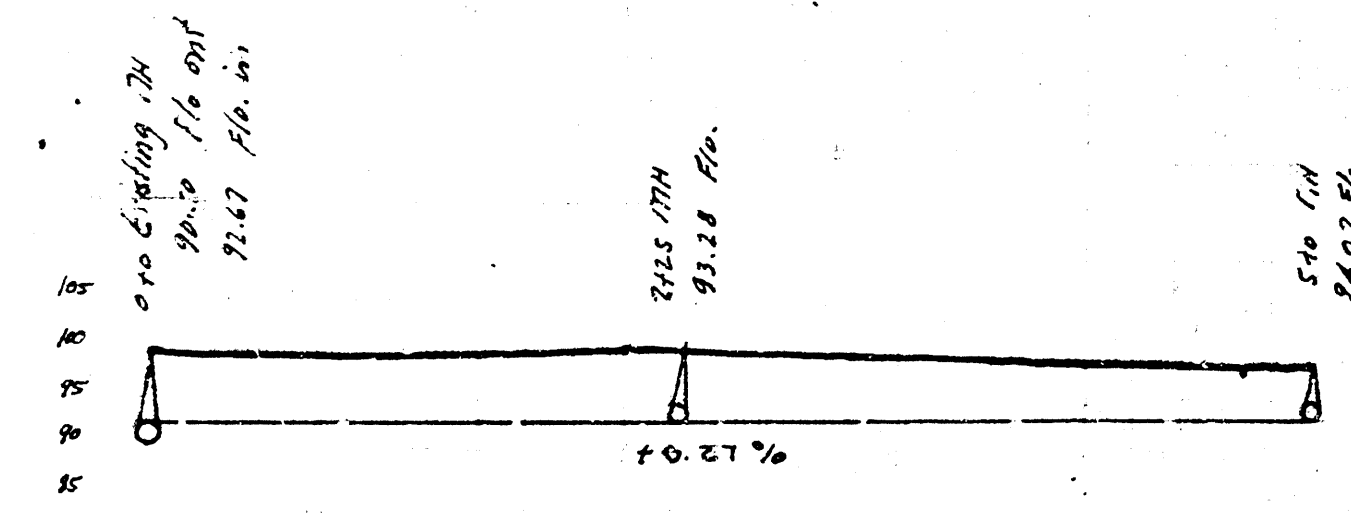

Lot. 2, Dist. B, S.S.* 20

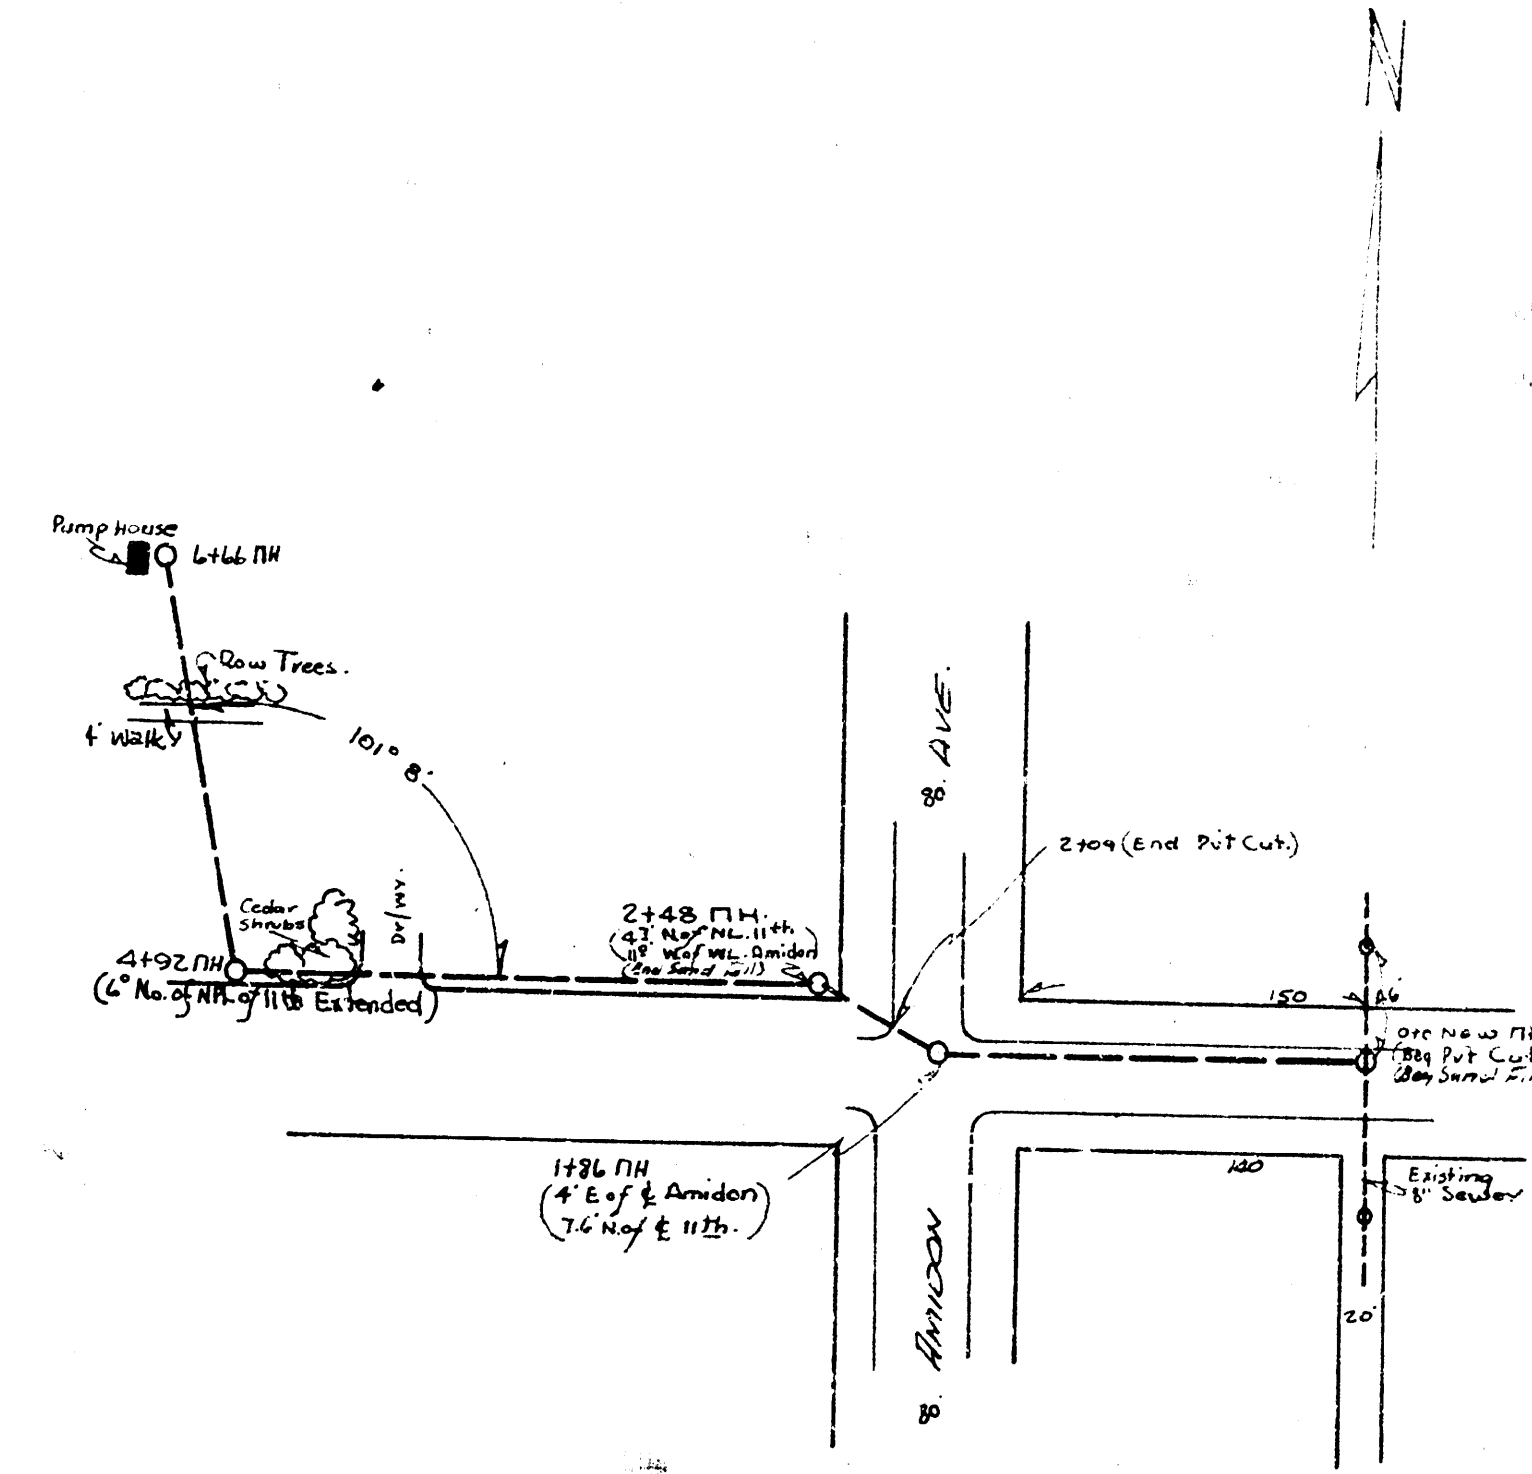

Salvation Army Sanitary Sewer
BM 119.22 Iron in Humble & Perimeter on 11th

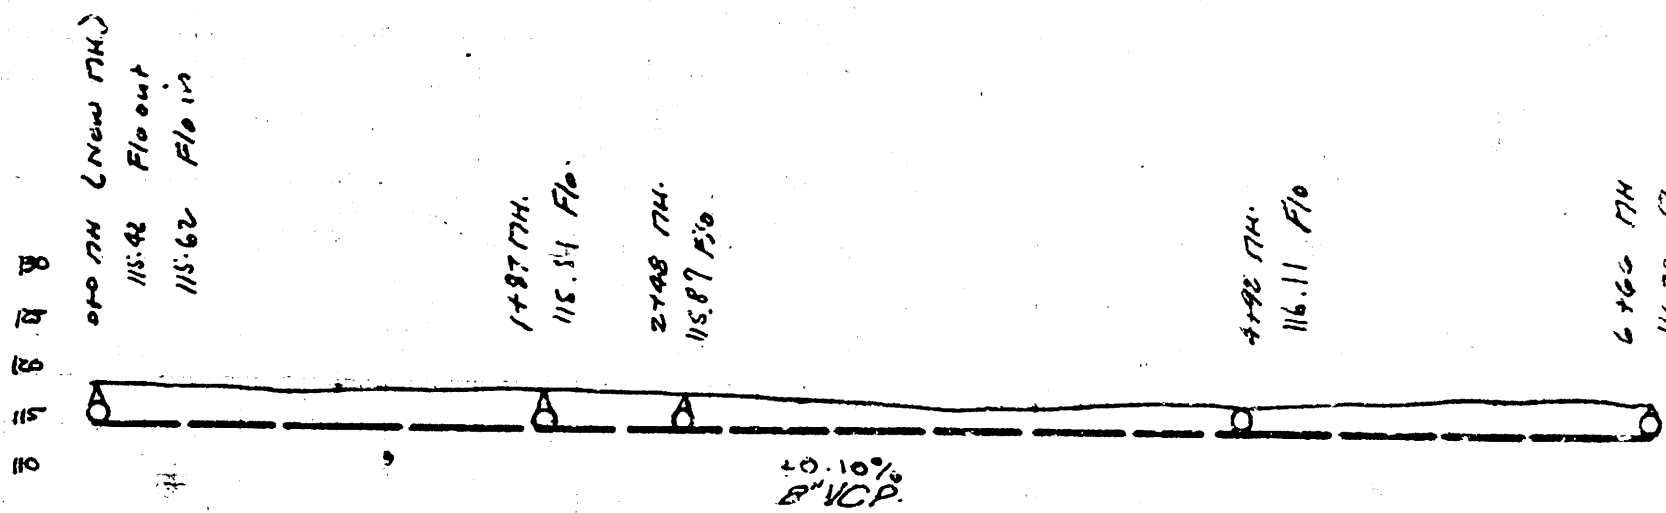

Salvation Army Sanitary Sewer
City Prison Farm Sanitary Sewer
Lot 8, Dist. B, Sanitary Sewer #20.
City of Wichita, Kansas

L. K. White City Engineer
Date May 23, 1949