





SCHAEFER SCHIRMER & EFLIN AIA
ARCHITECTS ENGINEERS AND PLANNERS
200 SOUTH HILLSIDE WICHITA KANSAS 67211 316-684-0171

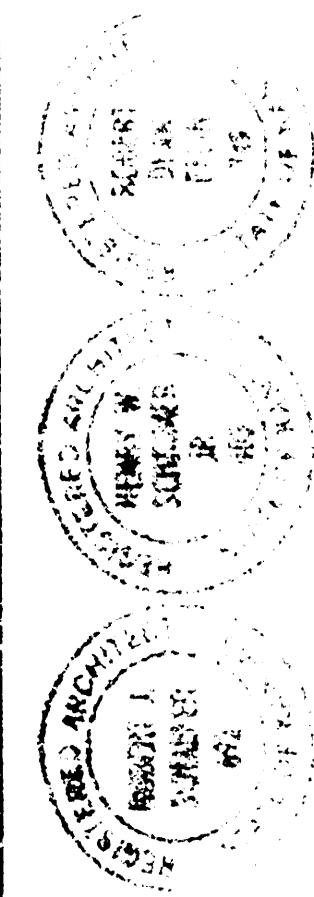

COLEMAN COMPANY INC.
PLANT ENGINEERS
2700 W. 10TH AVE
WICHITA, KANSAS 67210

REVISION:
DATE: 2/27/70
DRAWN BY:
JOB NUMBER:
SHEET NO.:
OF 2 SHEETS

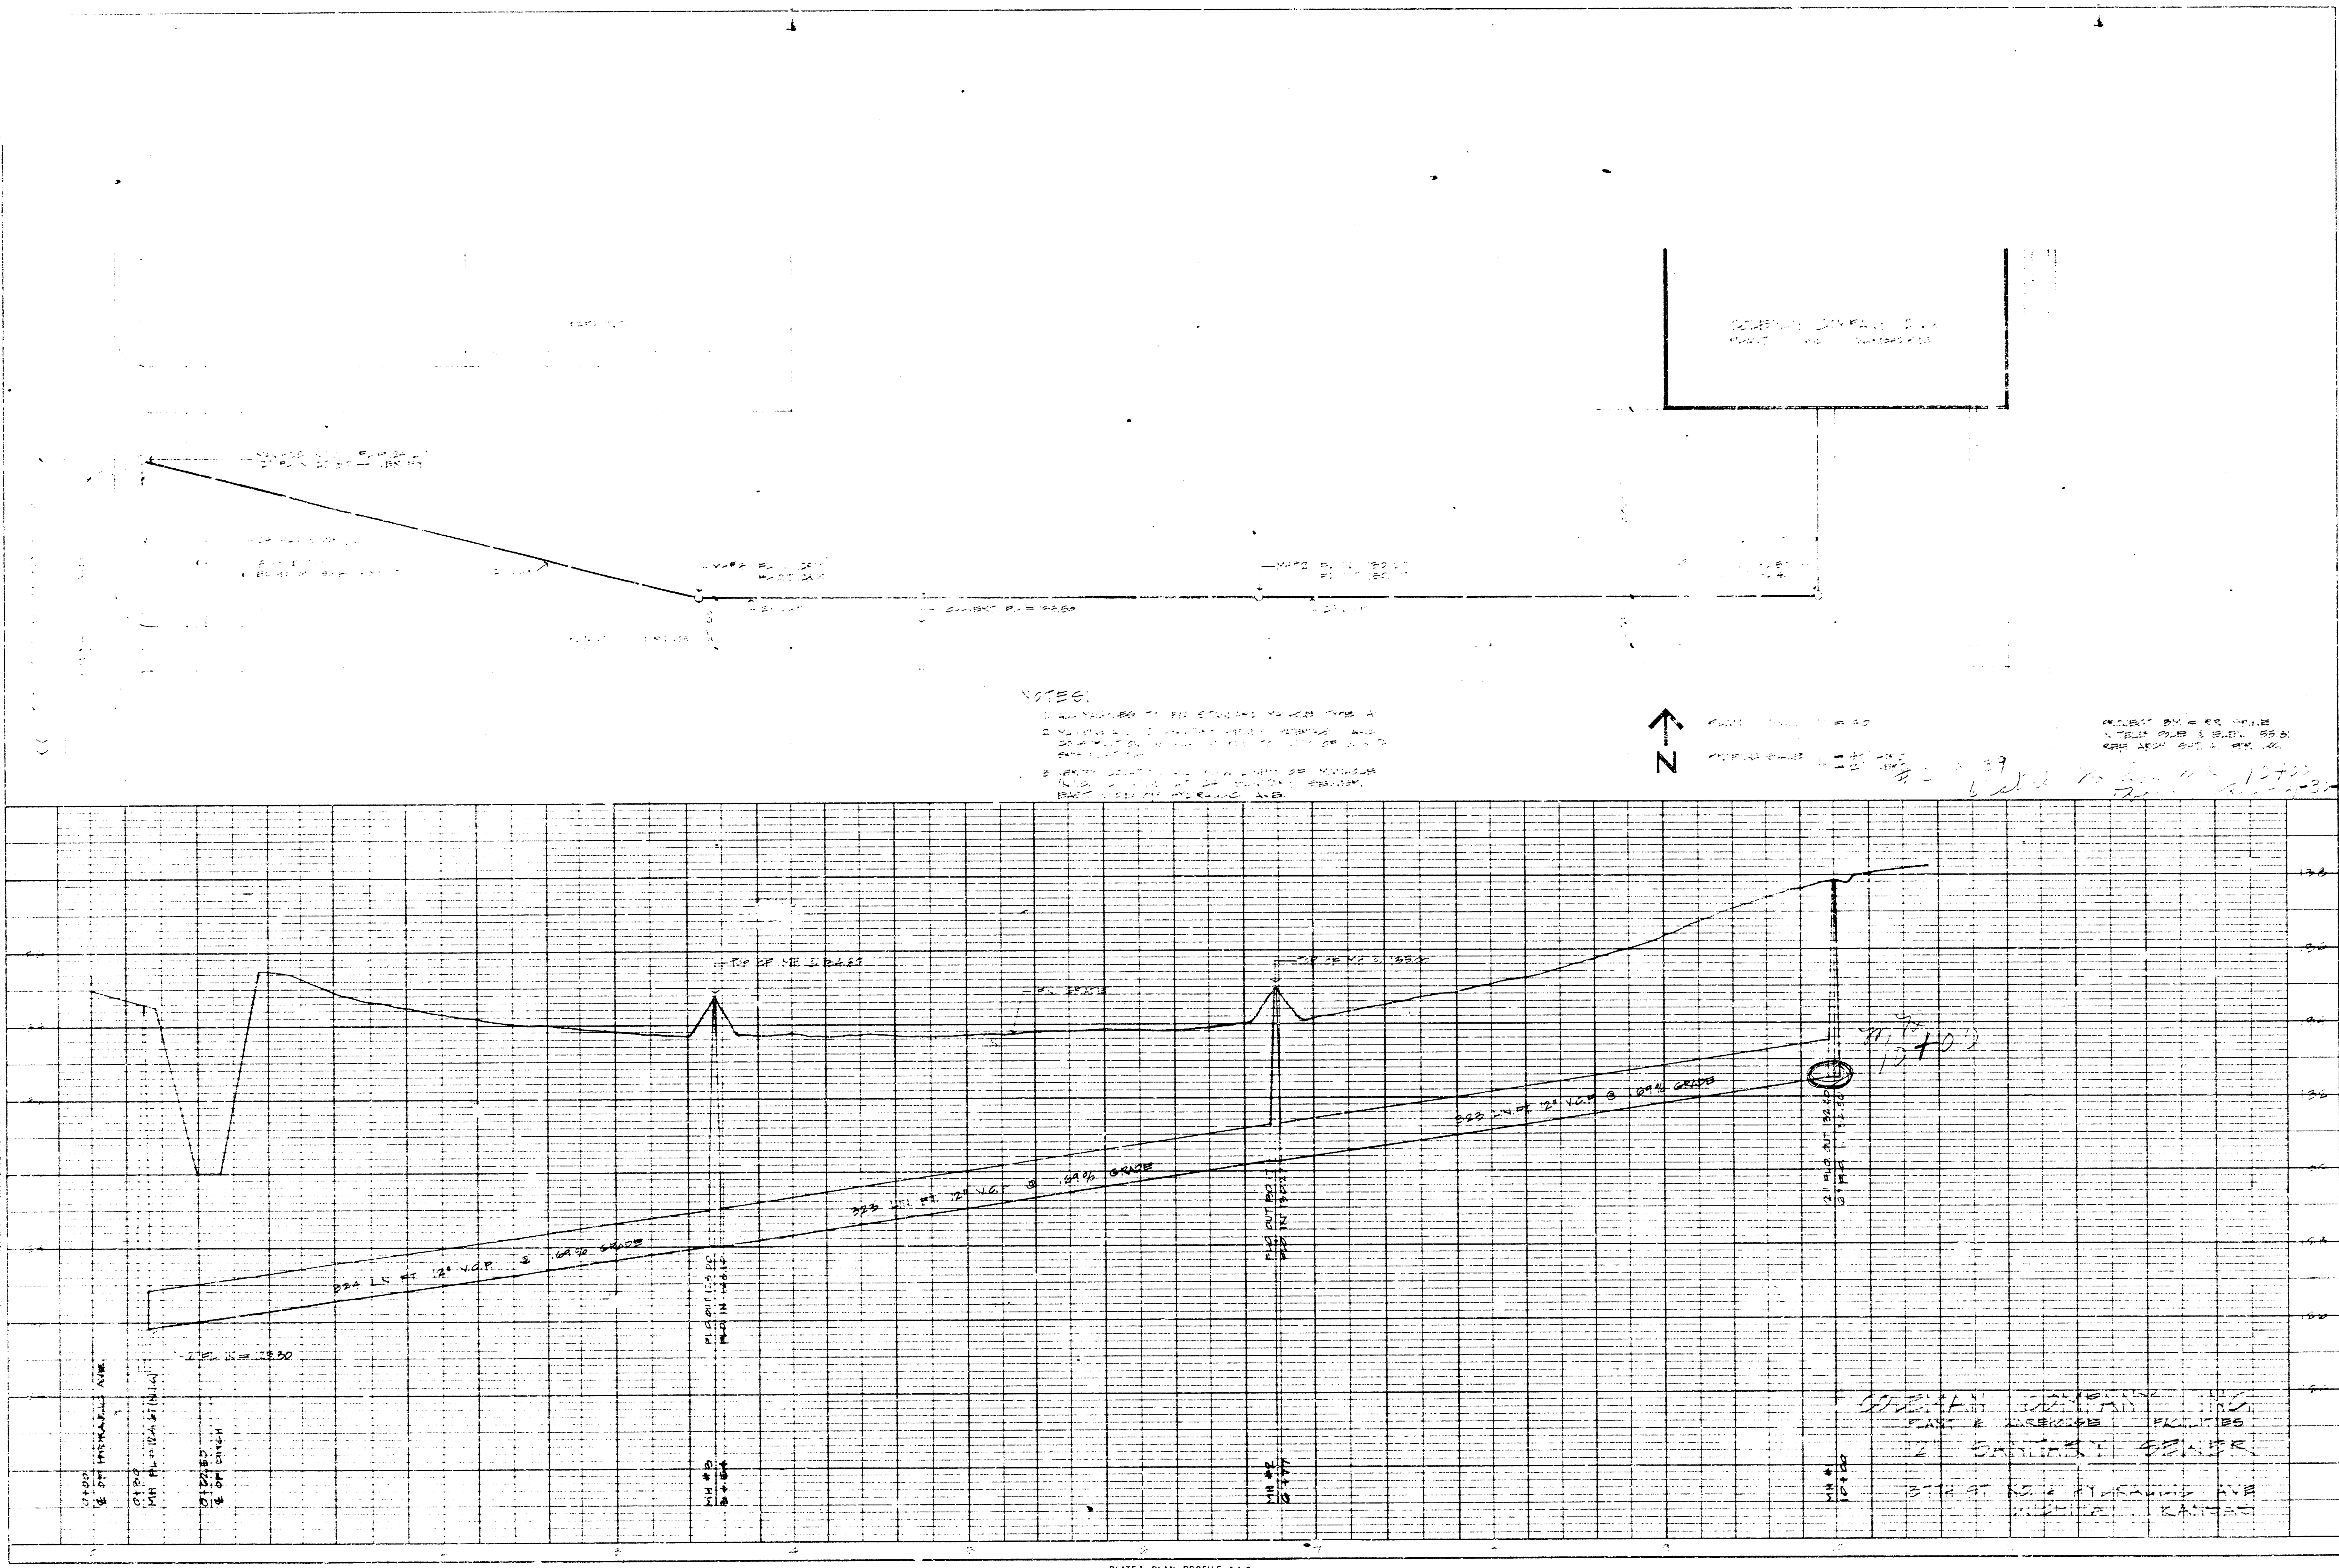

NOTES:








