





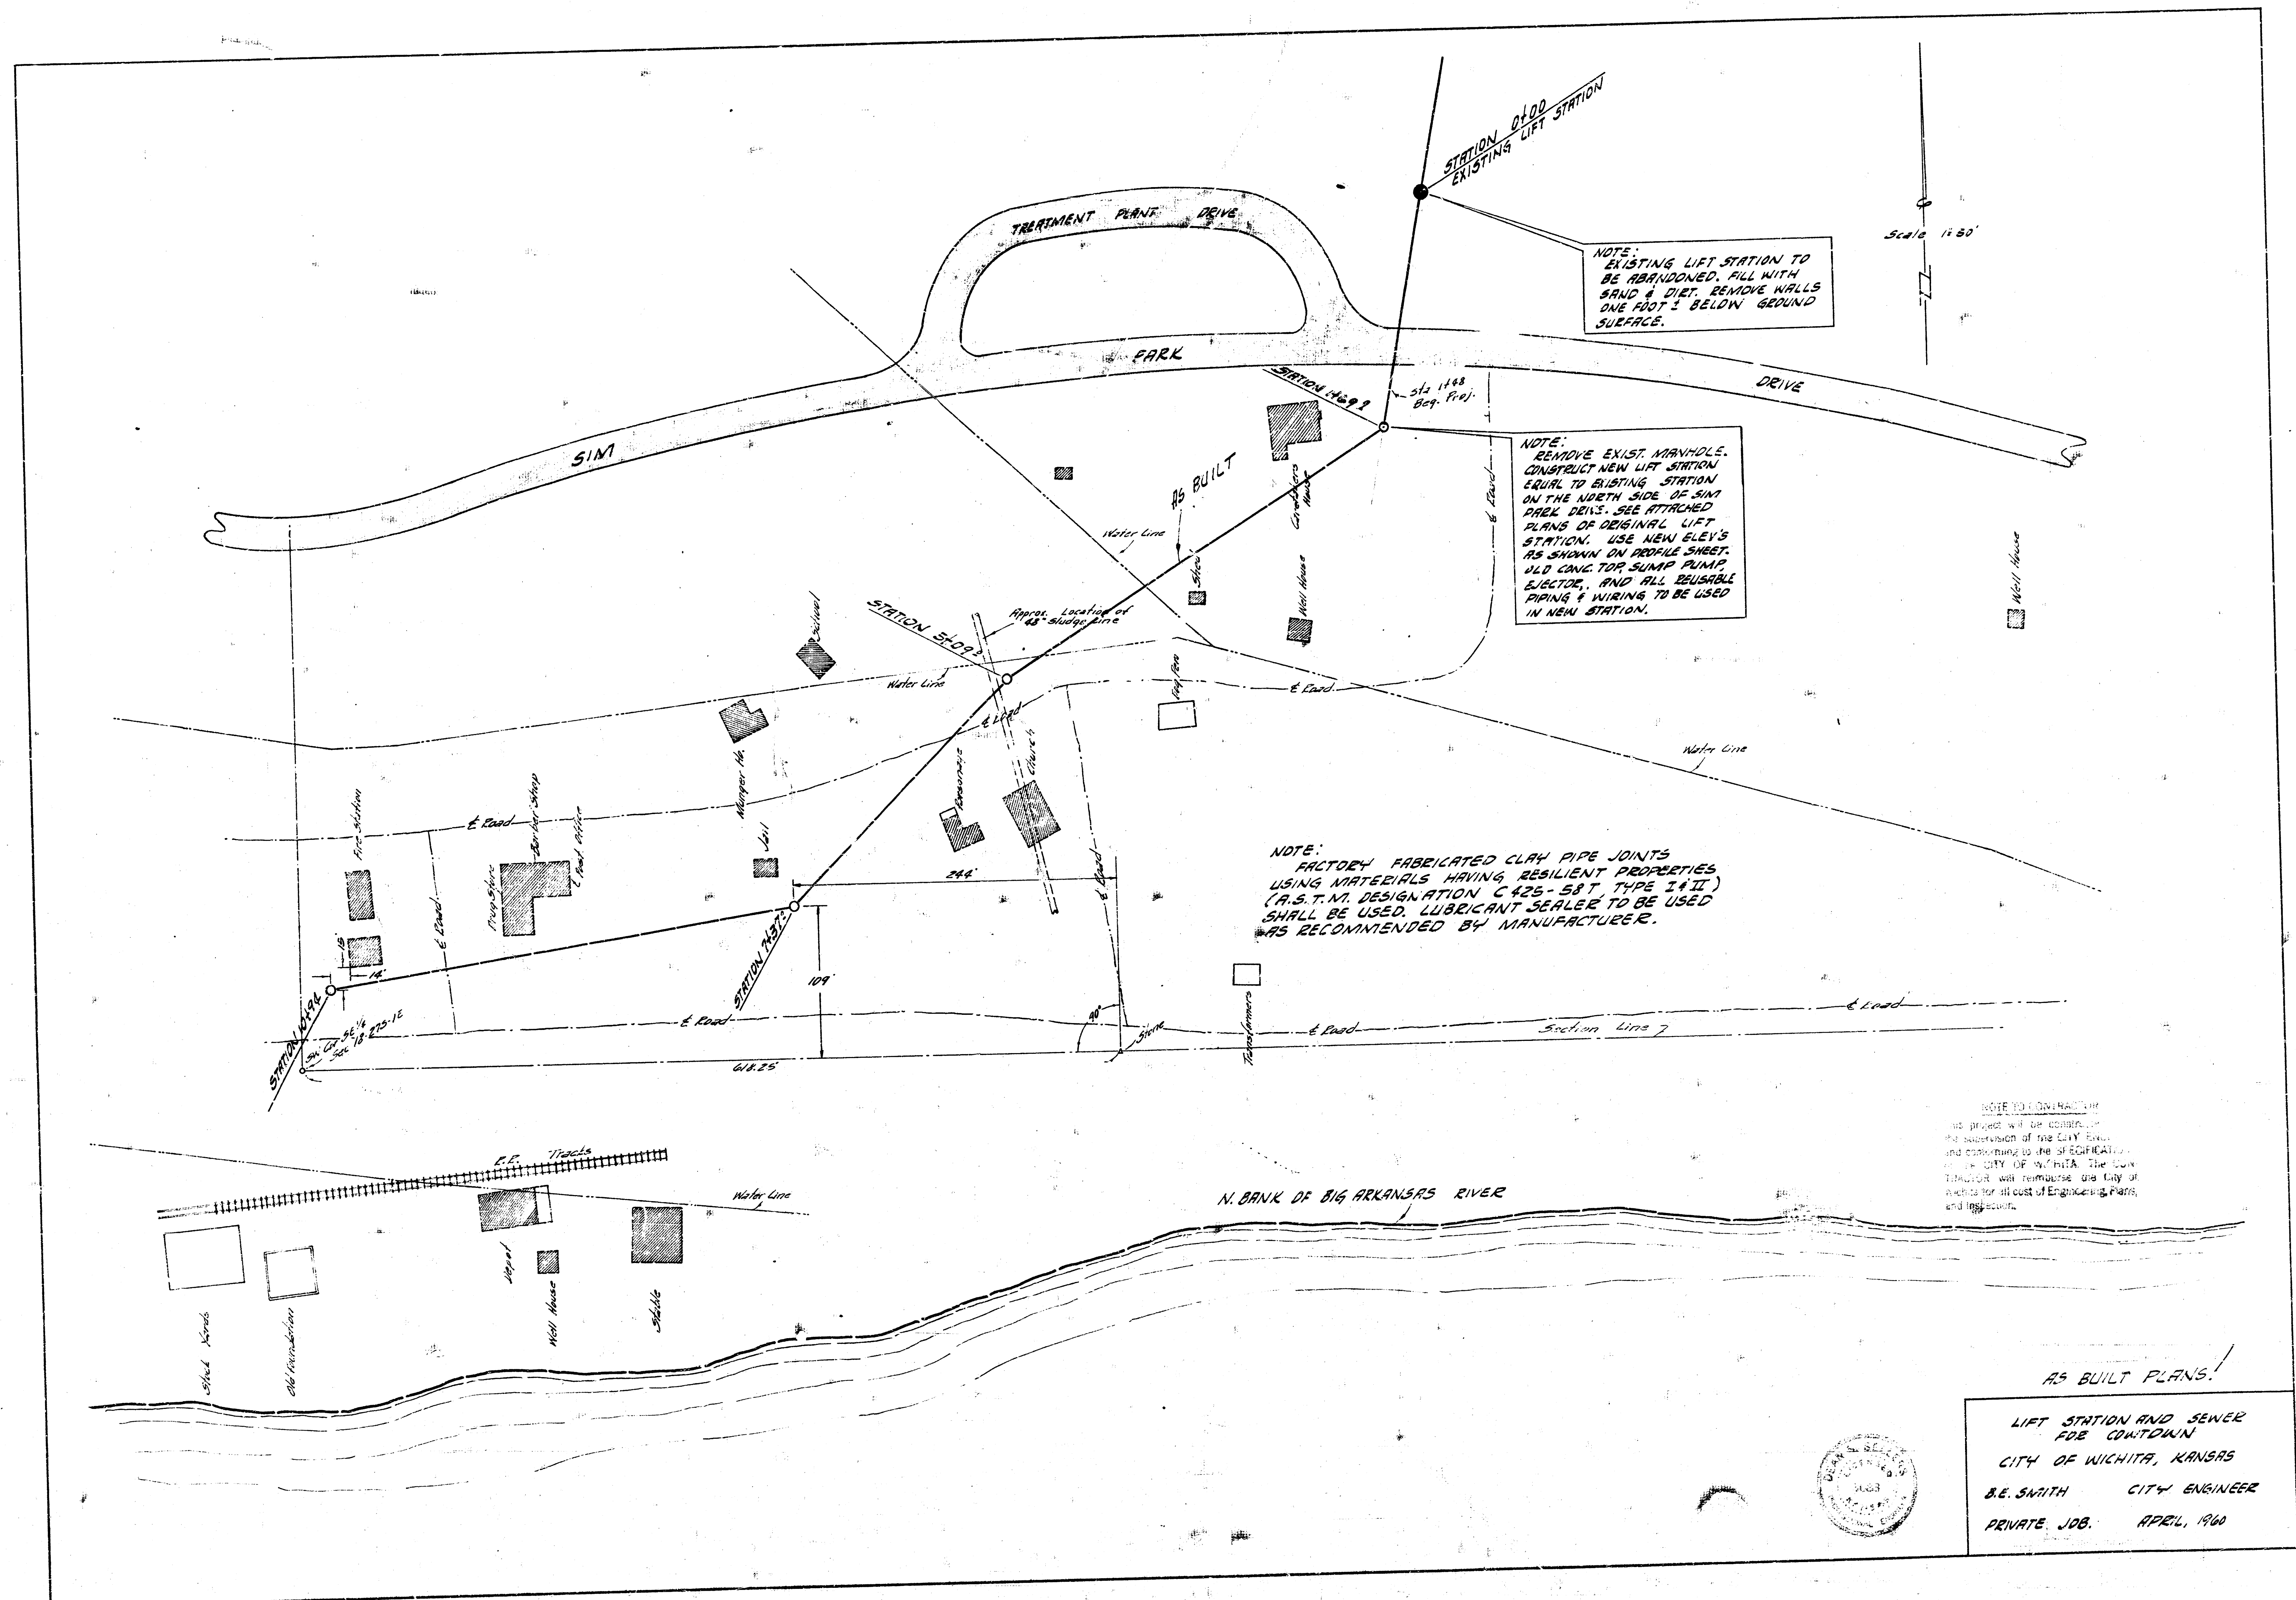

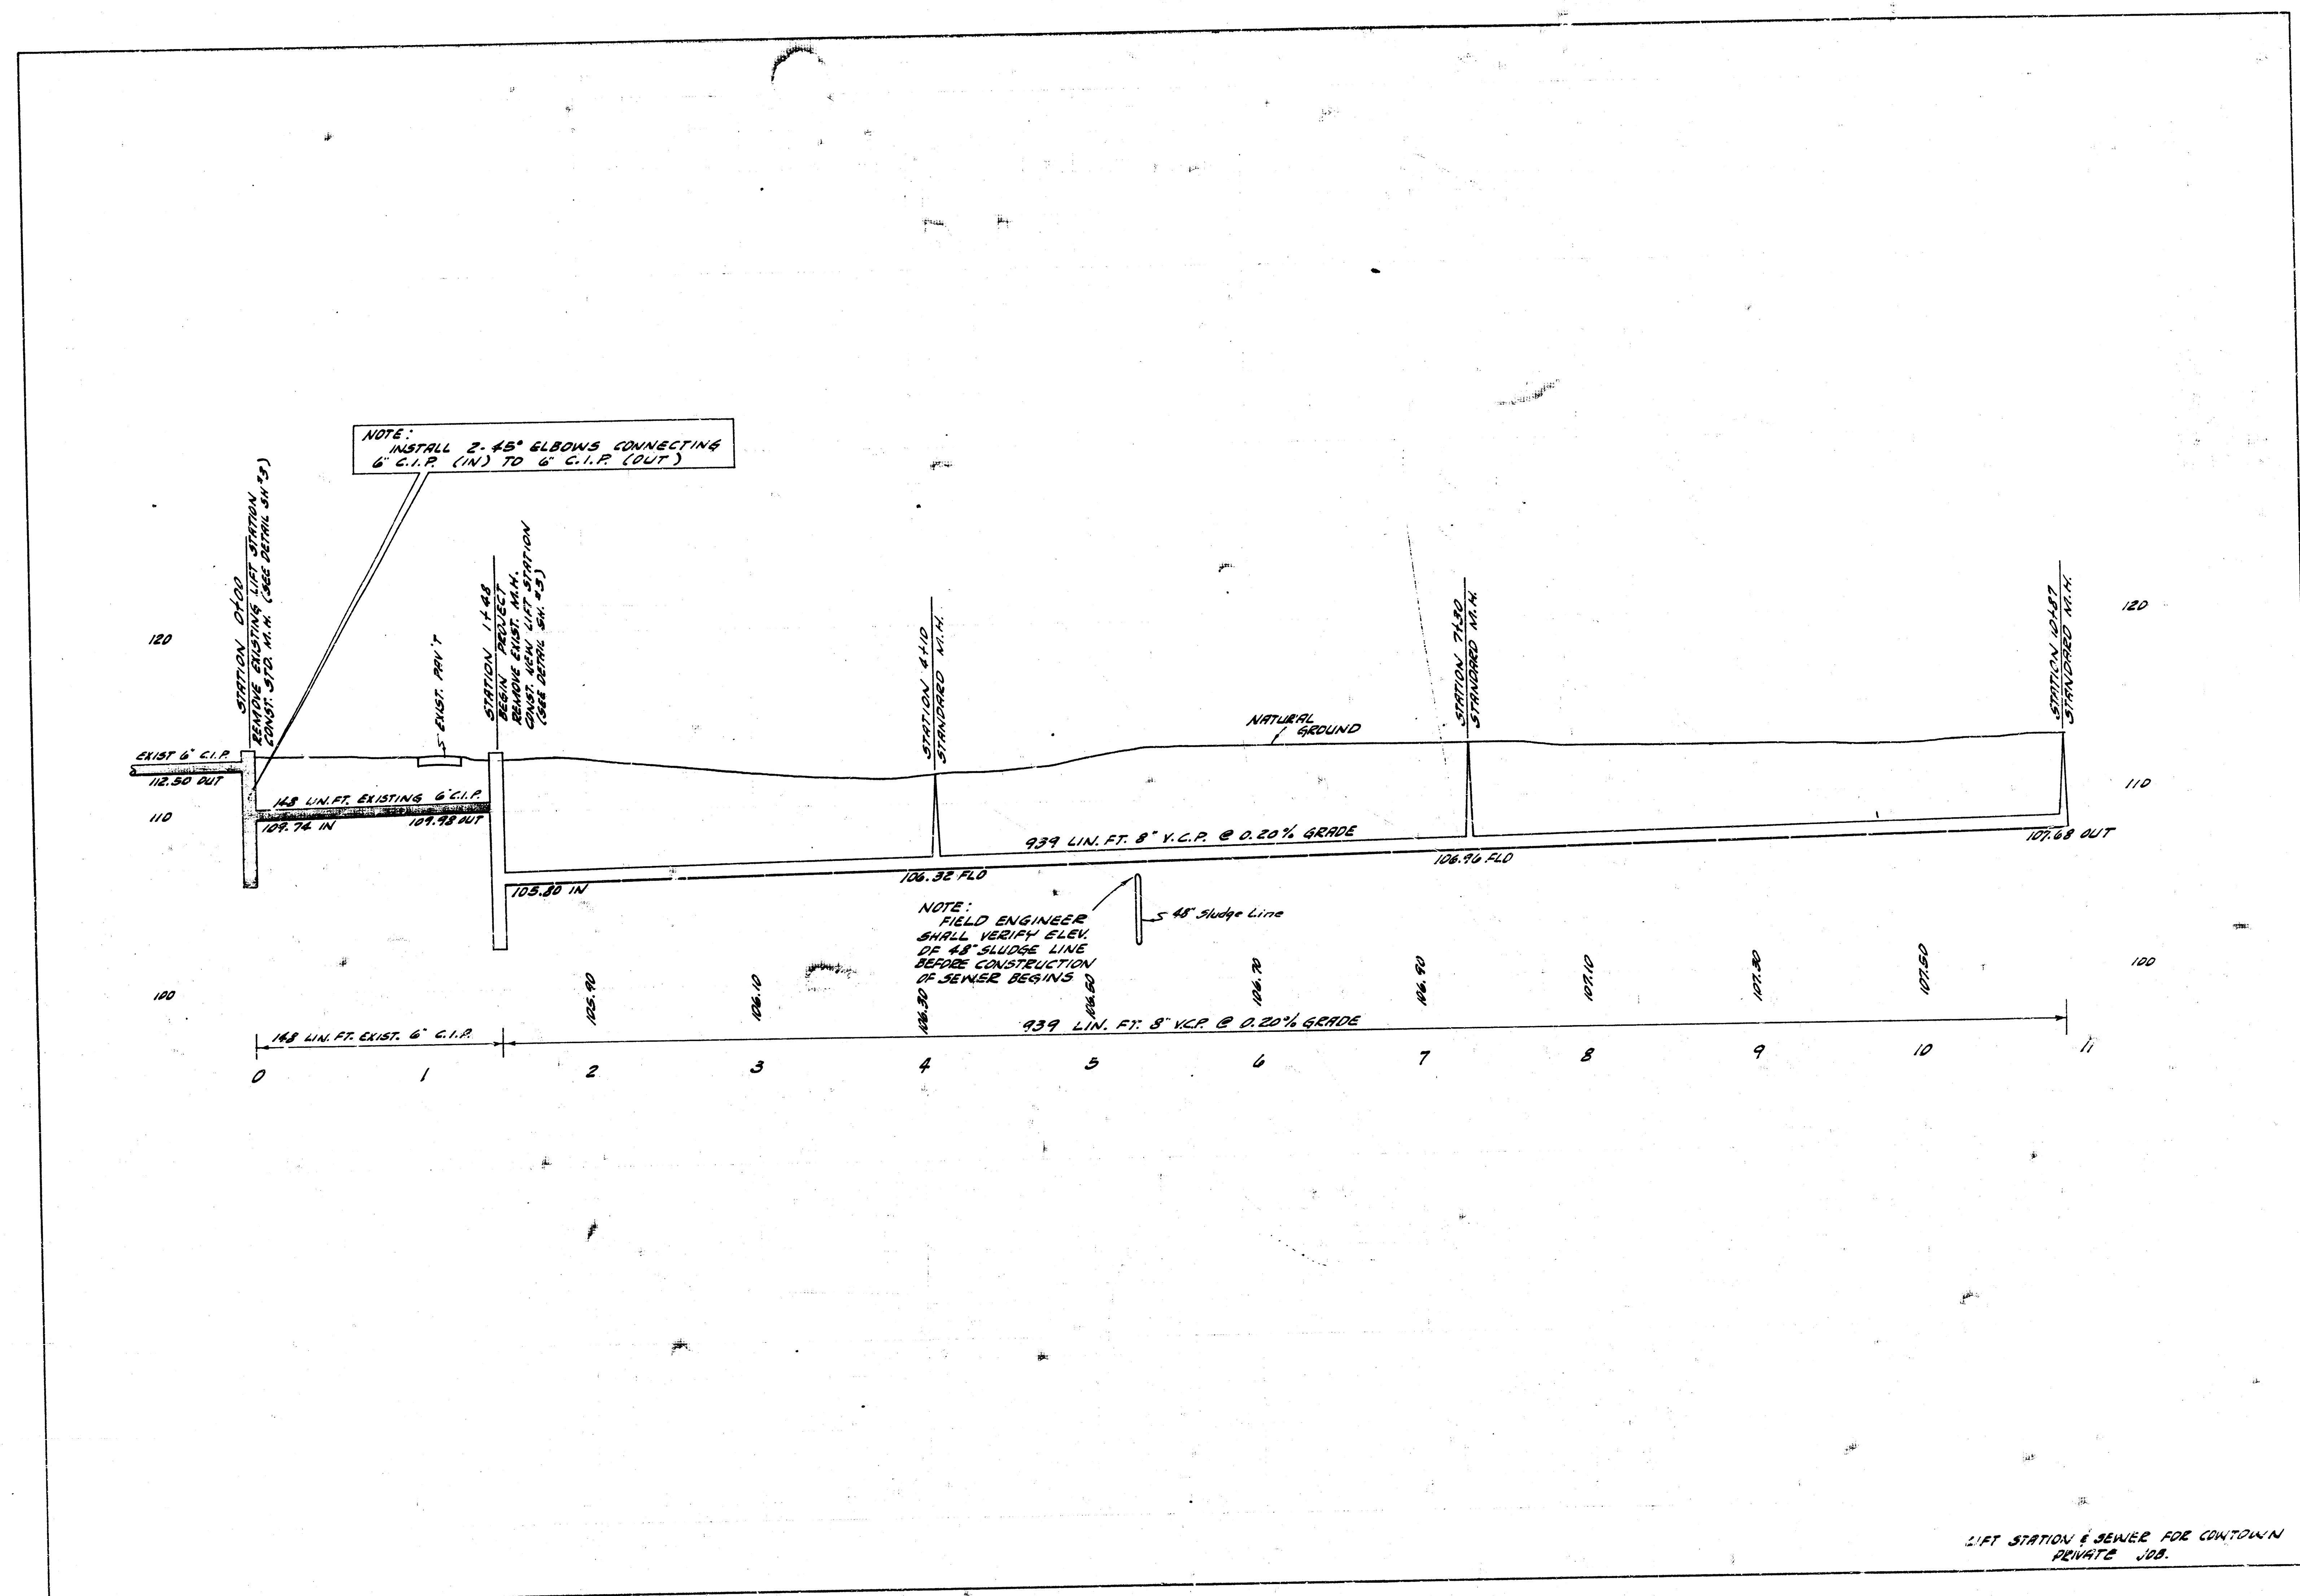


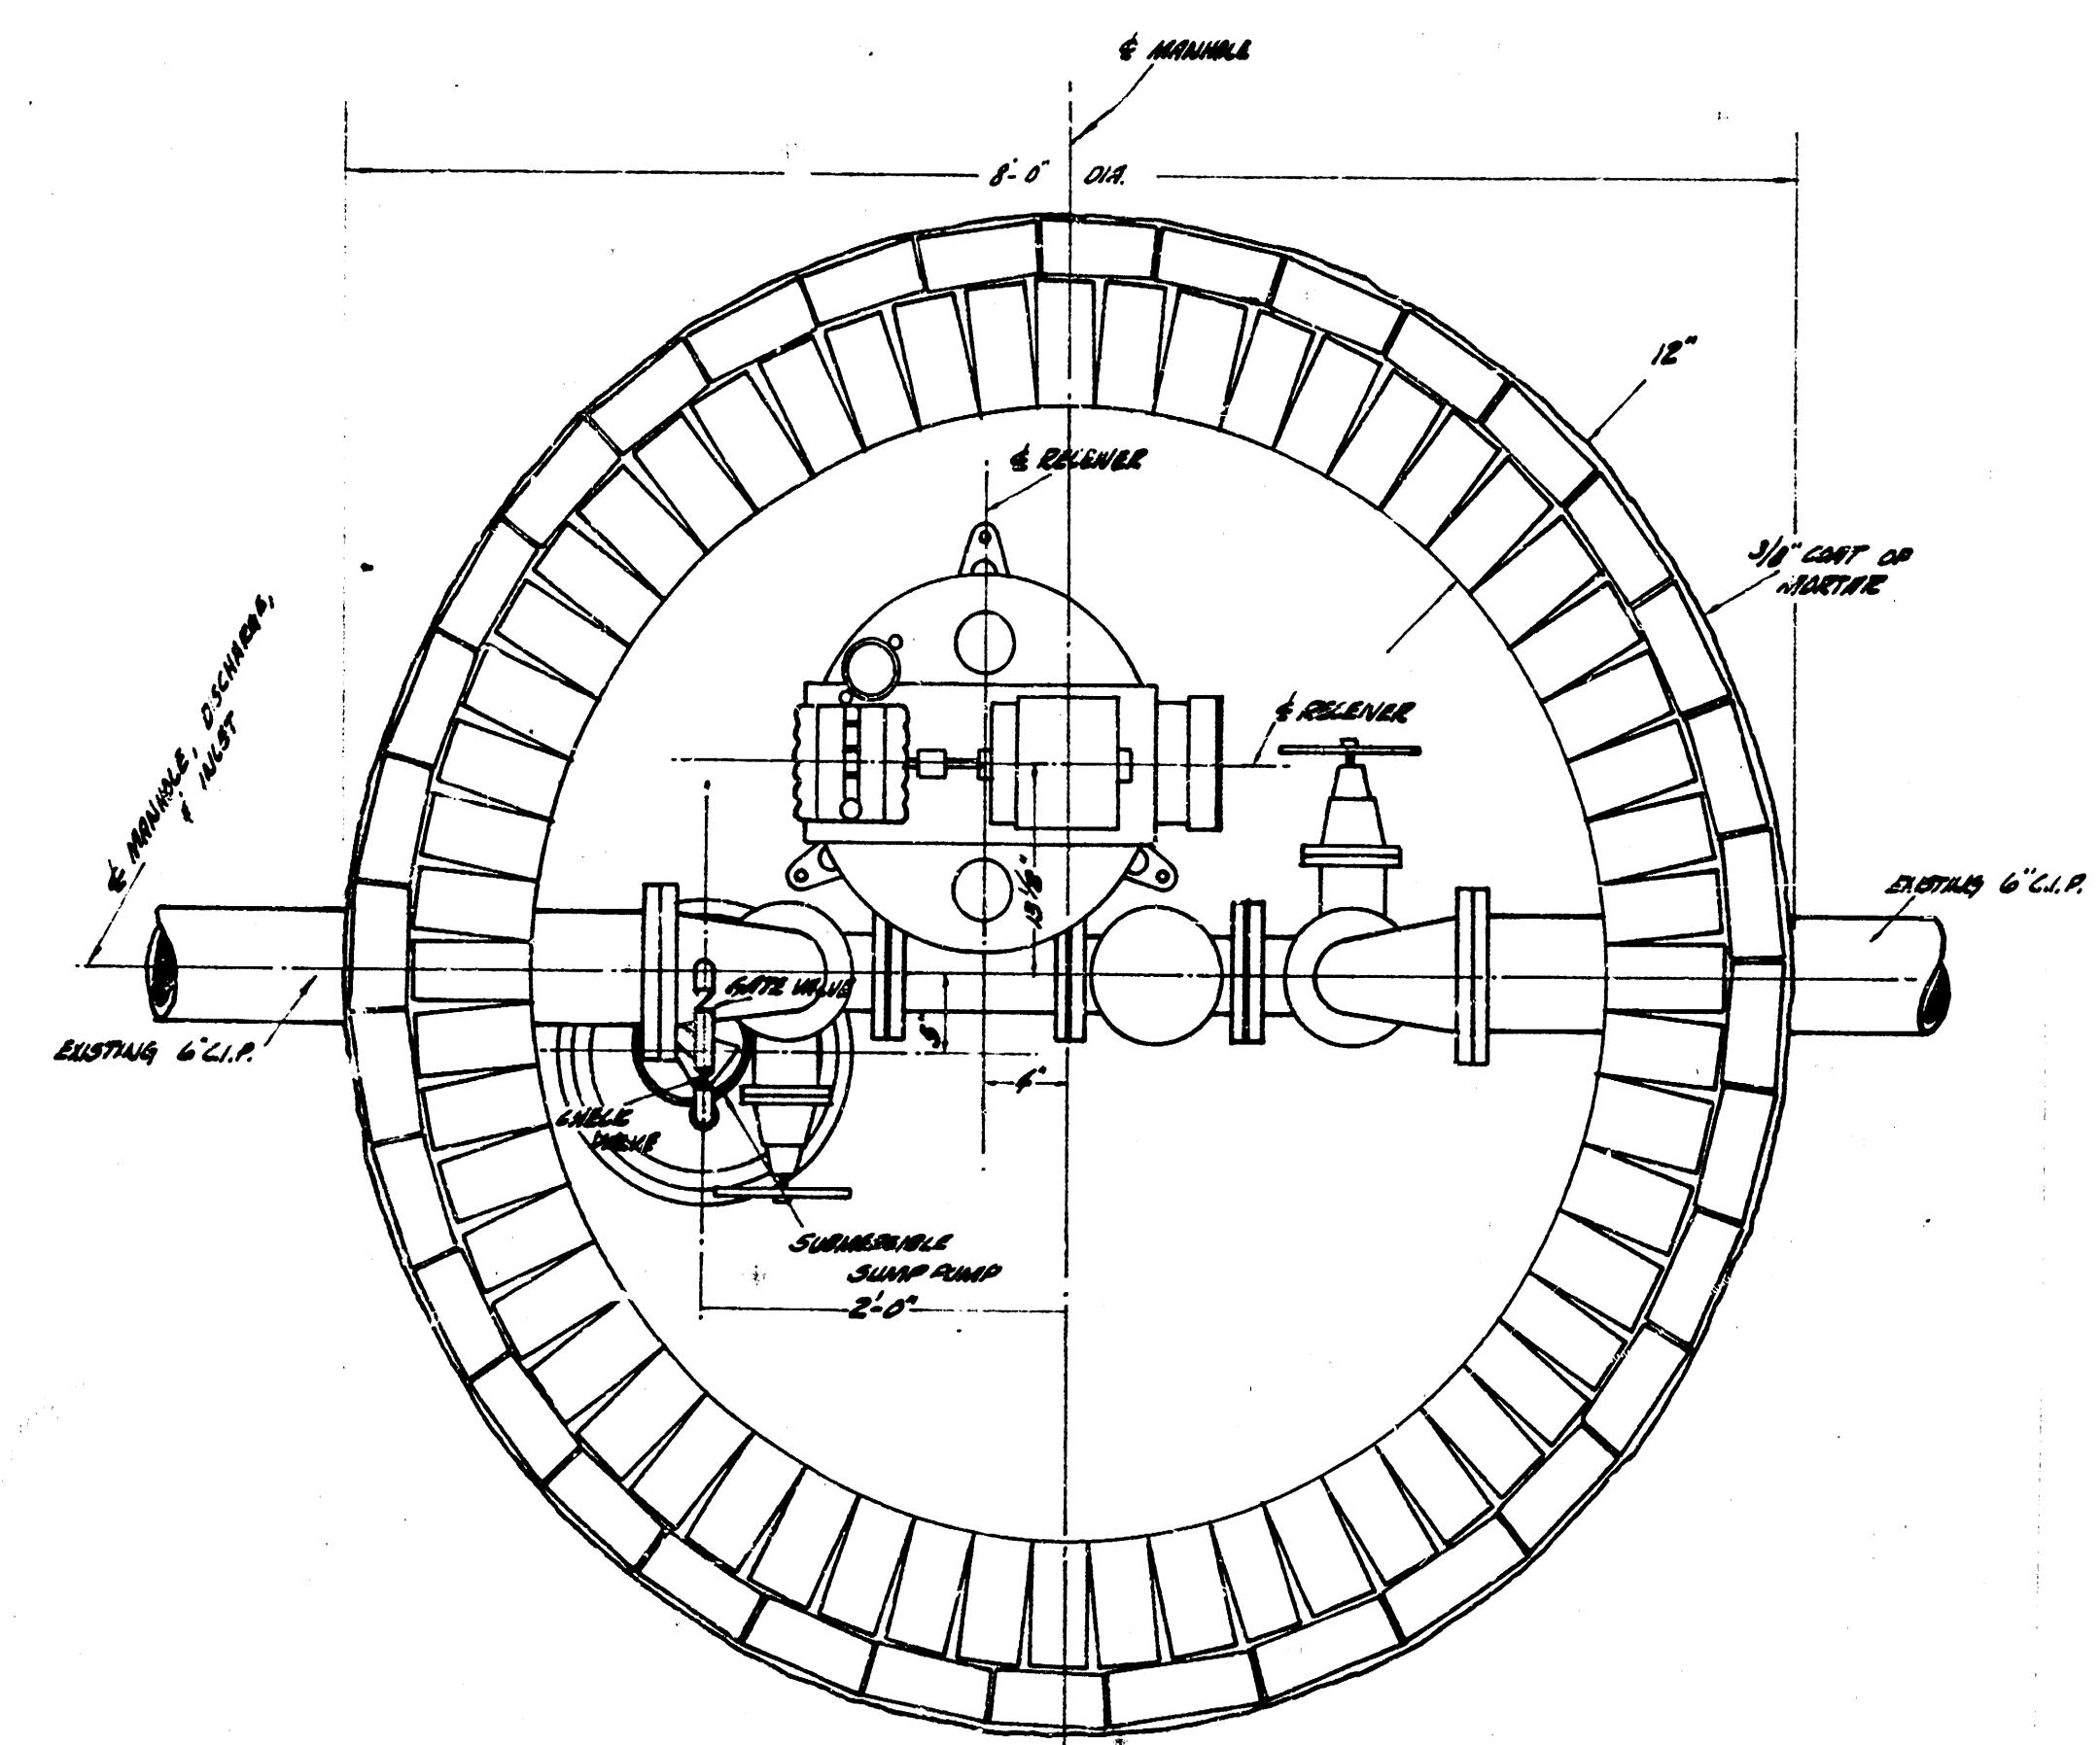


SECTIONAL PLAN
SCALE 1/2"

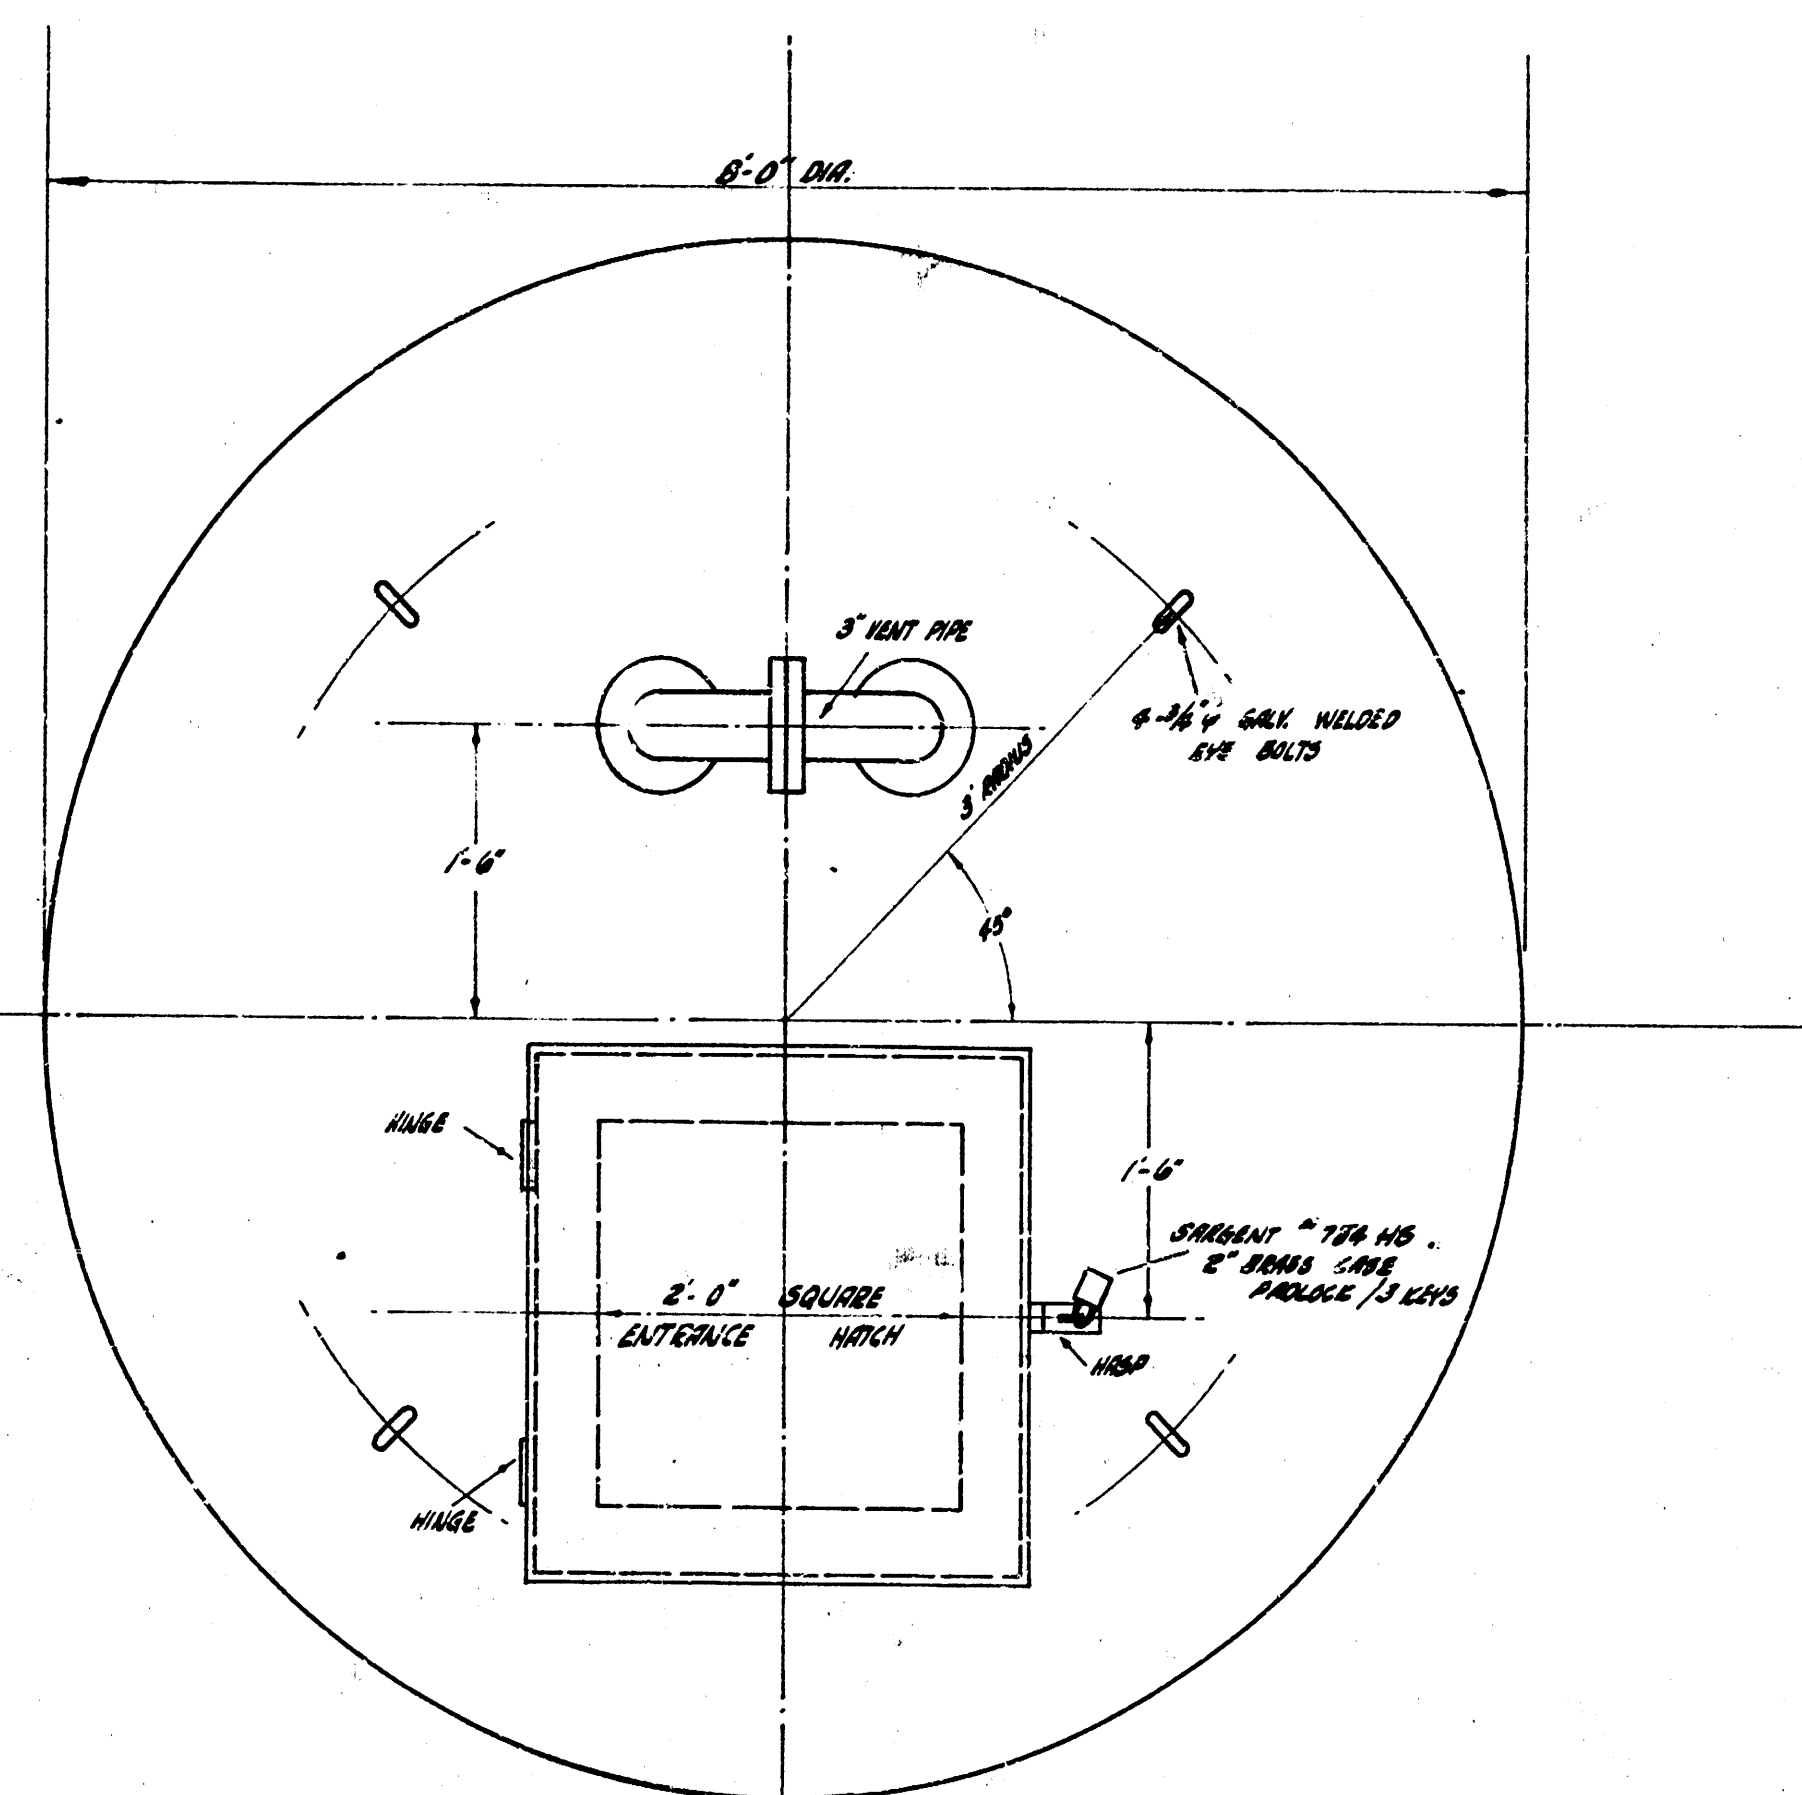


TOP
SCALE 1/2"

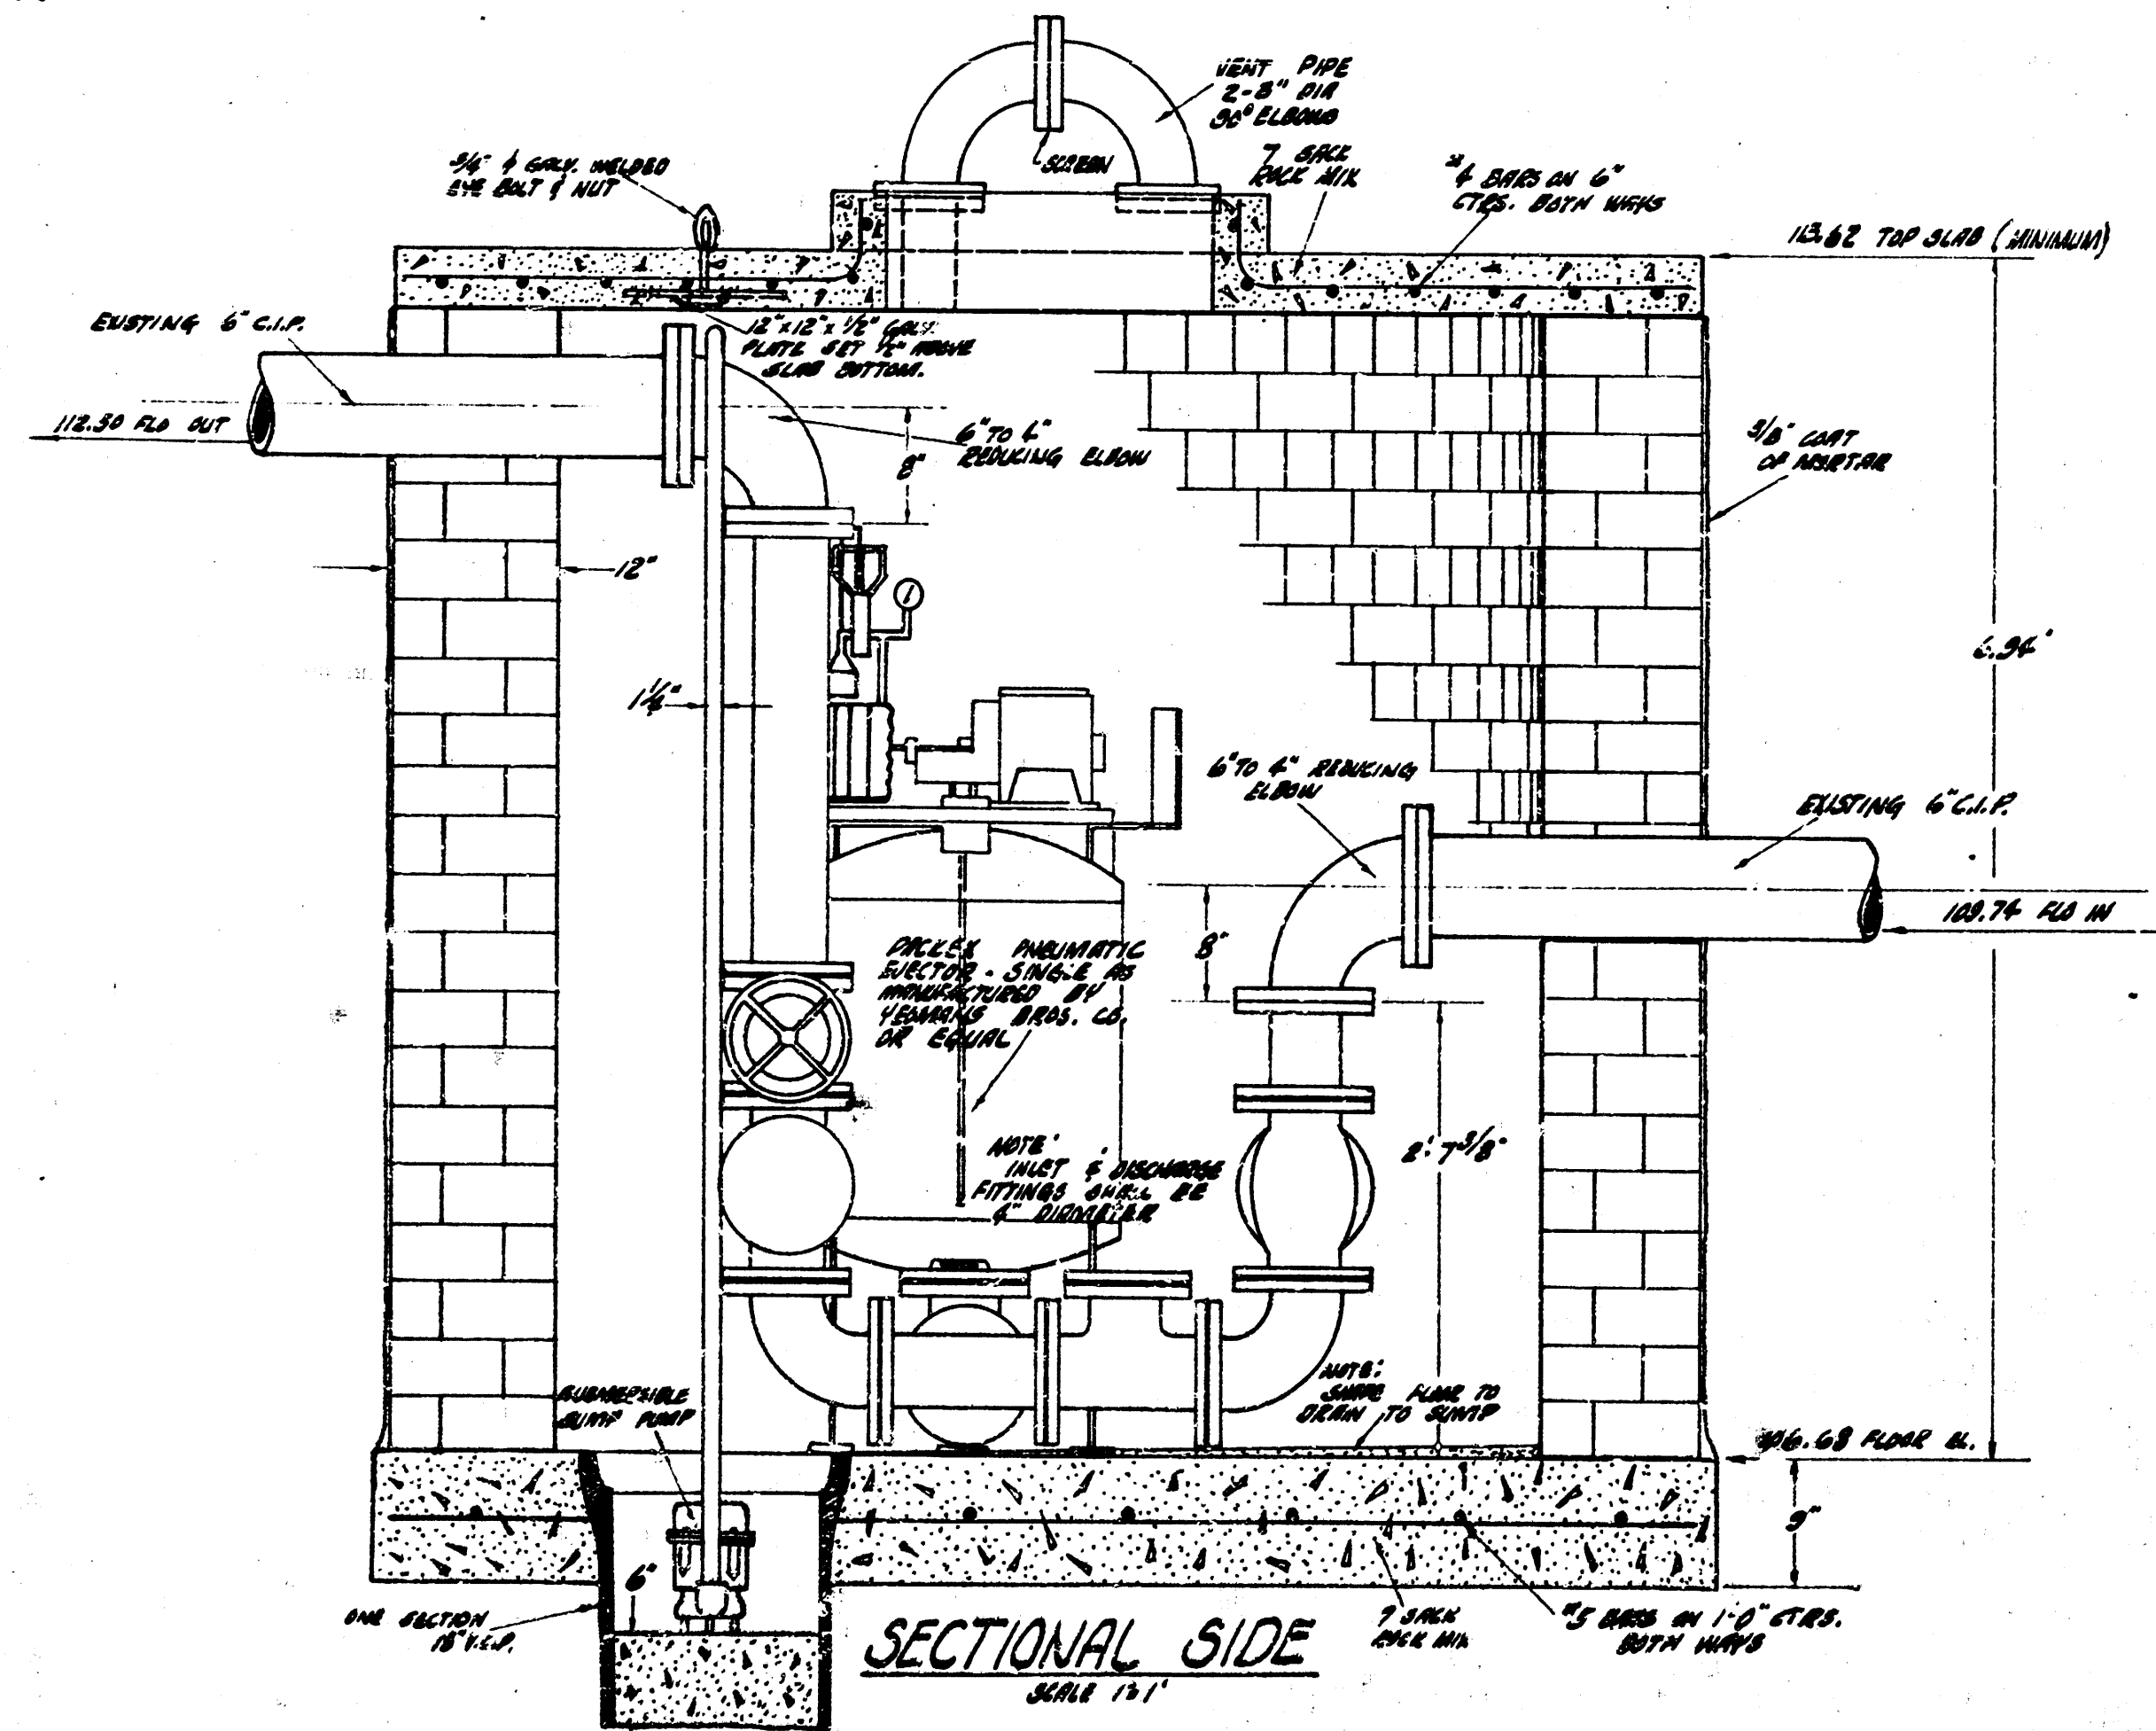

SECTIONAL SIDE
SCALE 1/2"

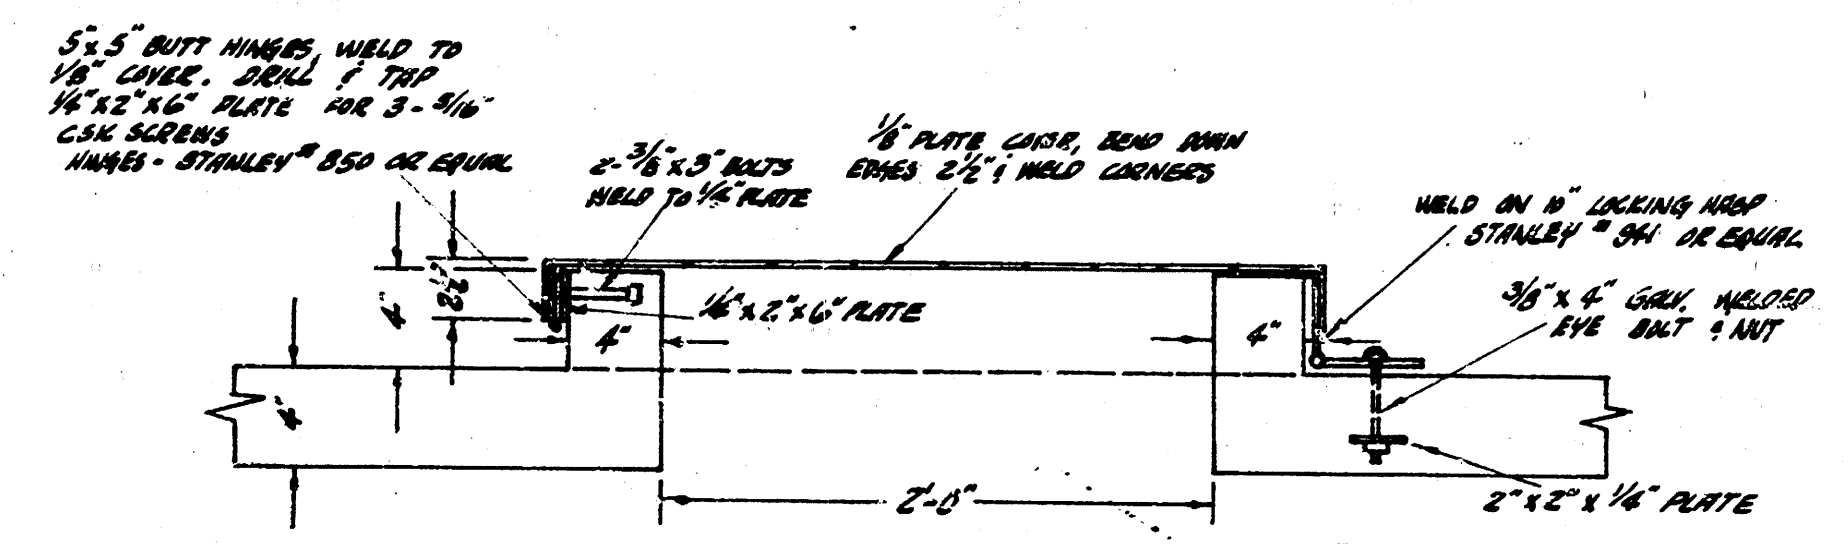


HATCH WAY
SCALE 1/2"

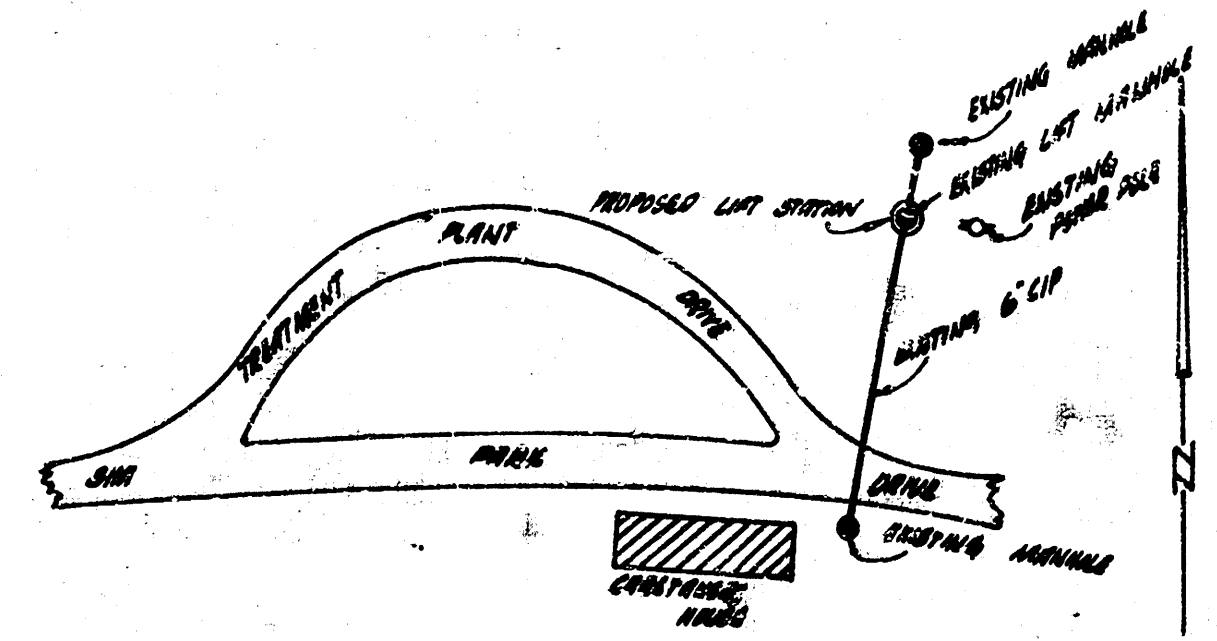



LOCATION MAP
1/4\"/>



LIFT STATION FOR COWTOWN SEWER
CITY OF WICHITA, KANSAS
B.E. SMITH CITY ENGINEER

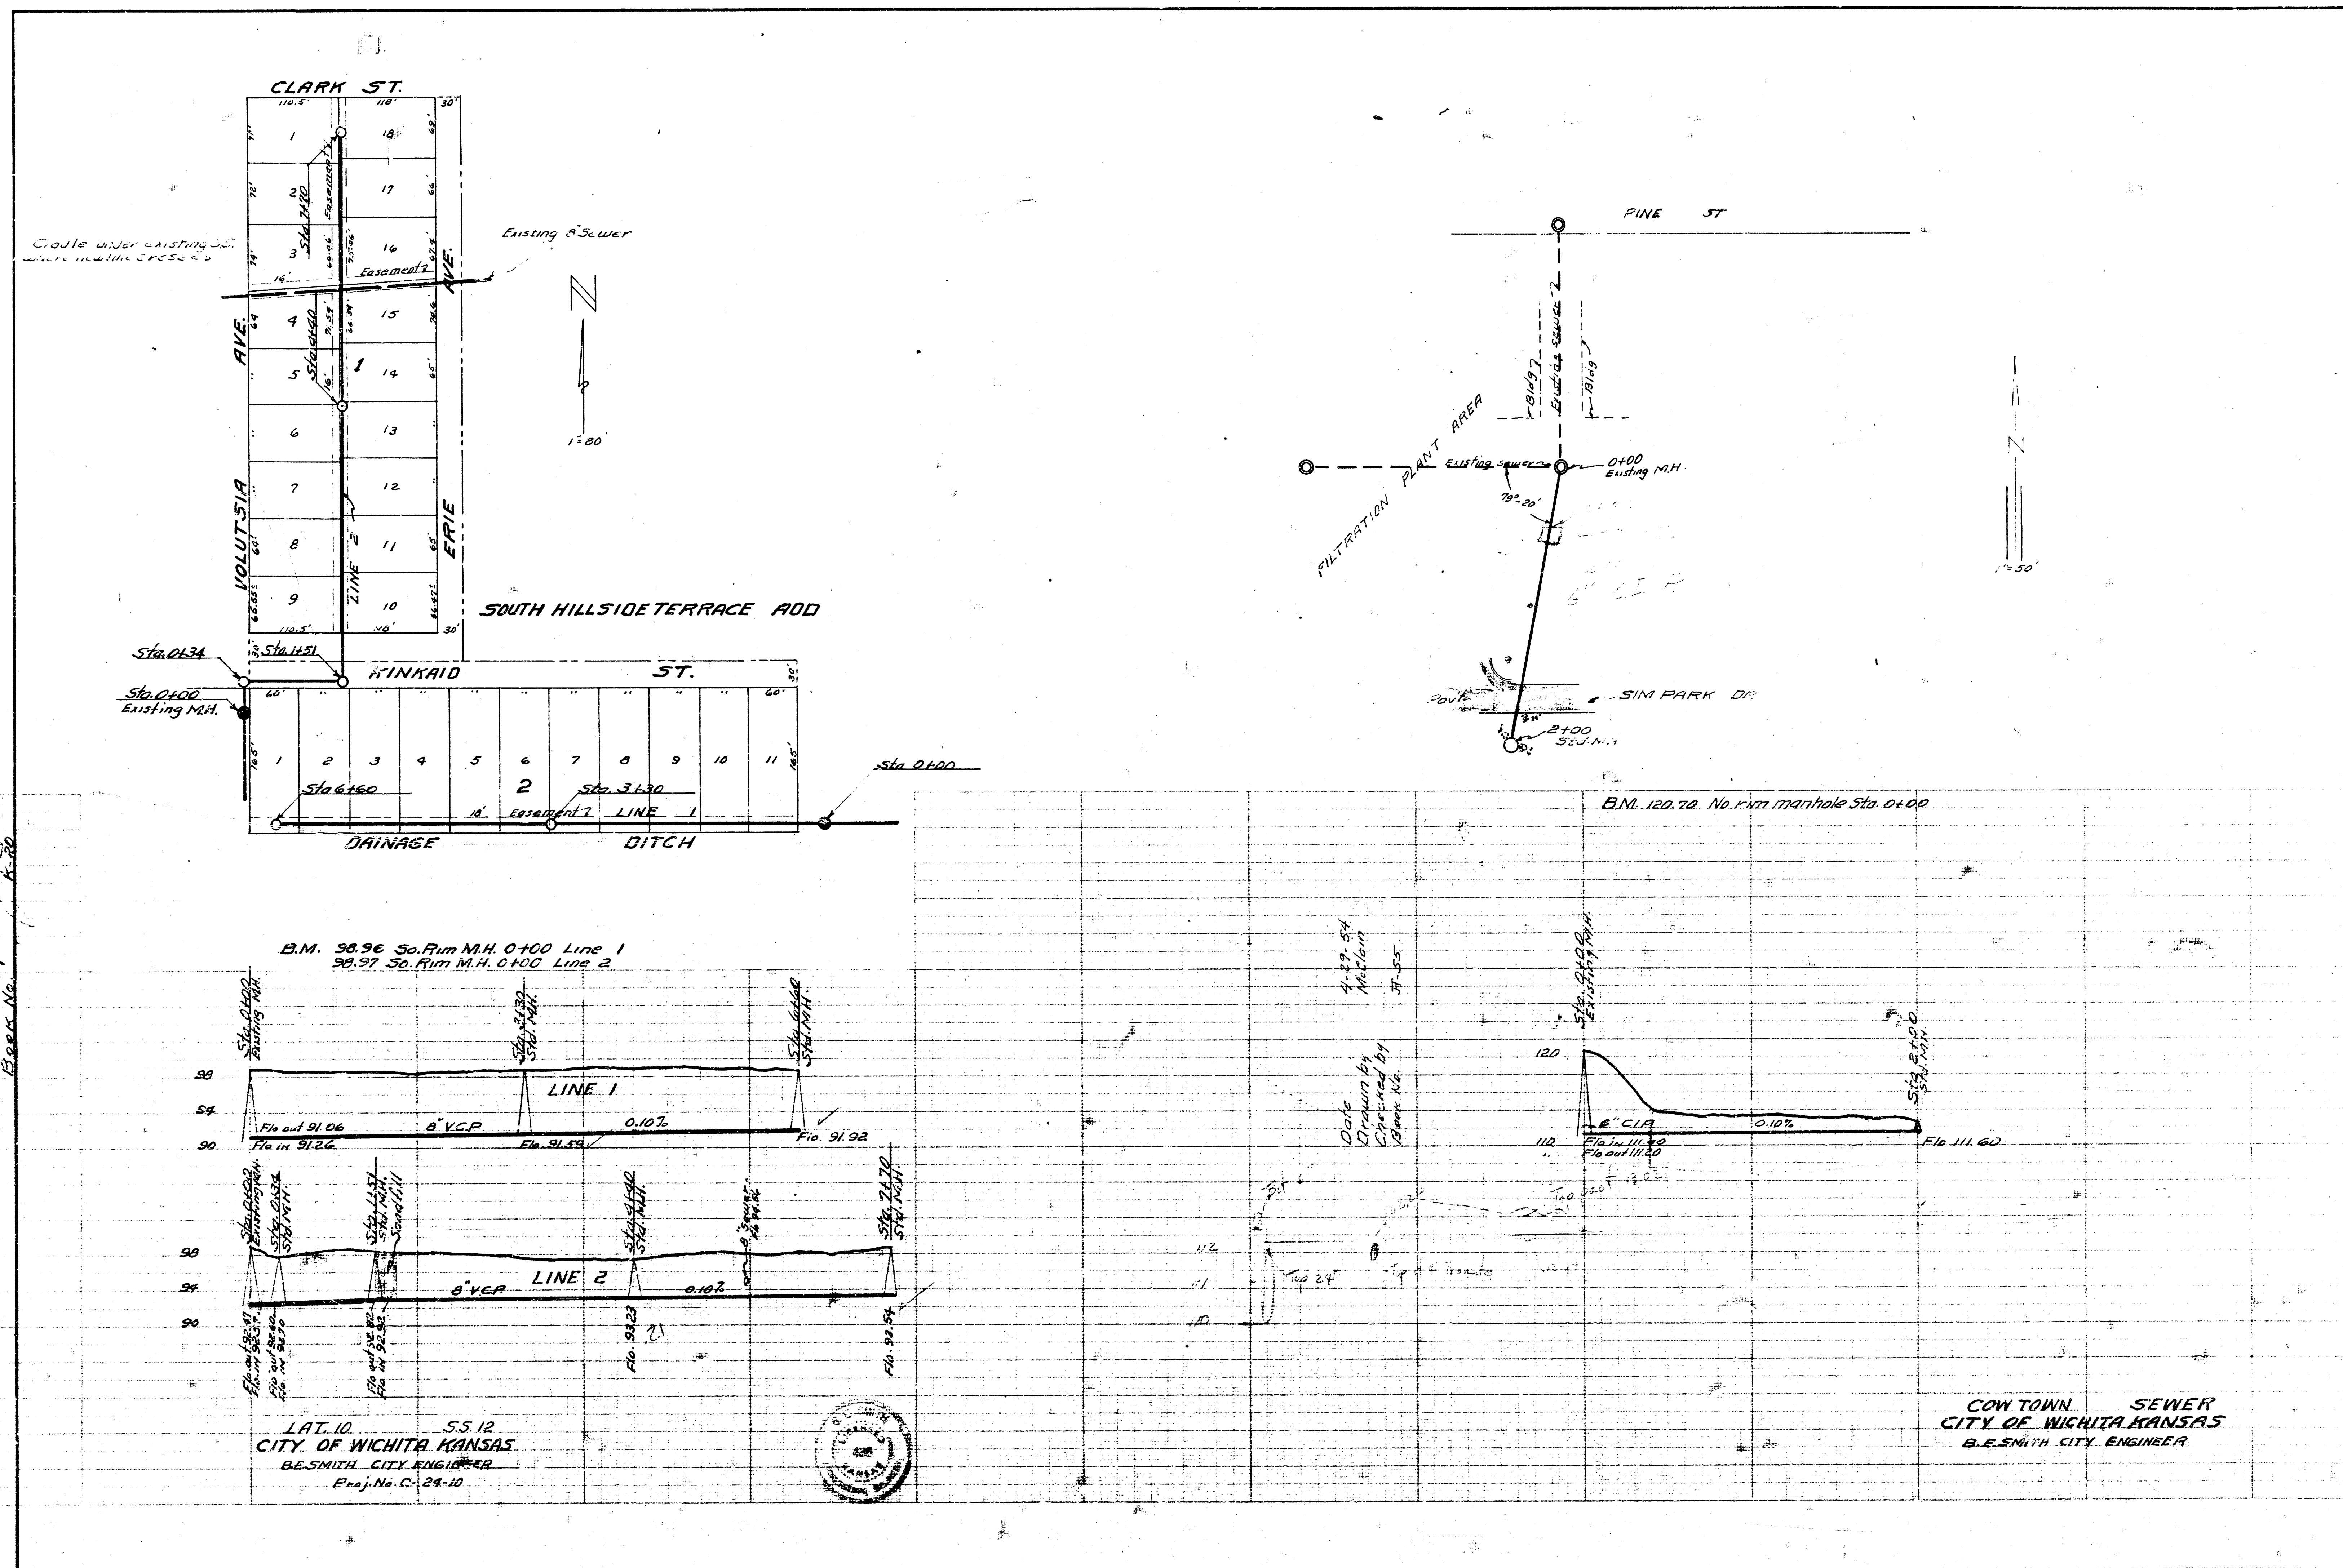

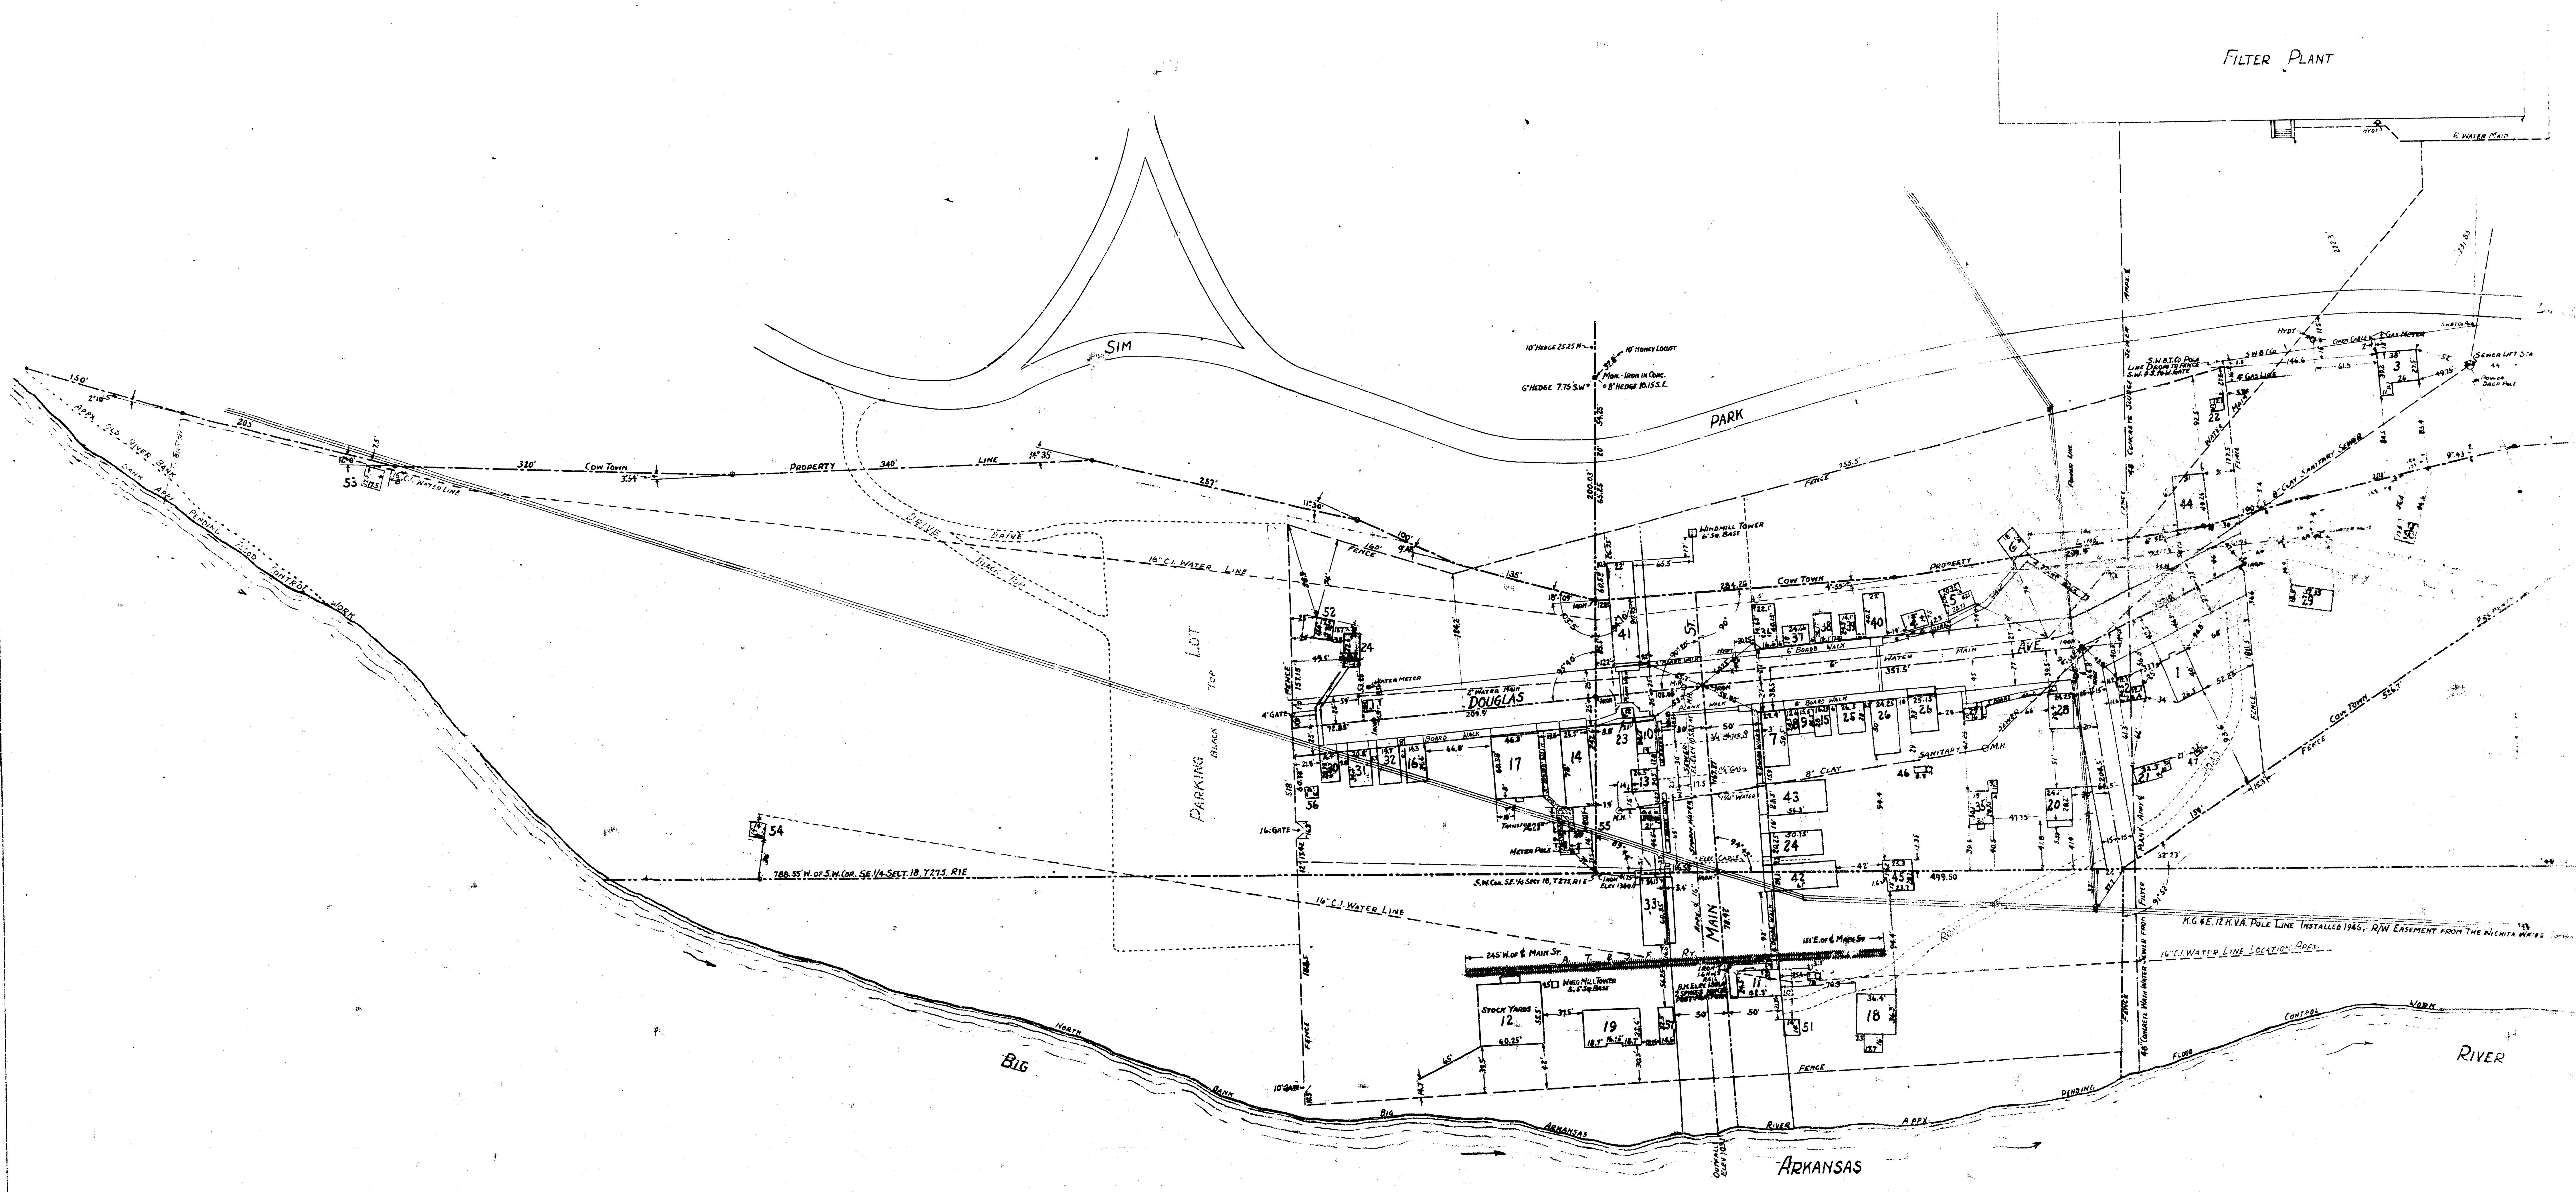

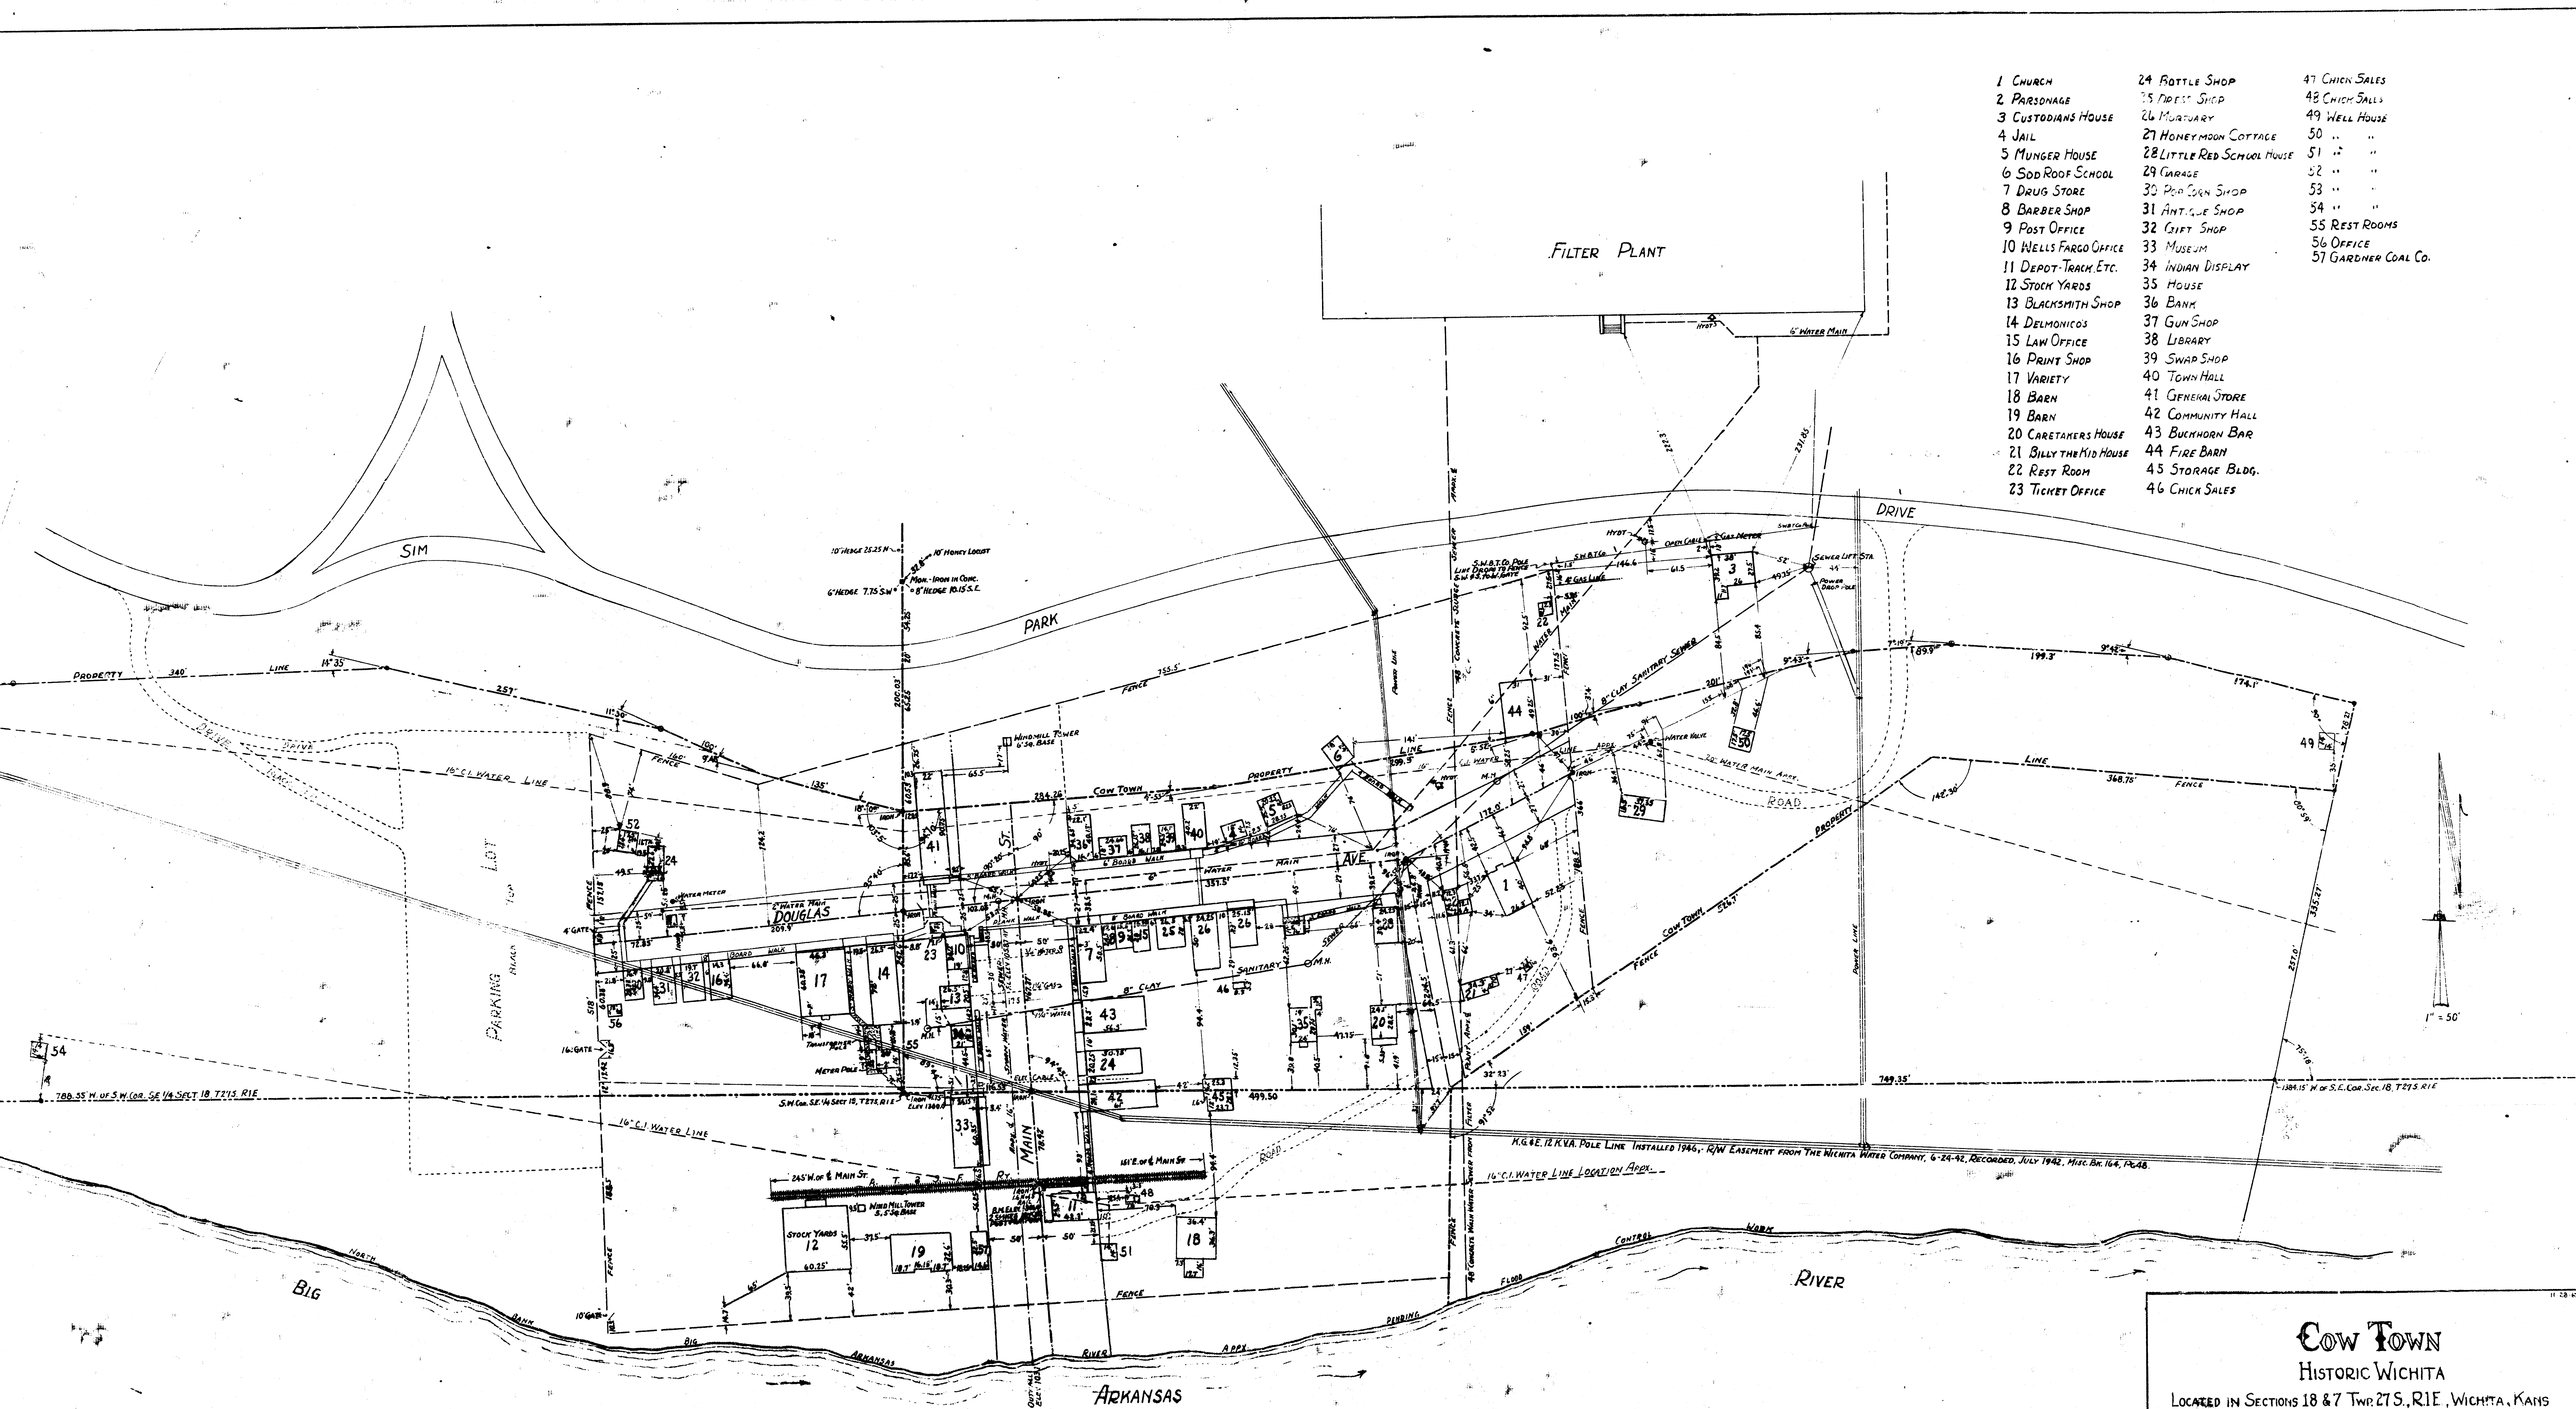

- | | | |
|------------------------|----------------------------|---------------------|
| 1 CHURCH | 24 BOTTLE SHOP | 47 CHICK SALES |
| 2 PARSONAGE | 25 FINEST SHOP | 48 CHICK SALES |
| 3 CUSTODIANS HOUSE | 26 MORTUARY | 49 WELL HOUSE |
| 4 JAIL | 27 HONEYMOON COTTAGE | 50 " " |
| 5 MUNGER HOUSE | 28 LITTLE RED SCHOOL HOUSE | 51 " " |
| 6 SOD ROOF SCHOOL | 29 GARAGE | 52 " " |
| 7 DRUG STORE | 30 PRO CEN SHOP | 53 " " |
| 8 BARBER SHOP | 31 ANT. & C. SHOP | 54 " " |
| 9 POST OFFICE | 32 GIFT SHOP | 55 REST ROOMS |
| 10 WELLS FARGO OFFICE | 33 MUSEUM | 56 OFFICE |
| 11 DEPOT-TRUCK ETC. | 34 INDIAN DISPLAY | 57 GARDNER COAL CO. |
| 12 STOCK YARDS | 35 HOUSE | |
| 13 BLACKSMITH SHOP | 36 BANK | |
| 14 DELMONICOS | 37 GUN SHOP | |
| 15 LAW OFFICE | 38 LIBRARY | |
| 16 PRINT SHOP | 39 SWAP SHOP | |
| 17 VARIETY | 40 TOWN HALL | |
| 18 BARN | 41 GENERAL STORE | |
| 19 BARN | 42 COMMUNITY HALL | |
| 20 CARETAKERS HOUSE | 43 BUCKHORN BAR | |
| 21 BILLY THE KID HOUSE | 44 FIRE BARN | |
| 22 REST ROOM | 45 STORAGE BLDG. | |
| 23 TICKET OFFICE | 46 CHICK SALES | |

COW TOWN
 HISTORIC WICHITA
 LOCATED IN SECTIONS 18 & 7 TWP 27S, R1E, WICHITA, KANS.

