


WYE BRANCH MAP OF THE
SEWER DISTRIBUTION SYSTEM
FOR
EASTBOROUGH ESTATES

SCALE 1"=100'


DON C. MOEHRING
CONSULTING CIVIL ENGINEER
WICHITA, KANSAS

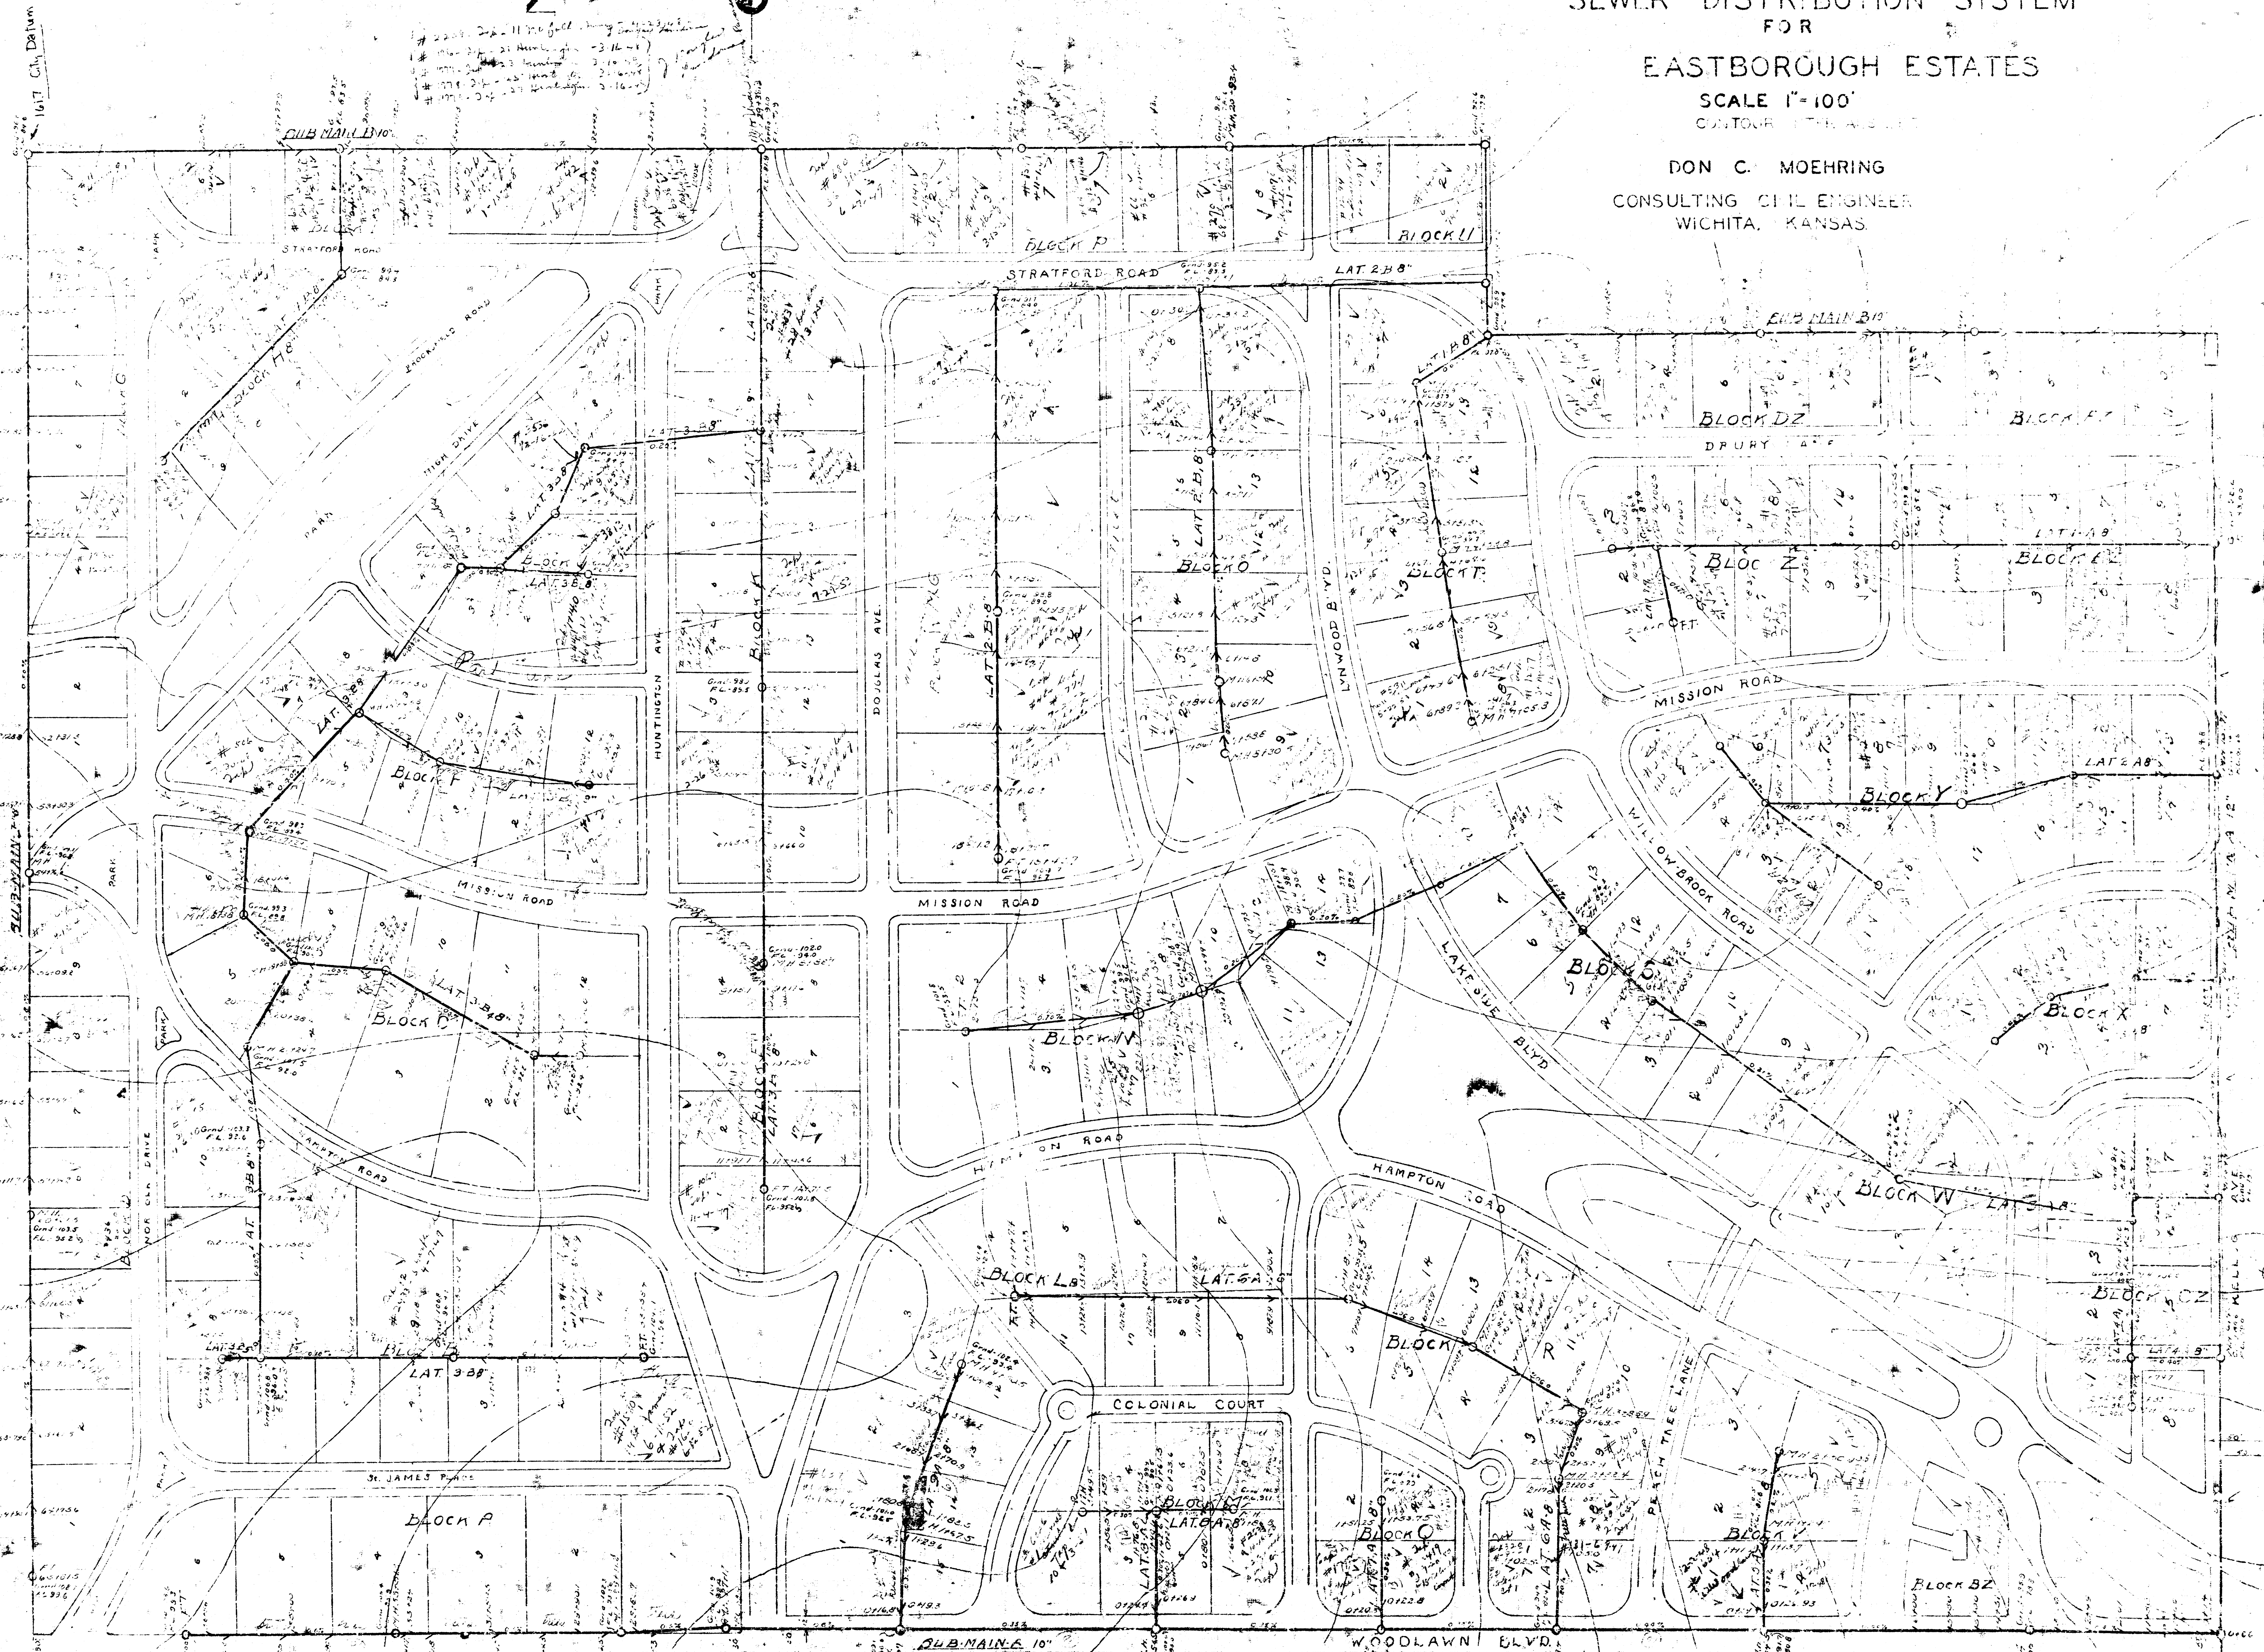

