
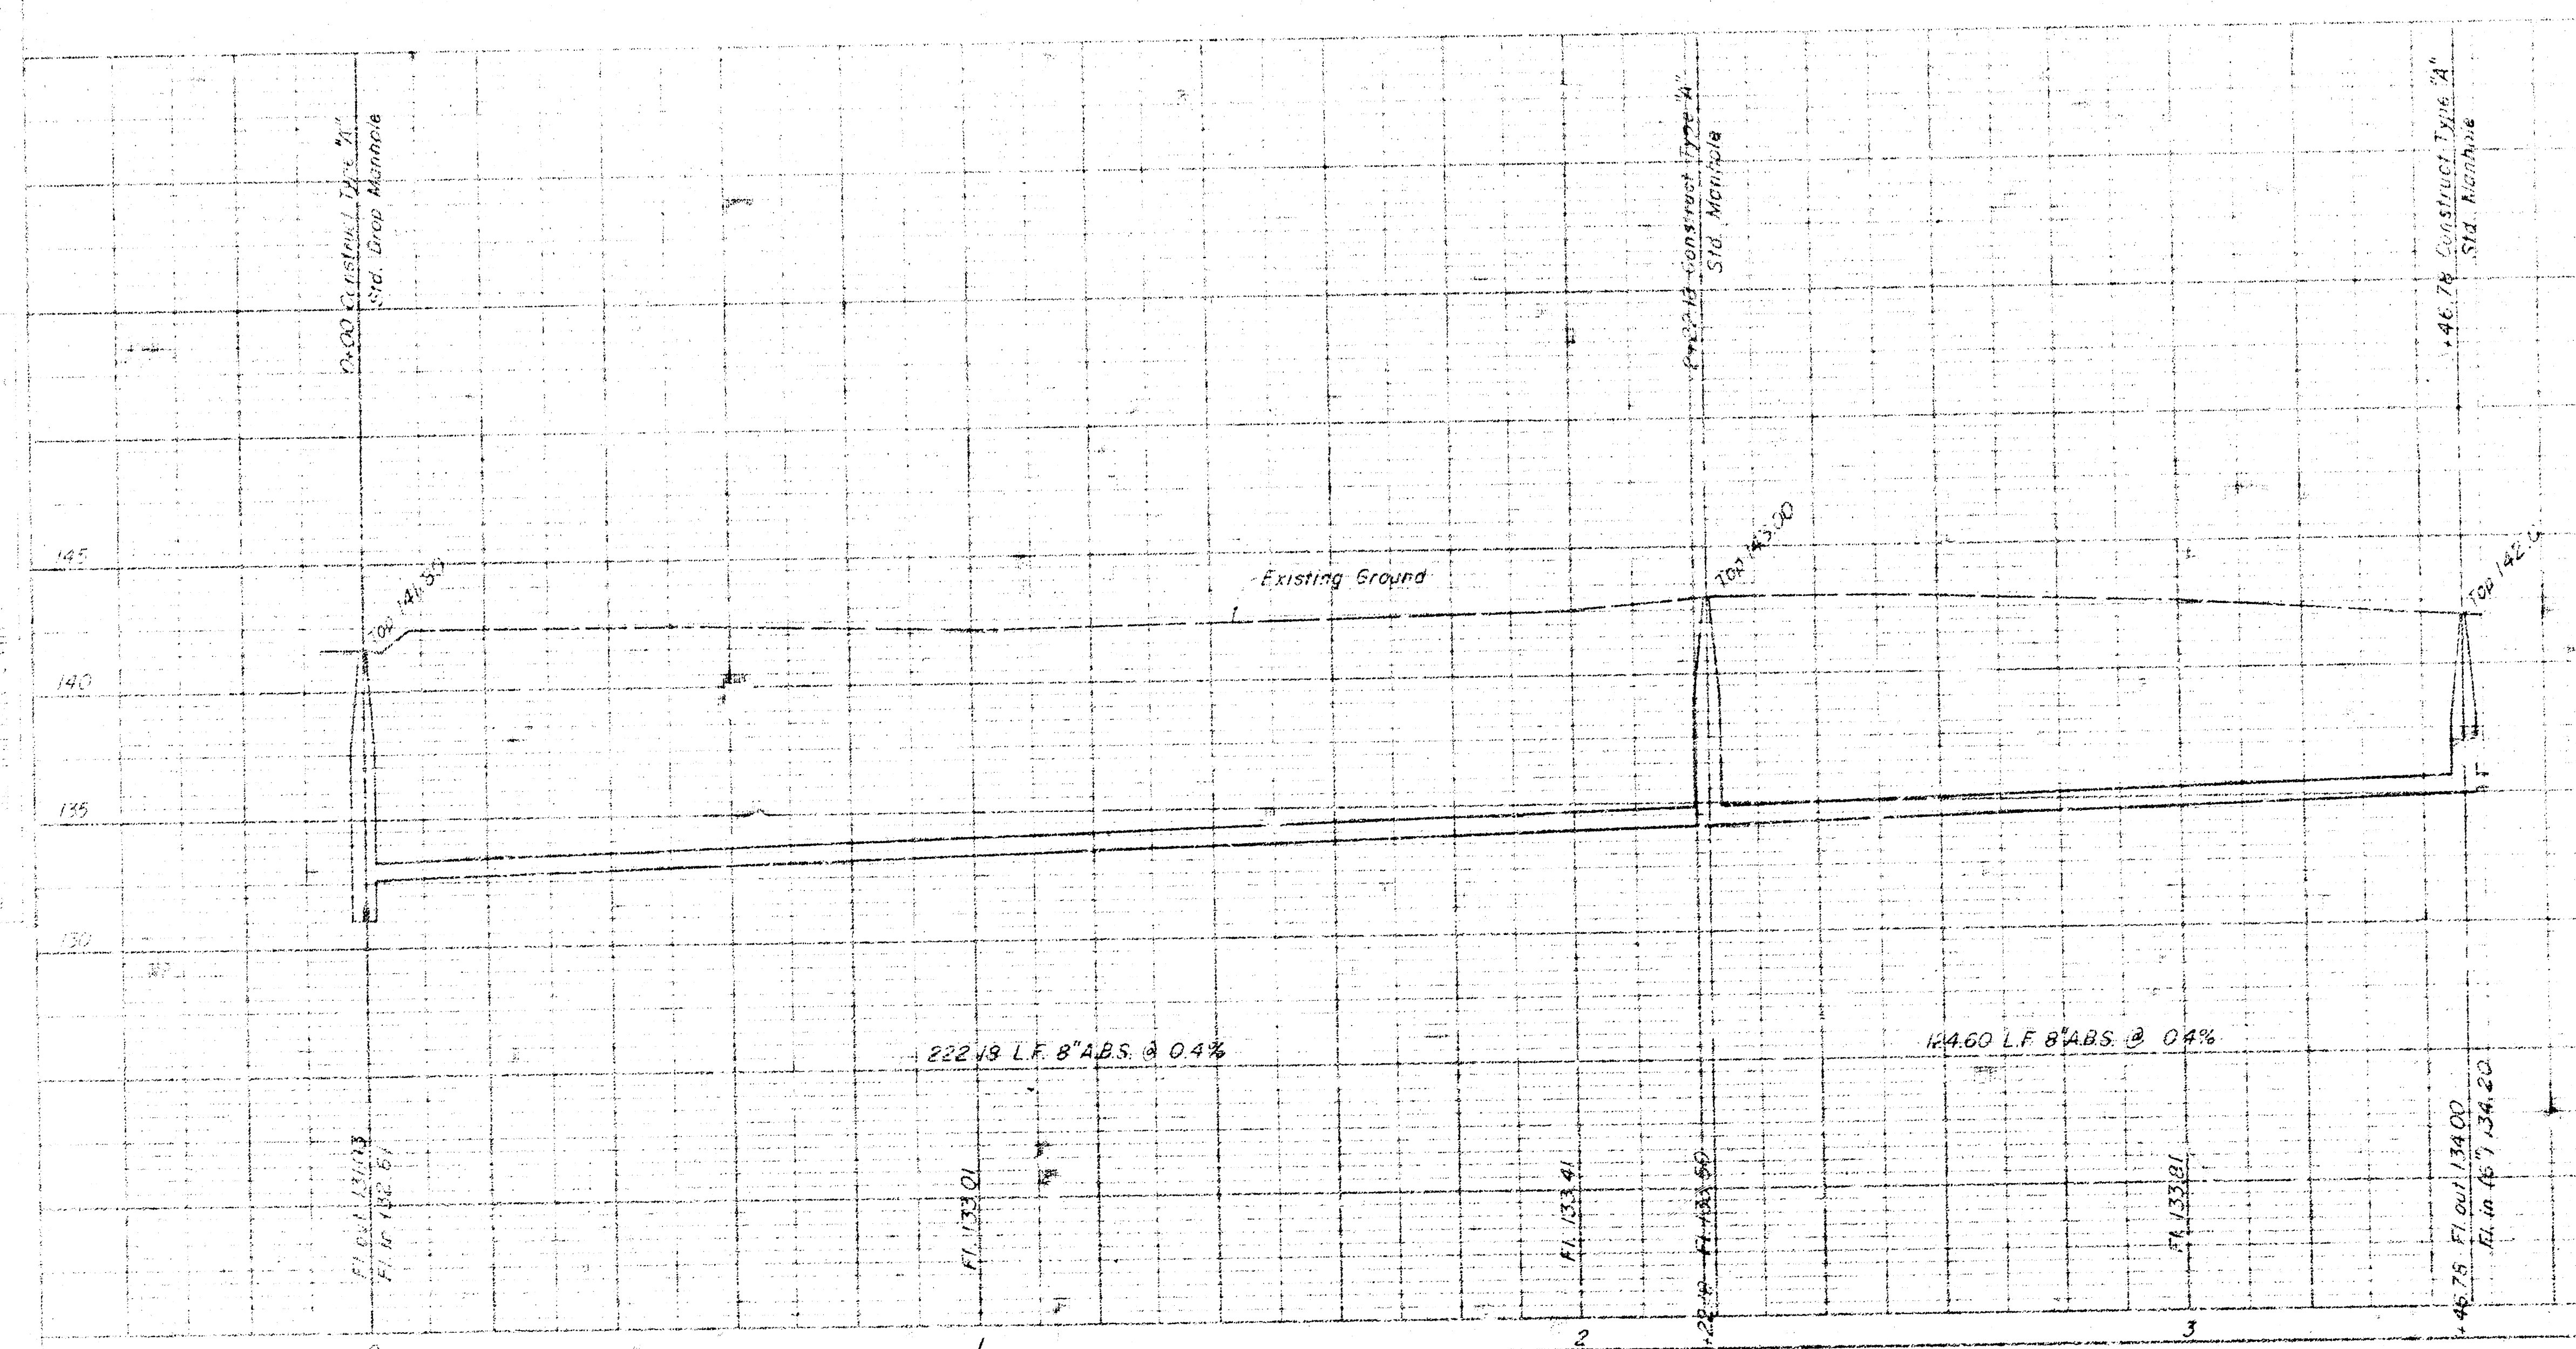


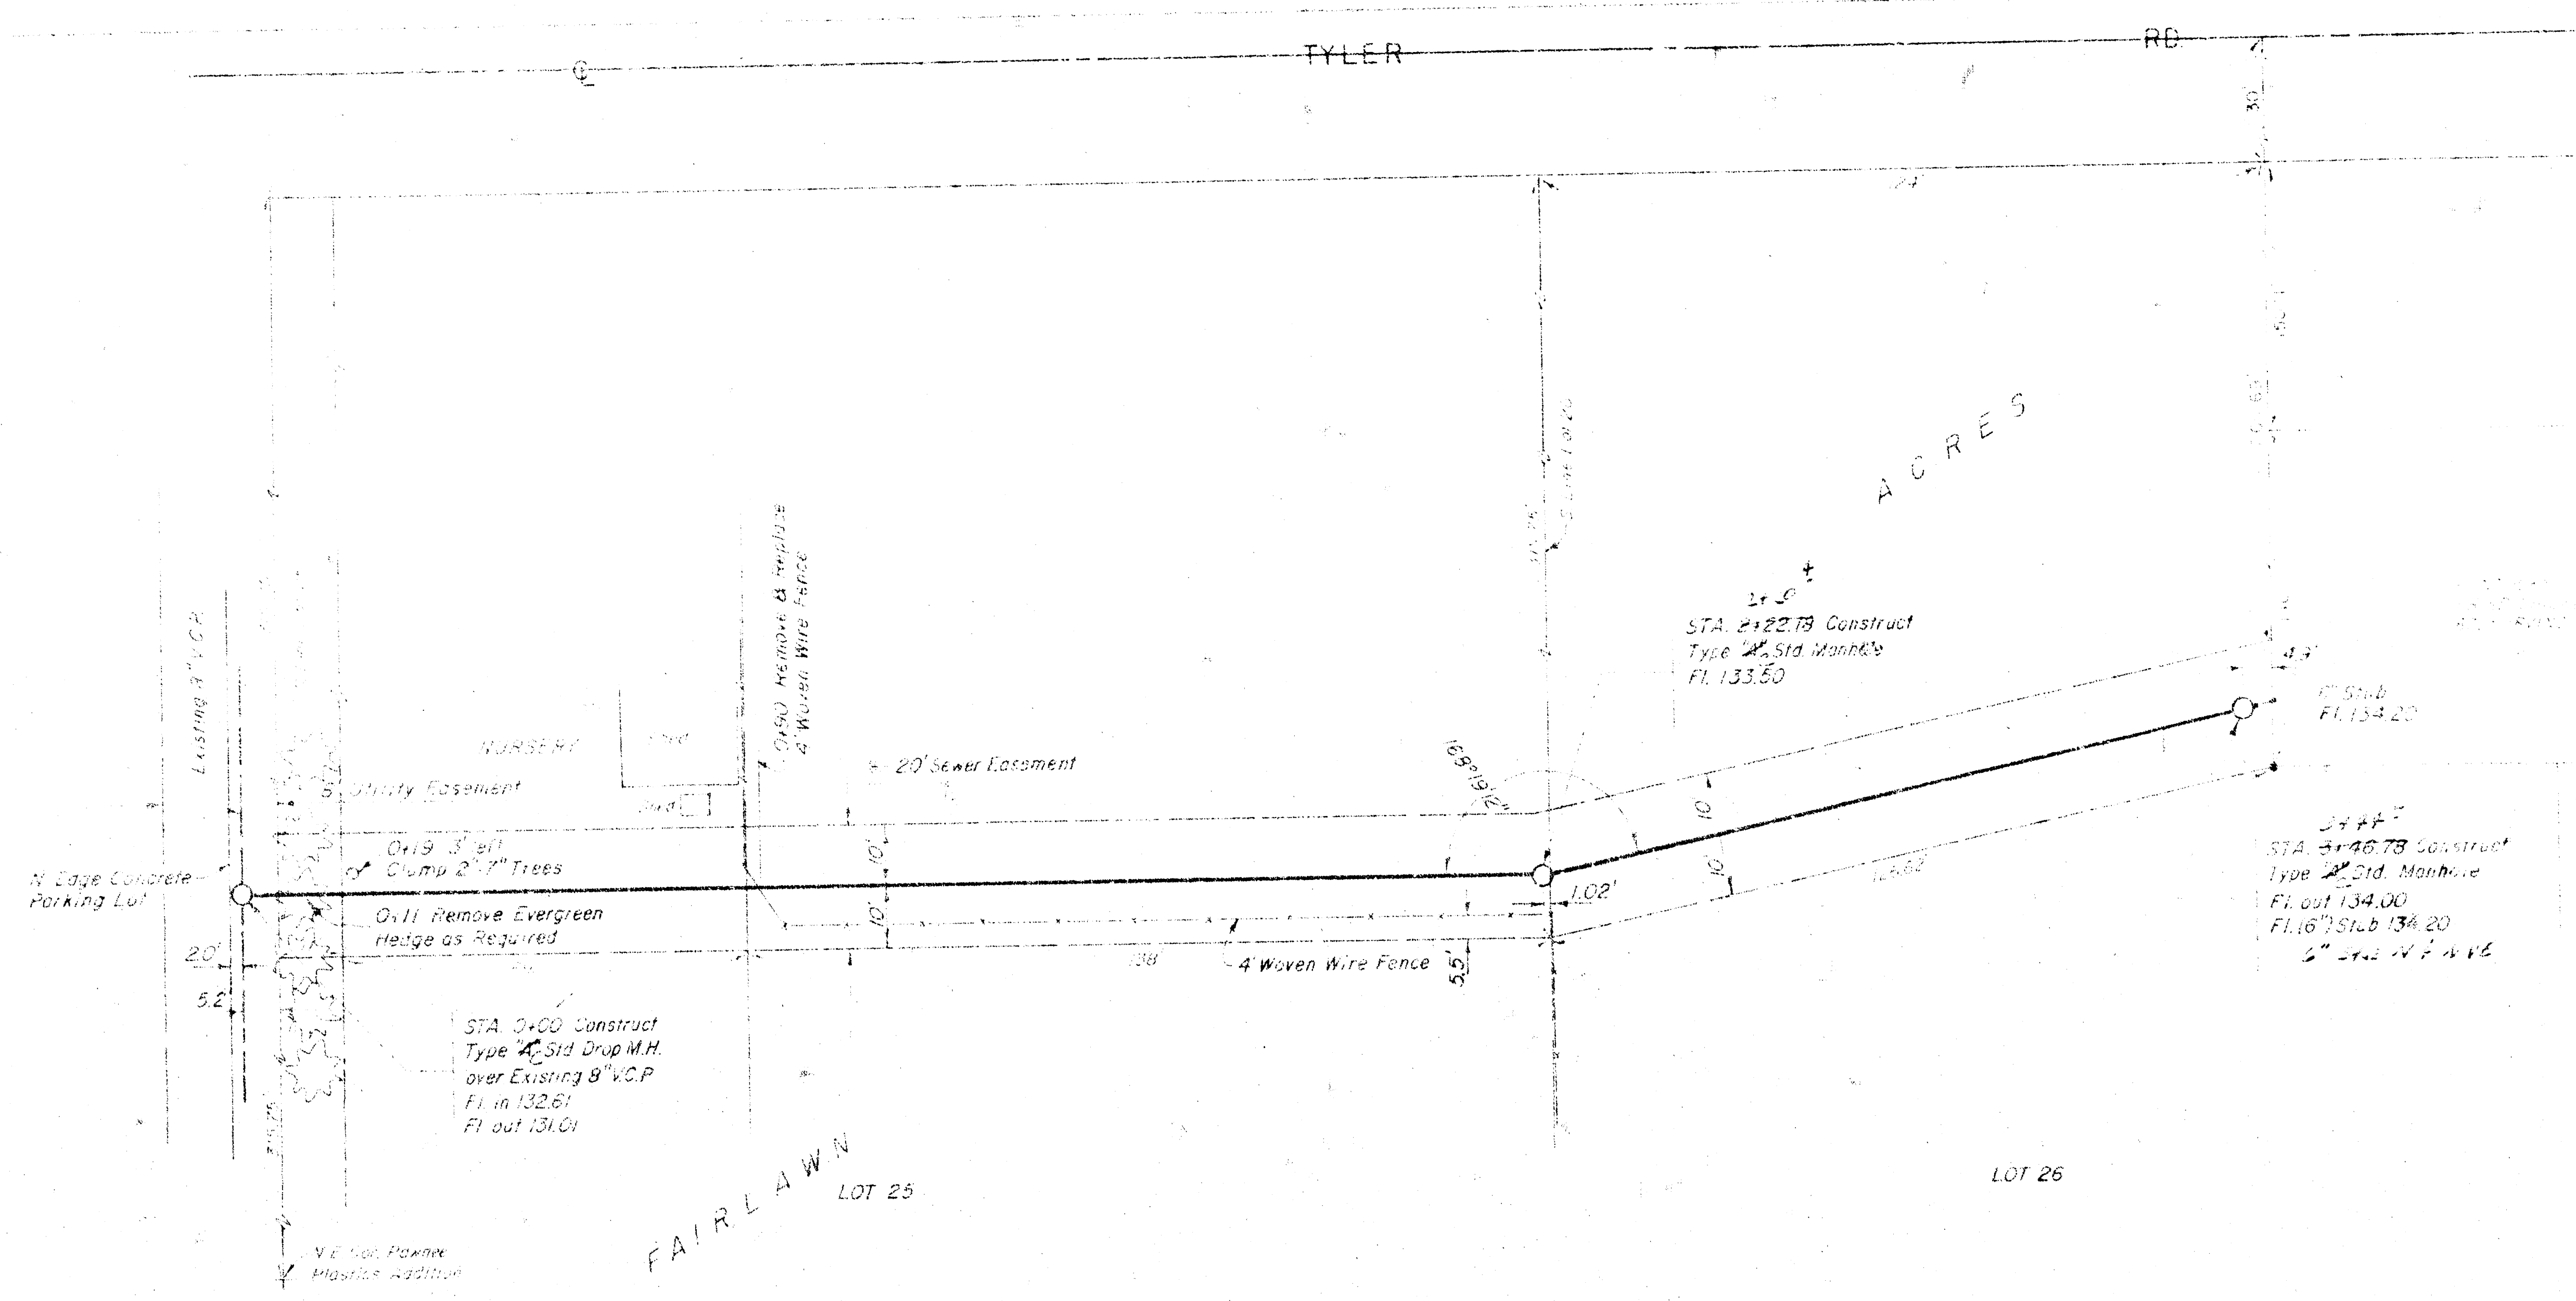

SCALE
 1" = 20' Horiz.
 1" = 5' Vert.

SEWER MARK
 "M" in "Master" on Top of Fire hydrant
 at S.E. Corner Tyler Road and Irving
 Street, Elev. 142.64

SANITARY SEWER EXTENSION
 IN LOTS 25 & 26, FAIRLAWN ACRES
 WICHITA, KANSAS
 (US 54 & TYLER RD.)
 CITY OF WICHITA PRIVATE PROJECTION
 159 75 245-80730-000-000-000
 Moshering & Associates, Inc.
 Consulting Engineers
 Wichita
 74-070-0
 JUNE 1979

DATE: JAN. 1979
 DRAWN BY: J.E.
 CHECKED BY: J.E.
 NO. 1041