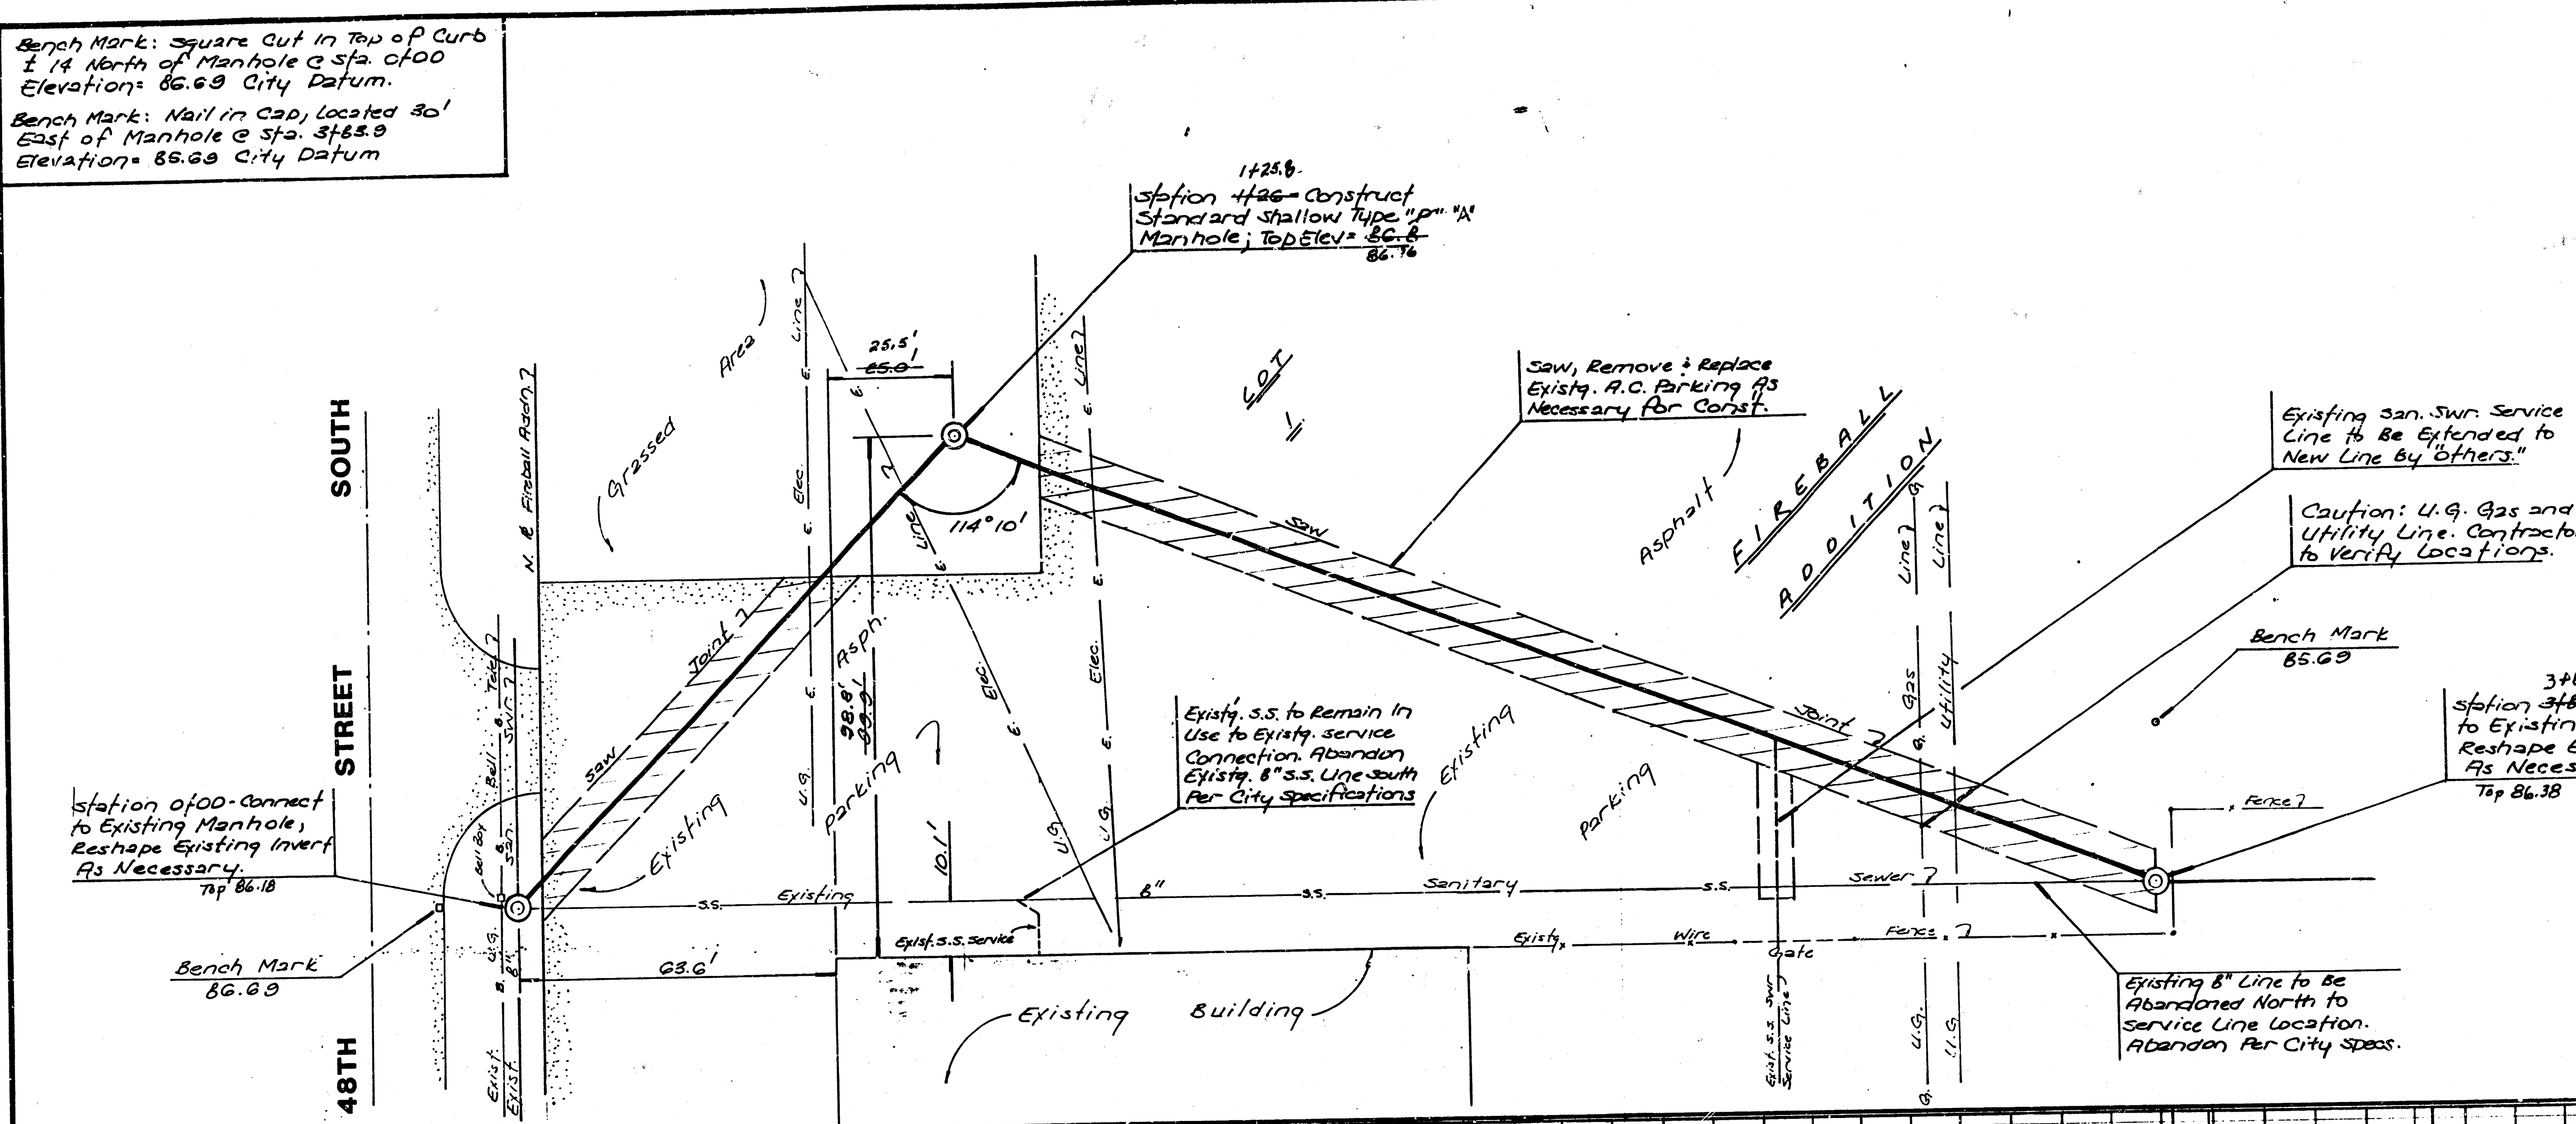

Scale: 1"= 20' Plan
1"= 5' Profile

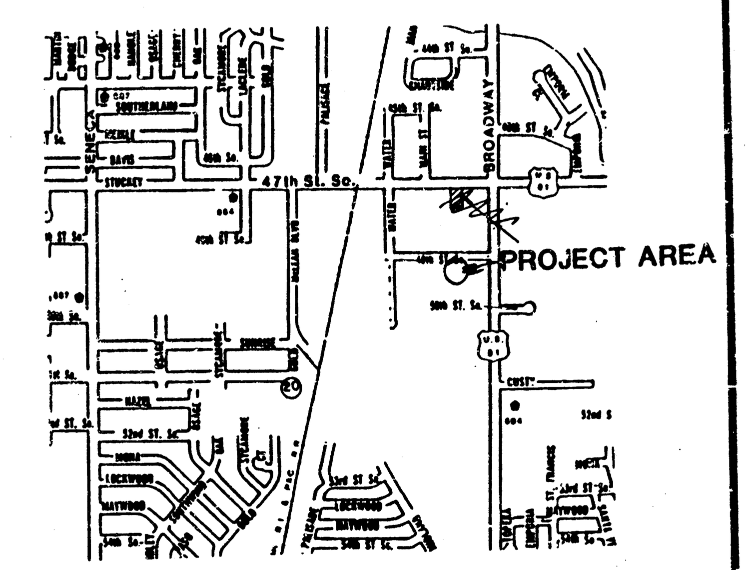

LOCATION MAP

GENERAL NOTES

Existing utility lines and their location, as shown on the plans, represent the best information obtainable for design. The Contractor will be required to work around existing utilities which do not conflict with proposed construction.

The contractor shall be responsible for locating all underground utility lines prior to construction of the sanitary sewer. This includes all public and private utilities that may be present on the site.

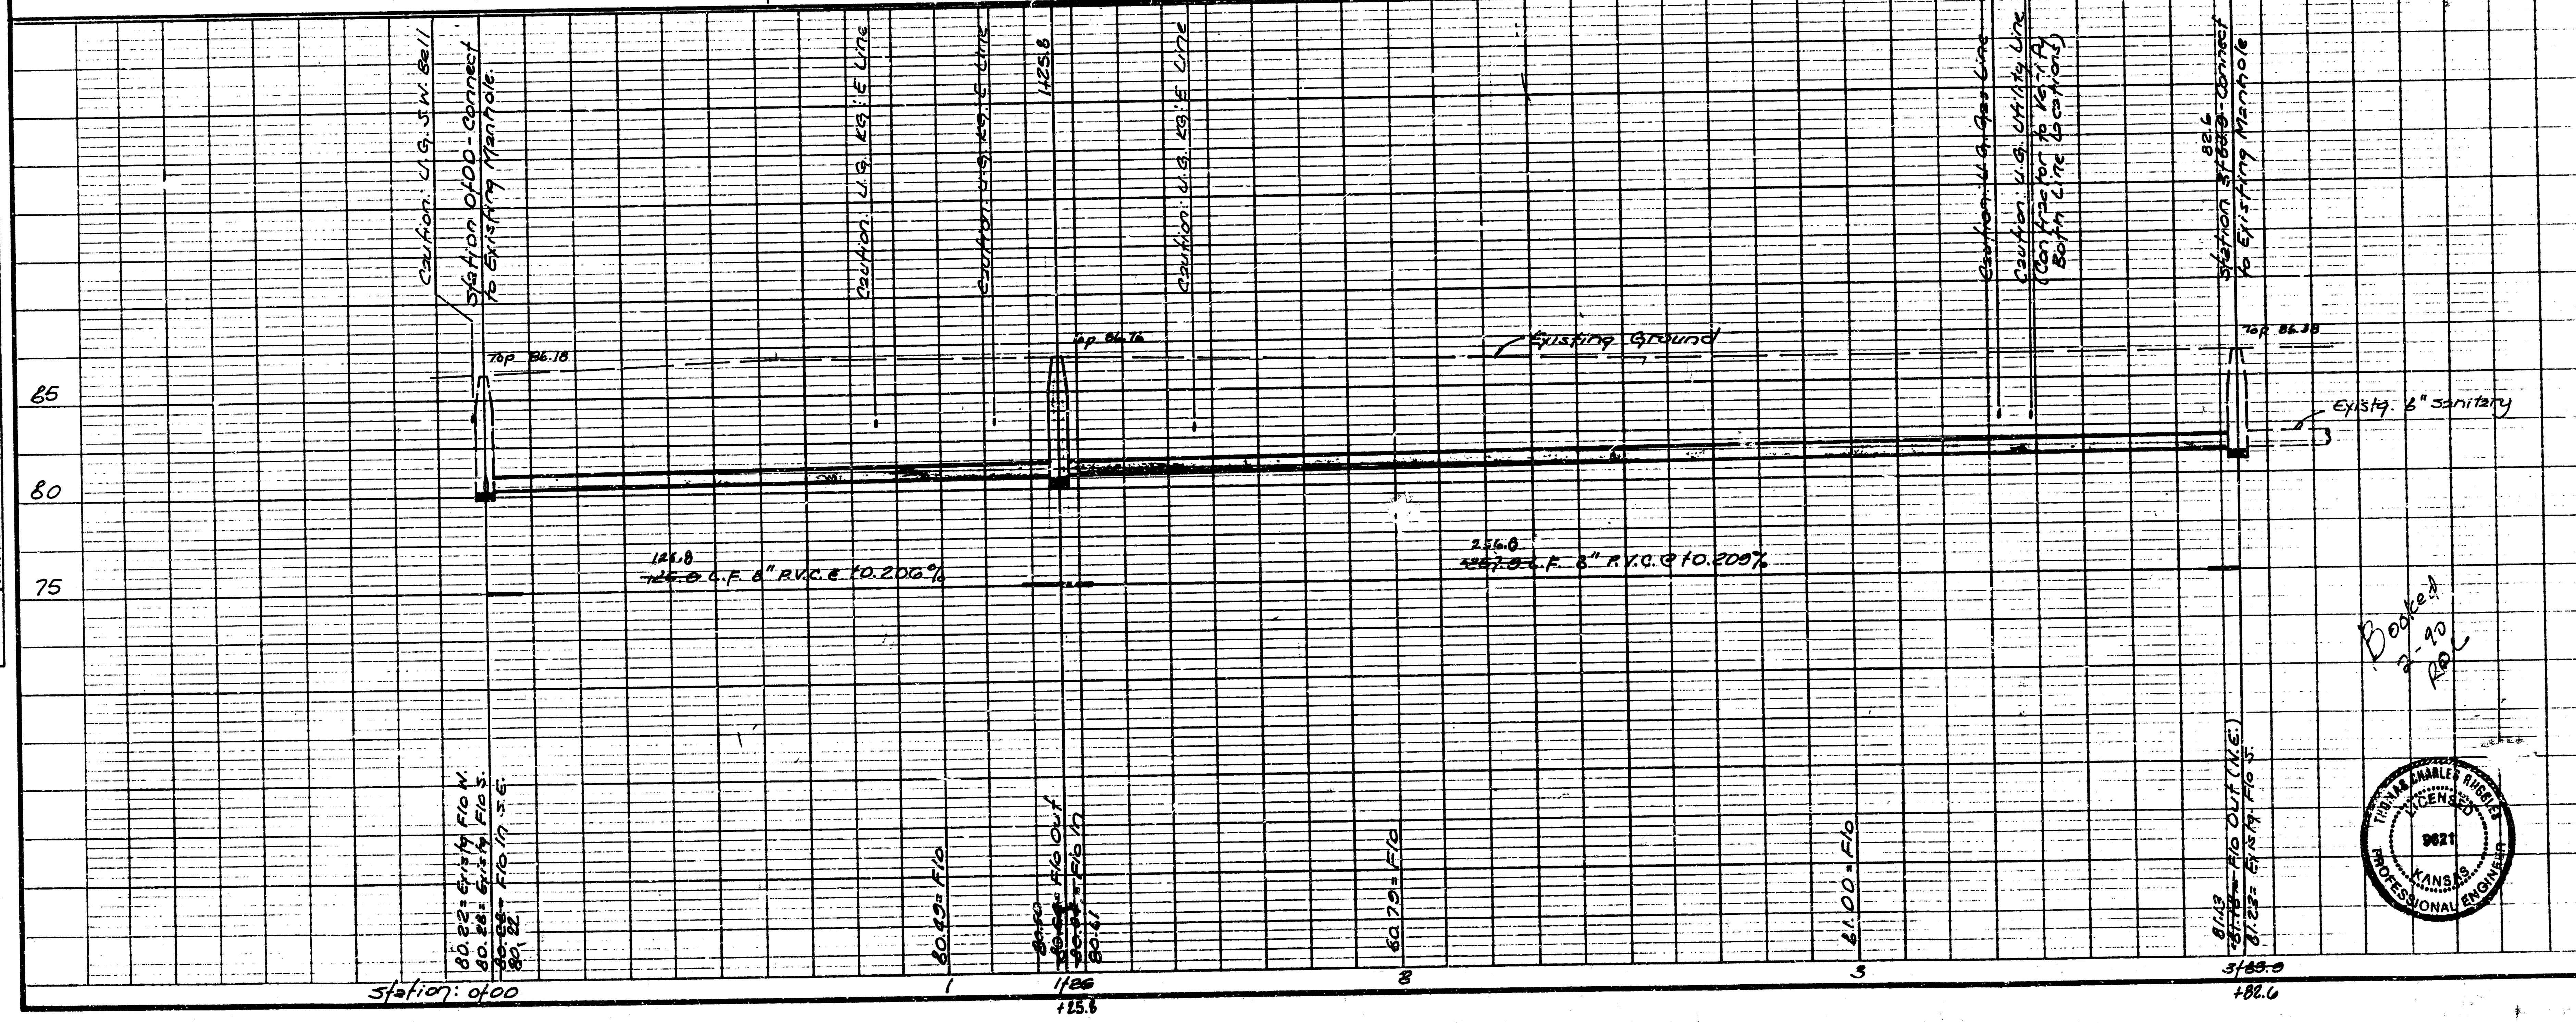

NOTE TO CONTRACTOR

INSPECTION AND TESTING FOR THIS PROJECT IS TO BE PROVIDED BY A LICENSED CONSULTING ENGINEERING FIRM UNDER CONTRACT WITH THE OWNER/DEVELOPER. SAID INSPECTION TO BE IN ACCORDANCE WITH THE CITY OF WICHITA STANDARD CONSTRUCTION ENGINEERING PRACTICES AND CERTIFIED BY A LICENSED PROFESSIONAL ENGINEER. NO WORK SHALL BE PERFORMED IN DEDICATED EASEMENTS OR PUBLIC RIGHT-OF-WAY BY THE CONTRACTOR WITHOUT SUCH INSPECTION NOR SHALL ANY WORK BE COMMENCED IN DEDICATED EASEMENTS OR PUBLIC RIGHT-OF-WAY WITHOUT WRITTEN AUTHORIZATION BY THE CITY ENGINEER.

APPROVED AS NOTED
By CITY ENGINEER OF WICHITA

Sanitary Sewers VRH 7/17/89
Storm Sewers
Driveway Approaches
Water Mains
Paving

Booked 2-90 RDL

REVISED AS BUILT 7-25-89

INDEX CODE 222 PPS

PRIVATE SANITARY SEWER RELOCATION TO SERVE LOT 1, FIREBALL ADDITION CITY OF WICHITA, KANSAS

THOMAS CHARLES RUGGLES LICENSED 9621 KANSAS PROFESSIONAL ENGINEER

BAUGHMAN COMPANY, P.A.
SURVEYING & ENGINEERING
316/262-7271 · 315 ELLIS · WICHITA, KANSAS 67211

Design:	Drawn:	Approved:	Date:	Scale:	Sheet
C. Bohm	C. Bohm	N.B.W.	7/89	Noted	1 of 2

1/2

PLAN NOTE BOOK No. SURVEYED PLOTTED ALIGNMENT CHECKED RT. OF WAY CHECKED BY DATE

PROFILE NOTE BOOK No. SURVEYED PLOTTED GRADES CHECKED B. M.'s NOTED STRUCTURE NOTATIONS CHECKED BY DATE

FILMED FROM THE BEST AVAILABLE COPY ....

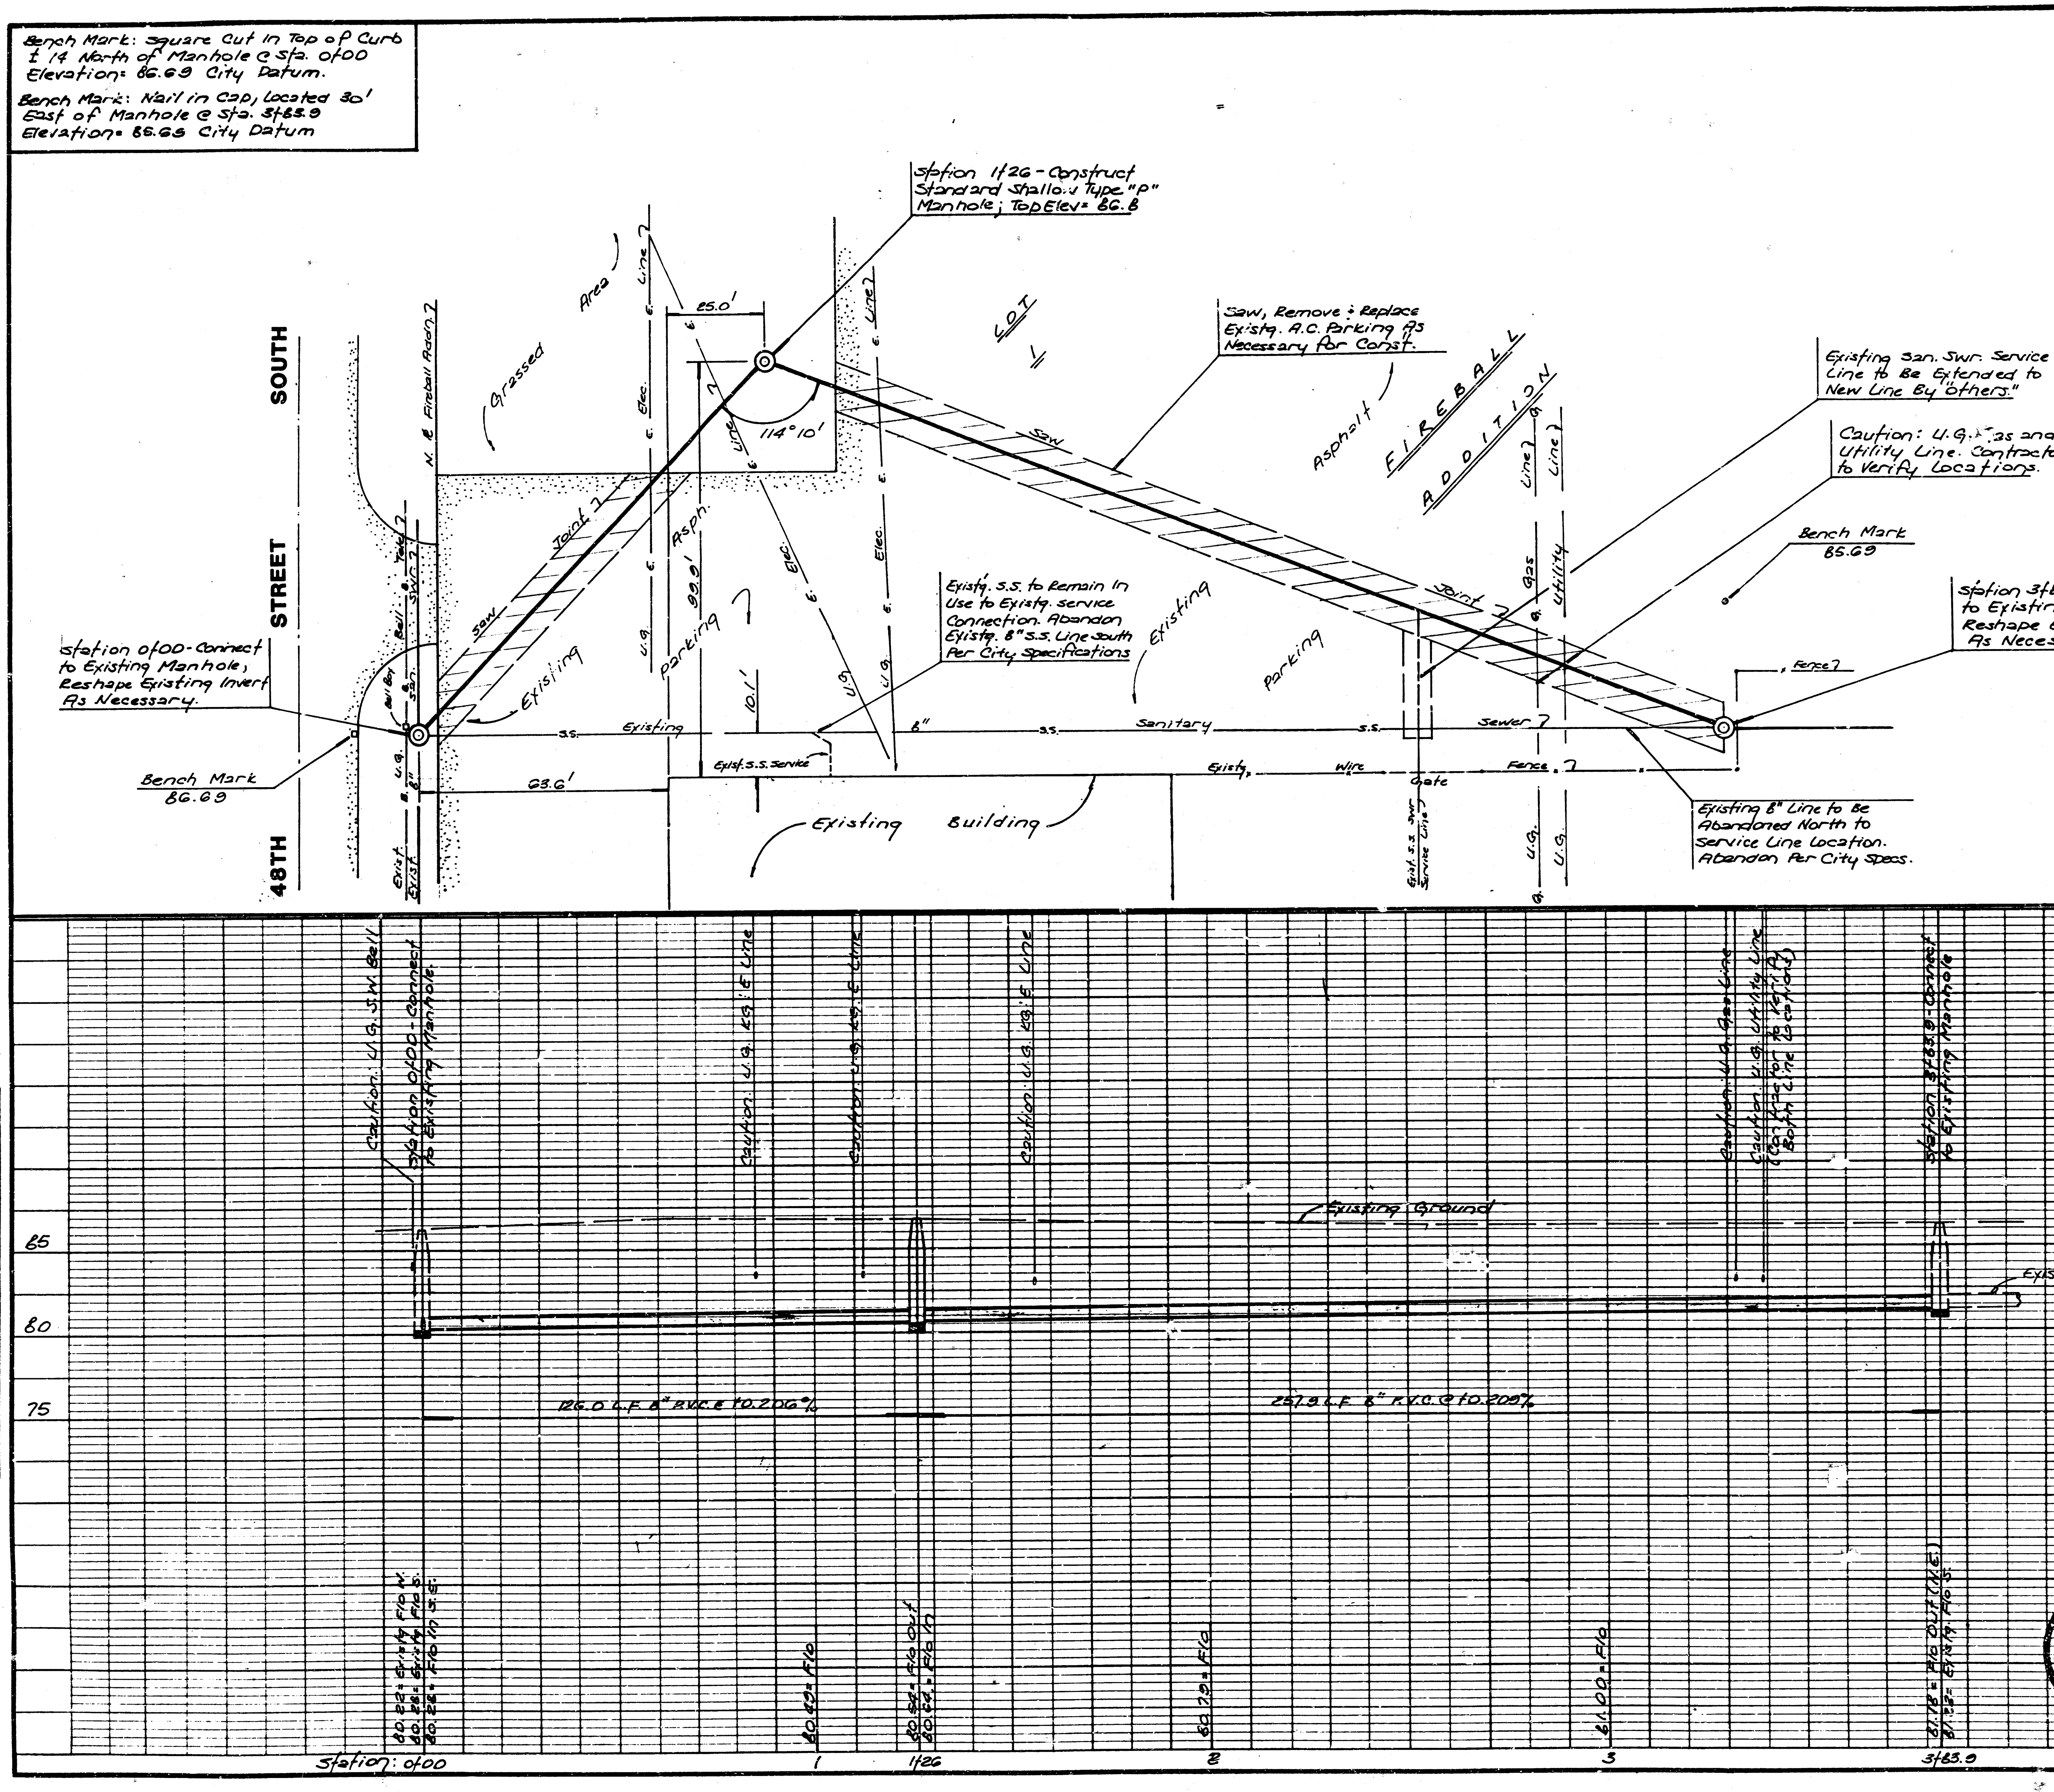

GENERAL NOTES

Existing utility lines and their location, as shown on the plans, represent the best information obtainable for design. The Contractor will be required to work around existing utilities which do not conflict with proposed construction.

The contractor shall be responsible for locating all underground utility lines prior to construction of the sanitary sewer. This includes all public and private utilities that may be present on the site.

NOTE TO CONTRACTOR

INSPECTION AND TESTING FOR THIS PROJECT IS TO BE PROVIDED BY A LICENSED CONSULTING ENGINEERING FIRM UNDER CONTRACT WITH THE OWNER/DEVELOPER. SAID INSPECTION TO BE IN ACCORDANCE WITH THE CITY OF WICHITA STANDARD CONSTRUCTION ENGINEERING PRACTICES AS PERFORMED BY A LICENSED PROFESSIONAL ENGINEER IN KANSAS. ALL ... PERFORMED IN DEDICATED EASEMENTS OR ... RIGHT-OF-WAY BY THE CONTRACTOR ... NO SHALL ANY WORK BE COMMENCED IN DEDICATED EASEMENTS OR PUBLIC RIGHT-OF-WAY WITHOUT WRITTEN AUTHORIZATION BY THE CITY ENGINEER.

APPROVED AS NOTED
BY CITY ENGINEER OF WICHITA
Sanitary Sewers VRH 7/7/89
Storm Sewers
Driveway Approaches
Water Mains
Paving

INDEX CODE 222 PPS

PRIVATE SANITARY SEWER RELOCATION
TO SERVE LOT 1, FIREBALL ADDITION
CITY OF WICHITA, KANSAS

BAUGHMAN COMPANY, P.A.
SURVEYING & ENGINEERING
316/262-7271 · 315 ELLIS · WICHITA, KANSAS 67211

Design:	Drawn:	Approved:	Date:	Scale:	Sheet
C. Bohm	C. Bohm	N.B.W.	7/89	Noted	2

FILMED FROM THE BEST AVAILABLE COPY