


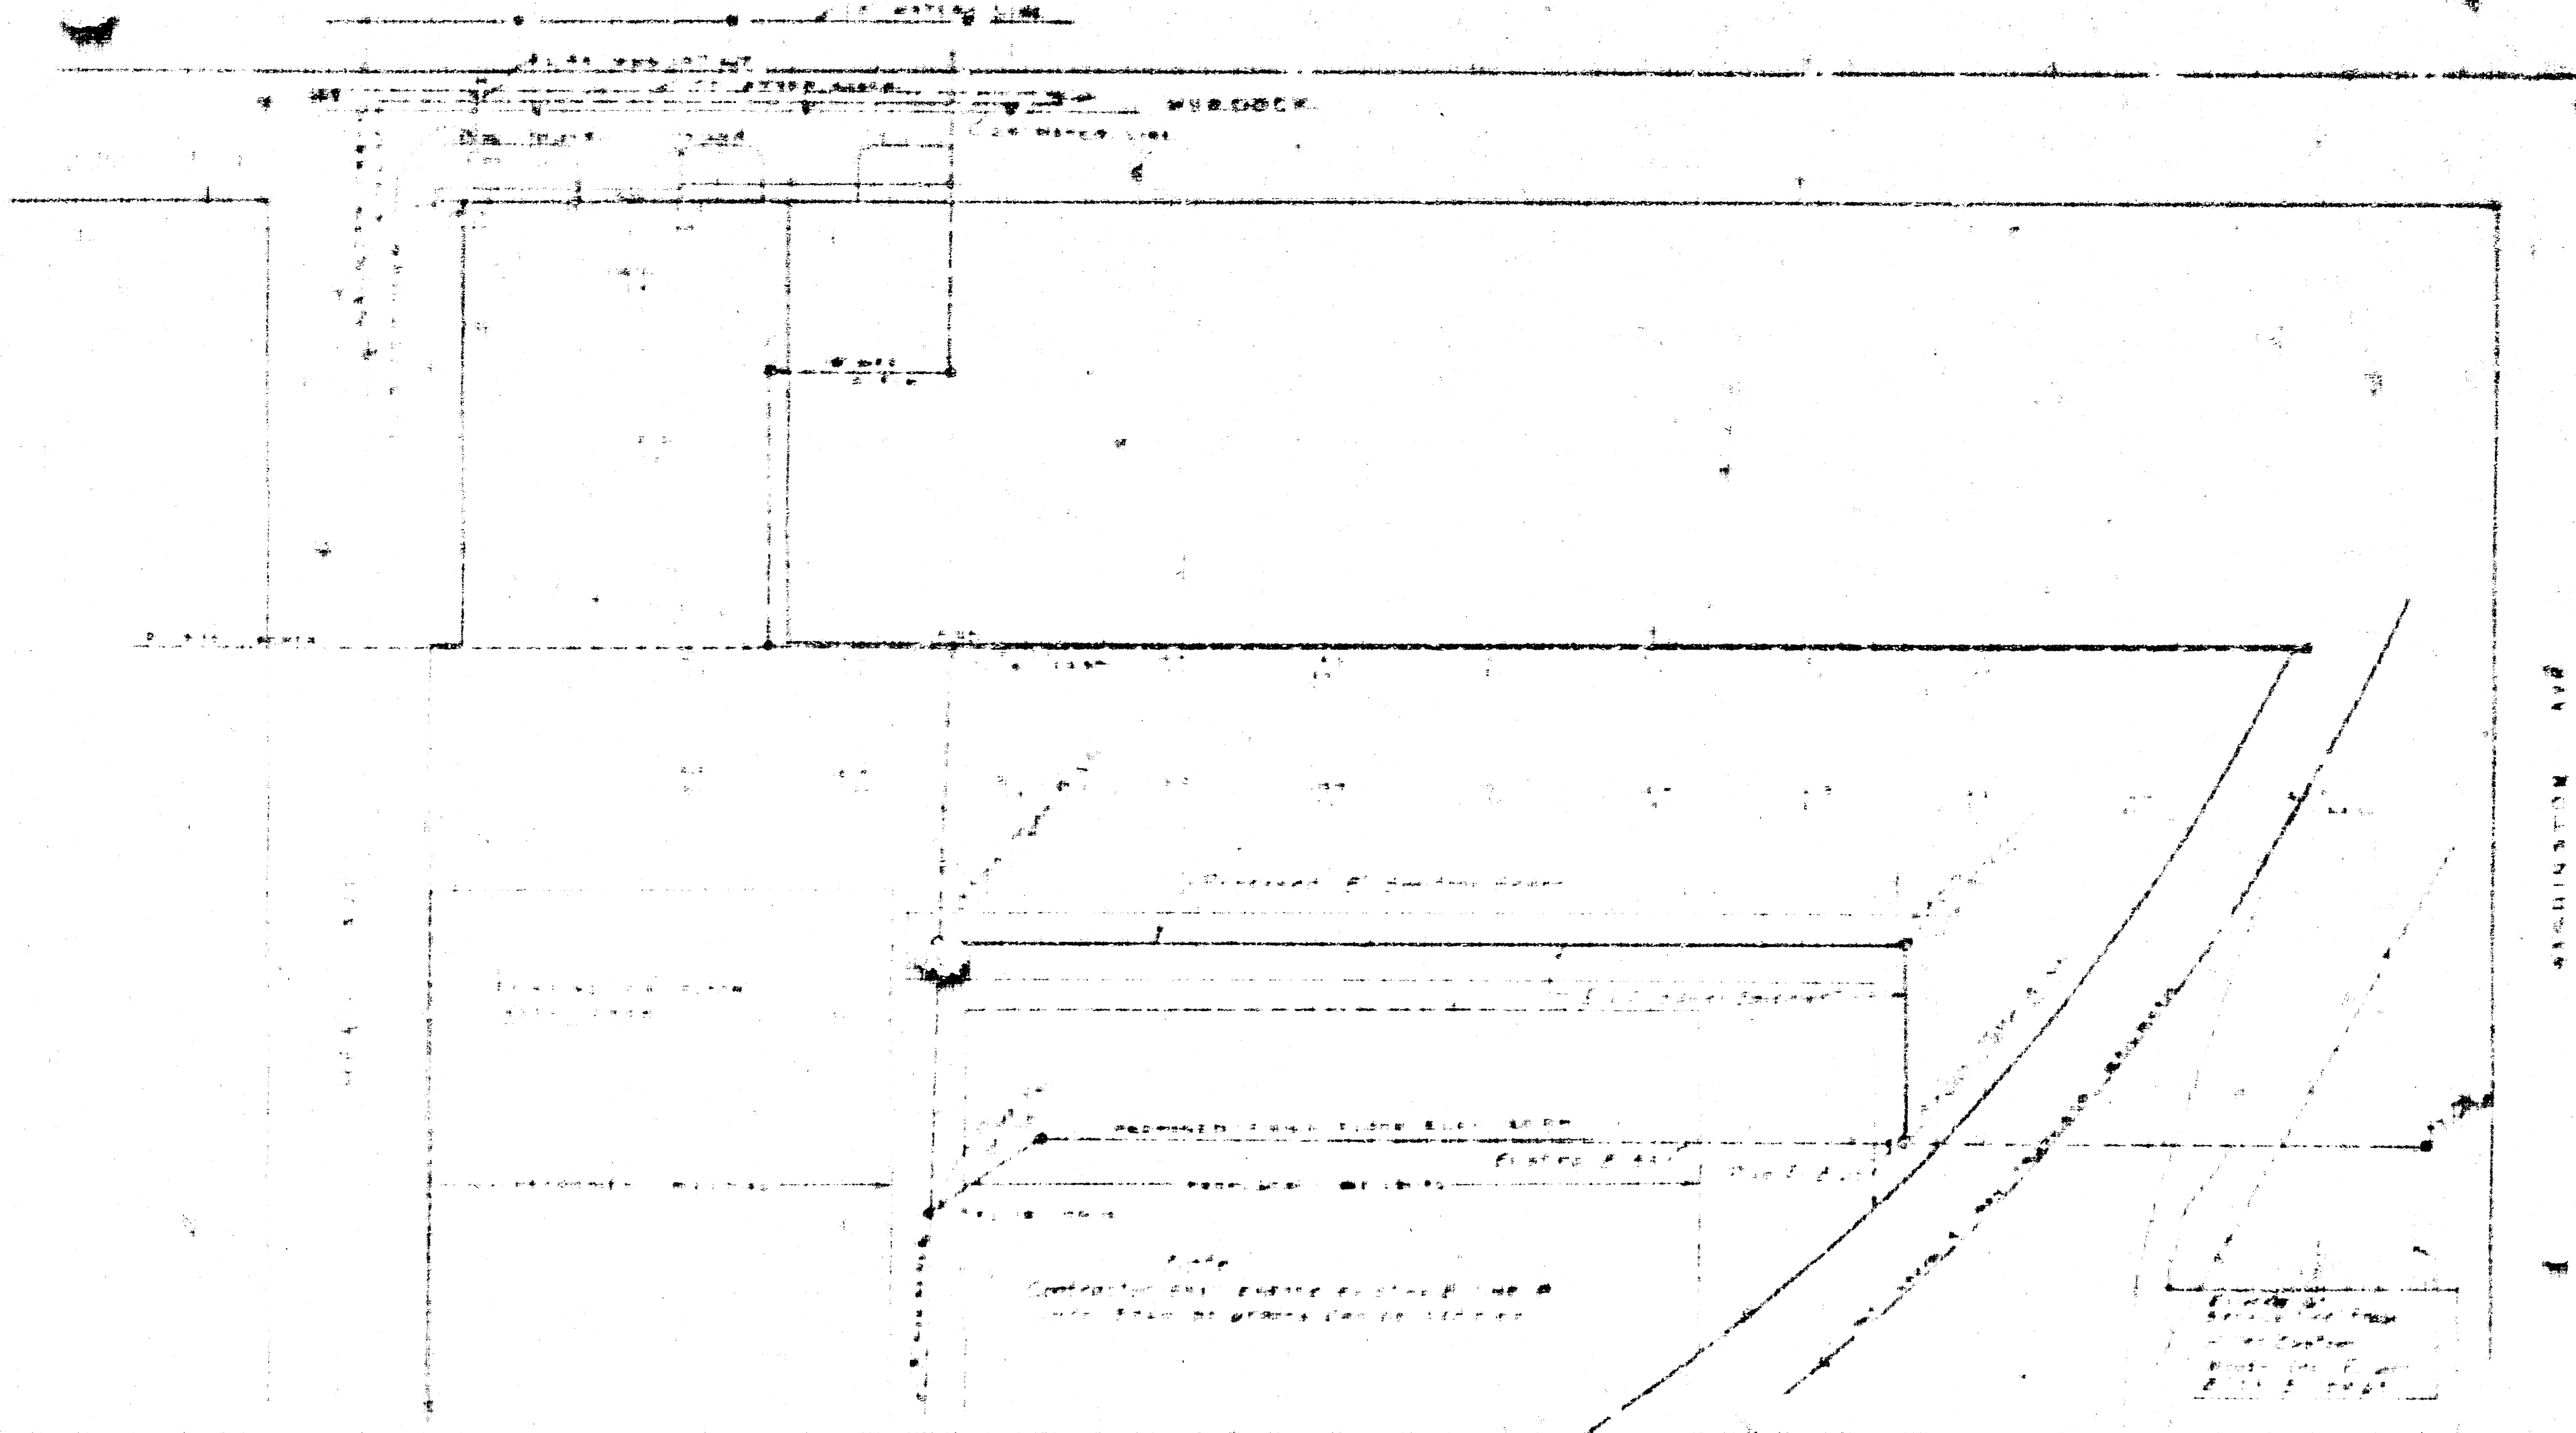

PLAN OF 1925. North side of 1st St. South of 2nd St. of Frisco
 E. 1st St. West of 1st St. of Frisco

SANITARY SEWER RELOCATION

FRISCO WAREHOUSE PROPERTY

NOTE TO CONTRACTOR
 This project can be constructed using
 the supervision of the City Engineer
 and the assistance of the City Engineer
 of the City of Frisco. The City Engineer
 will be responsible for the design and
 construction of the project. The City Engineer
 will also be responsible for the inspection
 and approval of the project.

APPROVED AS NOTED
 BY CITY ENGINEER OF FRISCO
 City Engineer 11-3-77
 City Engineer
 City Engineer

K. C. TAYLOR, P.E.
 NOV 1, 1977



CITY PROJ. NO. 1000000000