


SANITARY SEWER LAYOUT
 GREEN ACRES MOBILE HOME RESORT
 CITY OF WICHITA, KANSAS
 B. E. SMITH CITY ENGINEER
 PRIVATE PROJECT

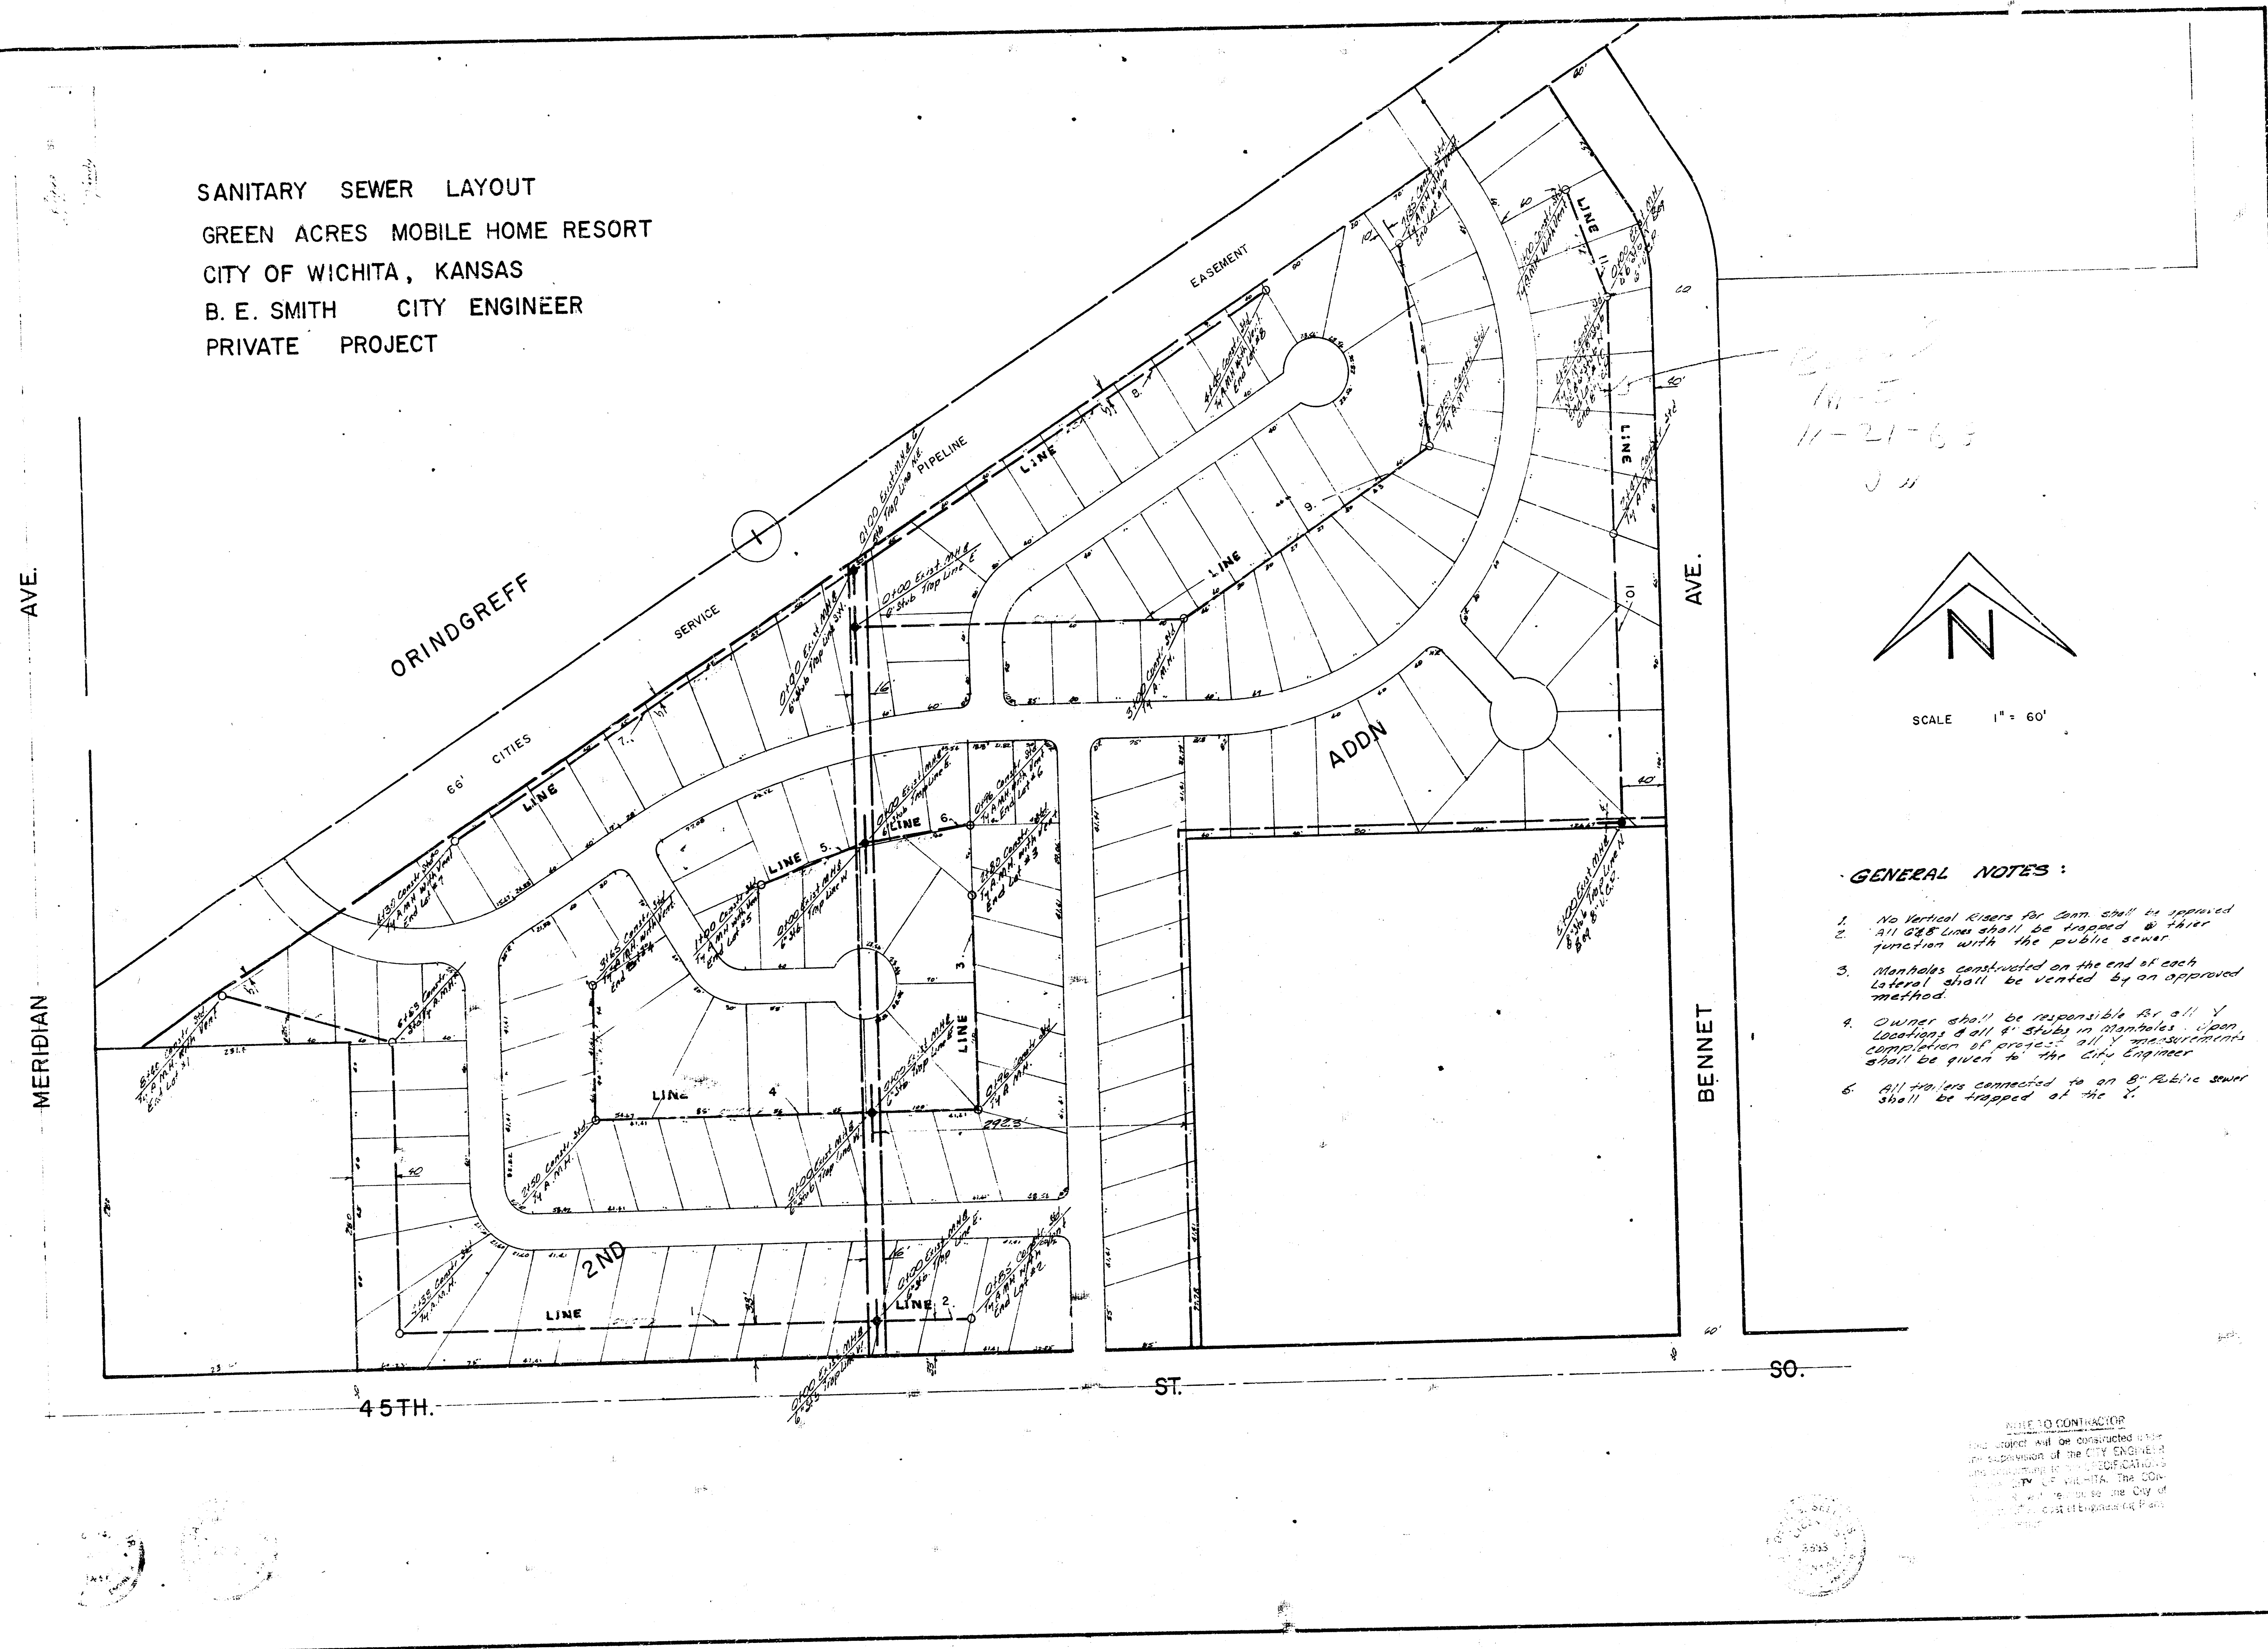

- GENERAL NOTES:


