


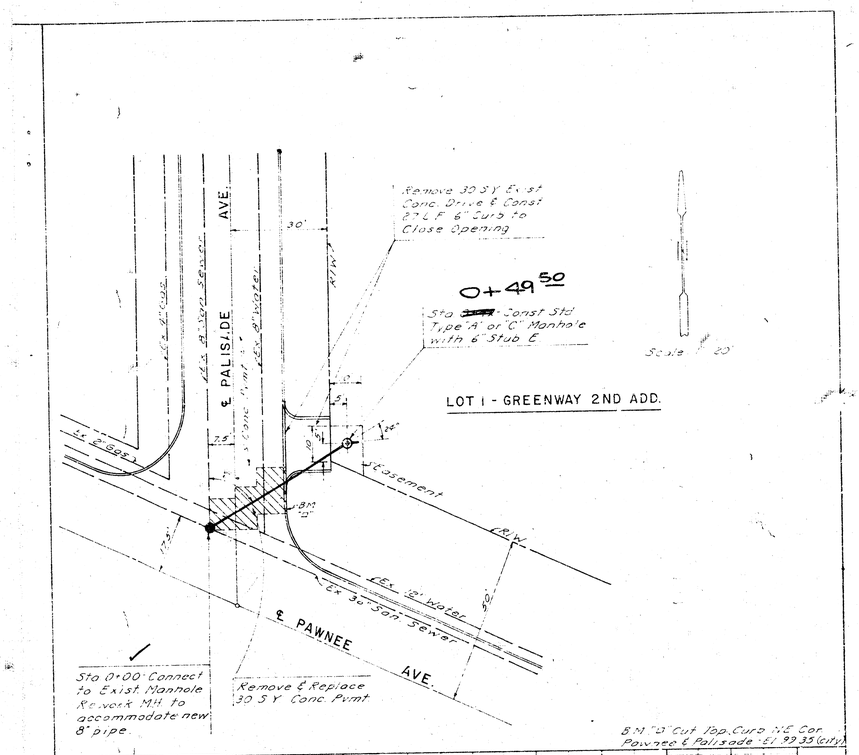


4/20/78

P.W. Proj.

7-24-78

CITY PROJECT NO.
468-76-245-80497-000-000-008

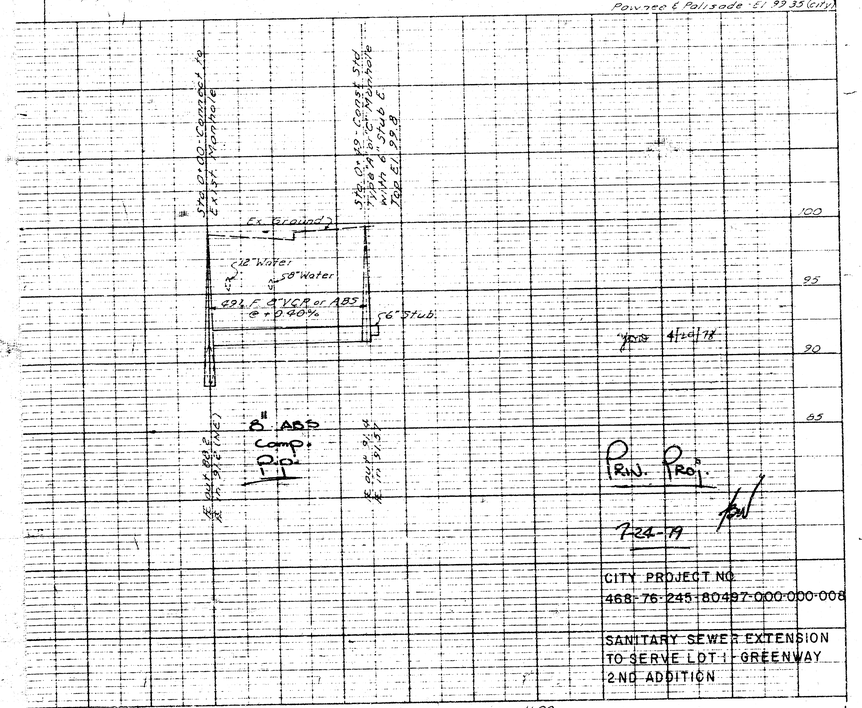SANITARY SEWER EXTENSION
TO SERVE LOT 1 GREENWAY
2ND ADDITION

14 3 2 11

FILMED FROM THE BEST AVAILABLE COPY