



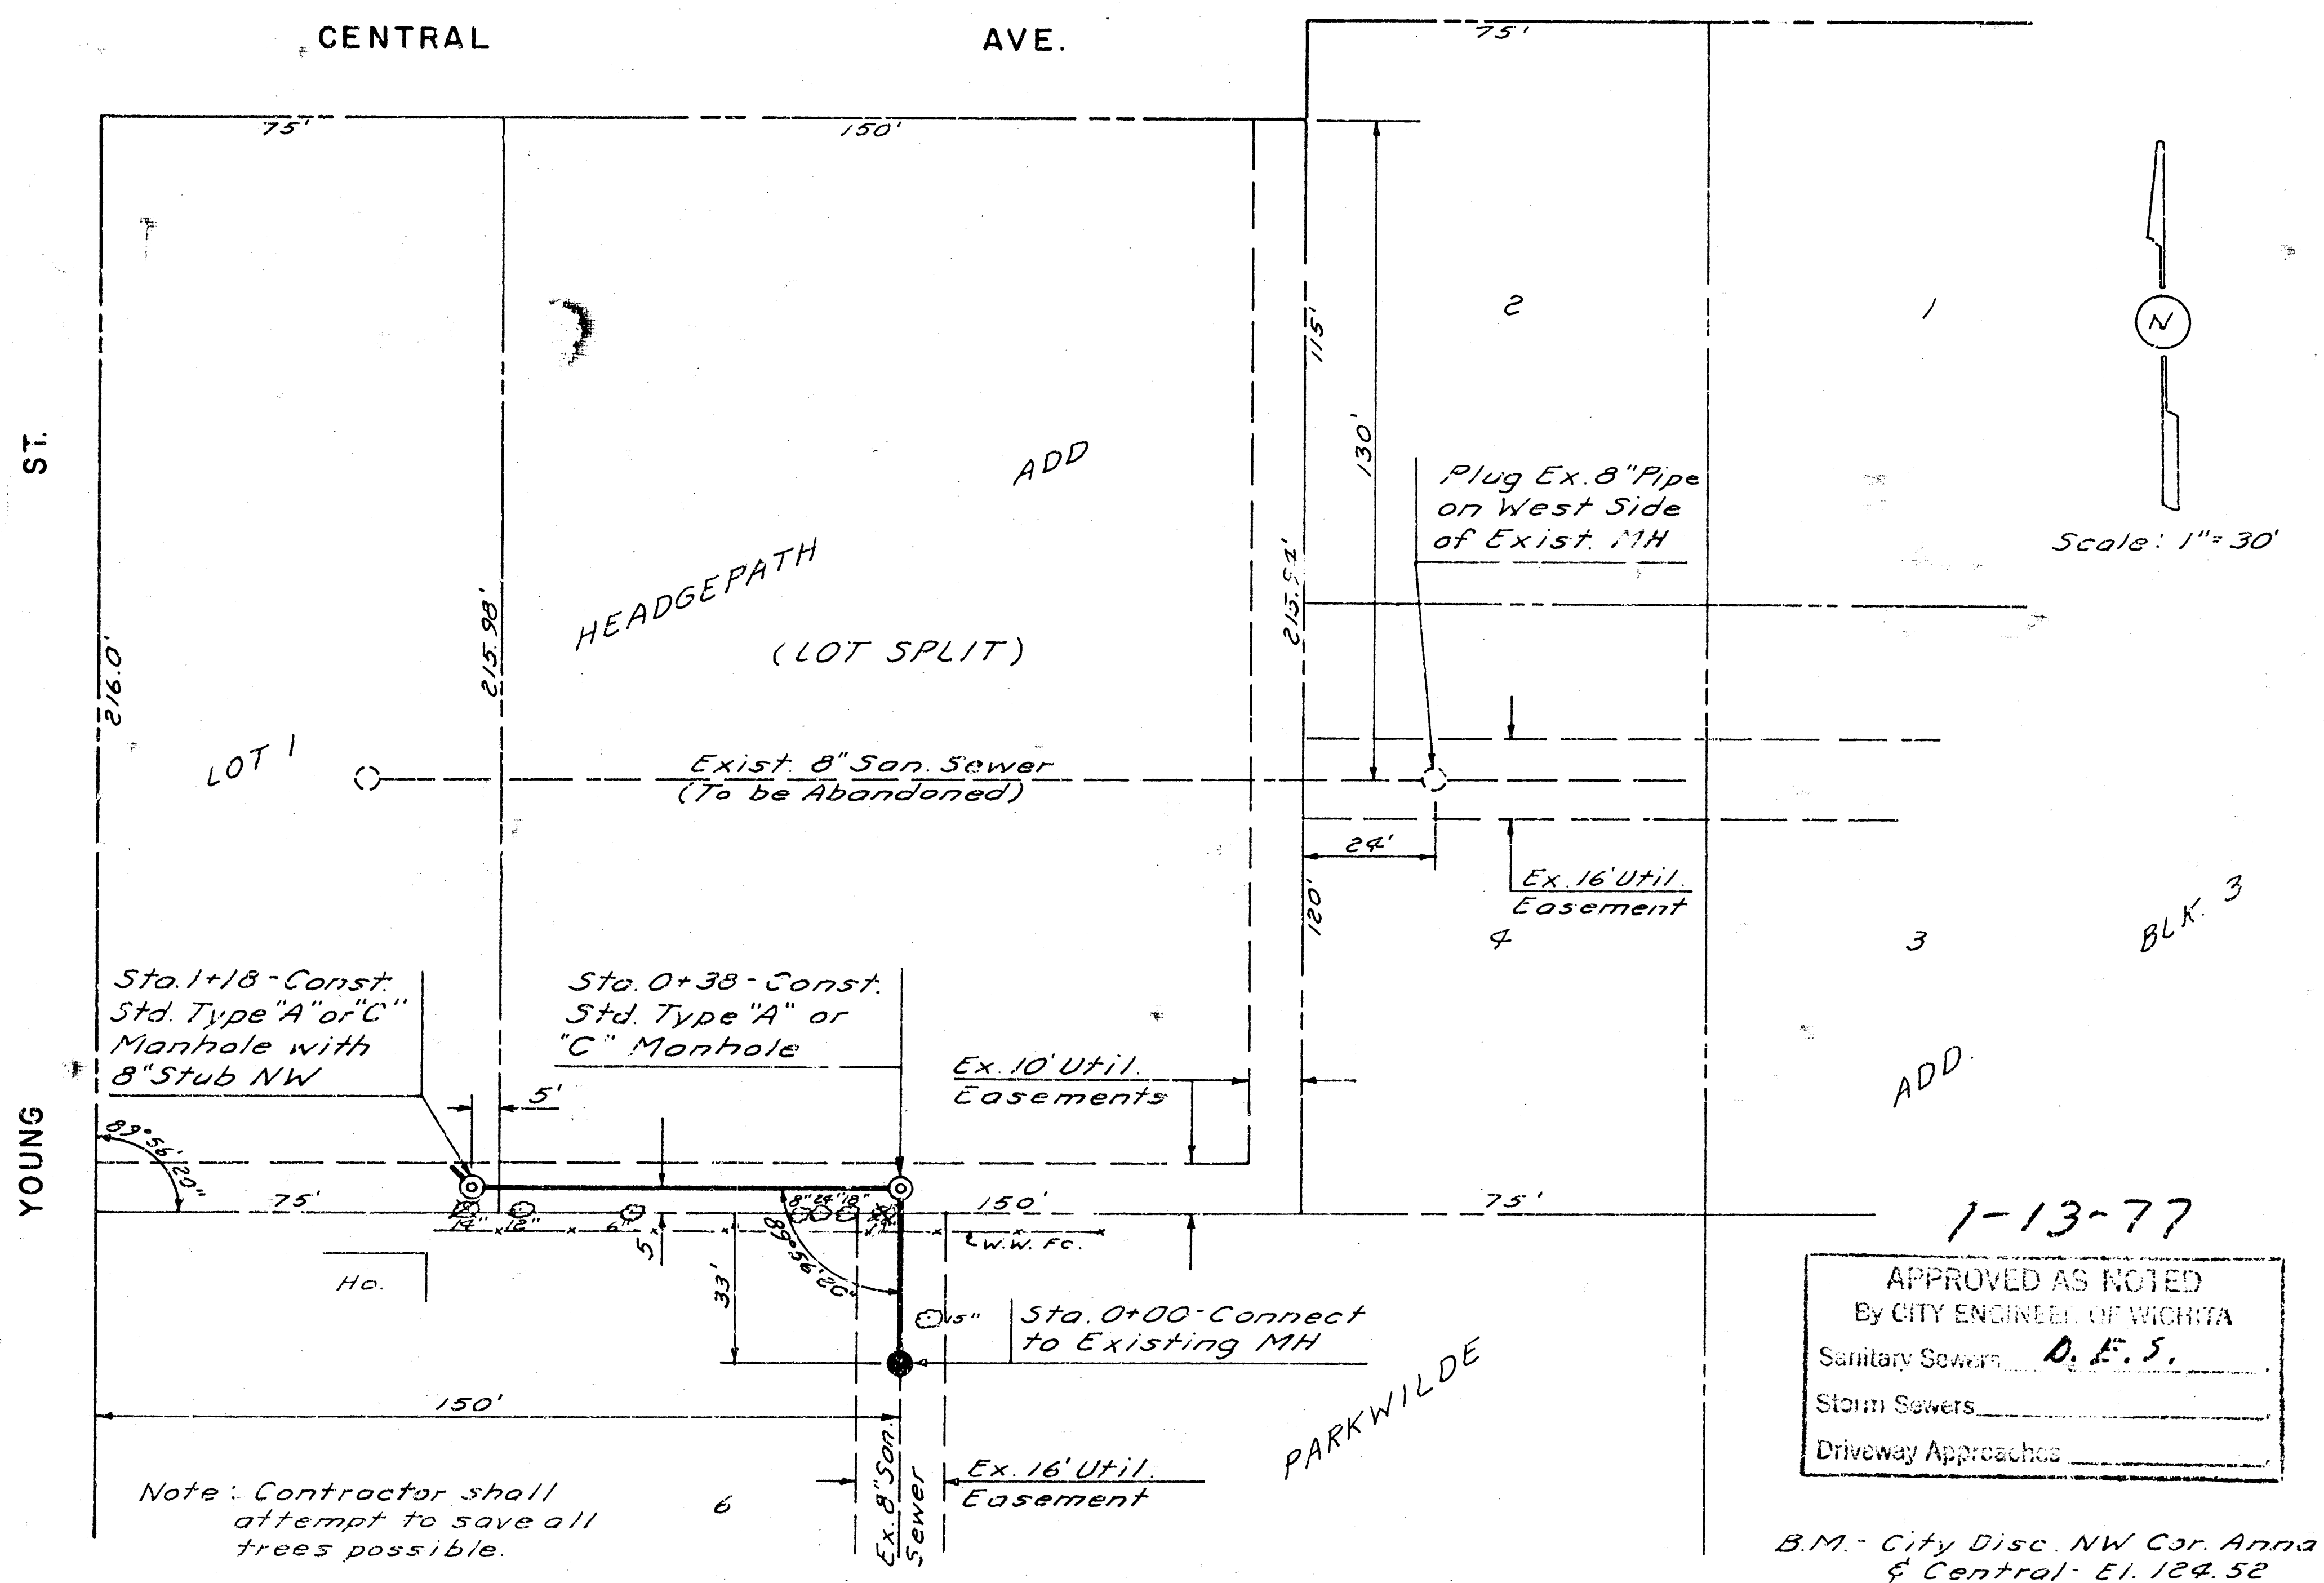

NOTE TO CONTRACTOR
This project will be constructed under the supervision of the CITY ENGINEER and conforming to the SPECIFICATIONS of the CITY OF WICHITA. THE CONTRACTOR will indemnify the City of Wichita for all cost of ~~inspection~~ inspection.

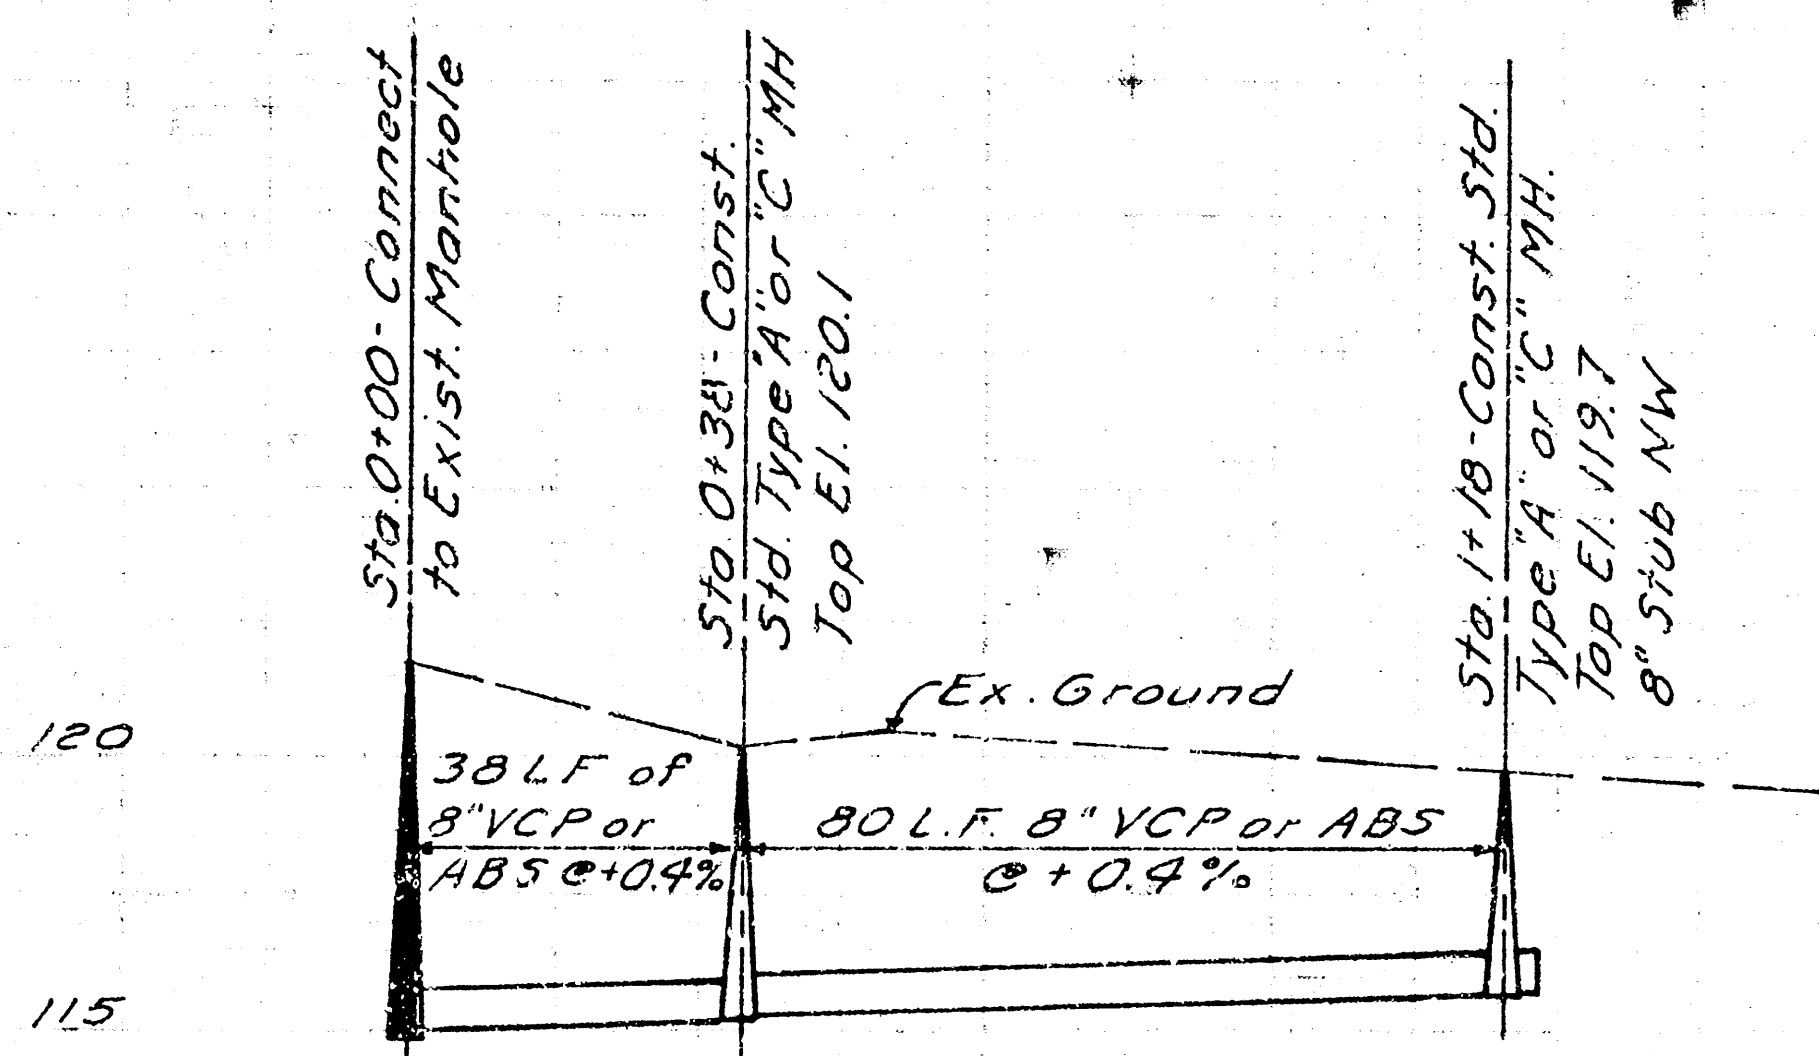

El. out 114.91
El. in 115.01

El. out 115.16
El. in 115.26

El. 115.36

El. out 115.58
El. in 115.68

CITY PROJ. NO. DBKW 707004
SANITARY SEWER TO SERVE
HEADGEPAH ADDITION