


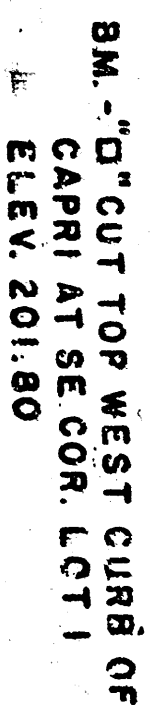

NOTE TO CONTRACTOR:

This project will be constructed under the supervision of the CITY ENGINEER and conforming to the SPECIFICATIONS of the CITY OF WICHITA. The CONTRACTOR will prepare the City of Wichita for all costs of inspection.



1st 20th 0th

21861

A circular professional engineer seal for N. Brent Wooten. The outer ring contains the text "N. BRENT WOOTEN" at the top and "PROFESSIONAL ENGINEER" at the bottom. The inner circle contains the text "KANSAS" on the left and "LICENSED" on the right, with the license number "8470" in the center.

**JEFF KREHBIEL
ASSOCIATES, aia**
architecture • planning

date drawn

prints issued
FOR CONSTRUCTION
32684

REV
Resite Bldg 5,
Revised Drain
& San. Sewer,
JUL 4-30-89

FINAL	DATE	BY	DATE
SURVEY			
NOTE BOOK			
NO.			

ORIGINAL	DATE	BY	DATE
SURVEY			
NOTE BOOK			
NO.			

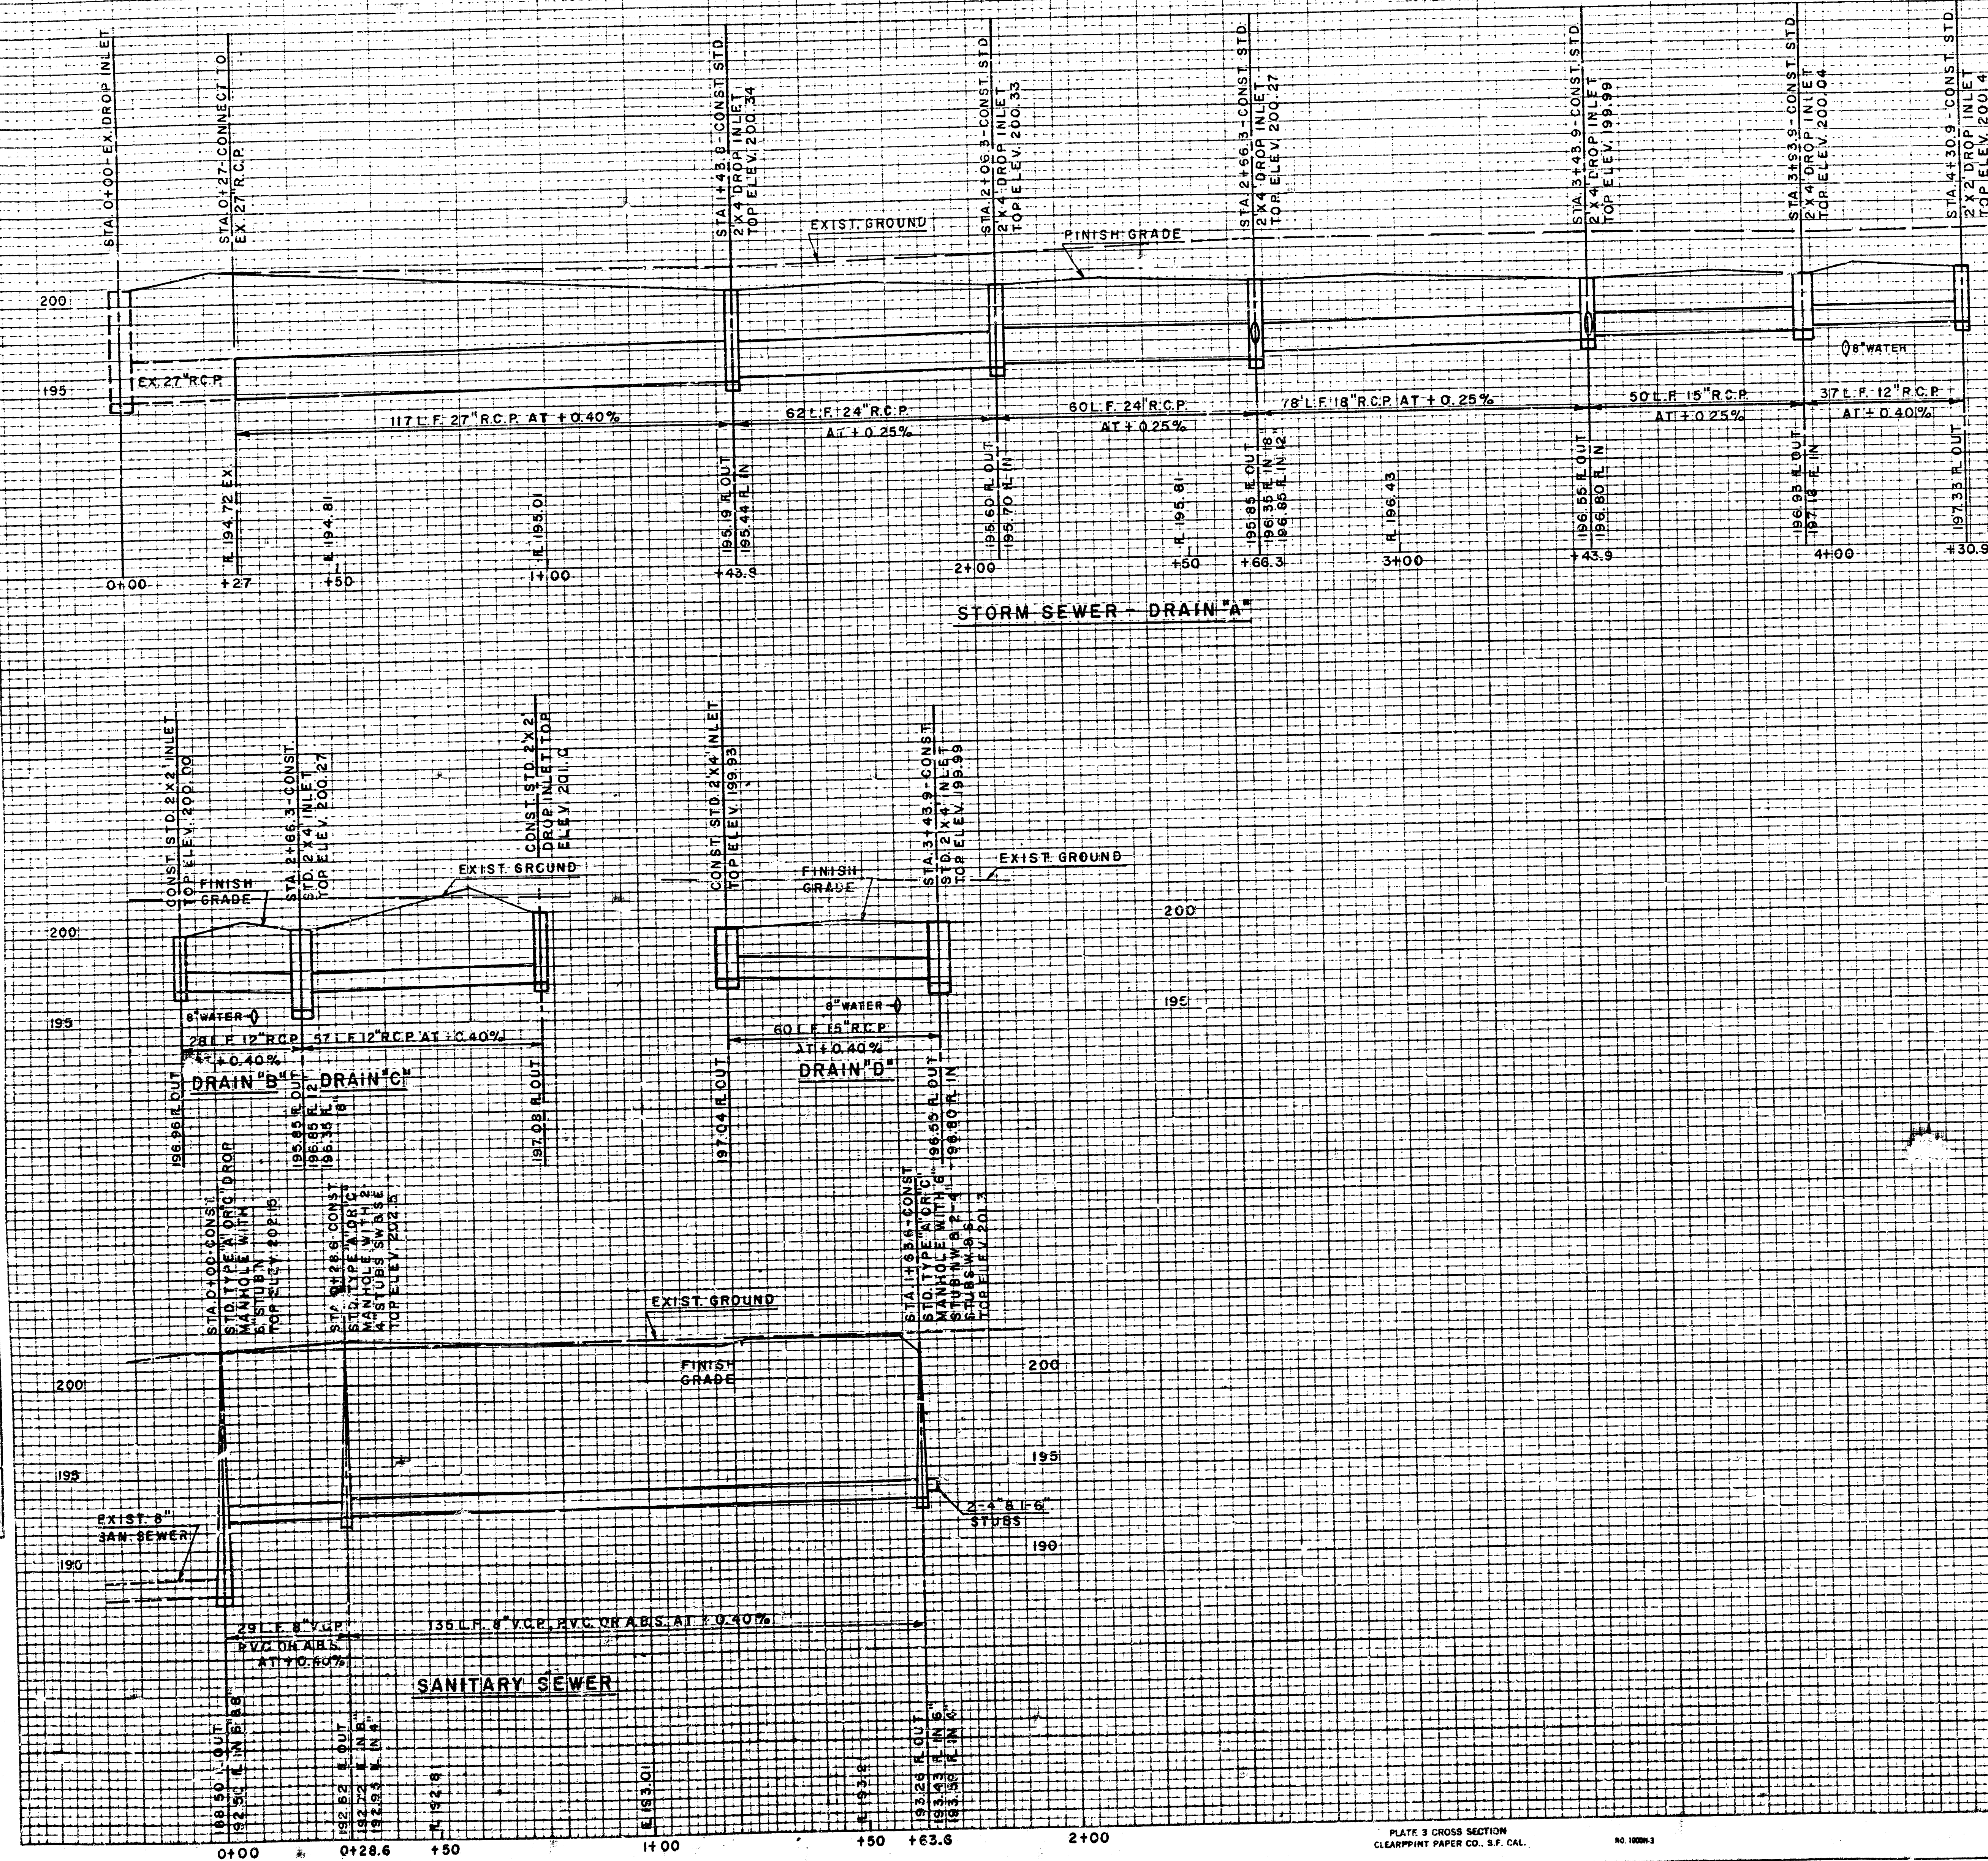


PLATE 3 CROSS SECTION
CLEARPRINT PAPER CO., S.F. CAL.

NO. 100001

BAUGHMAN COMPANY, P.A.
SURVEYING & ENGINEERING
3147 ASHLAND ST. - 3RD FLOOR - WICHITA, KANSAS 67211

14 8 3 8

prints issued
FOR CONSTRUCTION
5-26-84

revisions
Revise Drain C
& San. Sewer
5-1-84 JEL

date drawn

J&A
JEFF KREHBIEL
ASSOCIATES, aia
architecture · planning

1300 east lewis wichita, kansas 67211
(316) 267-8233

THE HIGHLANDS CONDOMINIUMS
PHASE V
SANITARY SEWER & STORM SEWER PROFILES
LOT 1, BLOCK 1, OAK KNOLL ADDITION

PAWNEE & CAPRI
WICHITA, KANSAS

sheet title

sheet

SU-3

of 3/2 sheets