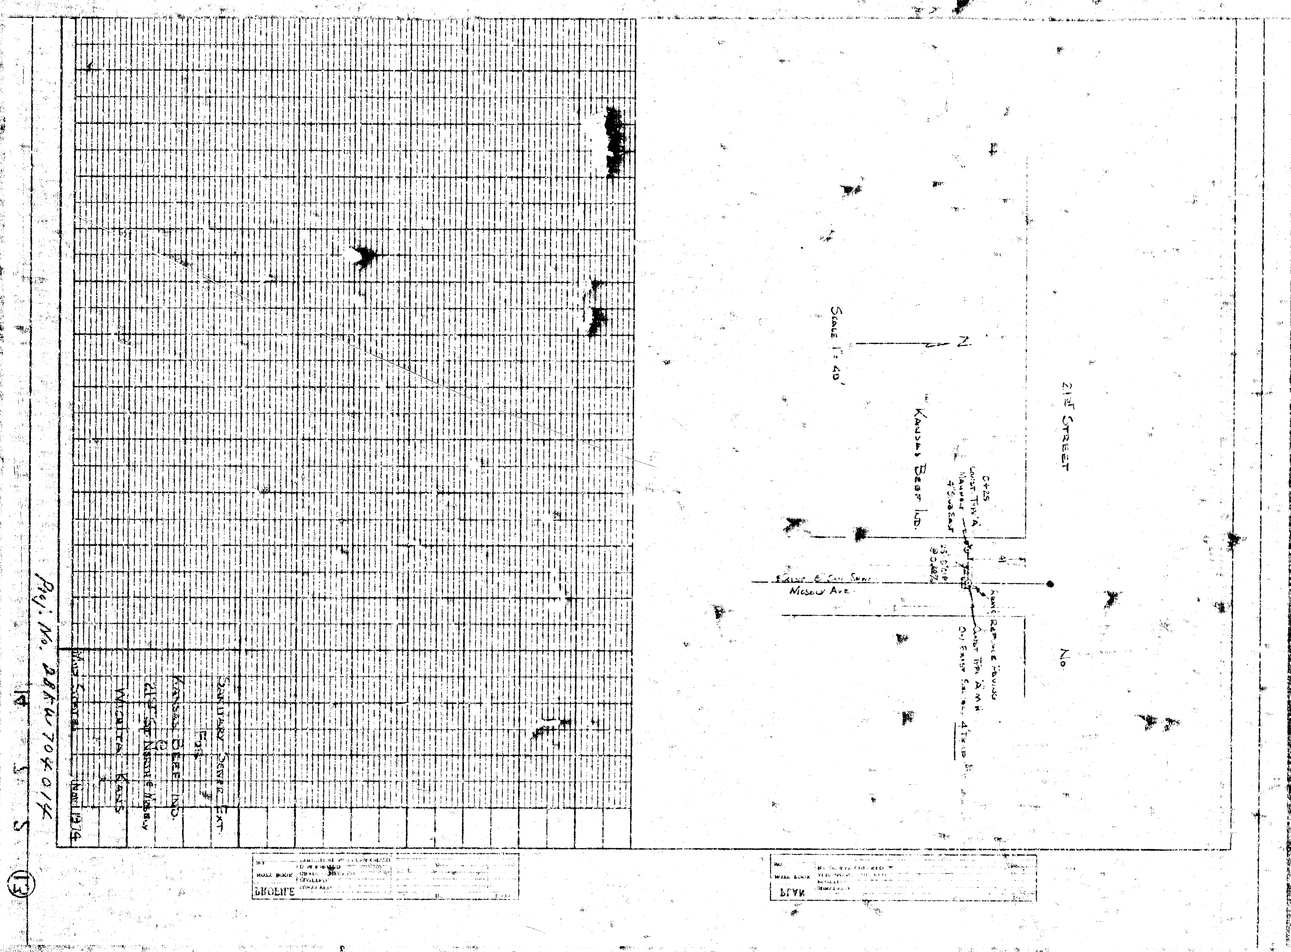
21st Street
Kansas Beer Ind.
Bear Ind.
Scale 1" = 40'
N
Missouri Ave.
Sanitary Sewer Est.
Kansas Beer Ind.
Wichita Kans.
Rev. No. 88FN704014
BROLITE
LEAR