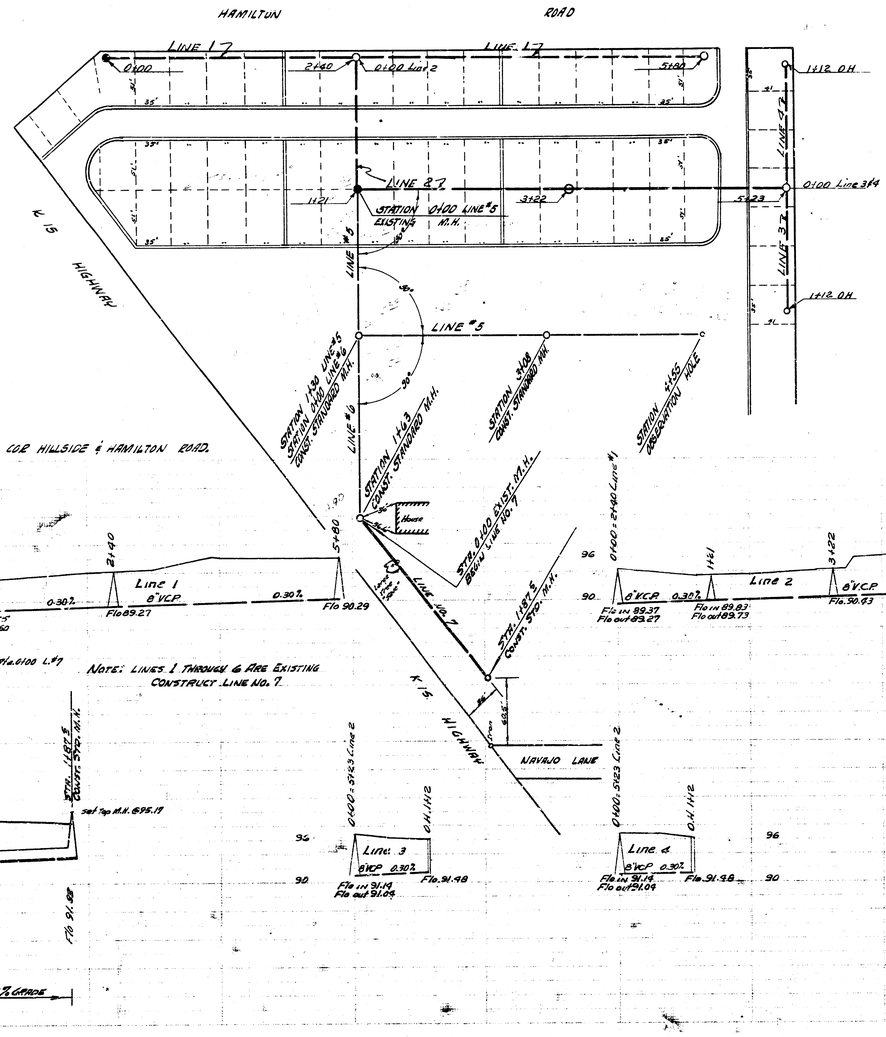

PLAN SCALE 1"=50'

NOTE TO CONTRACTOR

This project will be constructed under the supervision of the CITY ENGINEER and conformance to the SPECIFICATIONS of the CITY OF WICHITA, KANSAS. The CONTRACTOR is not relieved of responsibility for the correctness of the plans by the approval of the CITY ENGINEER.

NOTE:
THE FOLLOWING SCALES ARE USED ON LINES 5 & 6 & 7
PLAN SCALE 1" = 50'
PROFILE SCALE 1" = 80' HOR., —(1"=40' HOR. LN. #7)
1 = 4 VERT.

B.E. SMITH 435 REGISTERED ENGINEER

K & R TRATEL SAN. SEWER

ADDITION OF LINE 7
PRIVATE JOB
DATE - DECEMBER 1963

ADDITION OF LINES 3 & 6 TO THE K & R TRATEL SAN. SEWER
CITY OF WICHITA, KANSAS
B.E. SMITH CITY ENGINEER
PRIVATE JOB DATE - OCTOBER 1958

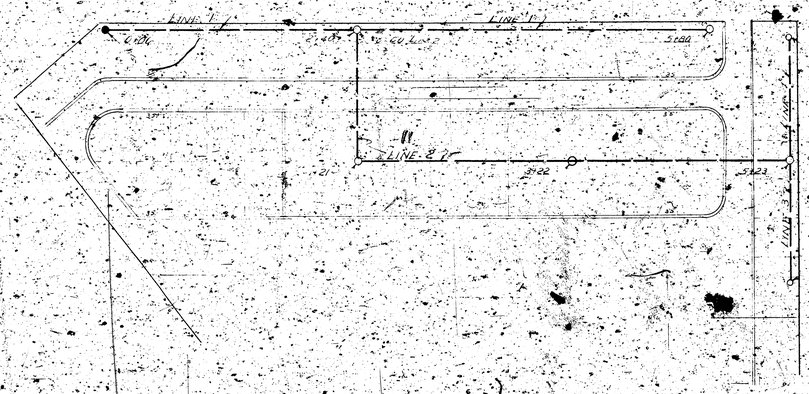
LINE 1
LINE 1A
5000
LINE 2
5122
5123
1512.01
0100 Line 3A
1112.02
LINE 3

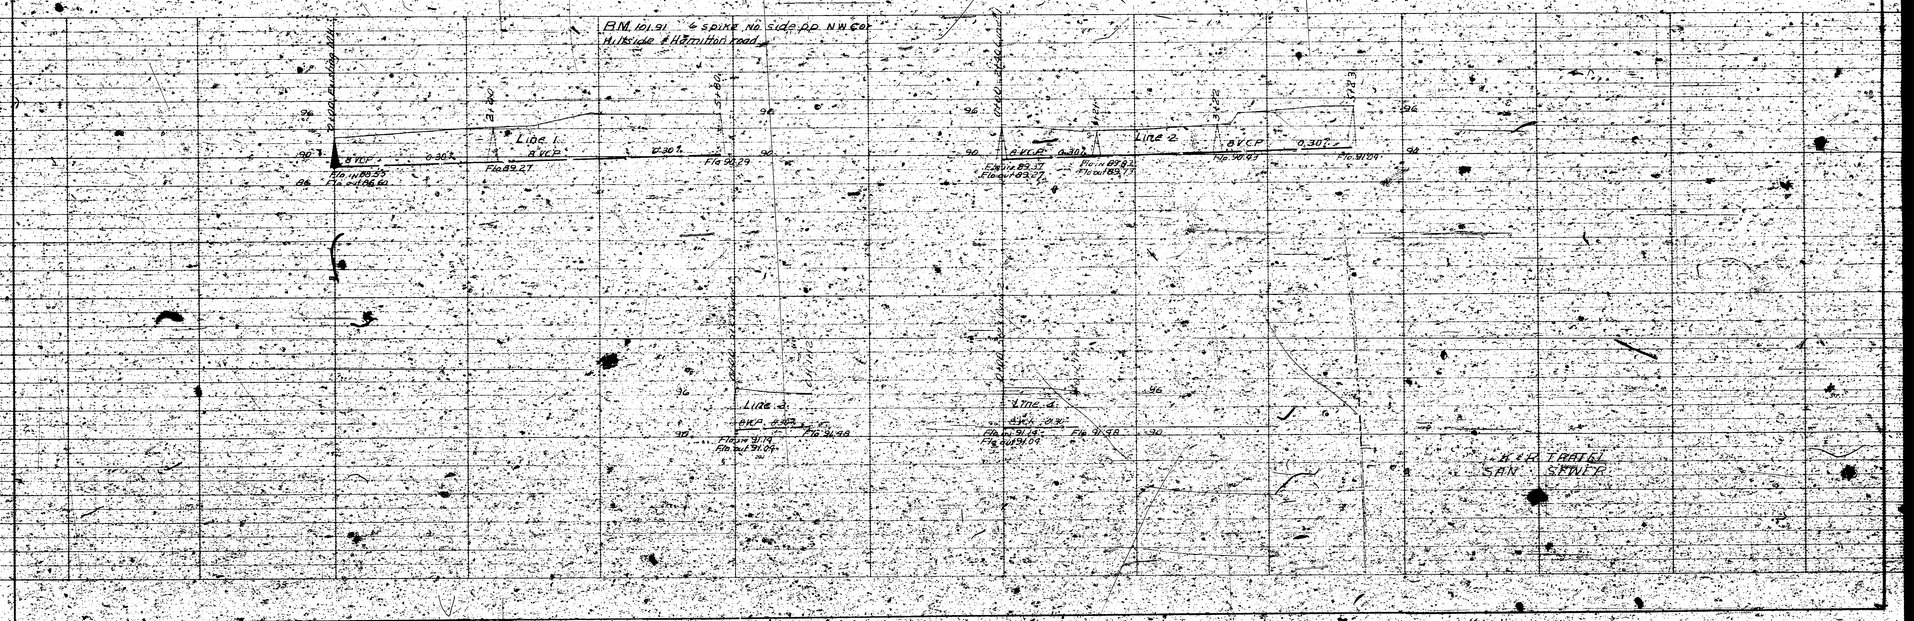
B.M. 101.91 6 spike No. side AP NW Co.
Hillside & Hamilton road
Line 1.
8"VCP
0.36%
Fl@89.27
0.30%
Fl@90.29
Fl@88.35
Fl@86.60
Line 2.
8"VCP
0.30%
Fl@90.43
Fl@91.54
Fl@87.82
Fl@85.17
Line 3.
8"VCP
0.30%
Fl@91.28
Fl@91.04
Fl@91.14
Fl@91.48
Fl@91.18
Fl@91.04
SAN. SEWER