





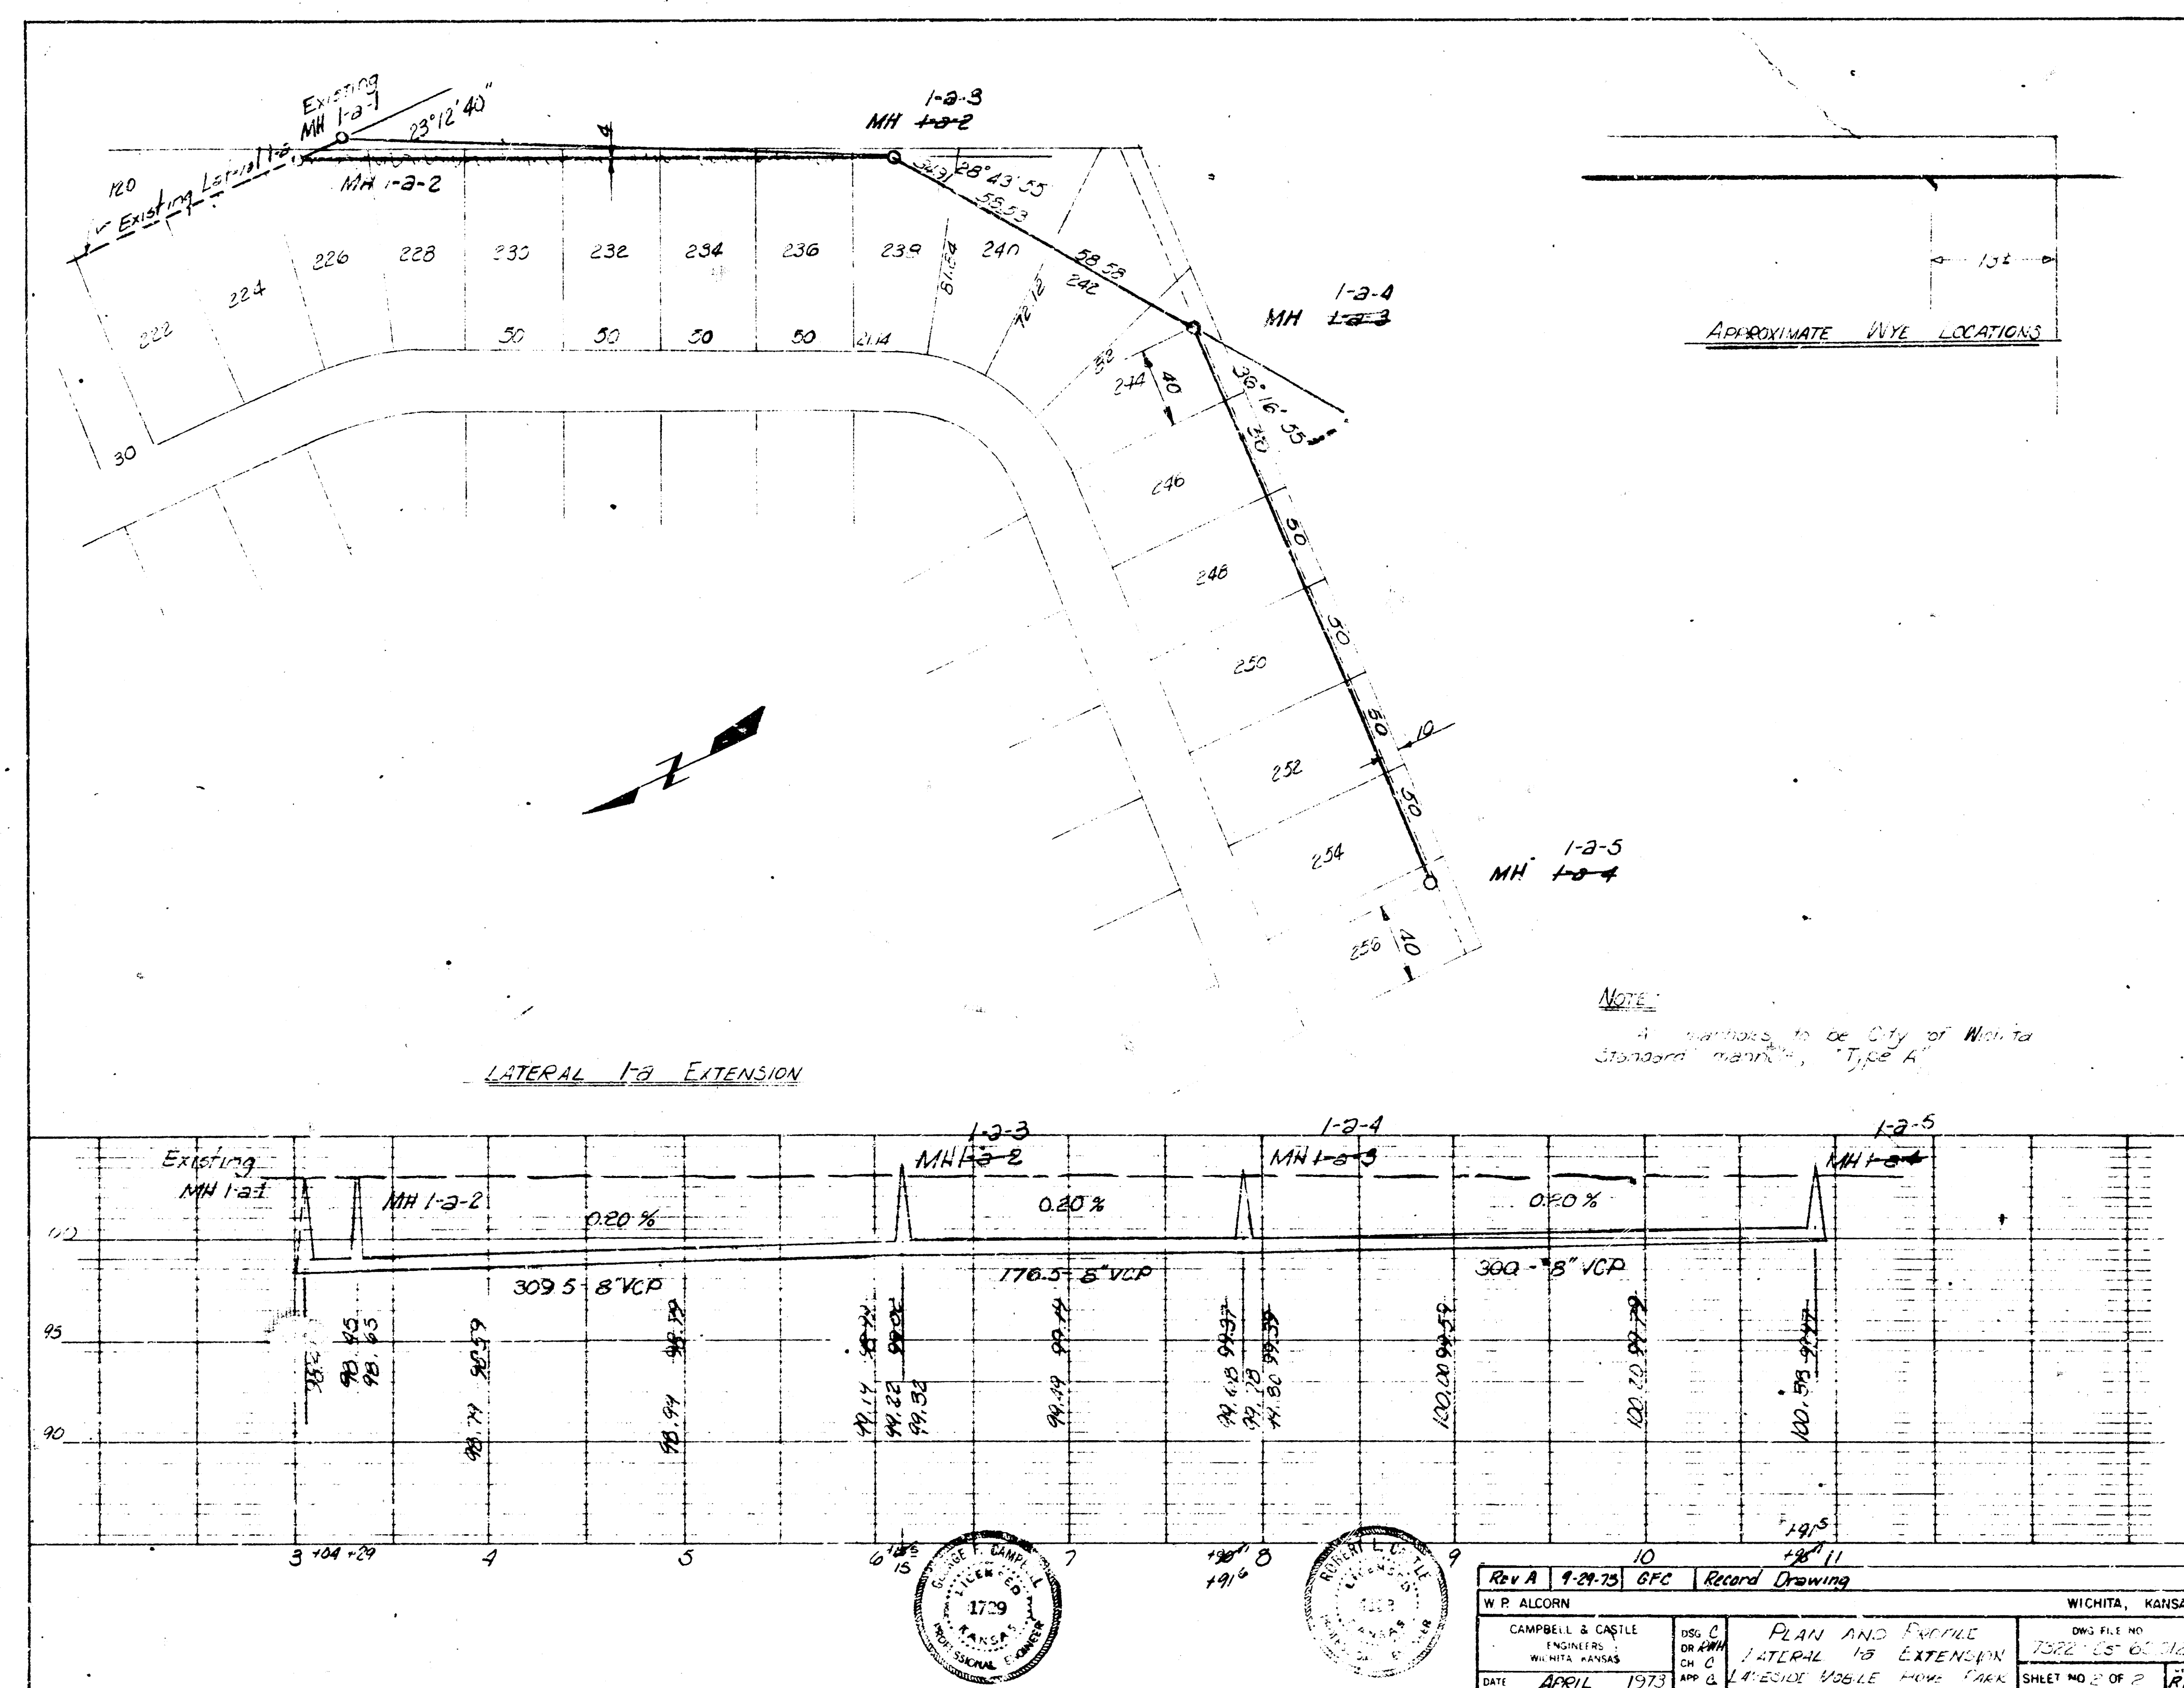

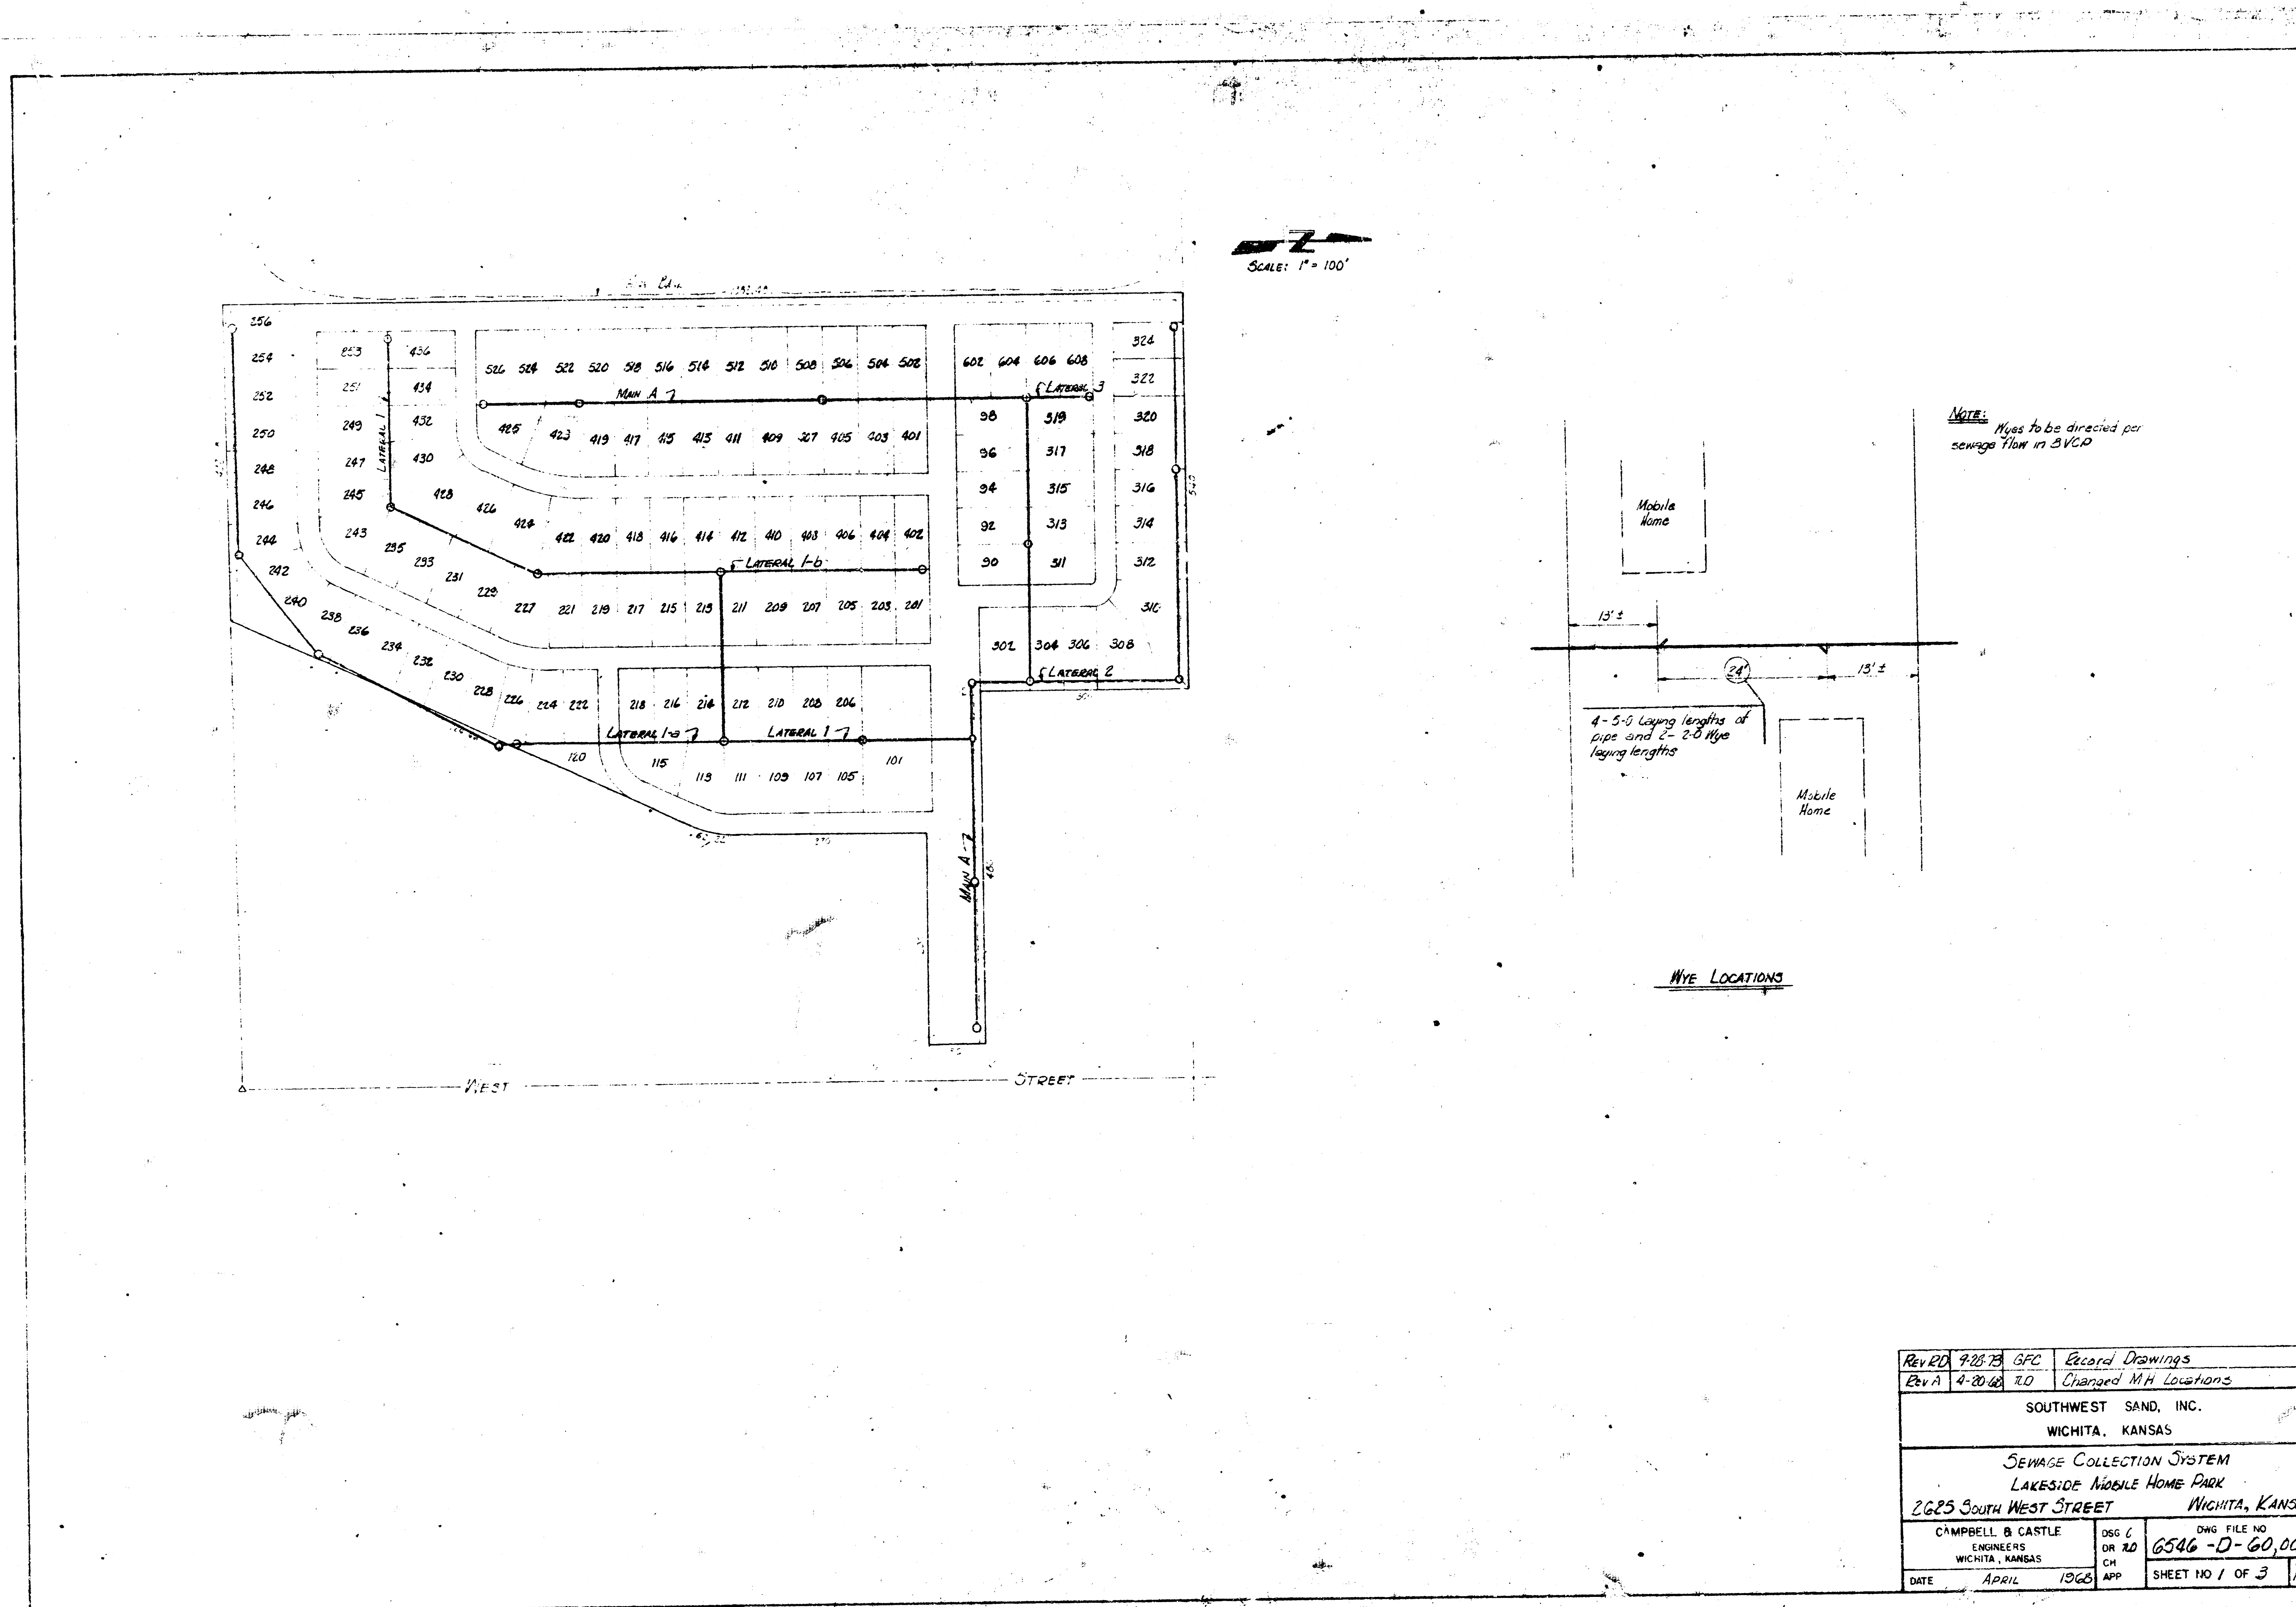


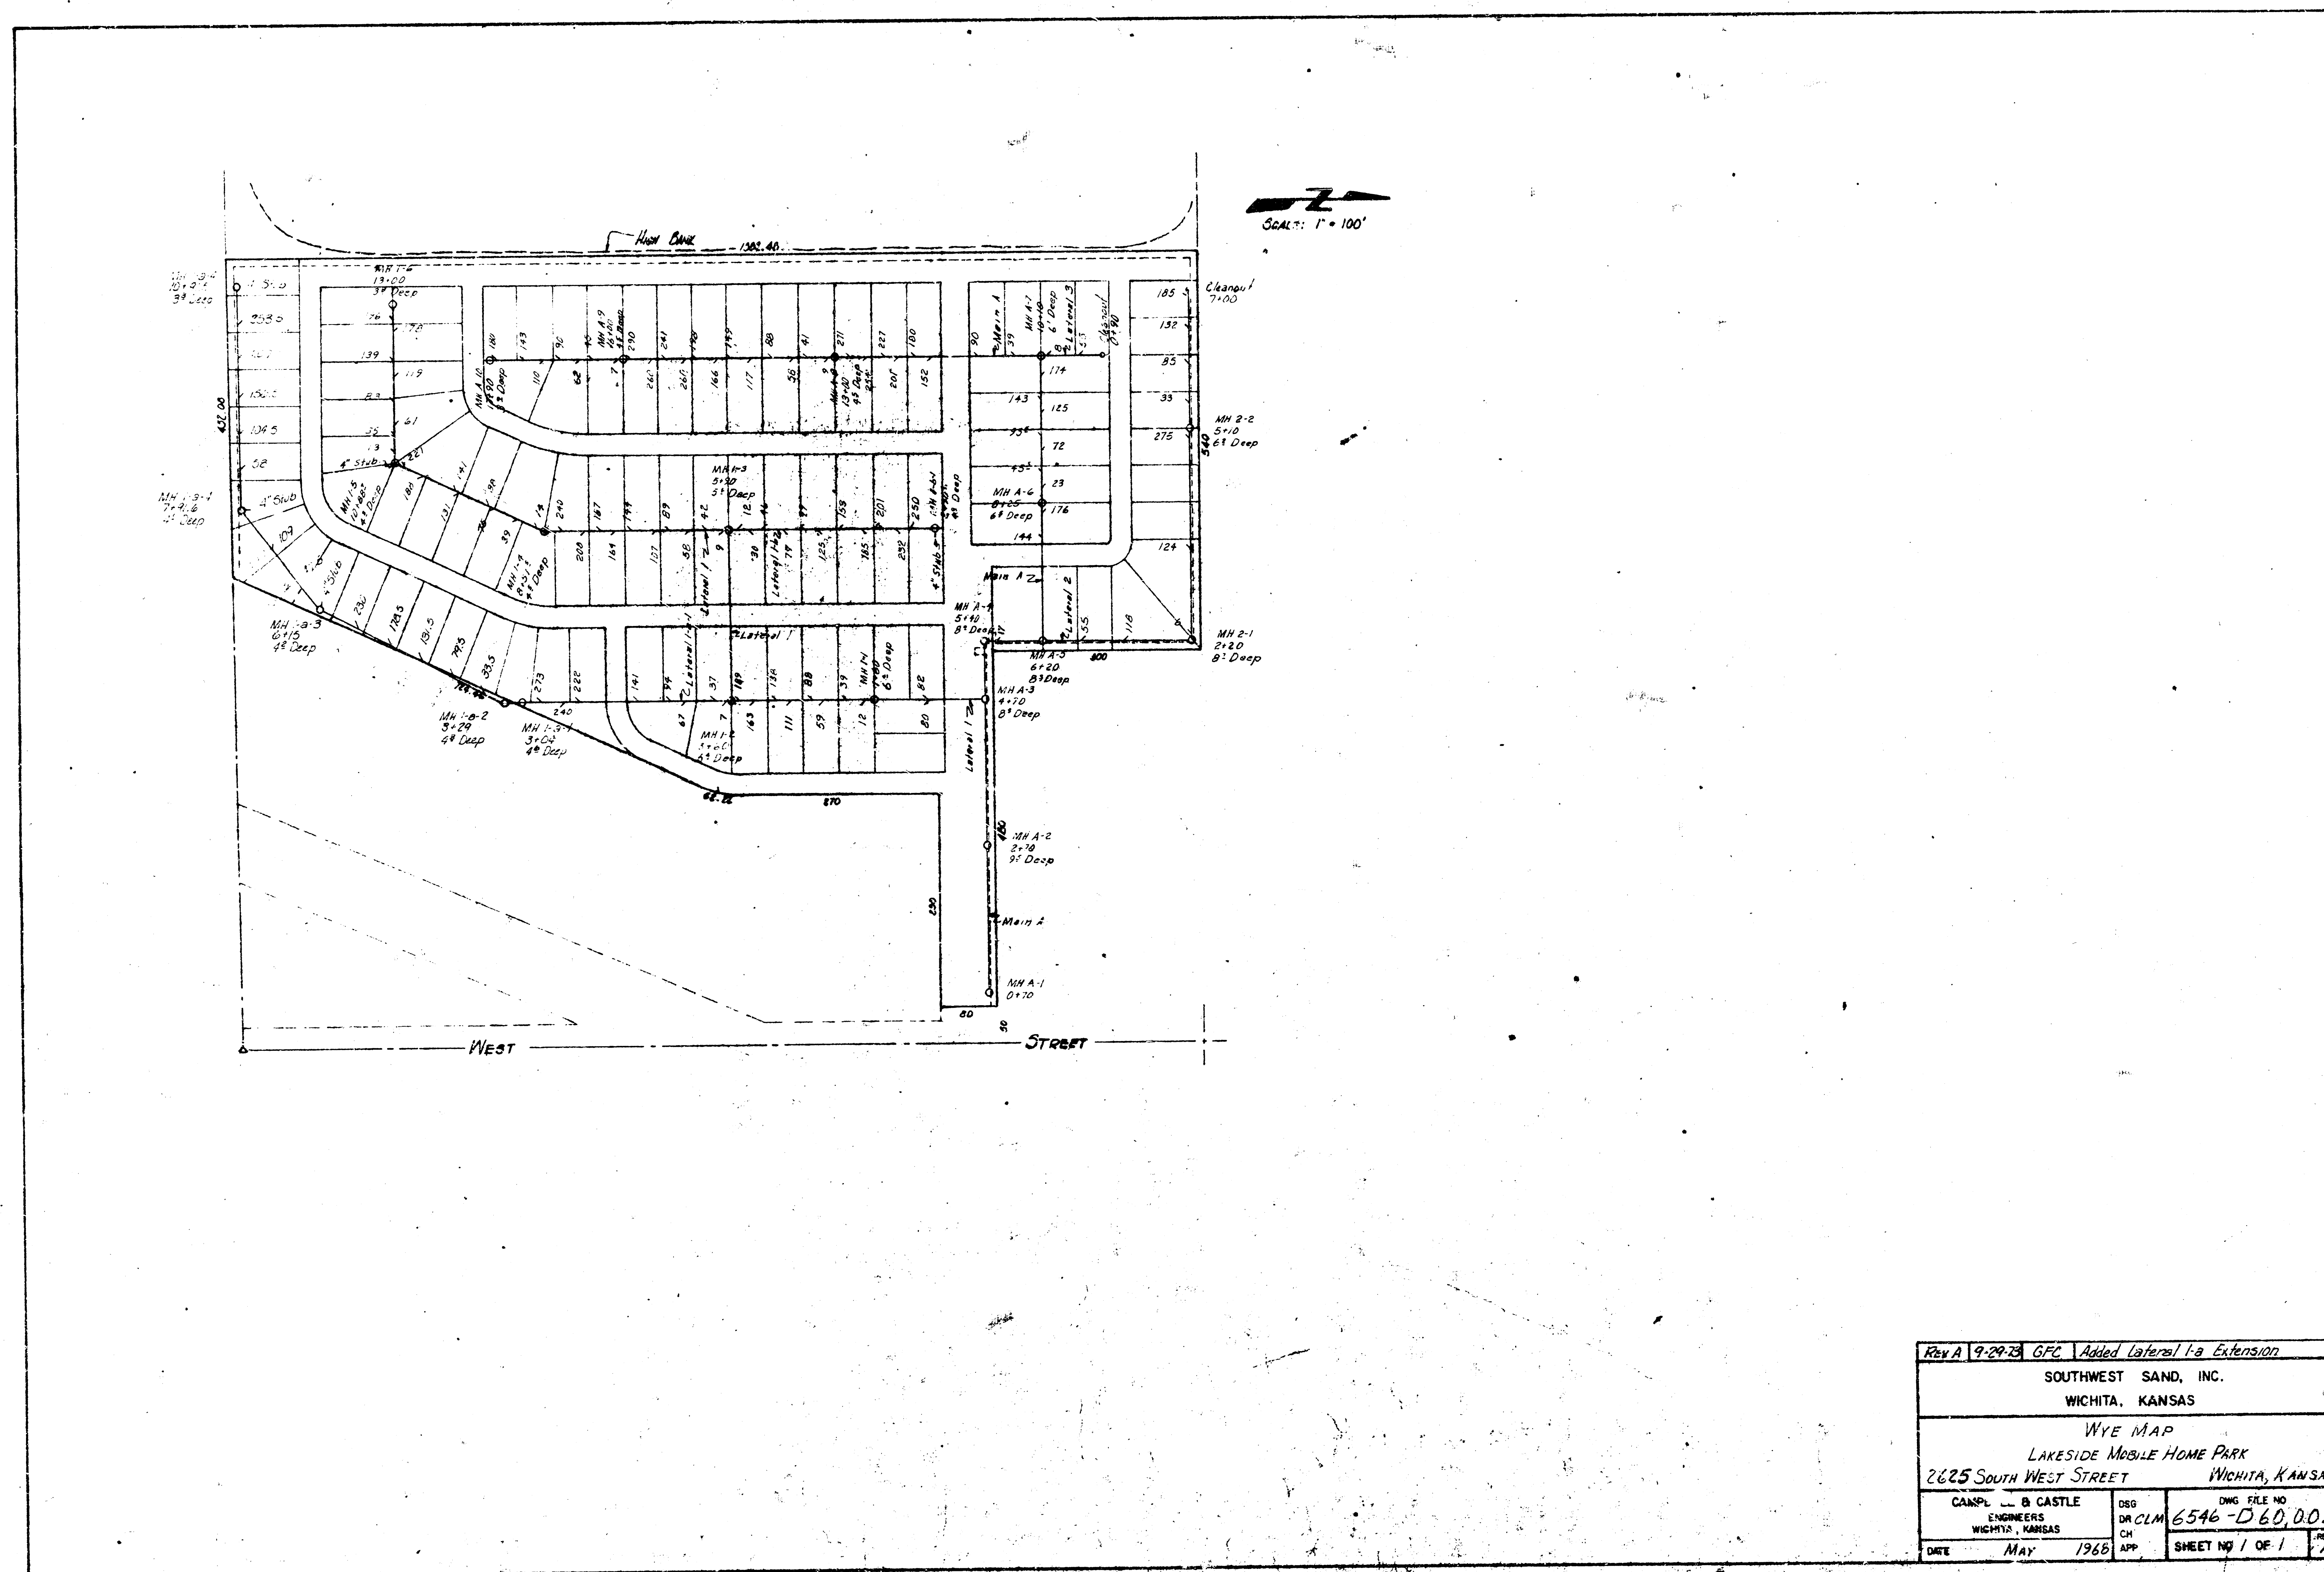


Rev A 9-29-73 GFC Added Lateral 1a Extension			
SOUTHWEST SAND, INC.			
WICHITA, KANSAS			
WYE MAP			
LAKESIDE MOBILE HOME PARK			
2625 SOUTH WEST STREET WICHITA, KANSAS			
CANPL. B. CASTLE	DSG	DWG. FILE NO.	
ENGINEERS	DR. CLM	6546-D60,009	
WICHITA, KANSAS	CH		
DATE MAY 1968	APP.	SHEET NO. 1 OF 1	REV. A

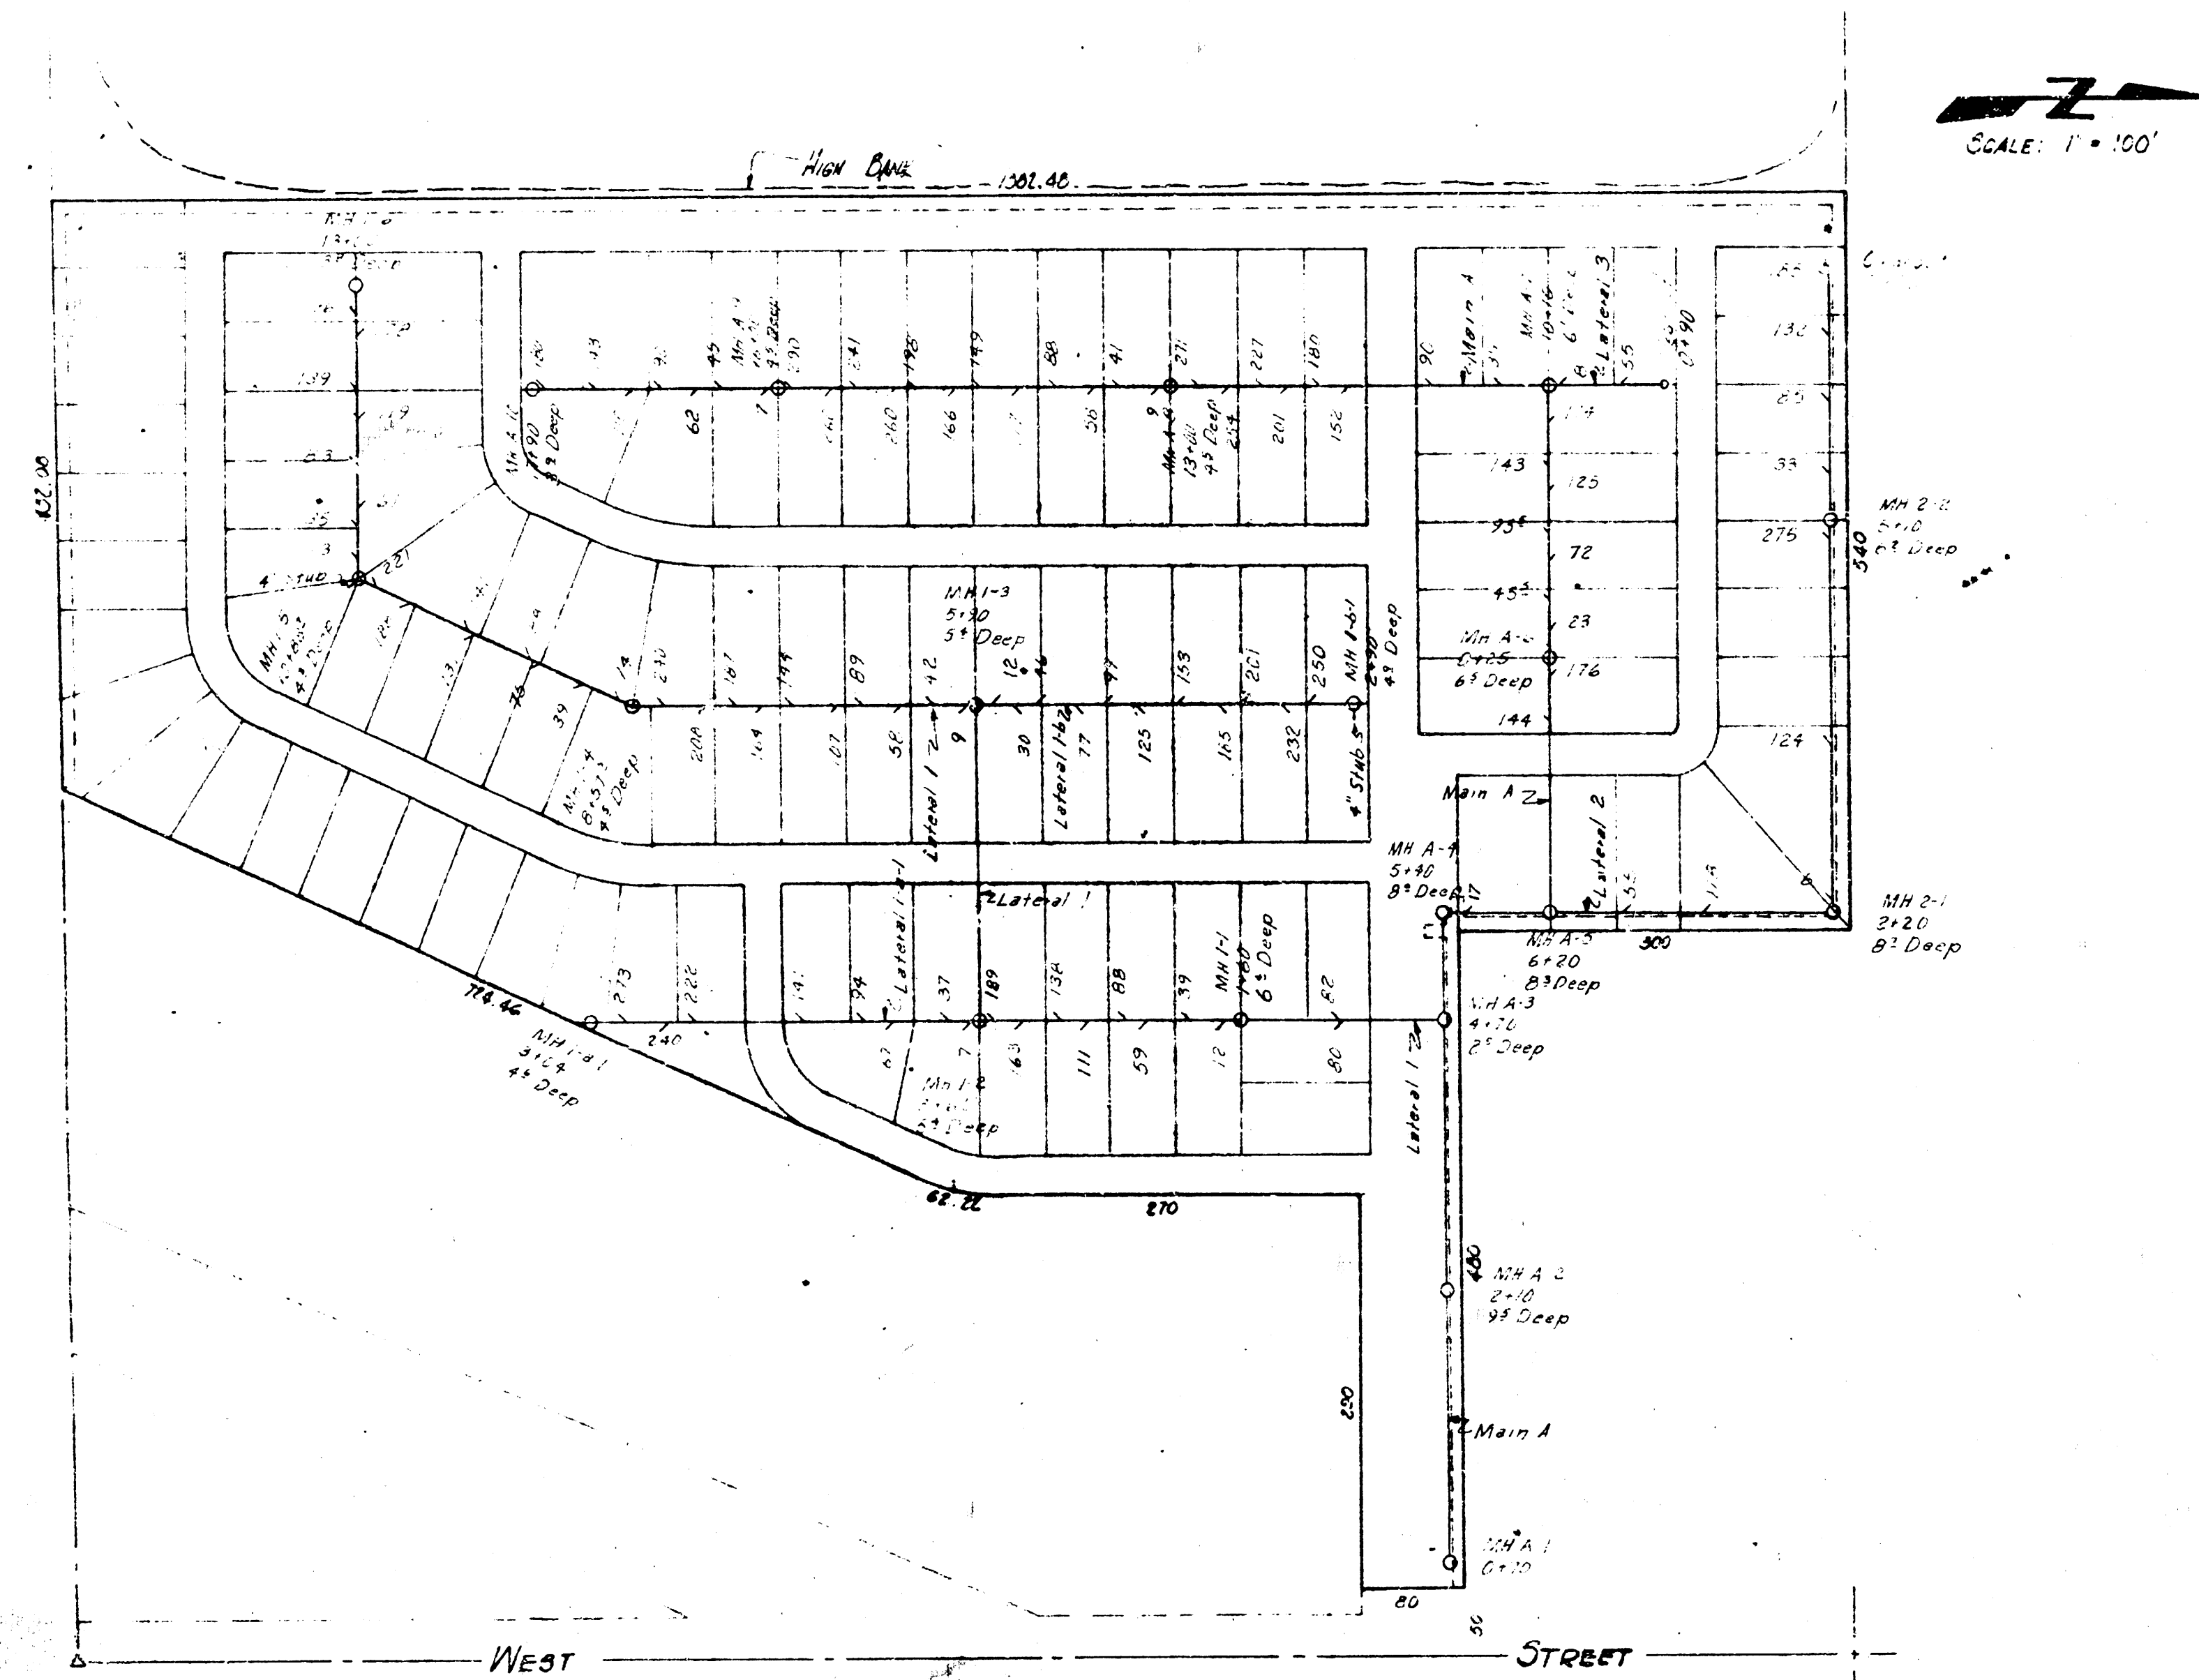

SOUTHWEST SAND, INC. WICHITA, KANSAS			
WYE MAP LAKESIDE MOBILE HOME PARK 2625 SOUTH WEST STREET WICHITA, KANSAS			
CAMPBELL & CASTLE ENGINEERS WICHITA, KANSAS	DSG DR CLM CH APP	DWG. FILE NO. 6546-D60,009	REV.
DATE MAY 1968		SHEET NO 1 OF 1	

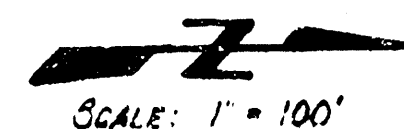


SOUTHWEST SAND, INC.			
WICHITA, KANSAS			
WYE MAP			
LAKESIDE MOBILE HOME PARK			
2625 SOUTH WEST STREET		WICHITA, KANSAS	
CAMPBELL & CASTLE ENGINEERS WICHITA, KANSAS		DSS OR CH APP	DWG FILE NO 6546 -D 60,009
DATE	May 1968	CH	SHEET NO / OF 1 REV

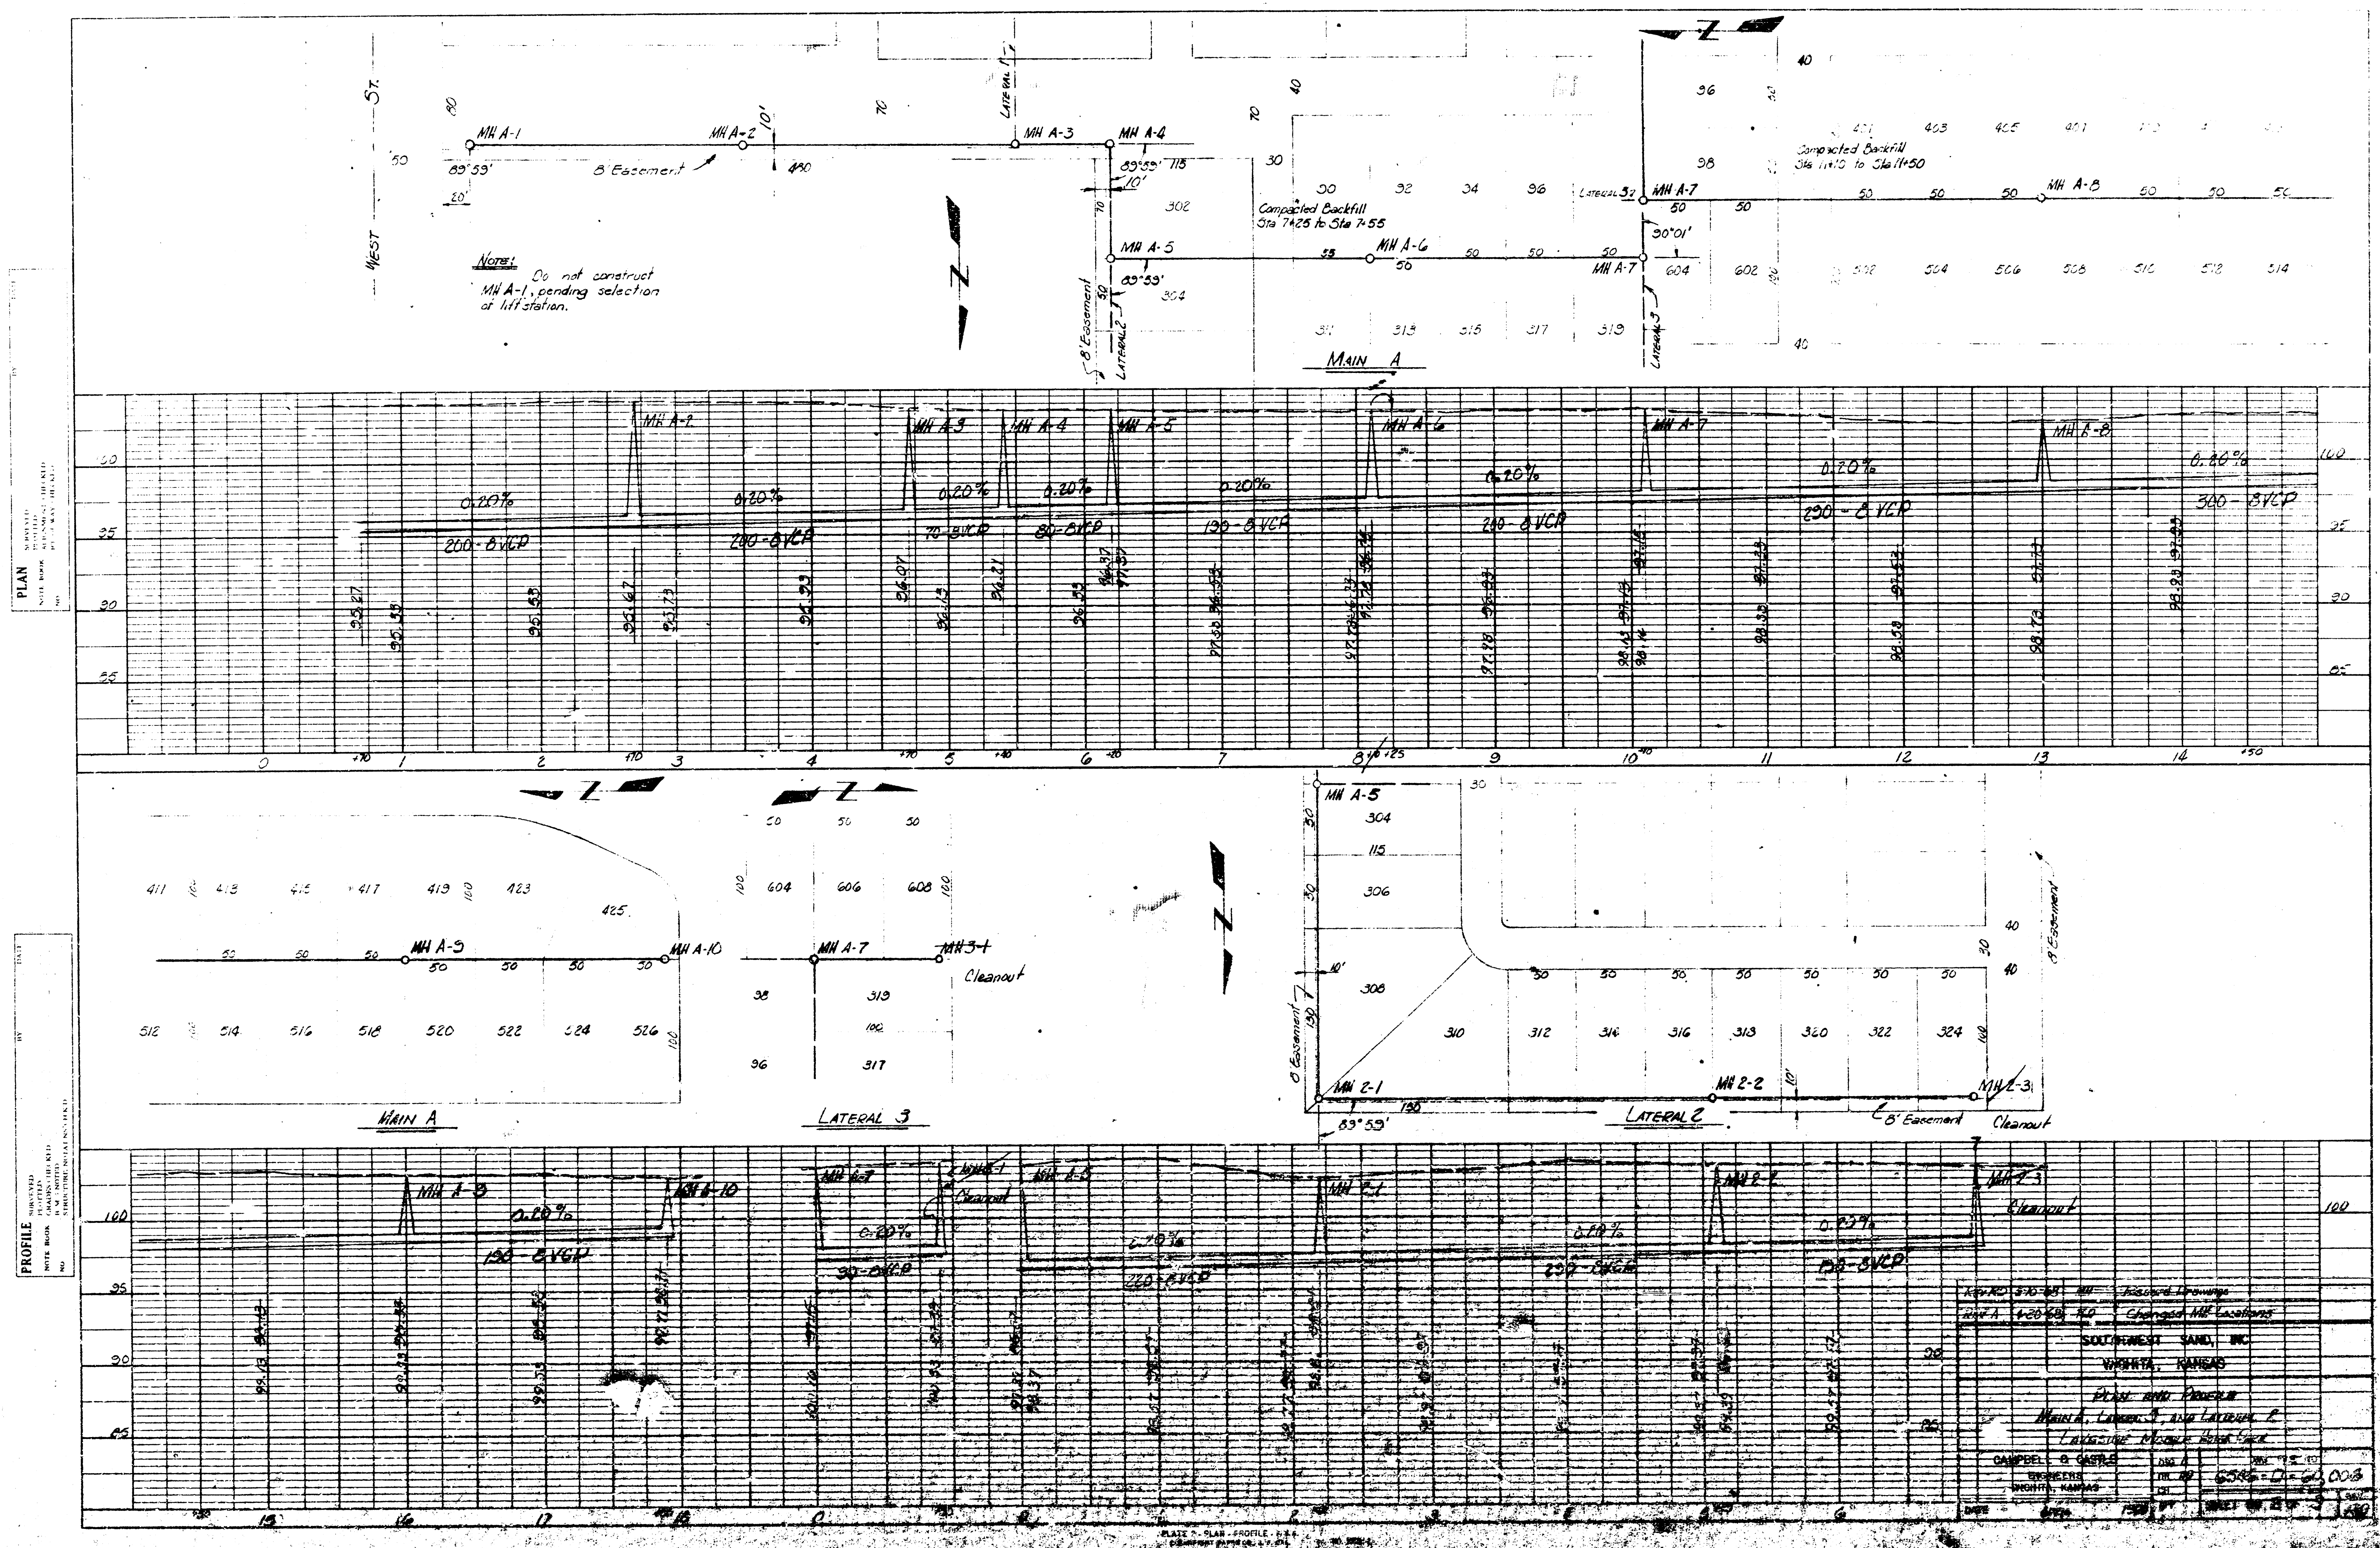

PLAN
 1" = 100'
 1" = 100'


PROFILE
 1" = 10'
 1" = 10'

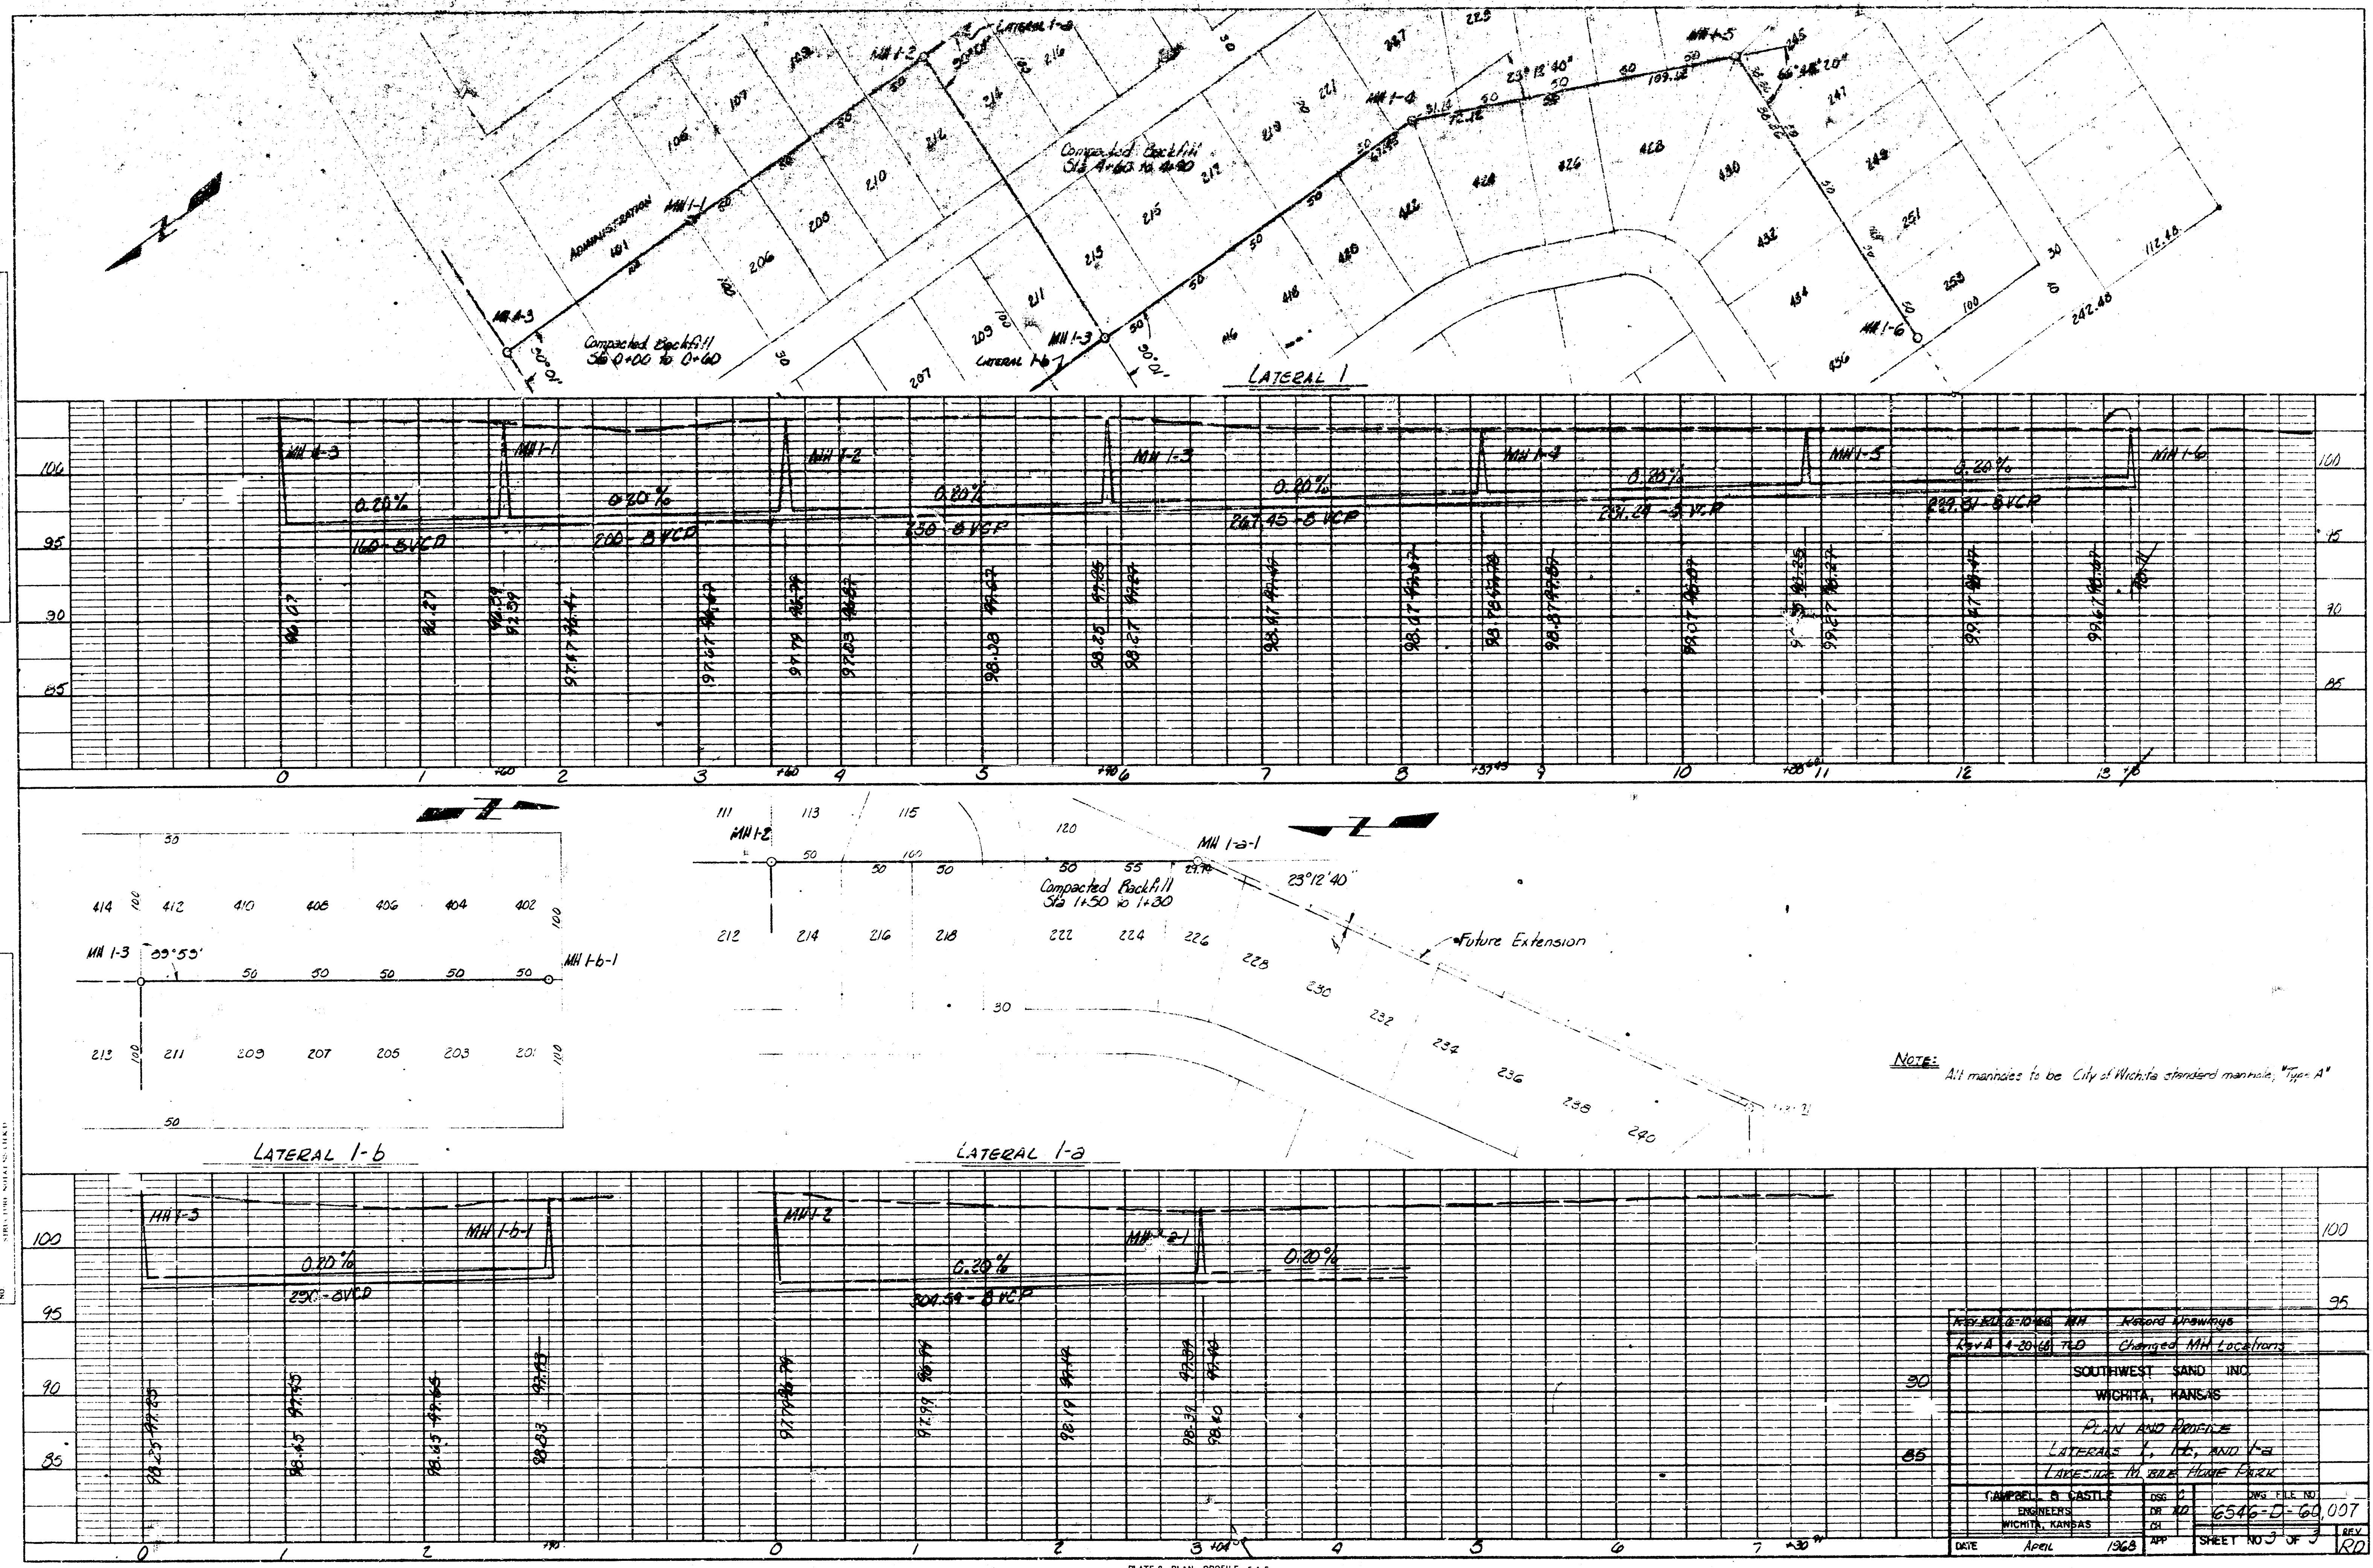

REVISIONS	NO.	DATE	BY	REVISION
1	1	10/18/60	W.H.	Revised Drawings
2	2	11/10/60	W.H.	Changed MH Locations
SOUTHWEST SAND INC.				
WICHITA, KANSAS				
PLAN AND PROFILE				
LATERALS 1, 1-b, AND 1-a				
LATERALS 1b AND 1a				
ENGINEERS	DR. BY	10/18/60	6546-D-60	007
WICHITA, KANSAS	CHECKED BY			
	DATE	10/18/60	SHEET NO. 3 OF 3	REV. 100

PLAN	DATE	7-26-68
	BY	R. S. SELLERS
NOTE BOOK	NO.	
	DATE	


PROFILE	DATE	7-26-68
	BY	R. S. SELLERS
NOTE BOOK	NO.	
	DATE	

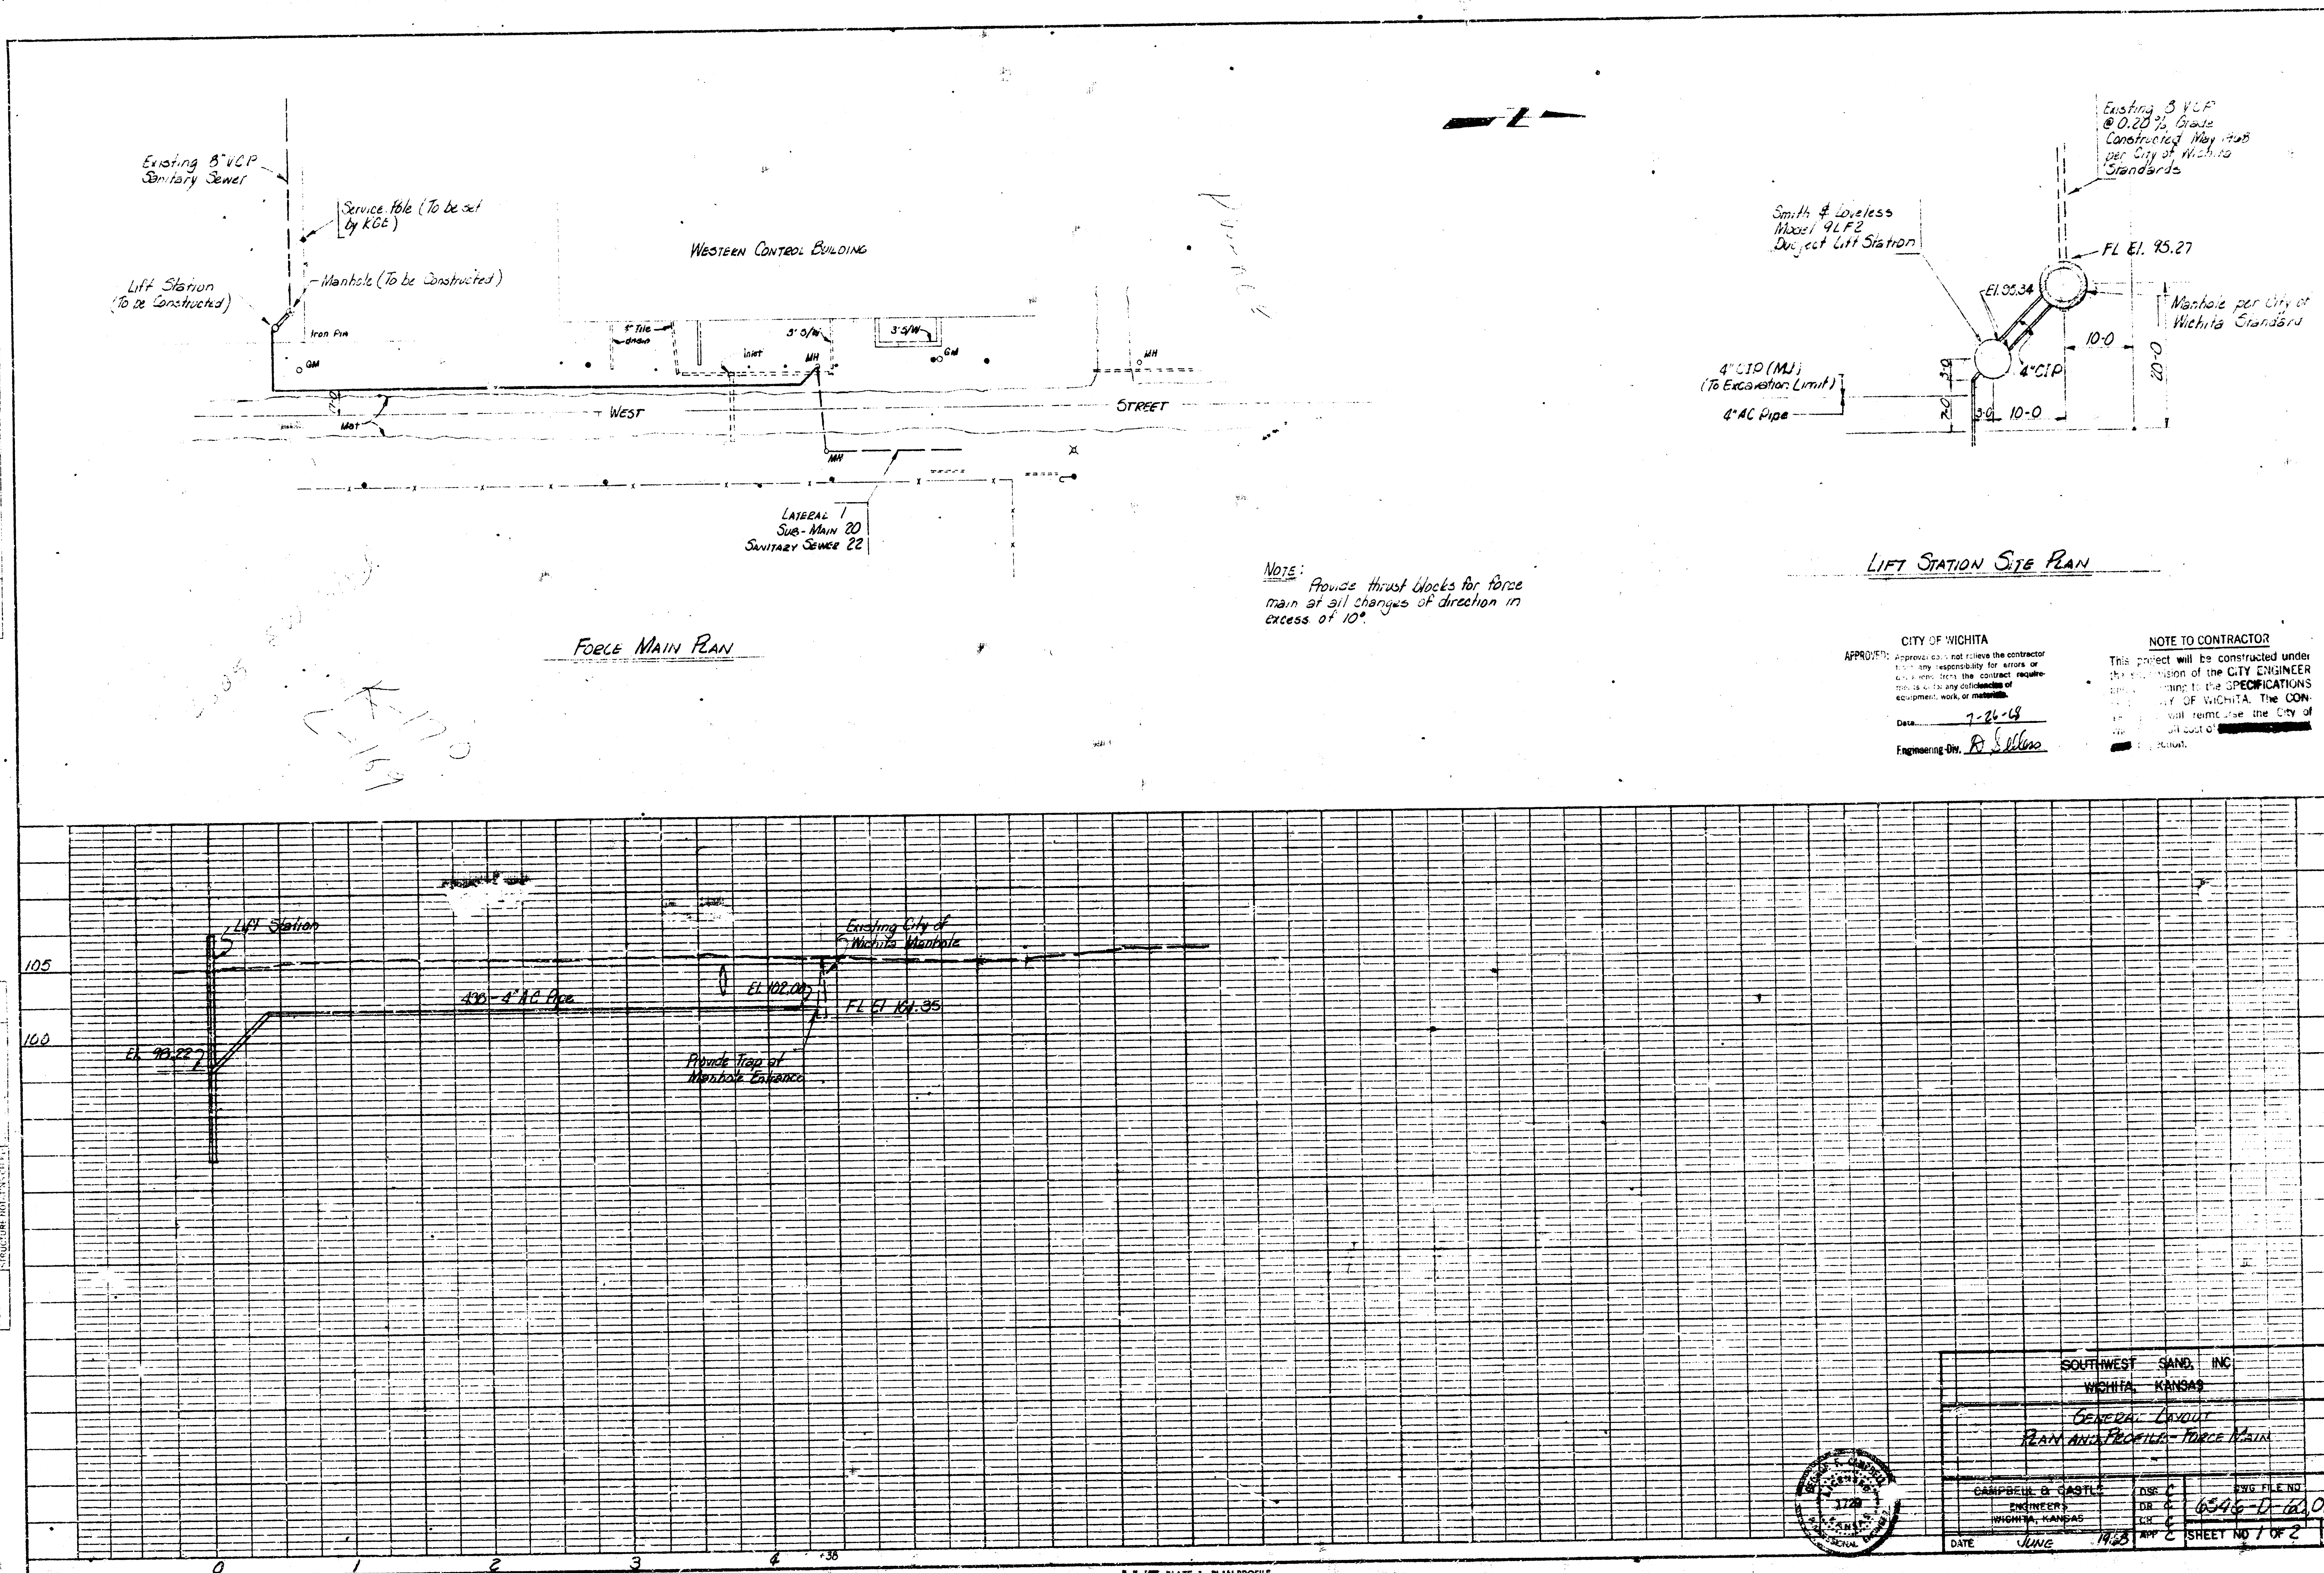



K-E PLATE 1, PLAN/PROFILE
K&E ENGINEERING CO.



SOUTHWEST SAND, INC.	
WICHITA, KANSAS	
GENERAL DRAIN	
PLAN AND PROFILE - FORCE MAIN	
CAMPBELL & CASTLE	ENGINEERS
WICHITA, KANSAS	
DATE	JUNE 1968
BY	RAY
SHEET NO.	1 OF 2

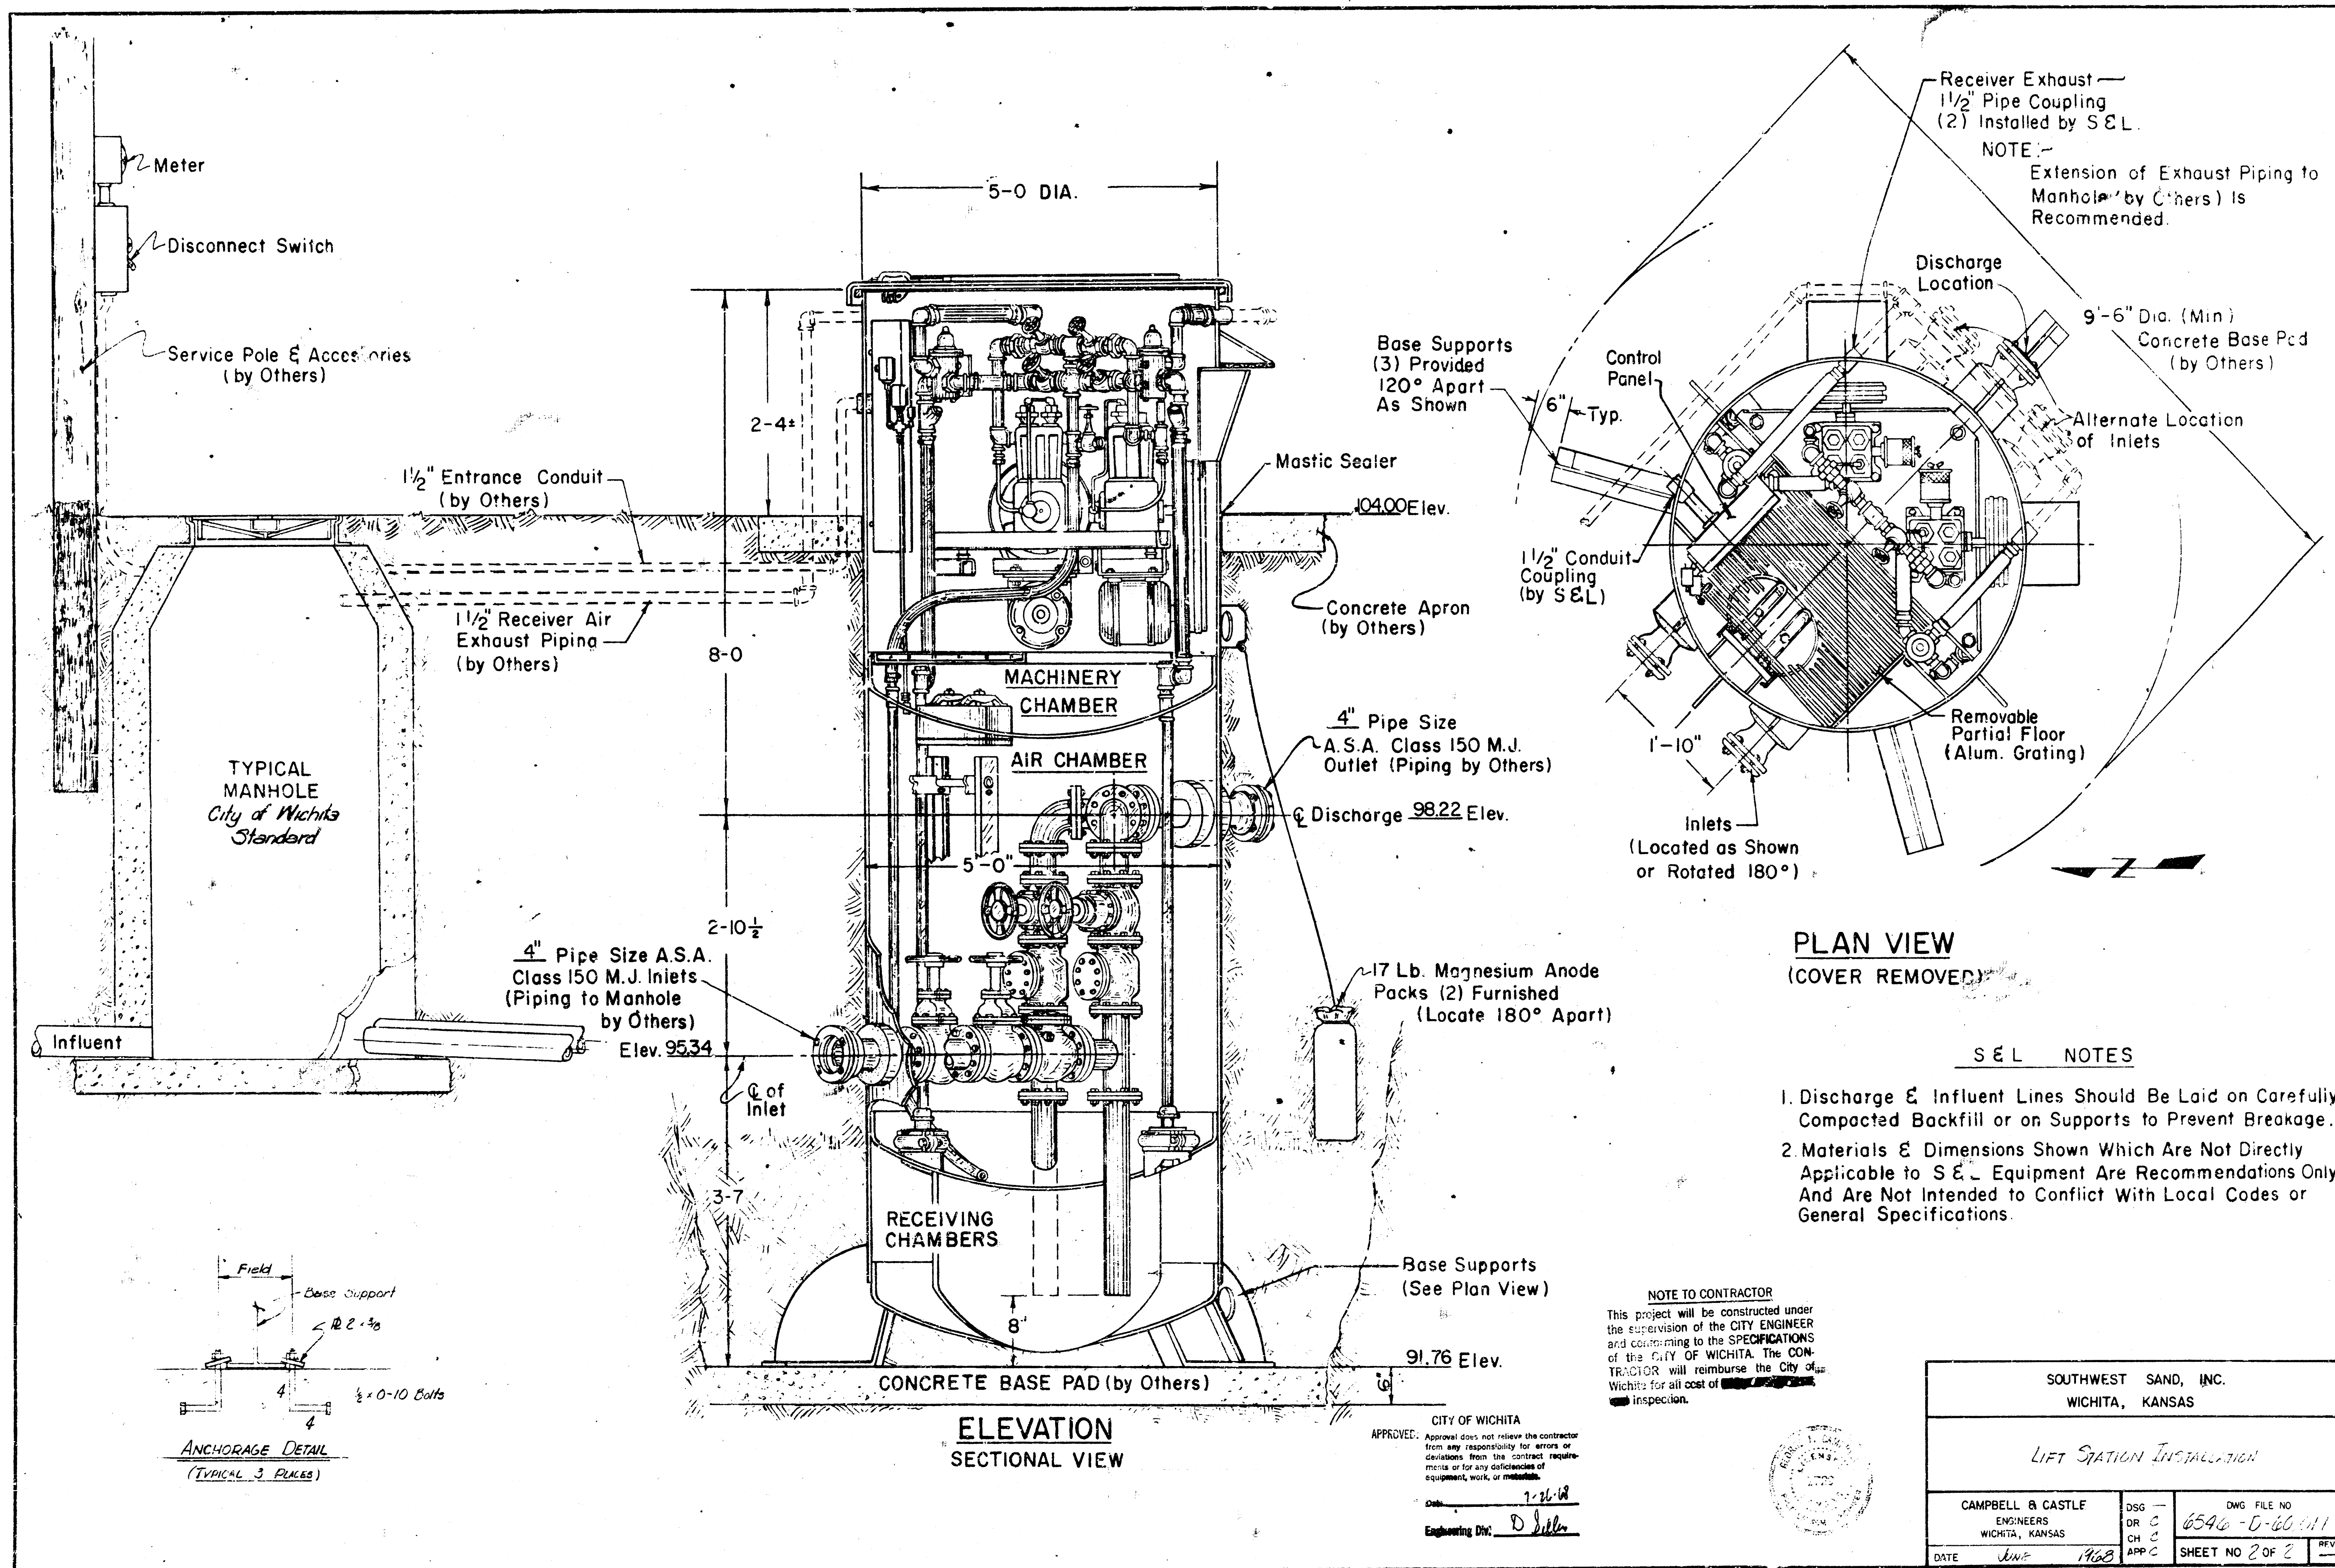

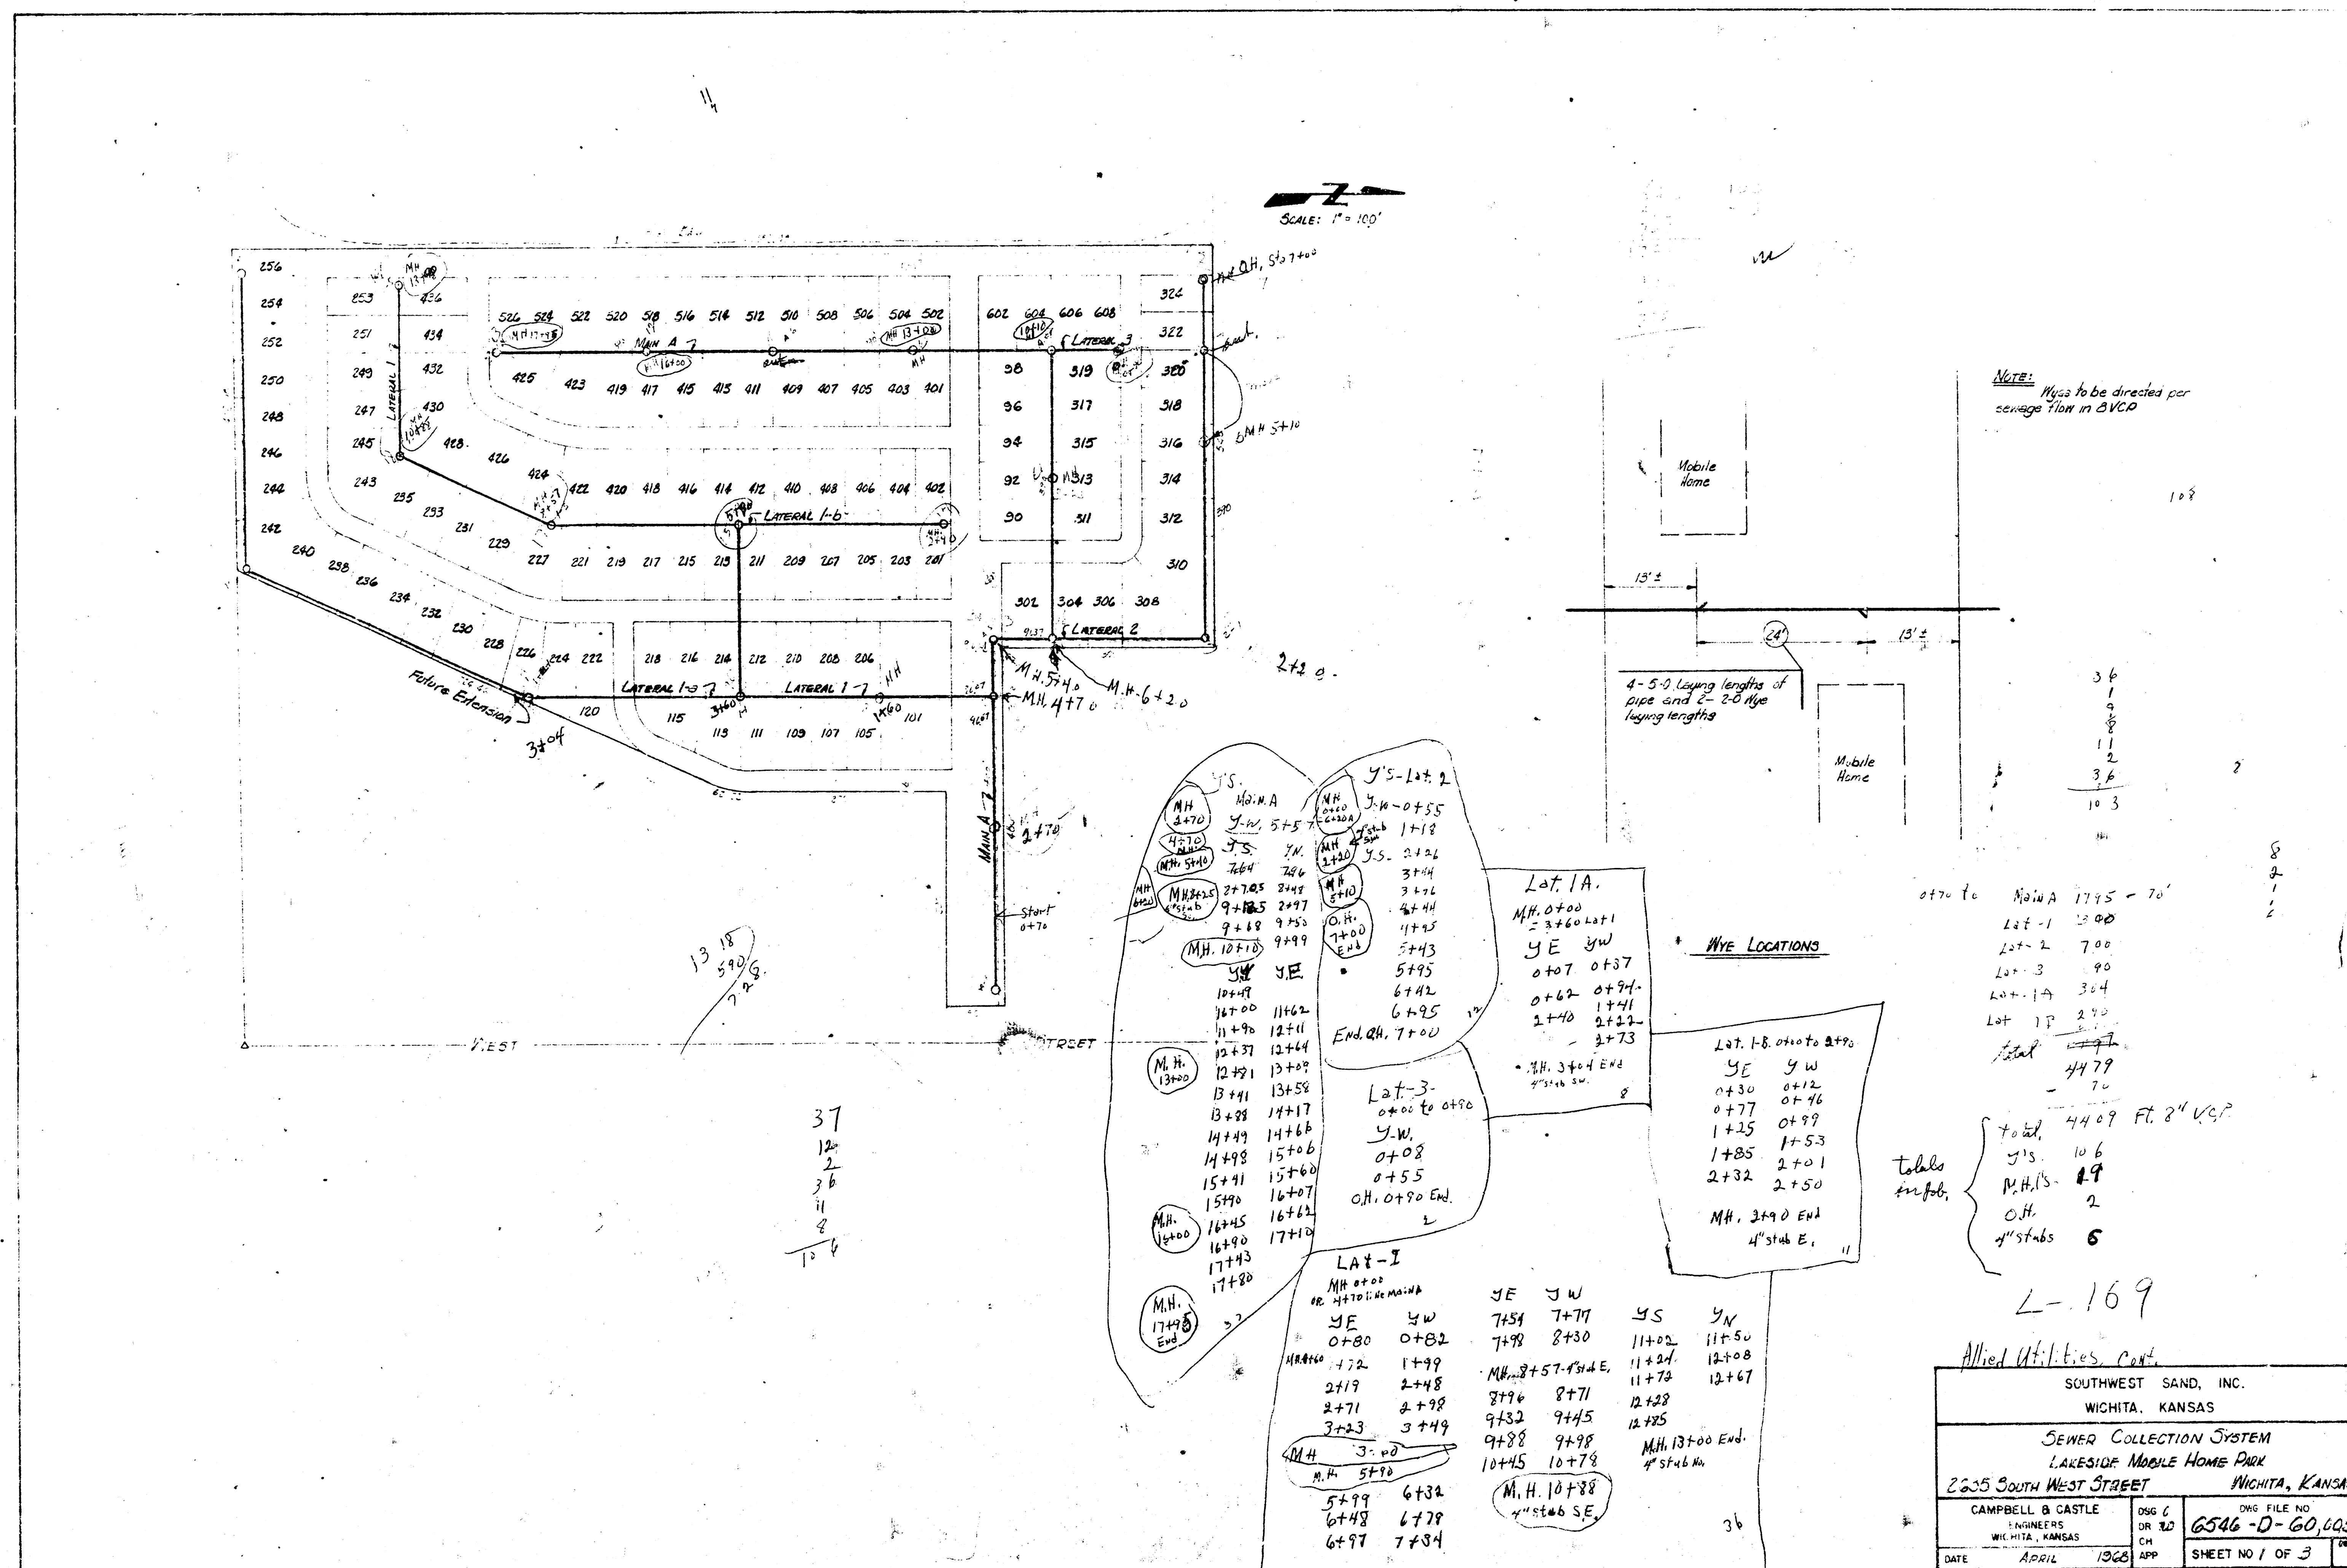

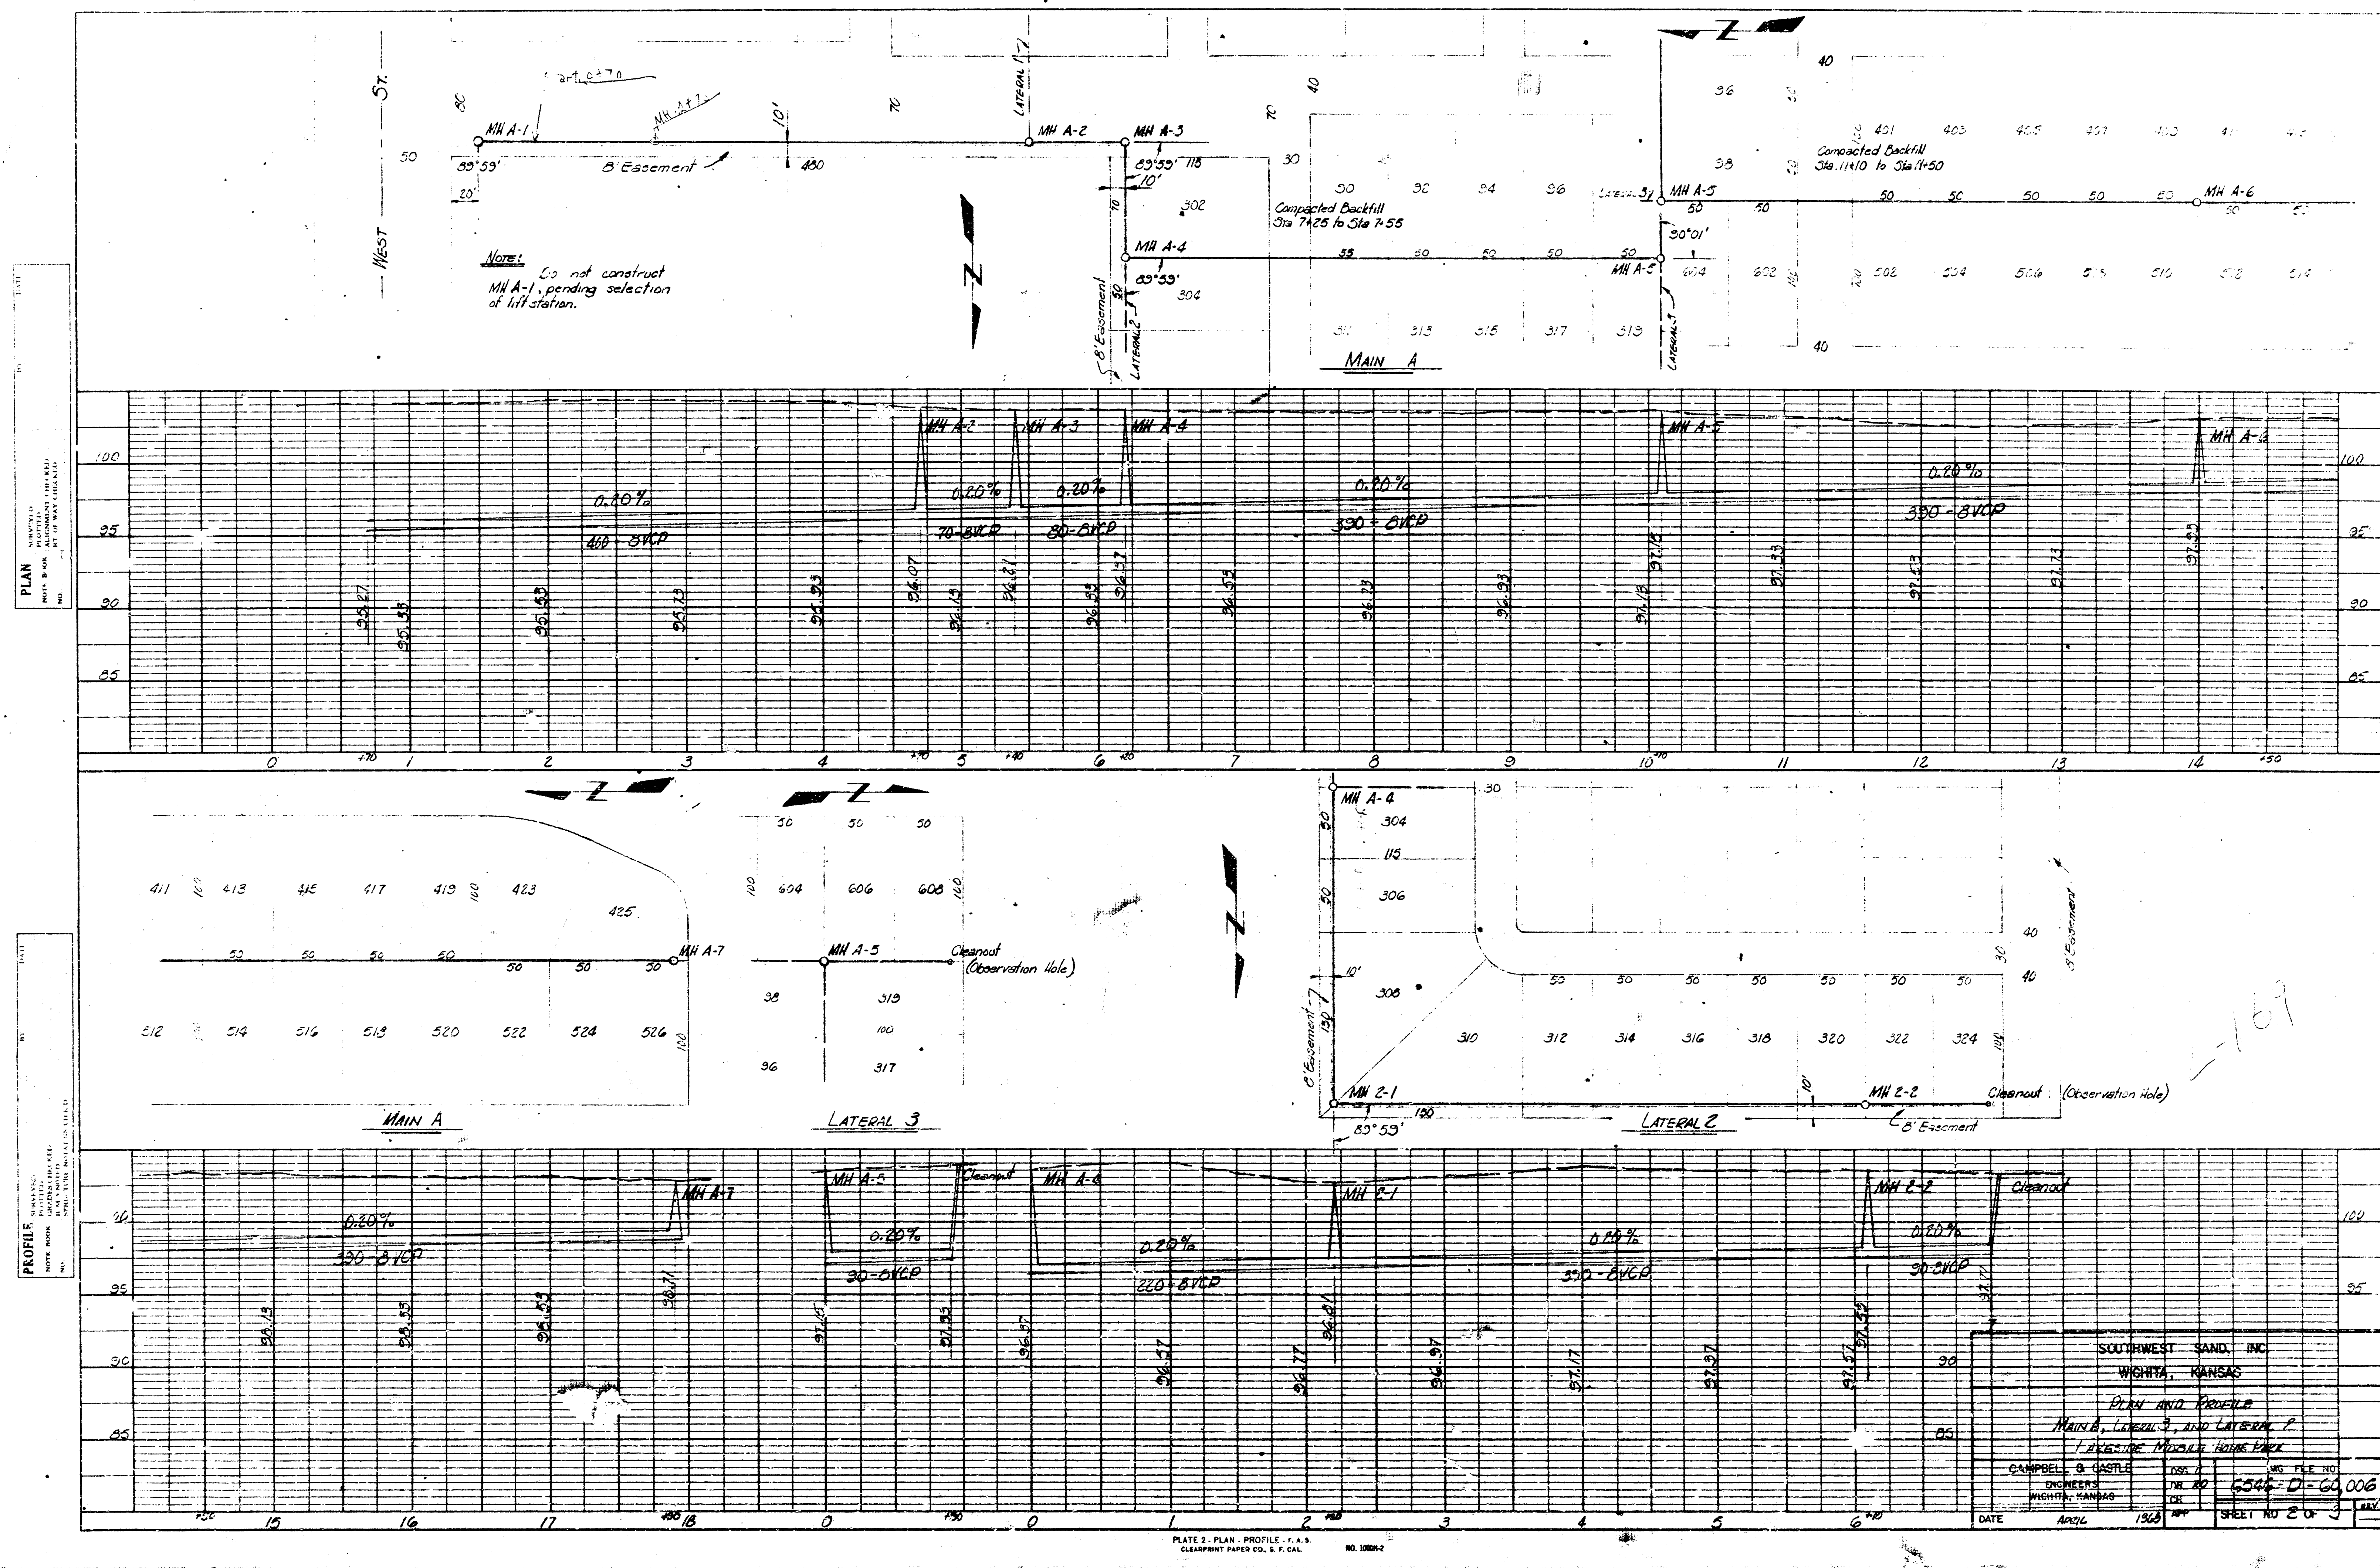

PLAN
 UNREVISED
 DOWNTOWN
 DATE: 1968
 BY: J. W. H. H. H.

PROFILE
 UNREVISED
 DOWNTOWN
 DATE: 1968
 BY: J. W. H. H. H.

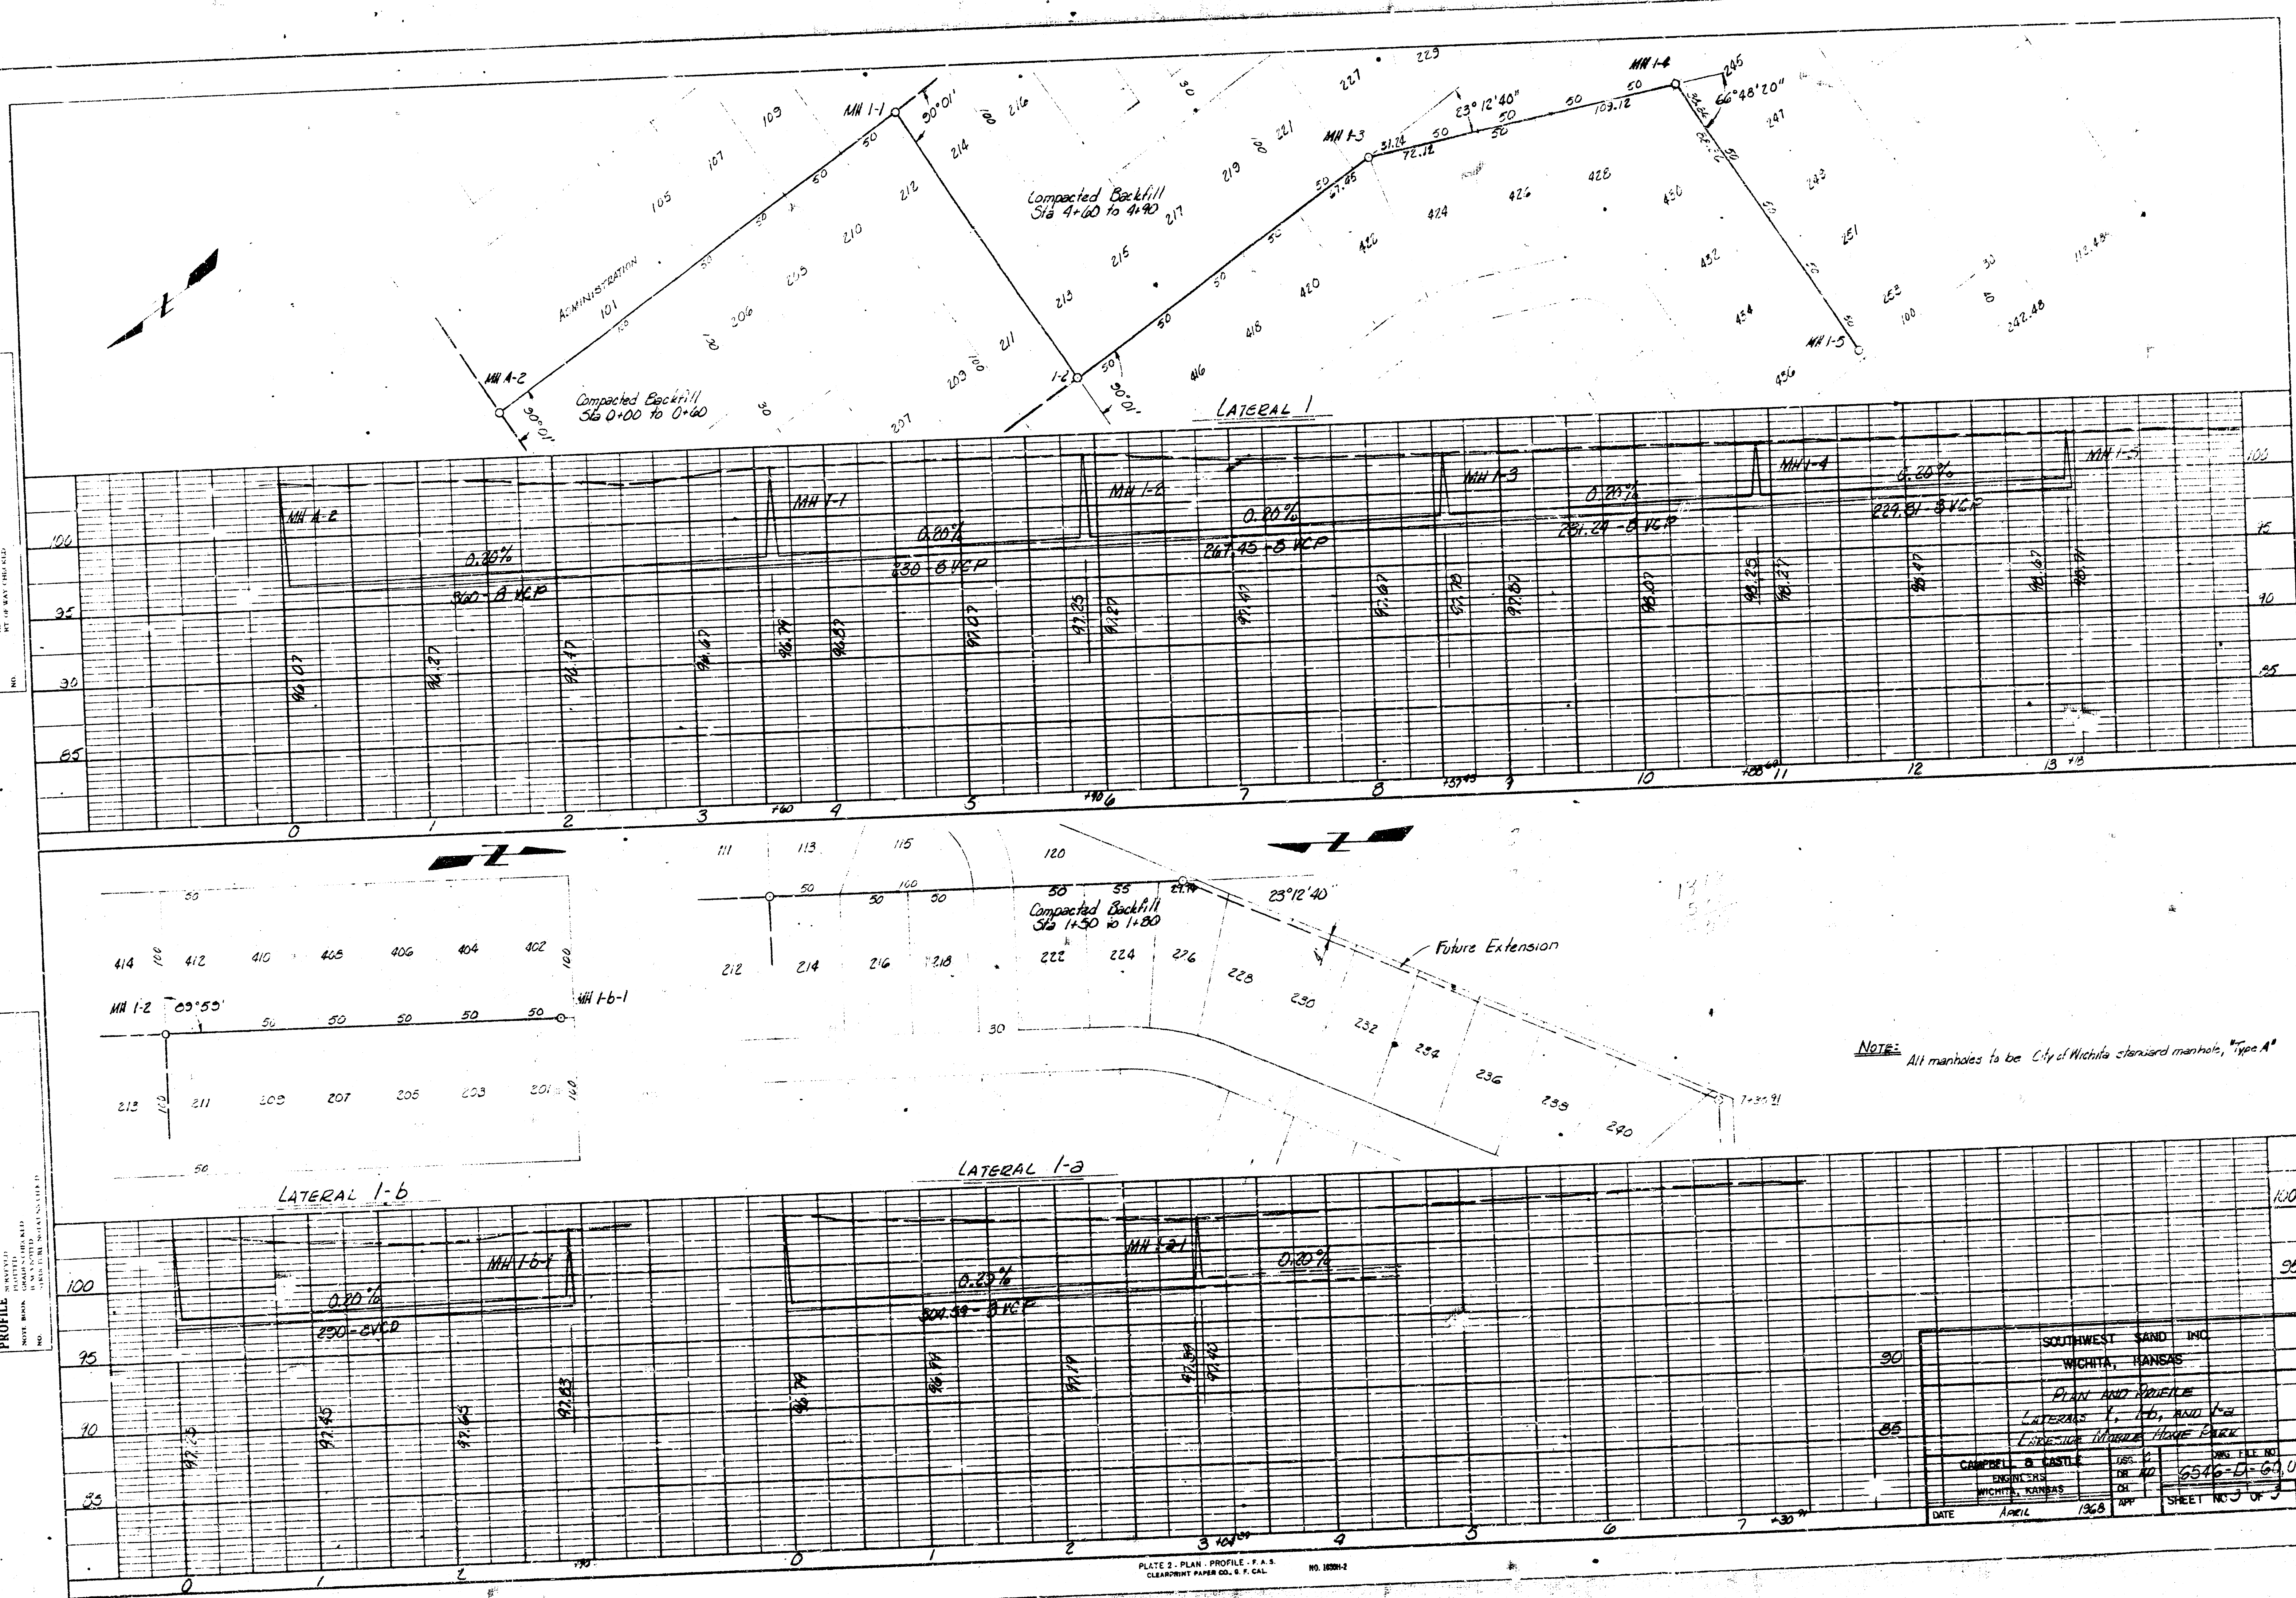


PLATE 2: PLAN - PROFILE, P.A.S.
 CLEARPRINT PAPER CO. & P. CO.
 NO. 1000-2

SOUTHWEST SAND INC.		DATE: APRIL 1968
WICHITA, KANSAS		
PLAN AND PROFILE		
LATERALS 1, 1-b, AND 1-c		
LATERAL 1-b AND 1-c		
CAMPBELL & CASTLE	DESIGN	NO. 1000-2
ENGINEERS	DATE	4/1/68
WICHITA, KANSAS	BY	J. W. H. H. H.
SHEET NO. 3 OF 3		REV.