



**SEWER SYSTEM  
LAMPLIGHTER  
MOBILE HOME PARK  
WICHITA, SEDGWICK COUNTY, KANSAS**

**REIS & GOODNESS ENGINEERS**  
2100 WEST 21<sup>ST</sup> STREET  
WICHITA, KANSAS 67201  
(316) 832-0253

SCALE: 1" = 60'

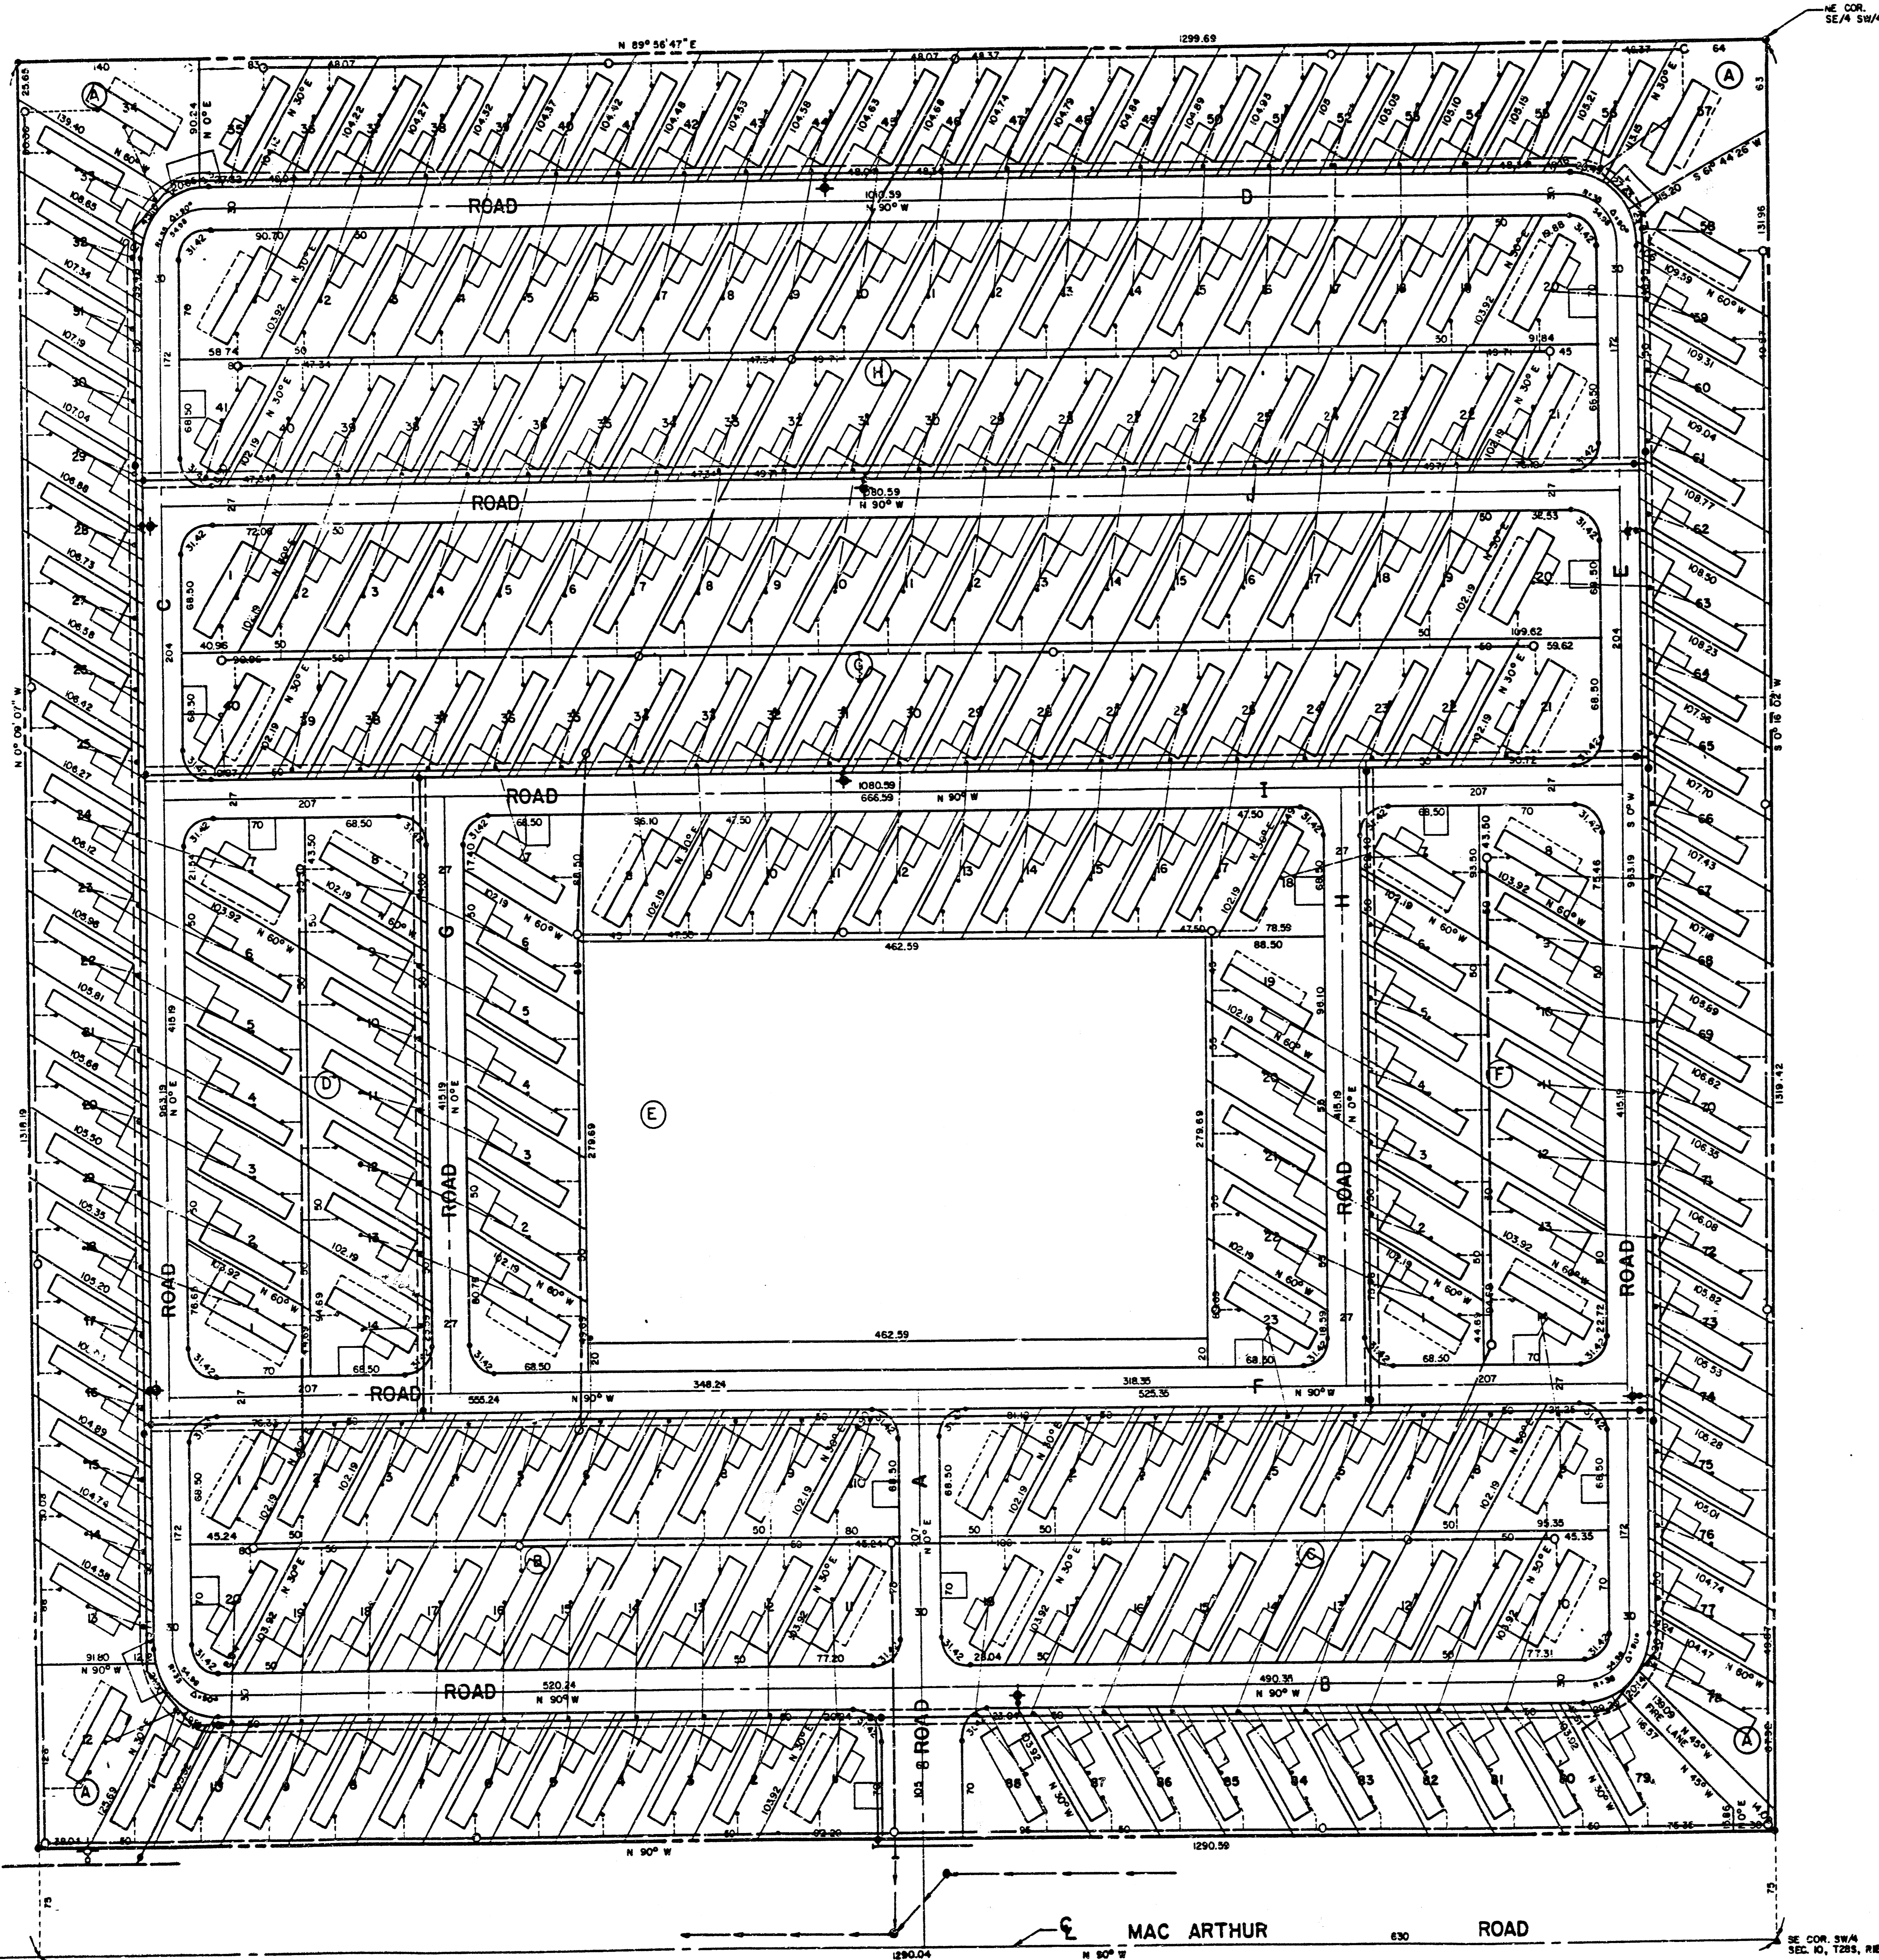

NE COR.  
SE 1/4 SW 1/4

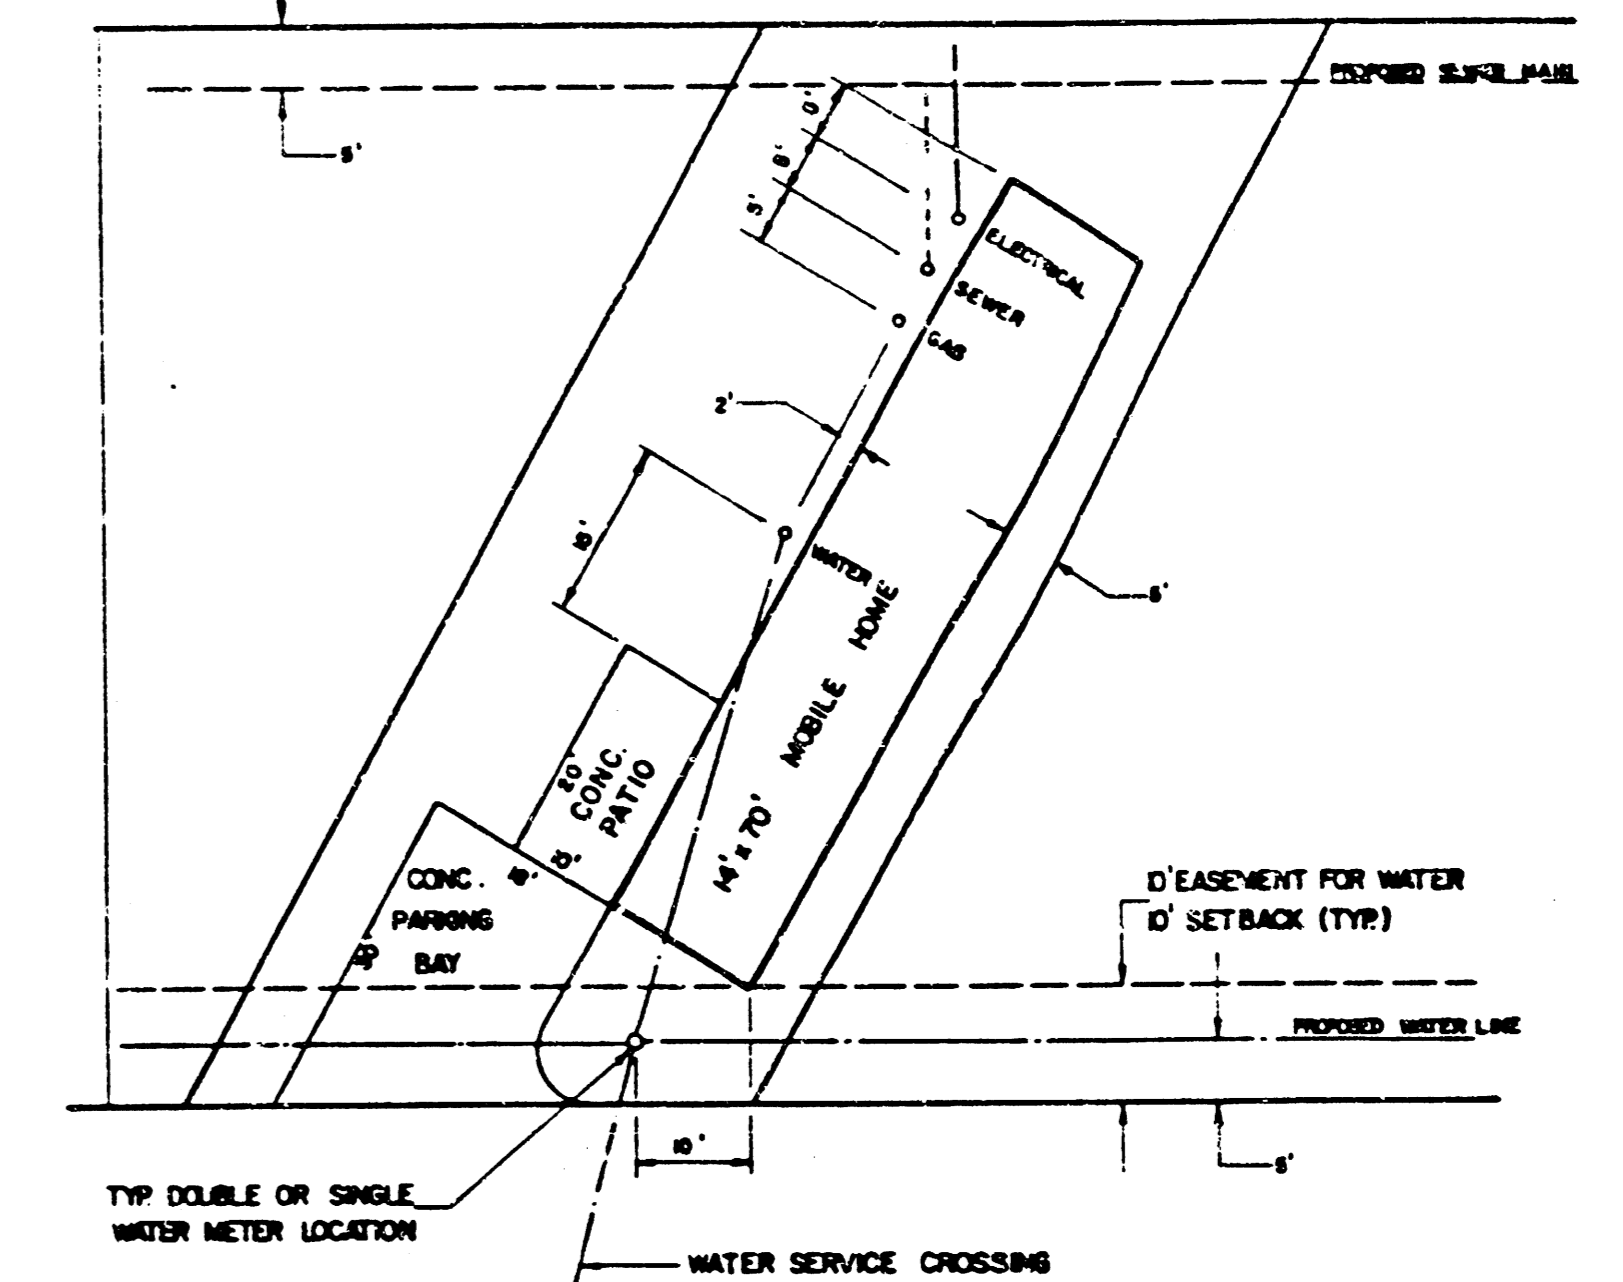

TYPICAL LOT LAYOUT  
1" = 20'

— SANITARY SEWER  
— WATER

## UTILITY MAP

### LAMPLIGHTER MOBILE HOME PARK

WICHITA, SEDGWICK COUNTY, KANSAS

REISS & GOODNESS ENGINEERS  
2180 WEST 21<sup>ST</sup> STREET  
WICHITA, KANSAS 67204  
(316) 628-0228

SCALE: 1" = 60'

3/8

NOTE:  
CONTRACTOR SHALL PROVIDE 24" MIN. COVER  
OVER PIPE

★ NO SEWER JOINT WITHIN 10' OF  
WATER LINE, OR USE SOLVENT  
WELD PIPE, OR 20' CONCRETE  
ENCASEMENT.

STA. 0+74, MAIN I, END 10"  
CLAY TILE SEWER.  
BEGIN 8" PVC SEWER



STA. 0+59, MAIN I, END EXIST.  
10" CLAY TILE STUB.  
BEGIN NEW 10" CLAY TILE SEWER.

STA. 0+00 MAIN I, EXIST. M.H.  
F.L. NORTH 74.89  
F.L. SOUTH 75.14  
F.L. WEST 74.85  
F.L. N.E. 75.19

NOTE:  
0+74 - END PUBLIC SEWER  
BEGIN PRIVATE SEWER

**MAIN LINE TRAP DETAIL (3 req'd.)**


INSTALL 4-45° ELBOWS & ENCASE  
IN 6" THICK CONCRETE AS SHOWN

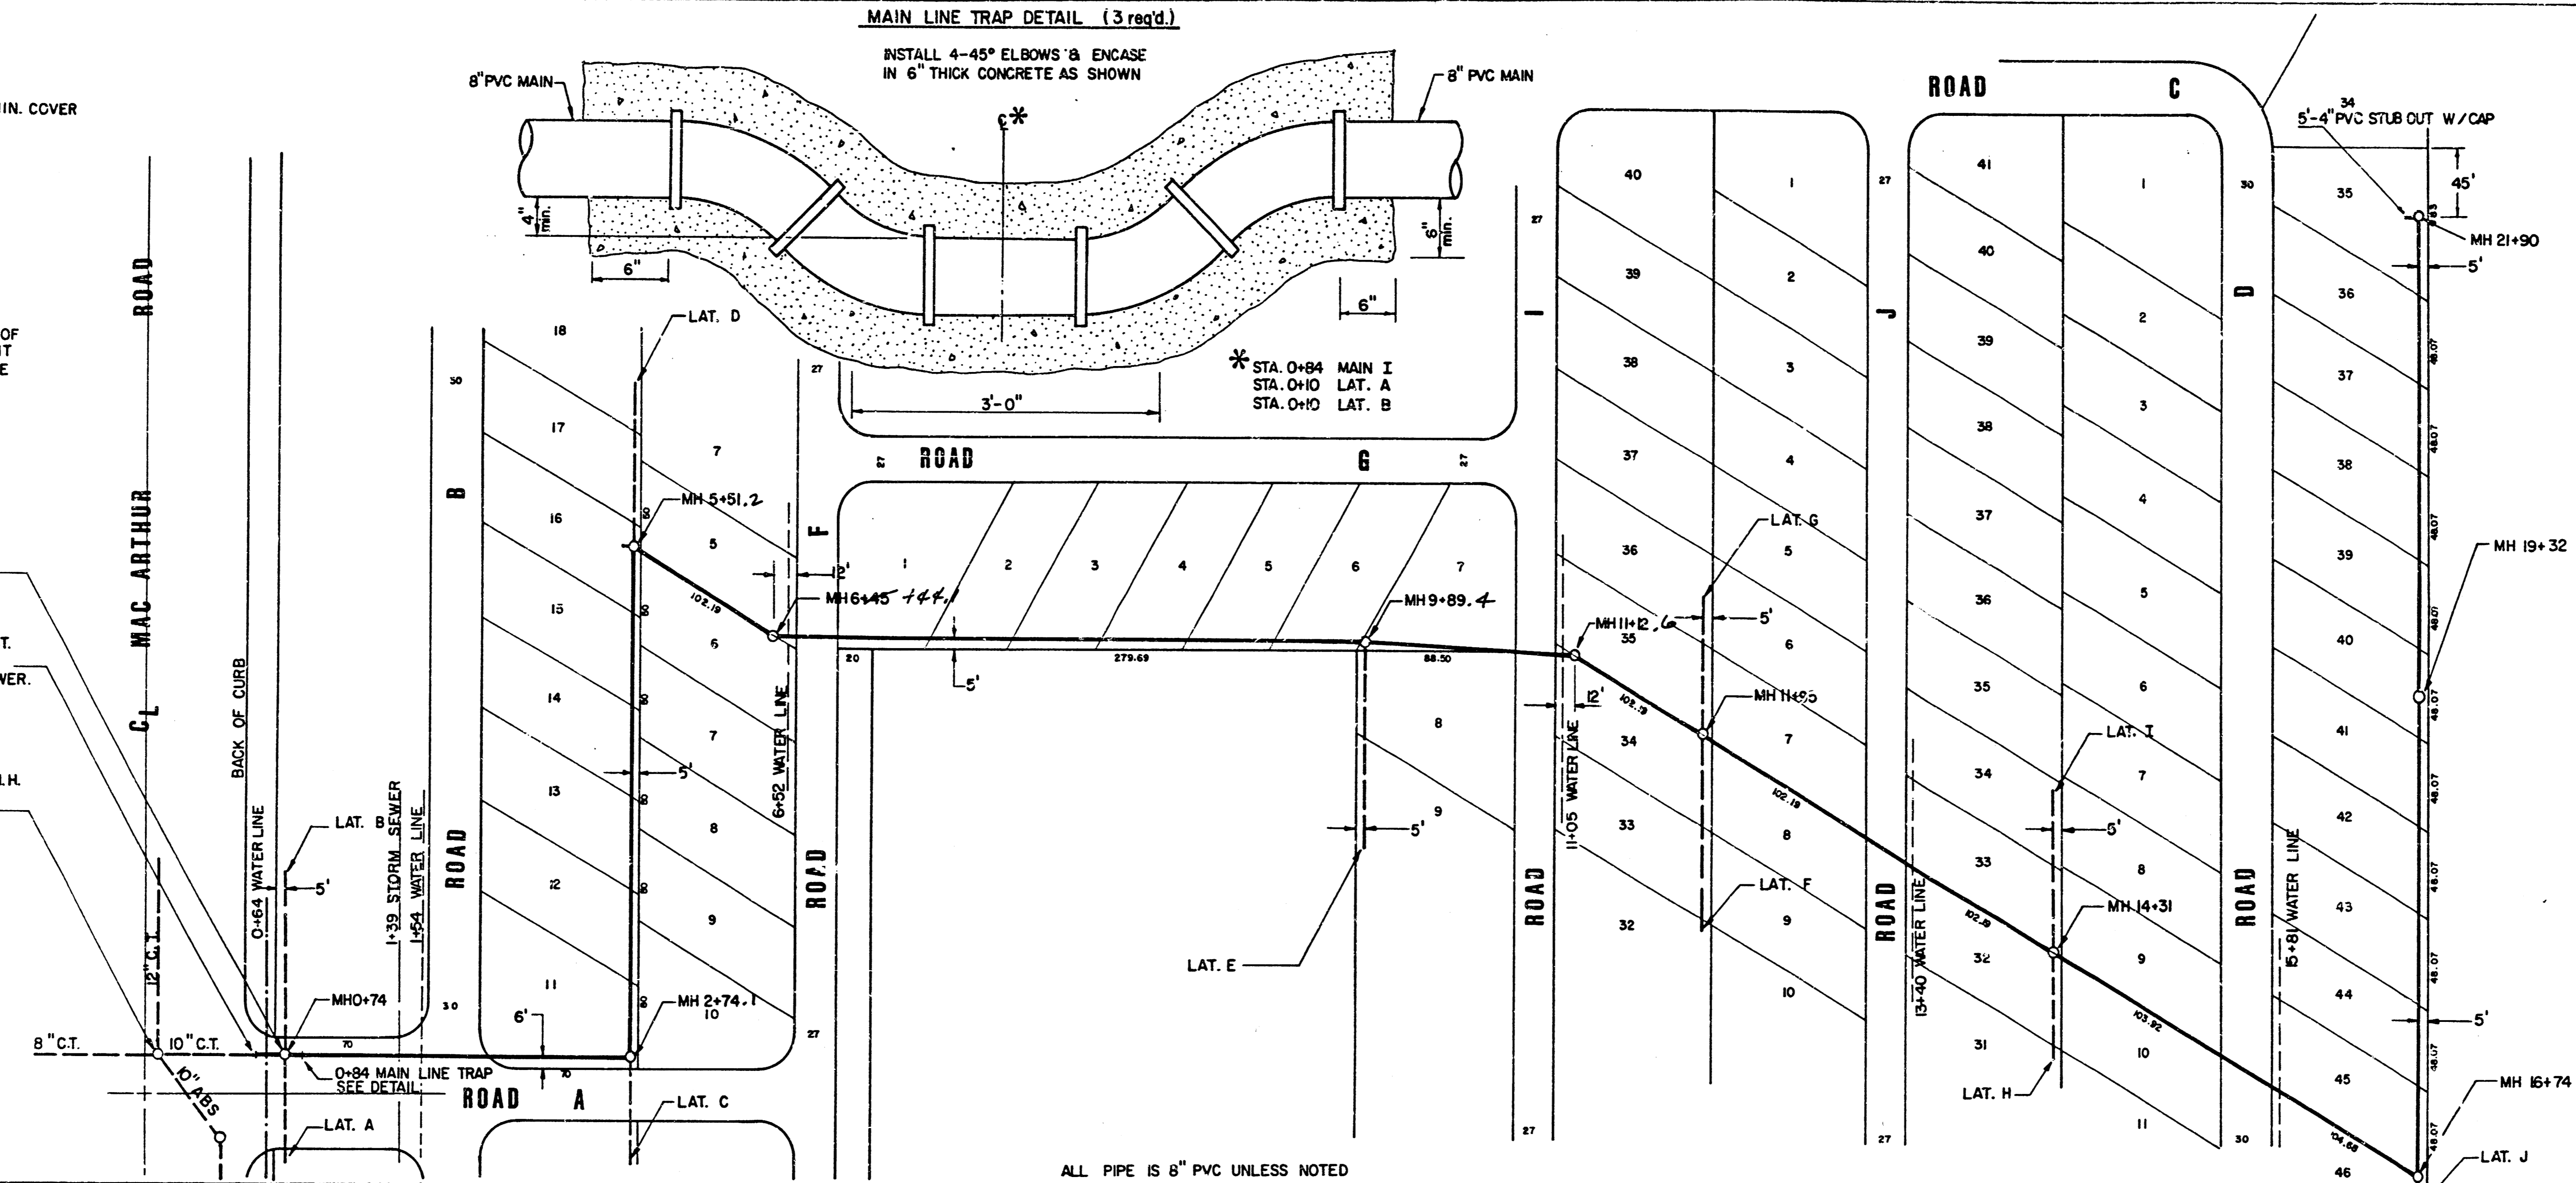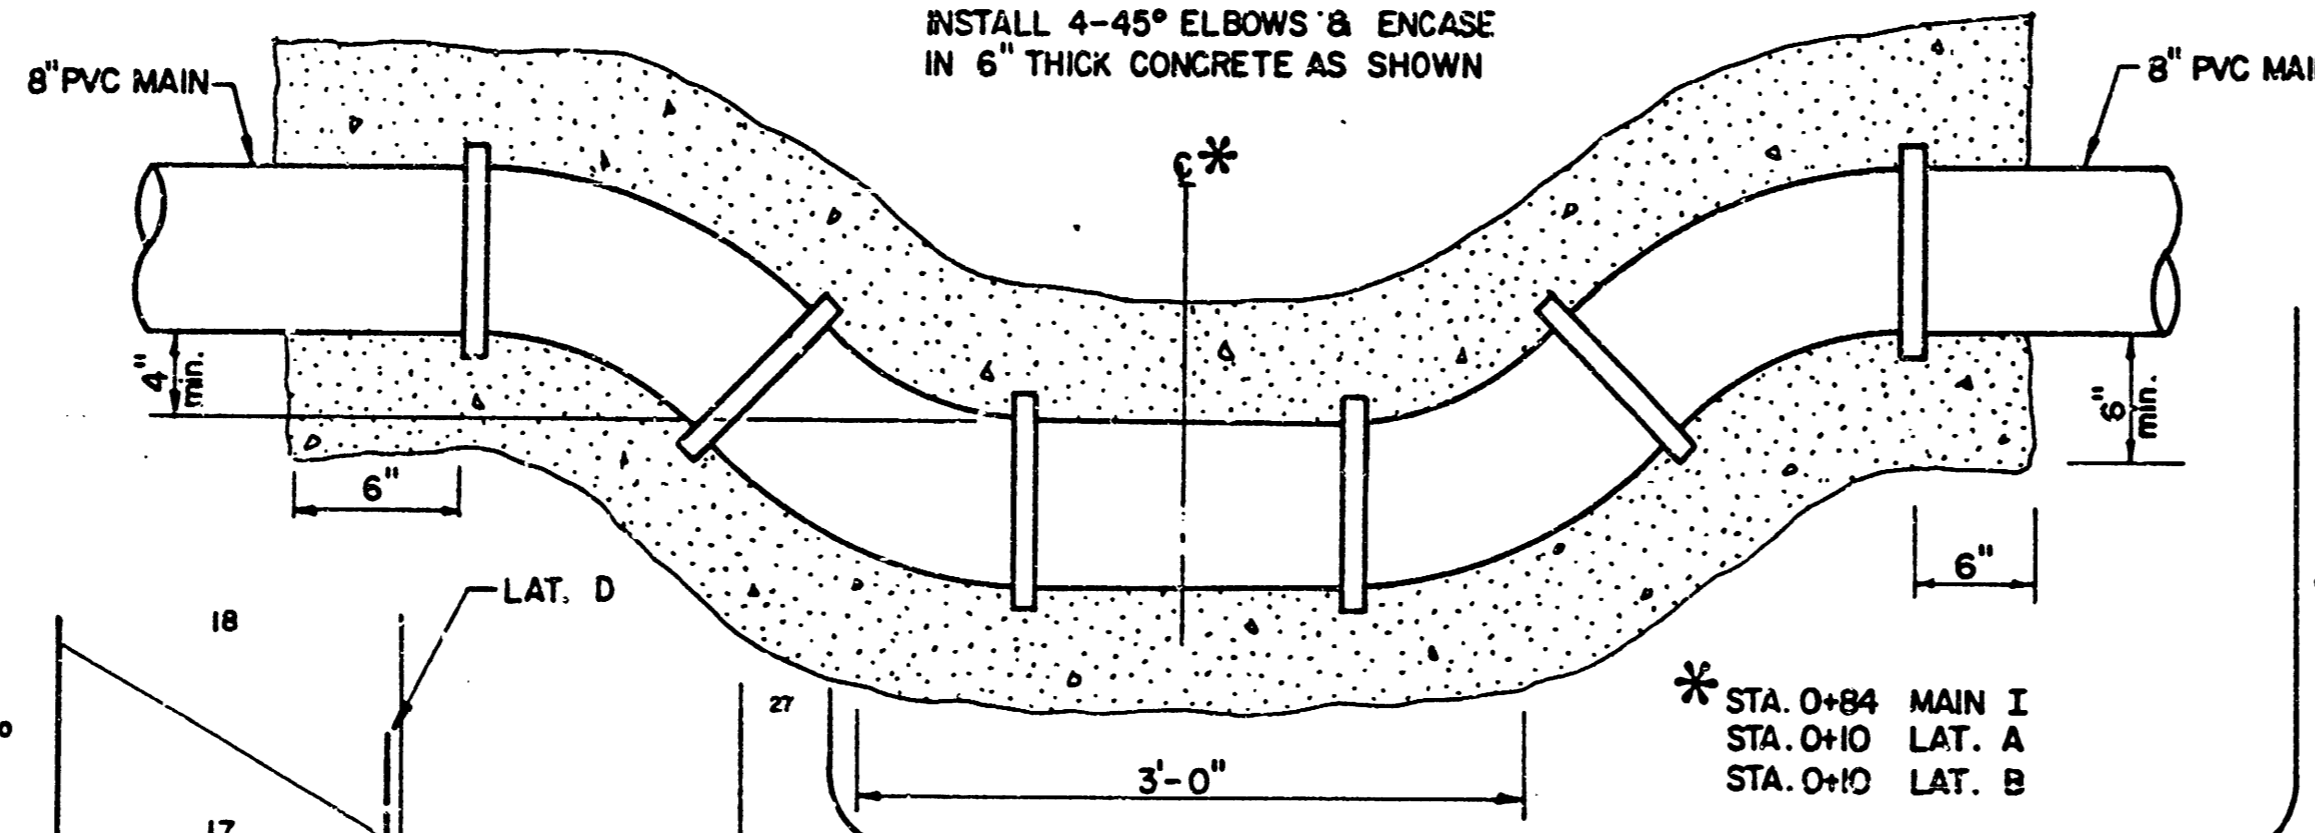

BM  
R.R. SPIKE IN P.P. AT THE SW/C  
OF THE PLAT.  
85.23 CITY OF WICHITA DATUM


ALL MANHOLES SHALL BE TYPE "A",  
SHALLOW TYPE "A", OR SPECIAL SHALLOW TYPE "A"  
UNLESS NOTED

VERIFY ELEVATION AND GRADE OF EXISTING PIPE  
PRIOR TO LAYING ANY NEW PIPE. NOTIFY ENGINEER  
OF ANY DISCREPANCIES IMMEDIATELY BETWEEN PLANS  
AND FIELD CONDITIONS.

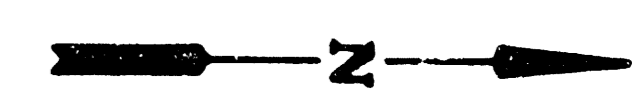


SCALE  
PLAN 1" = 60'  
PROFILE  
HORIZ. 1" = 50'  
VERT. 1" = 5'

ALL PIPE IS 8" PVC UNLESS NOTED

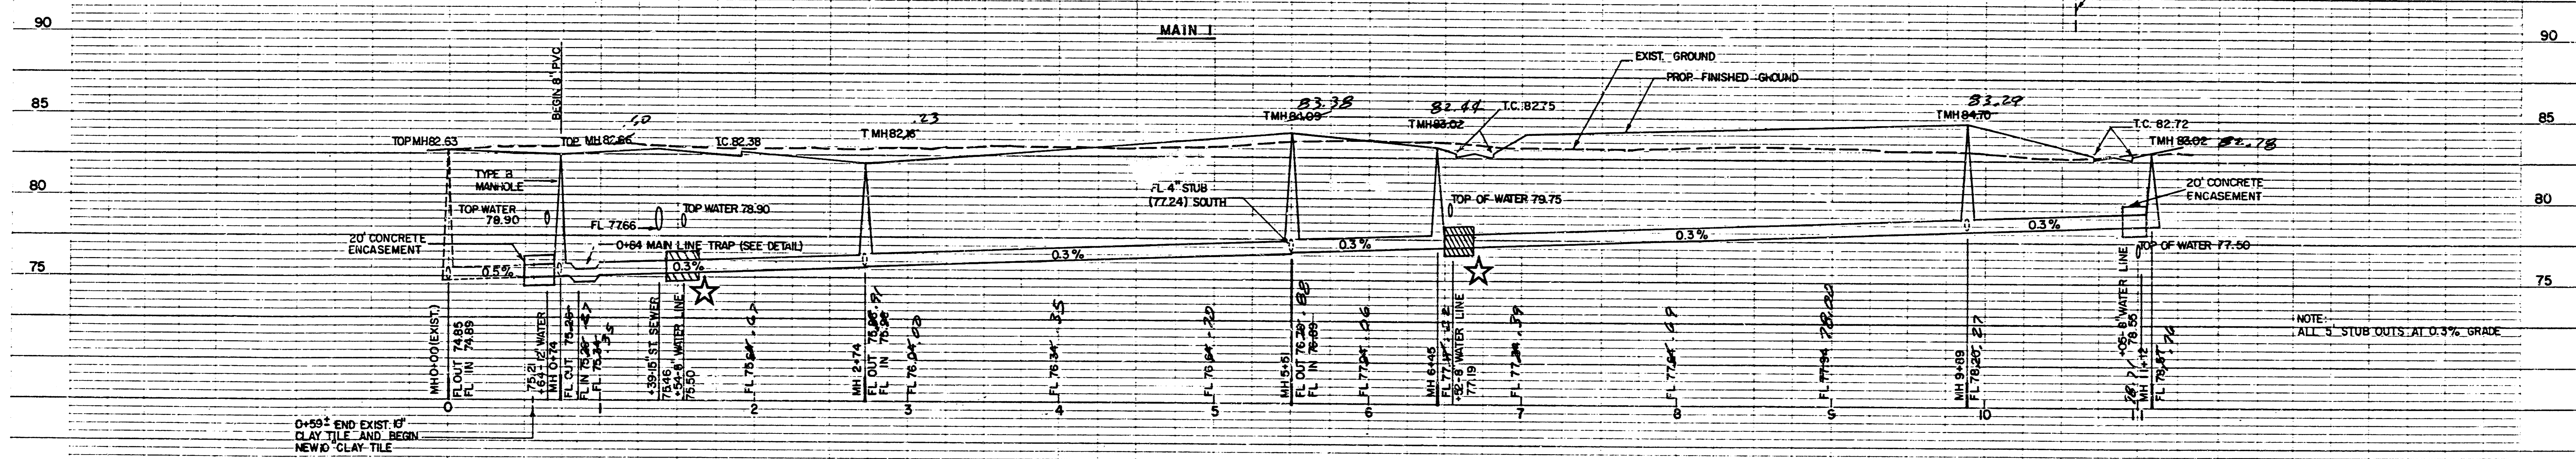


NOTE:  

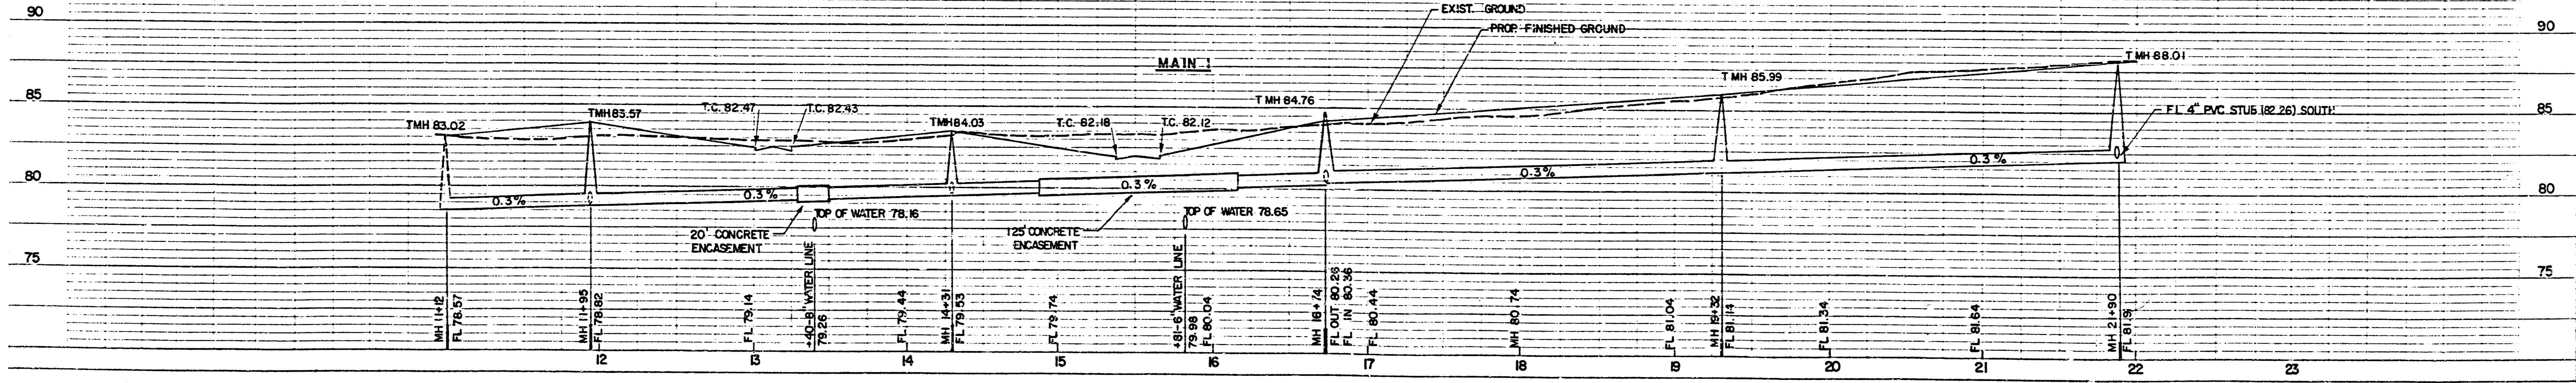

**REISS & GOODNESS ENGINEERS**  
2160 WEST 31<sup>ST</sup> STREET  
WICHITA, KANSAS 67203  
(316) 832-0213

SCALE  
 PLAN 1" = 60'  
 PROFILE 1" = 50'  
 HORIZ. 1" = 50'  
 VERT. 1" = 5'


SCALE  
 PLAN 1" = 60'  
 PROFILE 1" = 50'  
 HORIZ. 1" = 50'  
 VERT. 1" = 5'

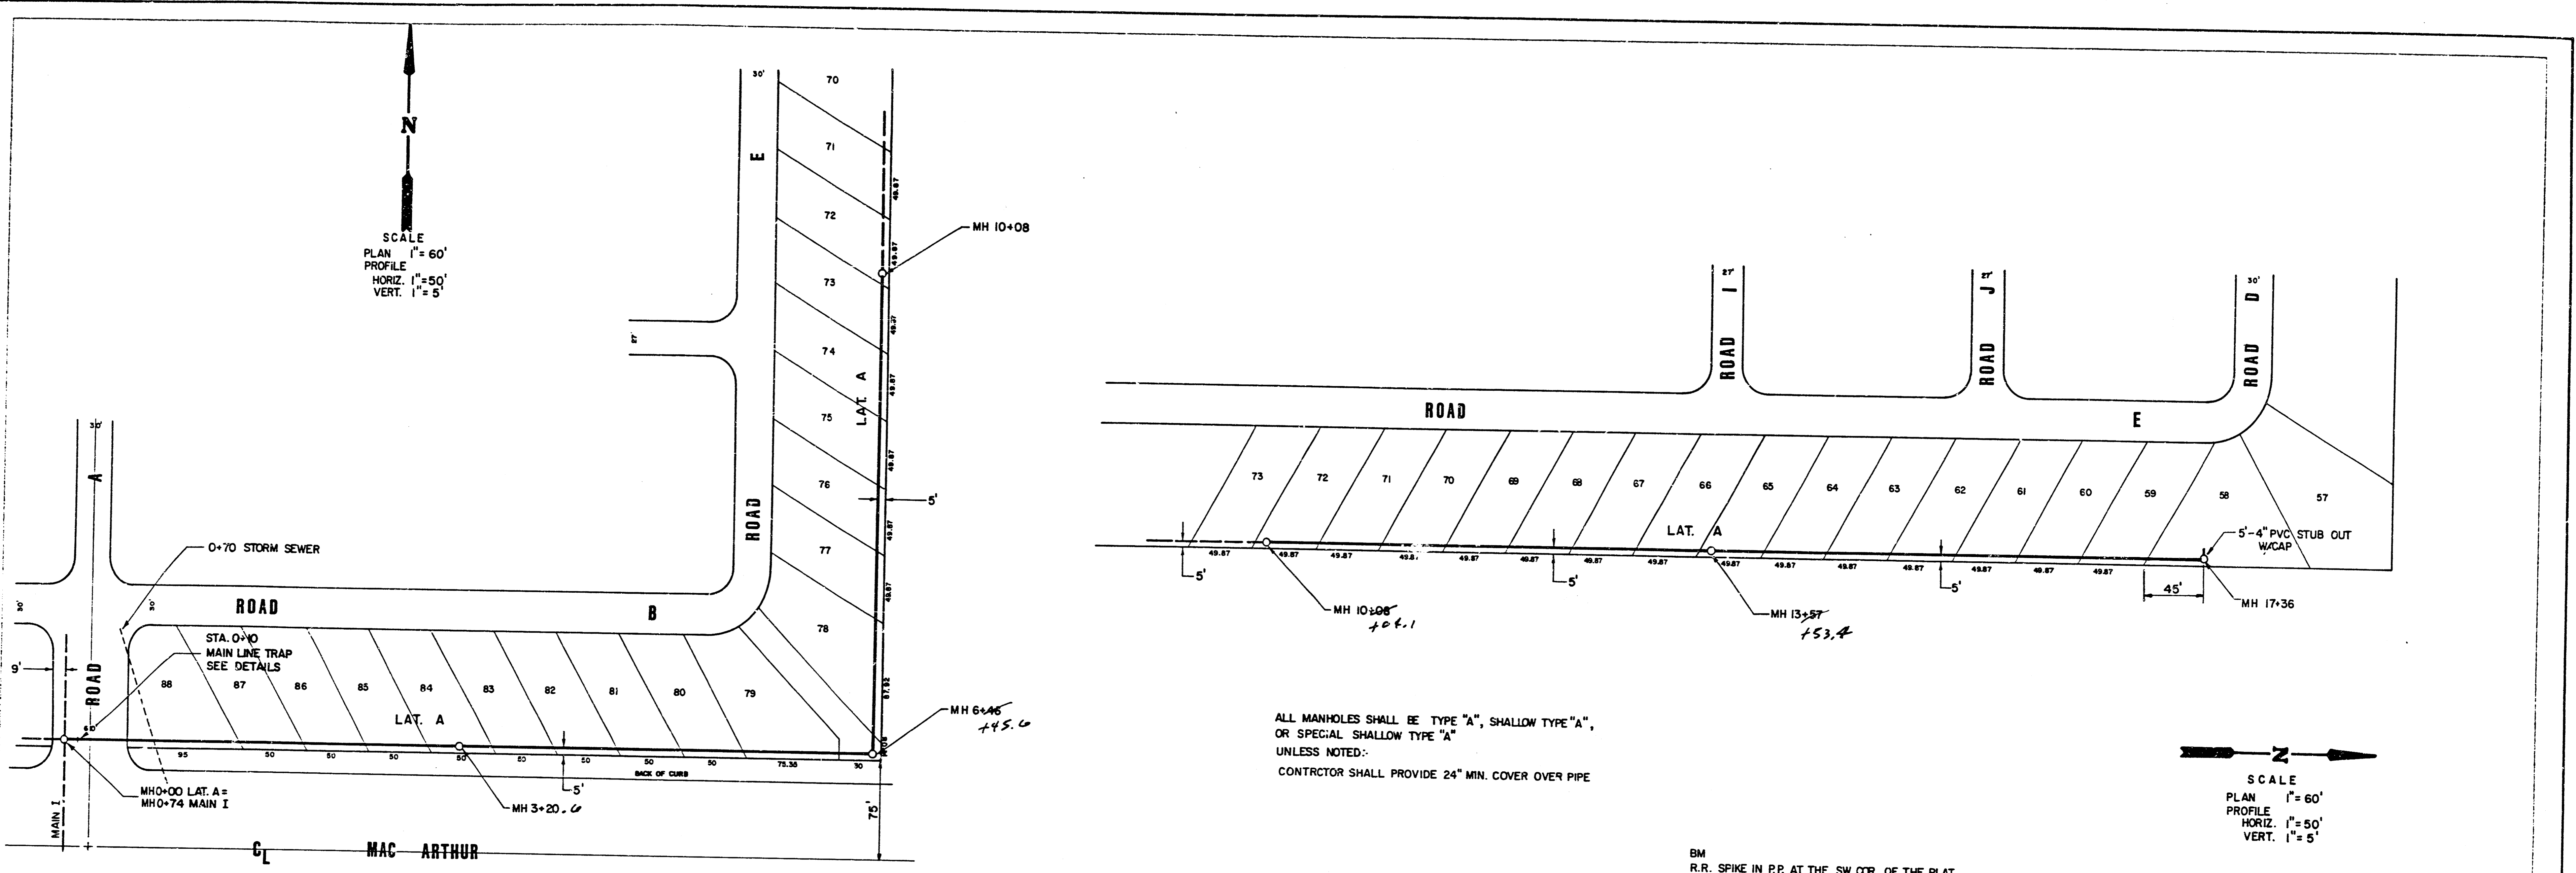


ALL MANHOLES SHALL BE TYPE "A", SHALLOW TYPE "A",  
 OR SPECIAL SHALLOW TYPE "A"  
 UNLESS NOTED:  
 CONTRACTOR SHALL PROVIDE 24" MIN. COVER OVER PIPE

BM  
 R.R. SPIKE IN P.P. AT THE SW COR. OF THE PLAT.  
 ELEV. 85.23  
 CITY OF WICHITA DATUM

ALL PIPE IS 8" PVC UNLESS NOTED

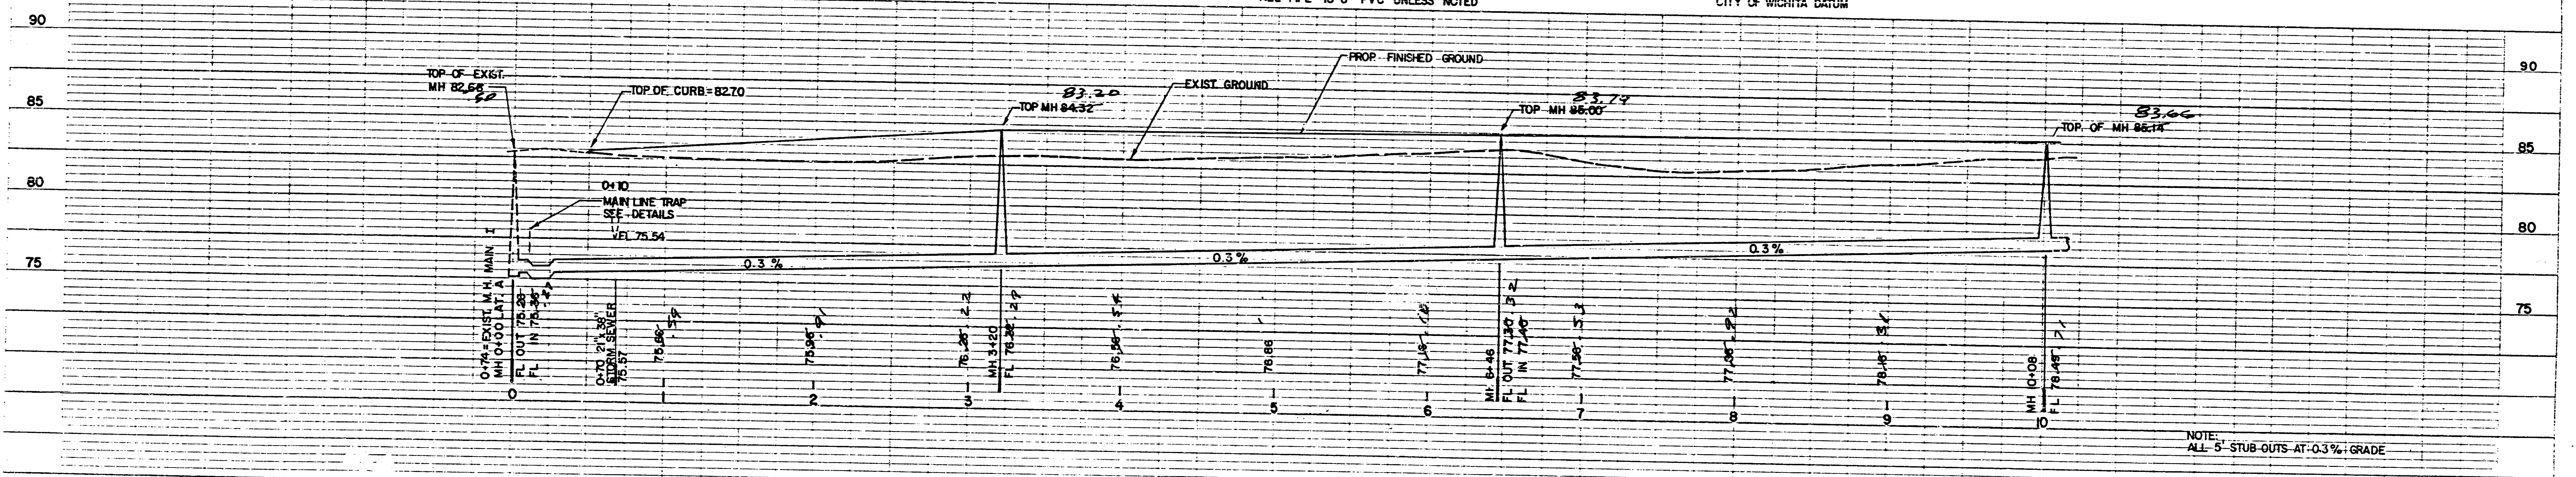

NOTE:  
 ALL 5" STUB-OUTS AT 0.3% GRADE

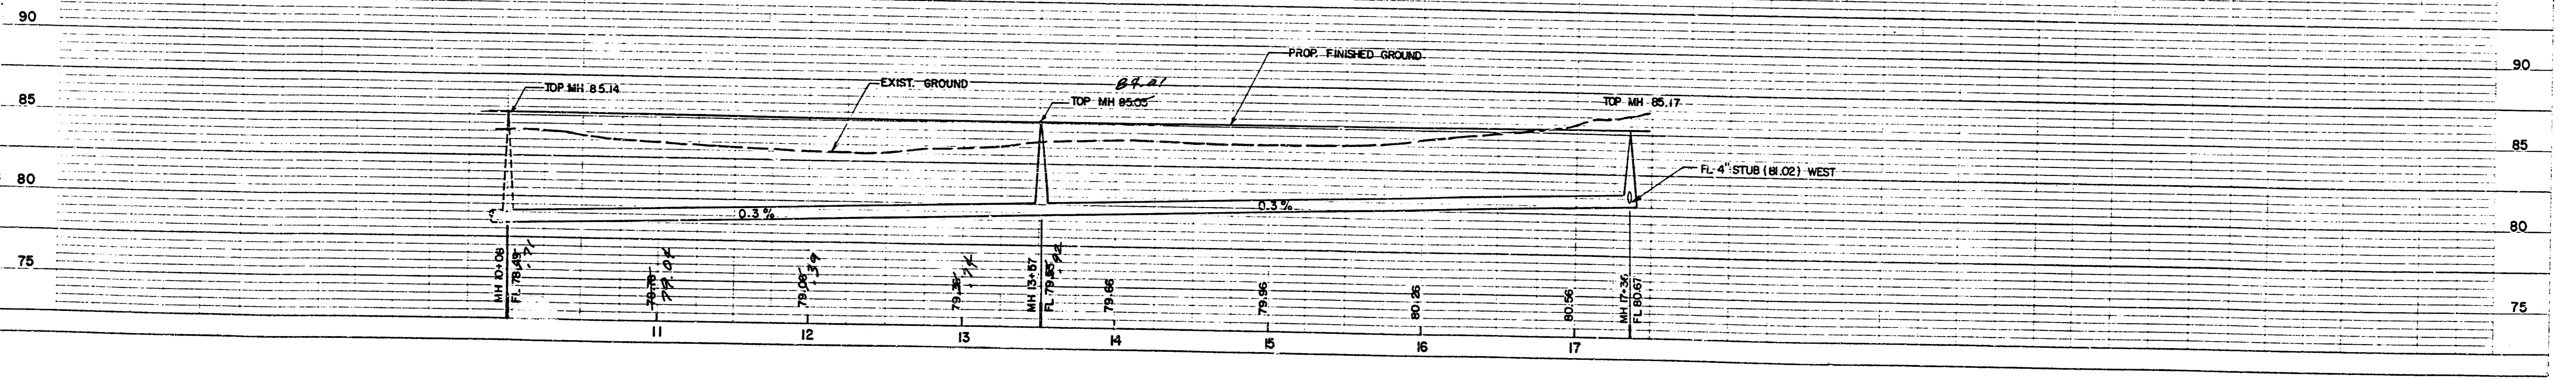

REVISION	DRAWN BY	CHECKED BY	DESIGNED BY	PROJECT



**SANITARY SEWER EXTENSIONS LAT. A**


CUSTOMER  
**LAMPLIGHTER MOBIL HOME PARK**

REISS & GOODNESS ENGINEERS  
 2100 WEST 21<sup>ST</sup> STREET  
 WICHITA, KANSAS 67203  
 (316) 832-0223

SCALE NOTED  
 DATE 4/1/06  
 PROJECT NO. 161284  
 SHEET 5 OF 13



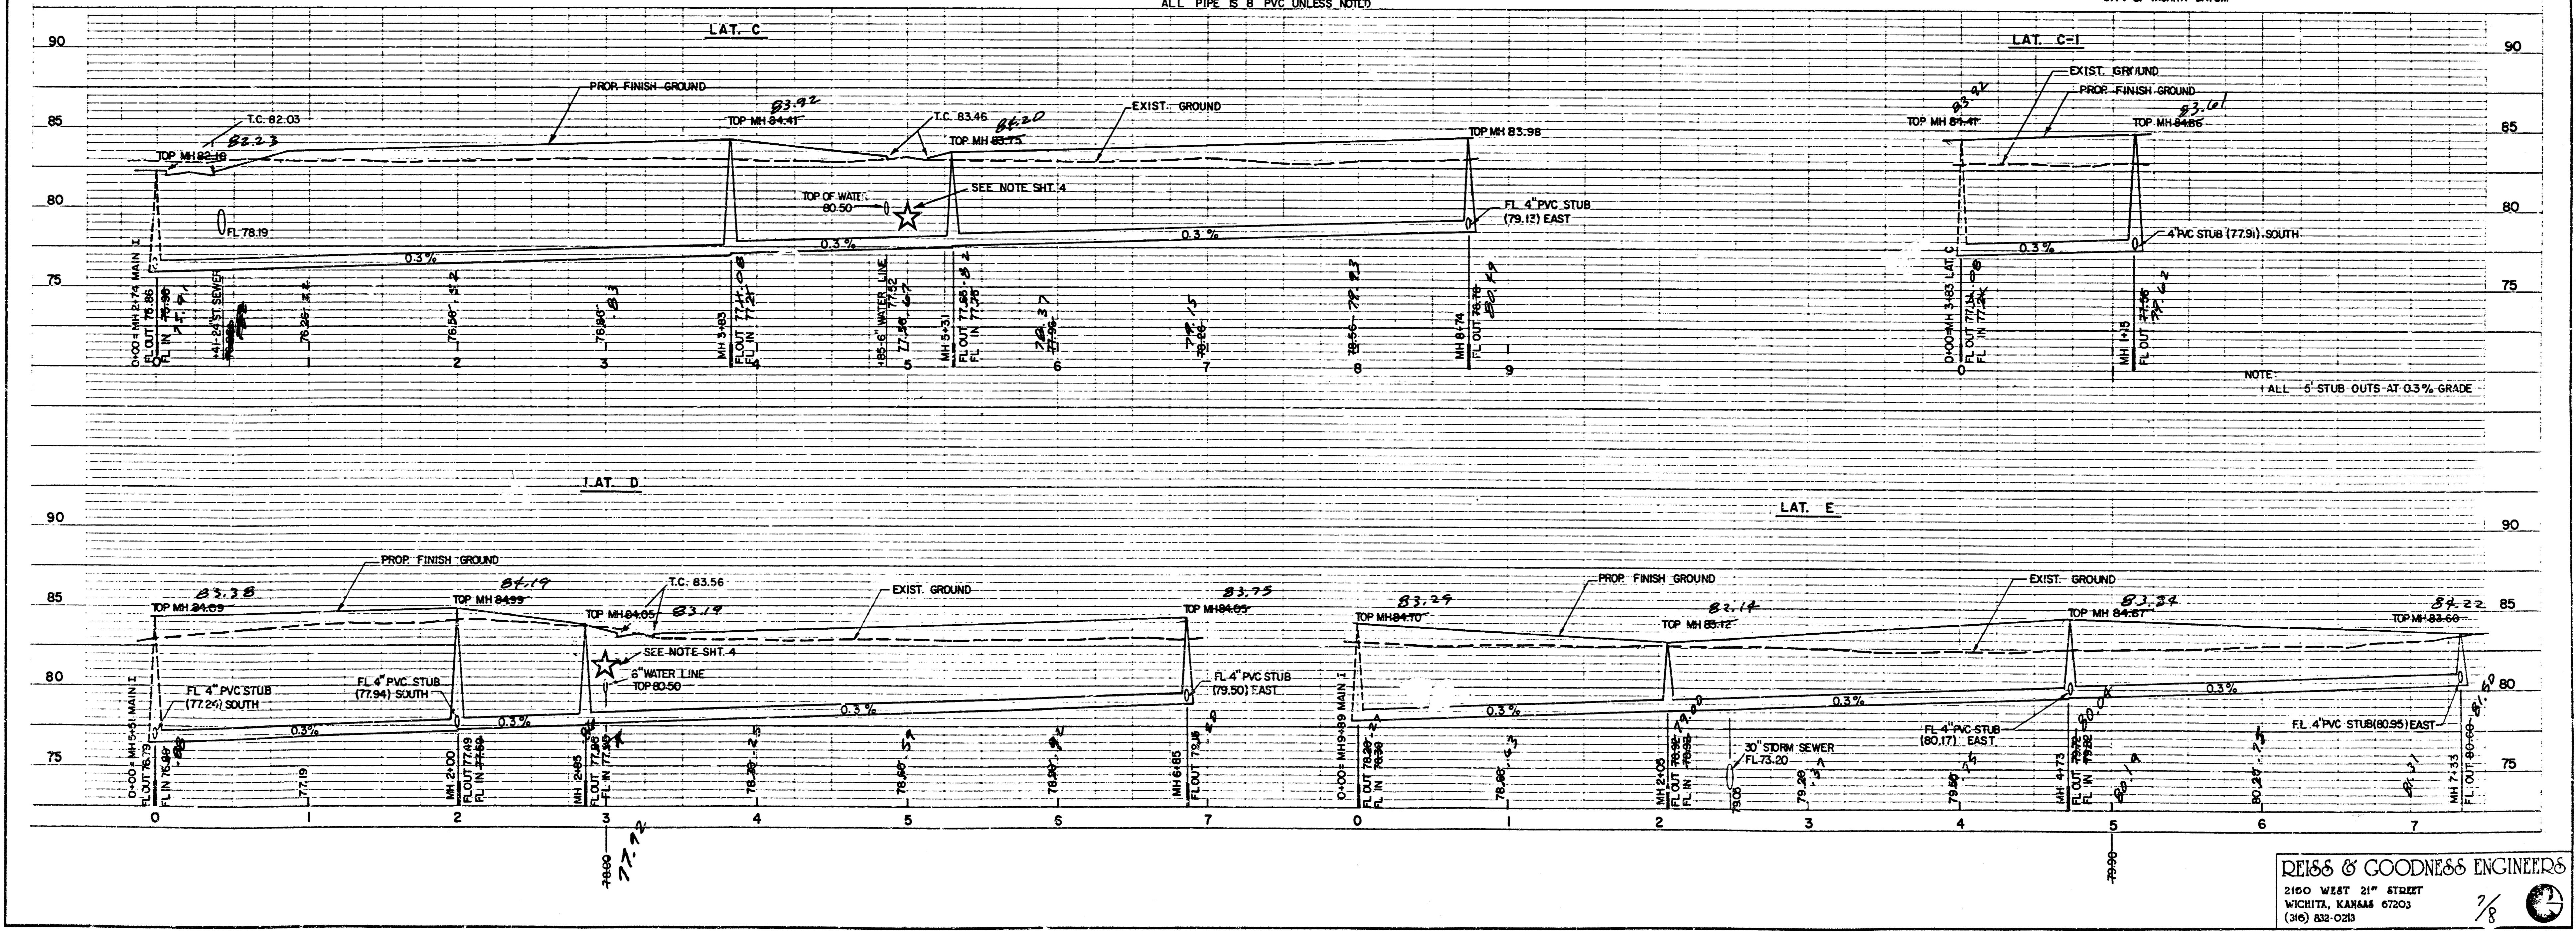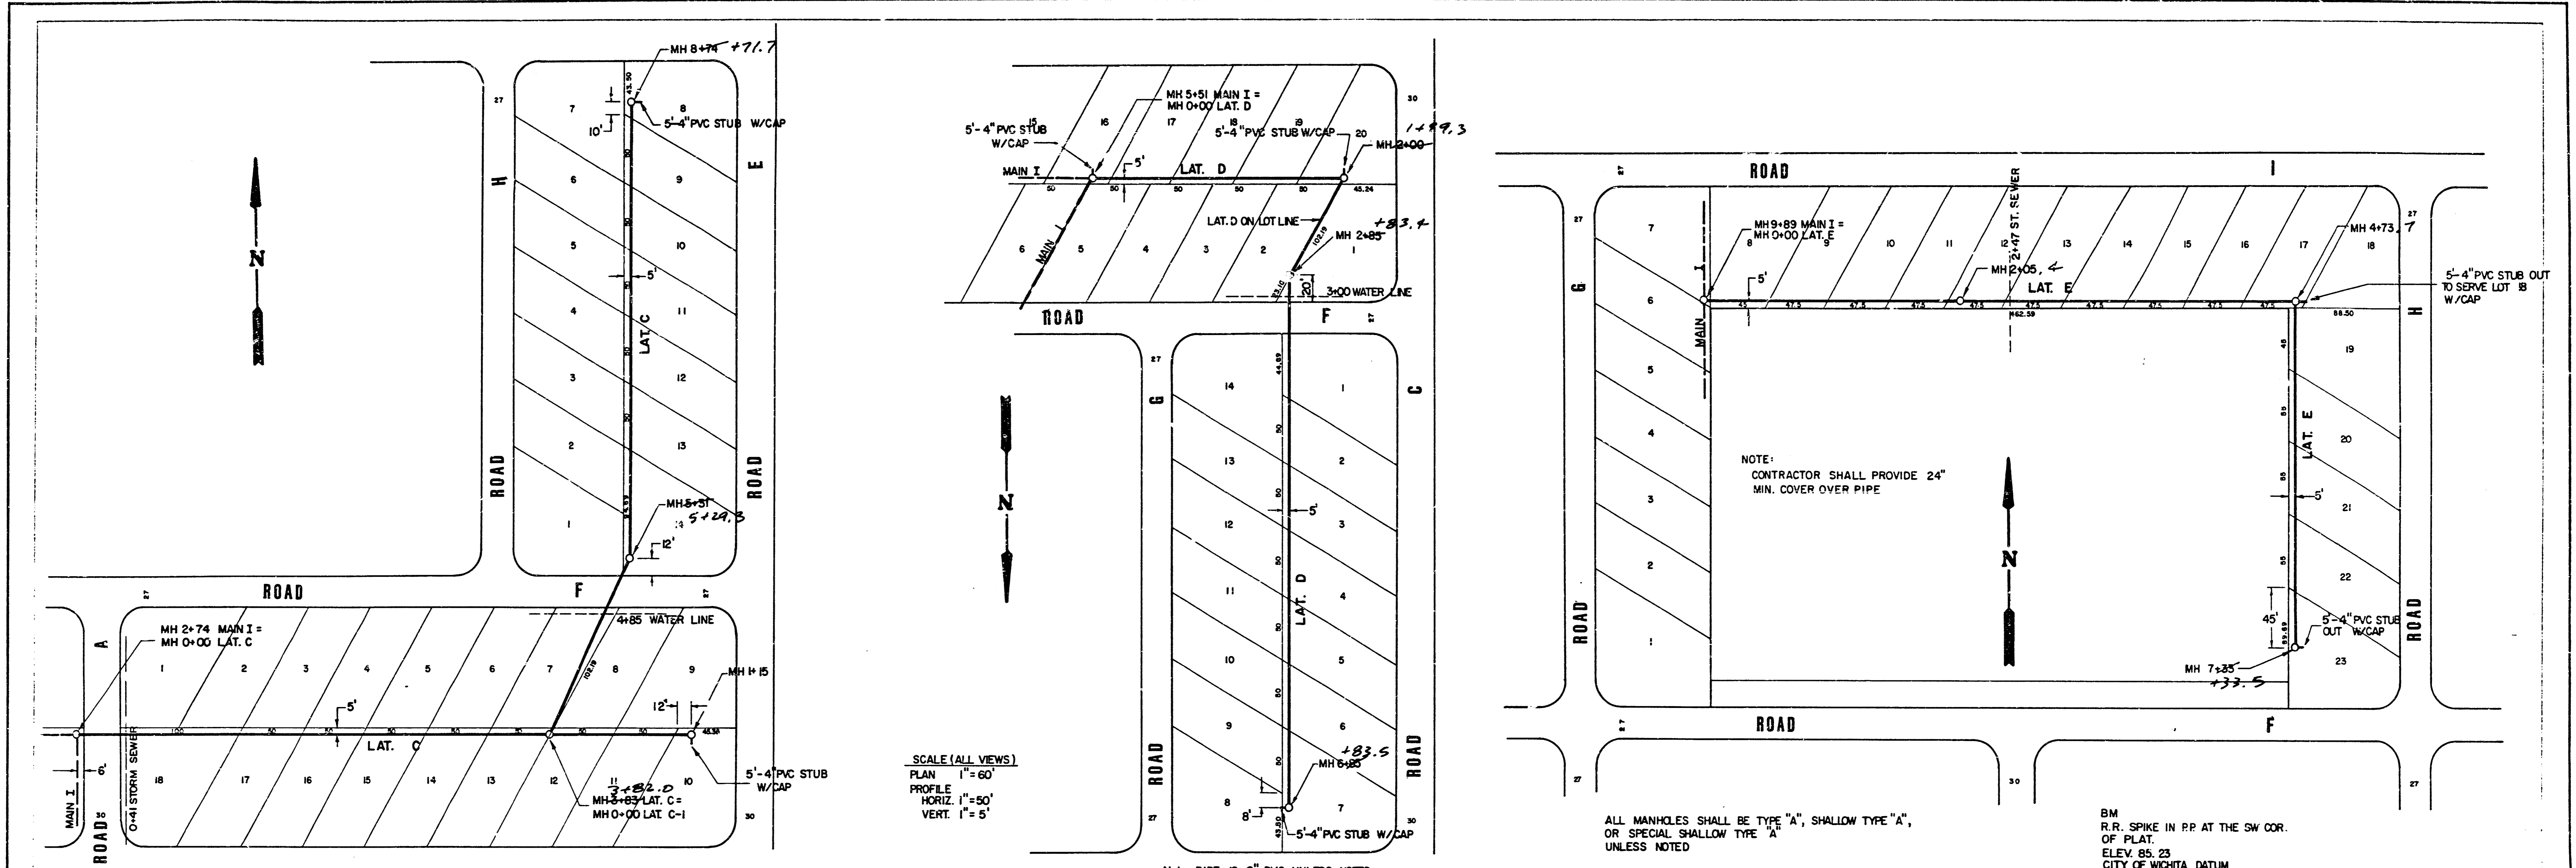

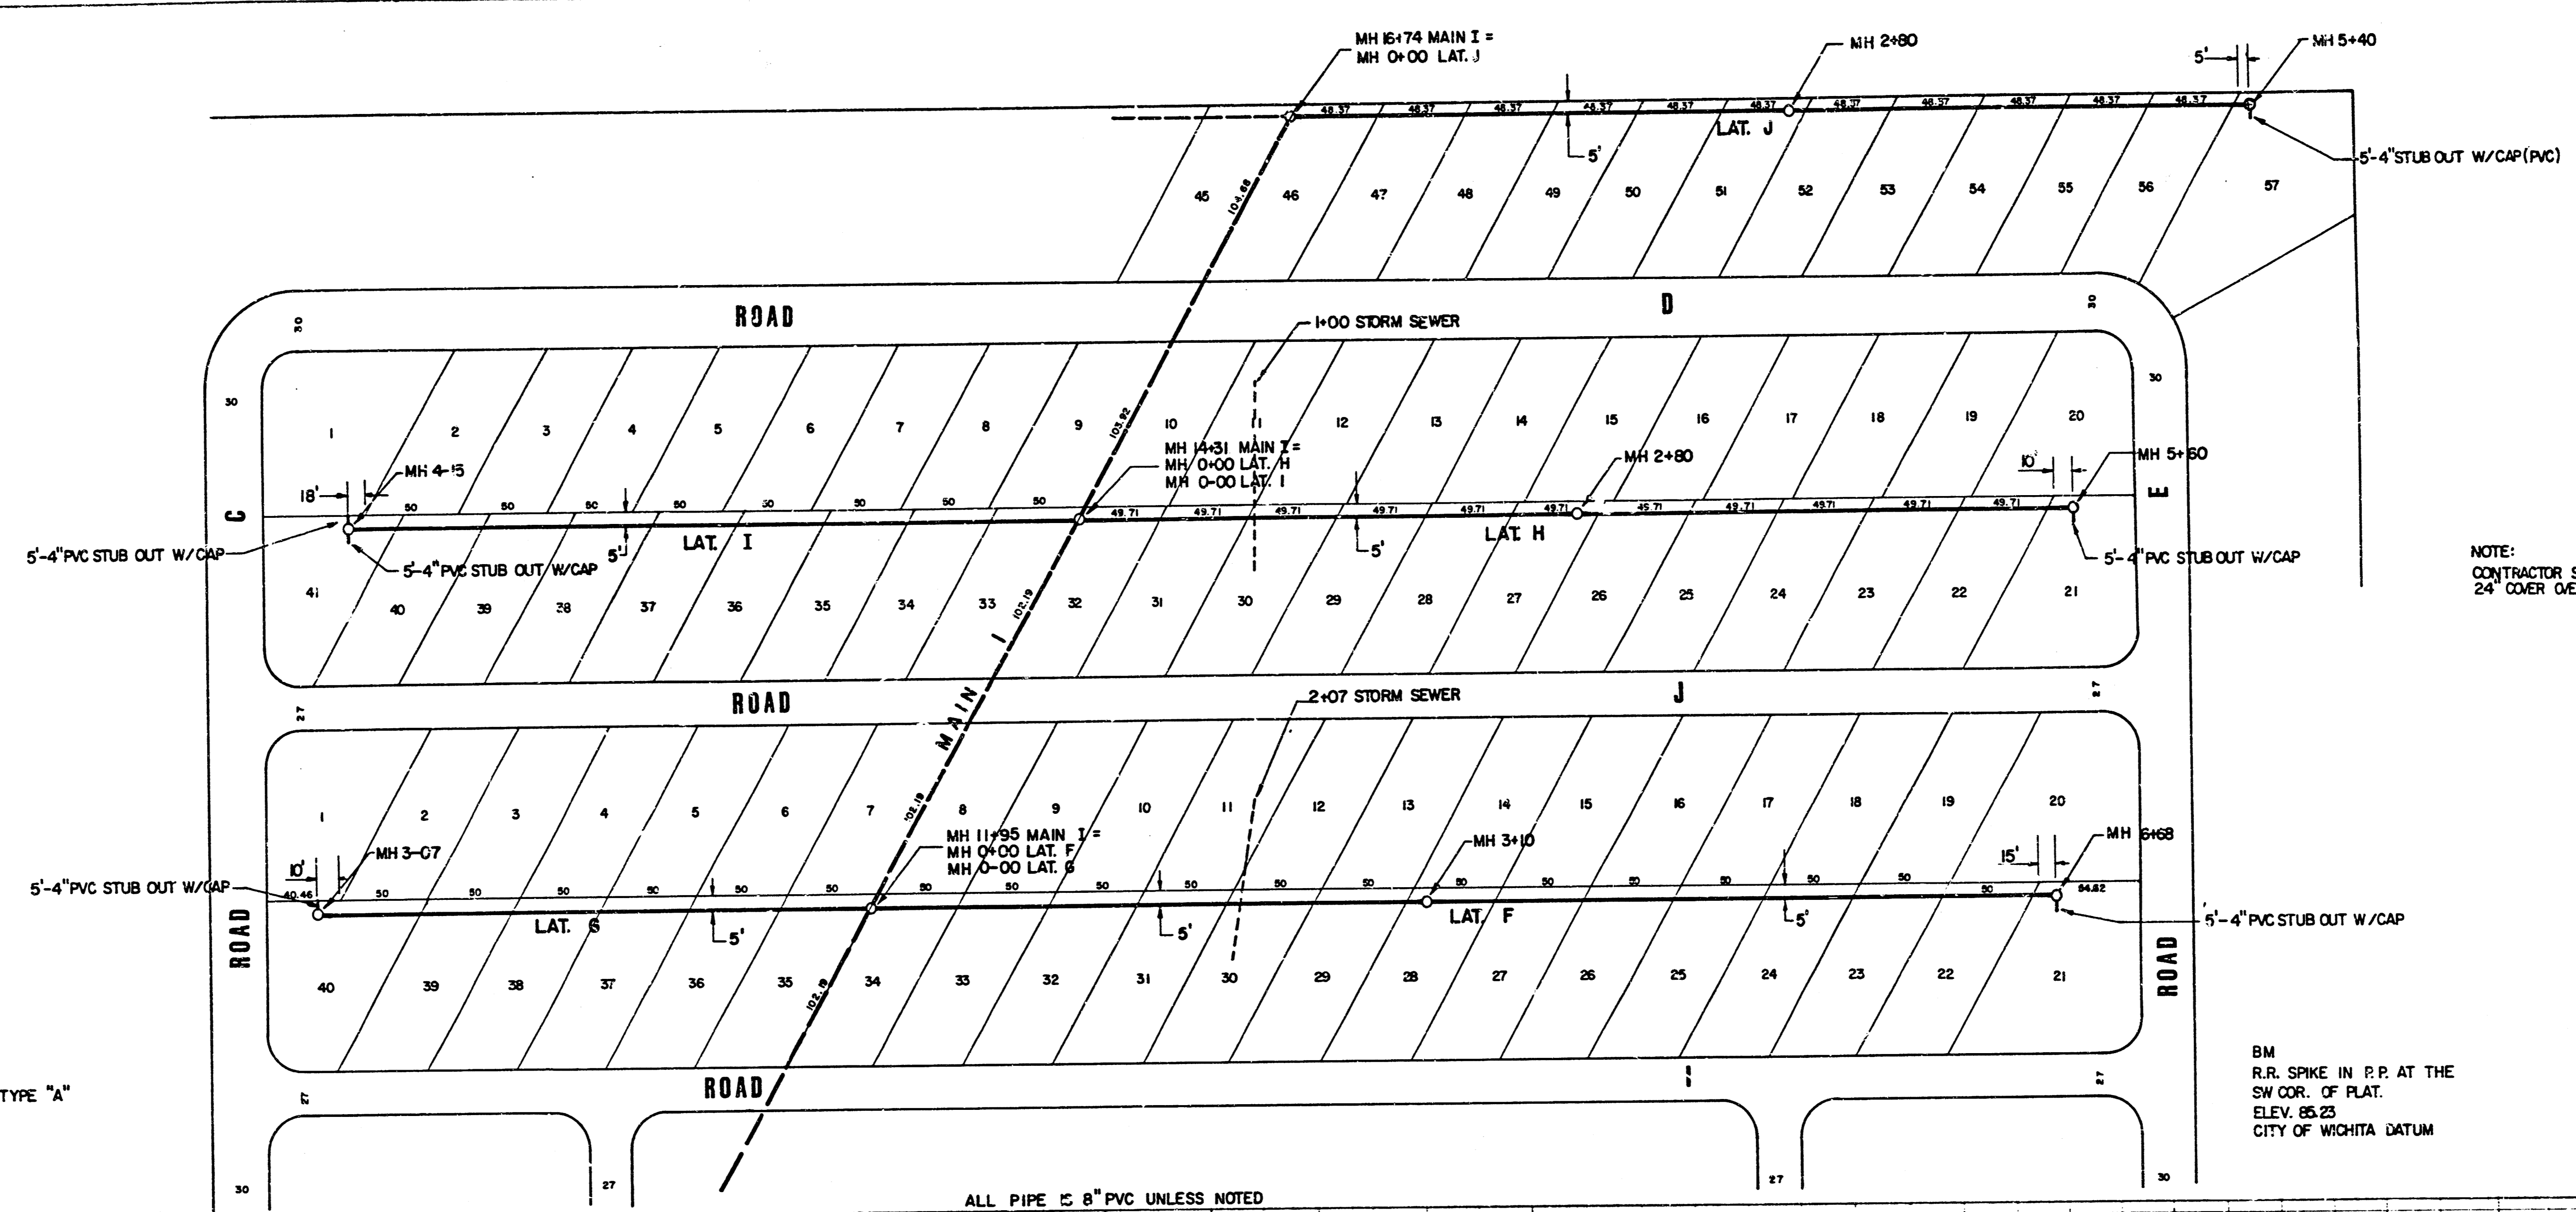

ALL MANHOLES SHALL BE TYPE "A", SPECIAL TYPE "A", OR SPECIAL SHALLOW TYPE "A"


NOTE: CONTRACTOR SHALL PROVIDE A MIN. OF 24" COVER OVER PIPE



SCALE  
PLAN 1" = 60'  
PROFILE 1" = 50'  
VERT. 1" = 5'

B.M. R.R. SPIKE IN P.P. AT THE SW COR. OF PLAT. ELEV. 85.23 CITY OF WICHITA DATUM

ALL PIPE IS 8" PVC UNLESS NOTED

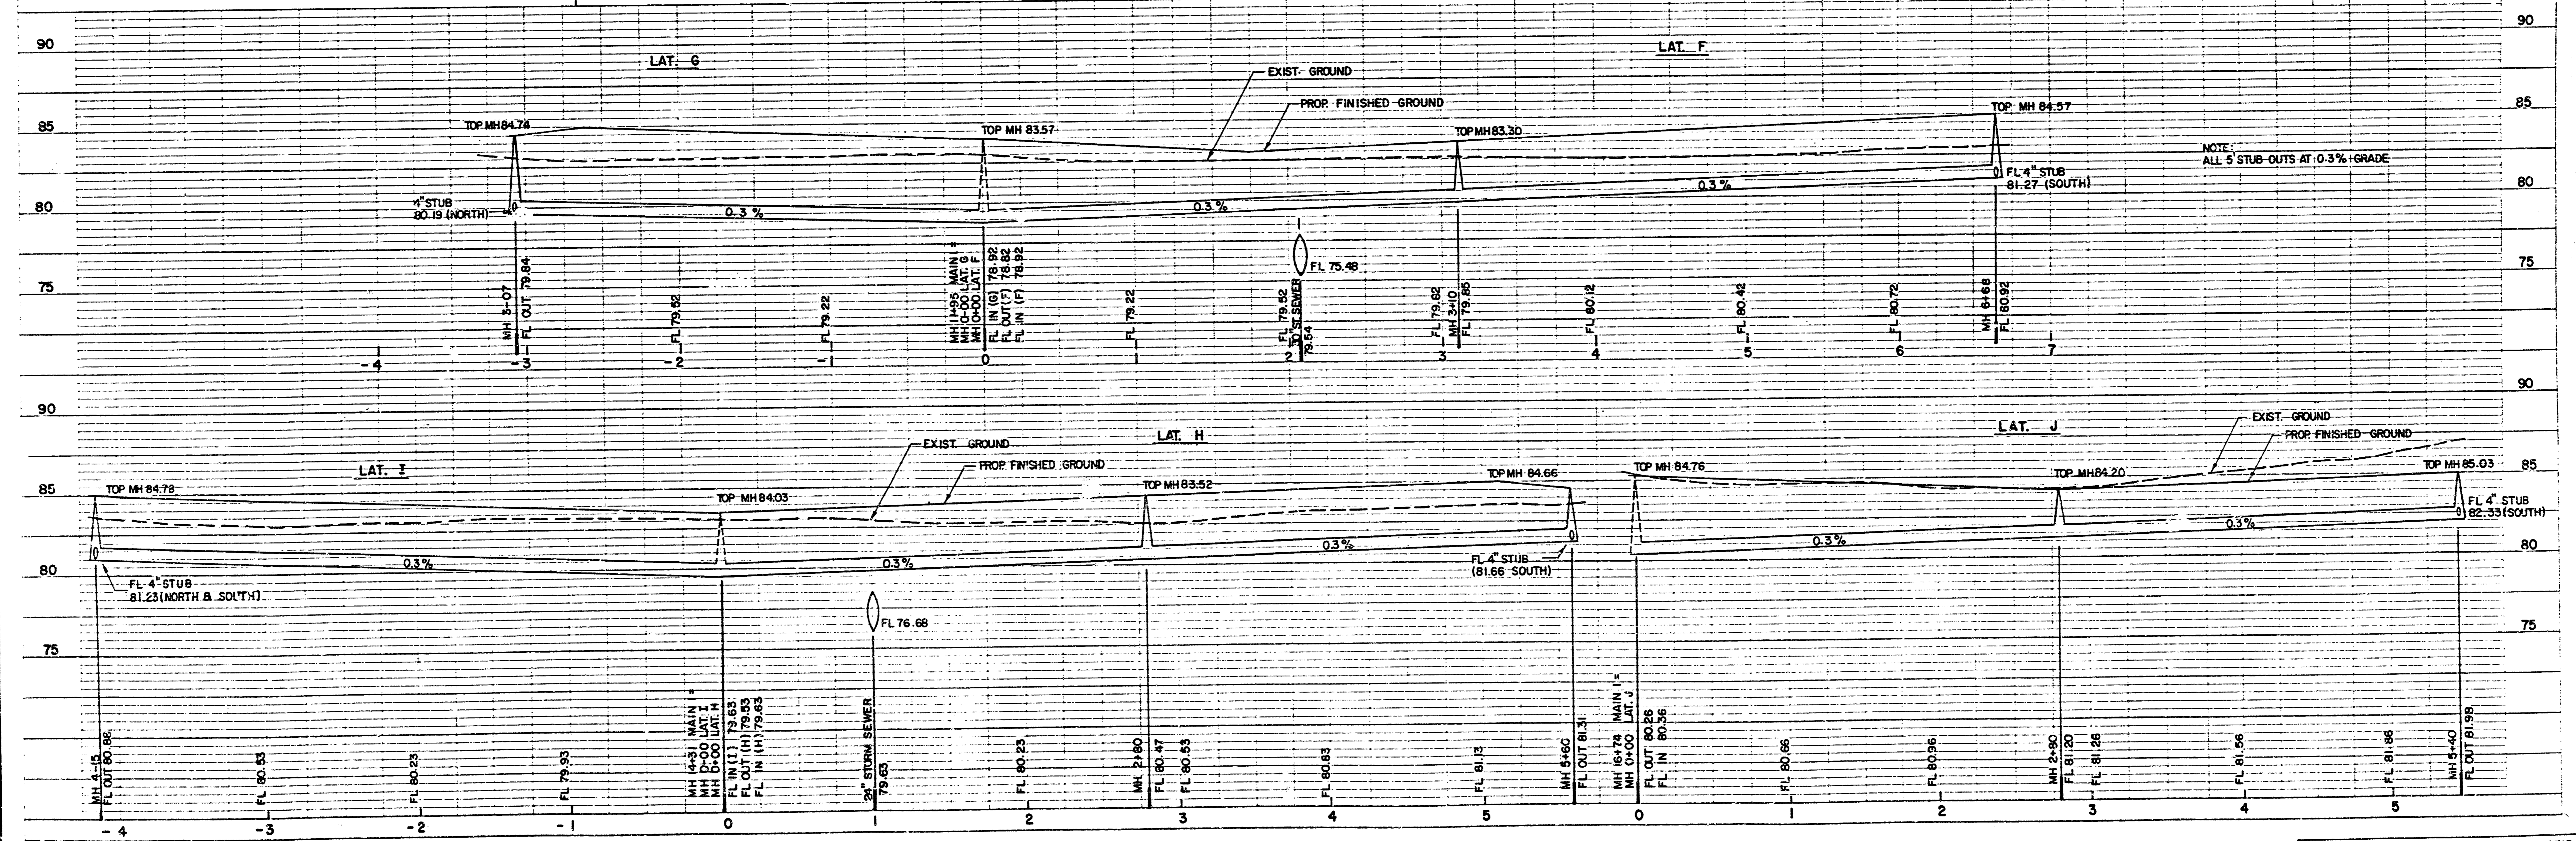

NOTE: ALL 5" STUB-OUTS AT 0.3% GRADE

REISS & GOODNESS ENGINEERS  
2100 WEST 21<sup>ST</sup> STREET  
WICHITA, KANSAS 67203  
(316) 832-0213

REVISION	DRAWN BY	CHECKED BY	DESIGNED BY	PROJECT

**SANITARY SEWER EXTENSIONS LAT'S. F, G, H, I, J**

CUSTOMER

**LAMPLIGHTER MOBILE PARK 3**

DATE NOTED 4/1/85  
PROJECT NO. MS 1265  
SHEET 8 OF 13