


MAP OF
 REPLAT OF LAWN TERRACE
 AND
 KRUEGER'S ADD.
 SEDGWICK CO KANSAS

WITH
 SEWER WYES
 AND
 WATER CONNECTIONS

SCALE 1" = 100'

PREPARED BY
 W. CHITTA 1960

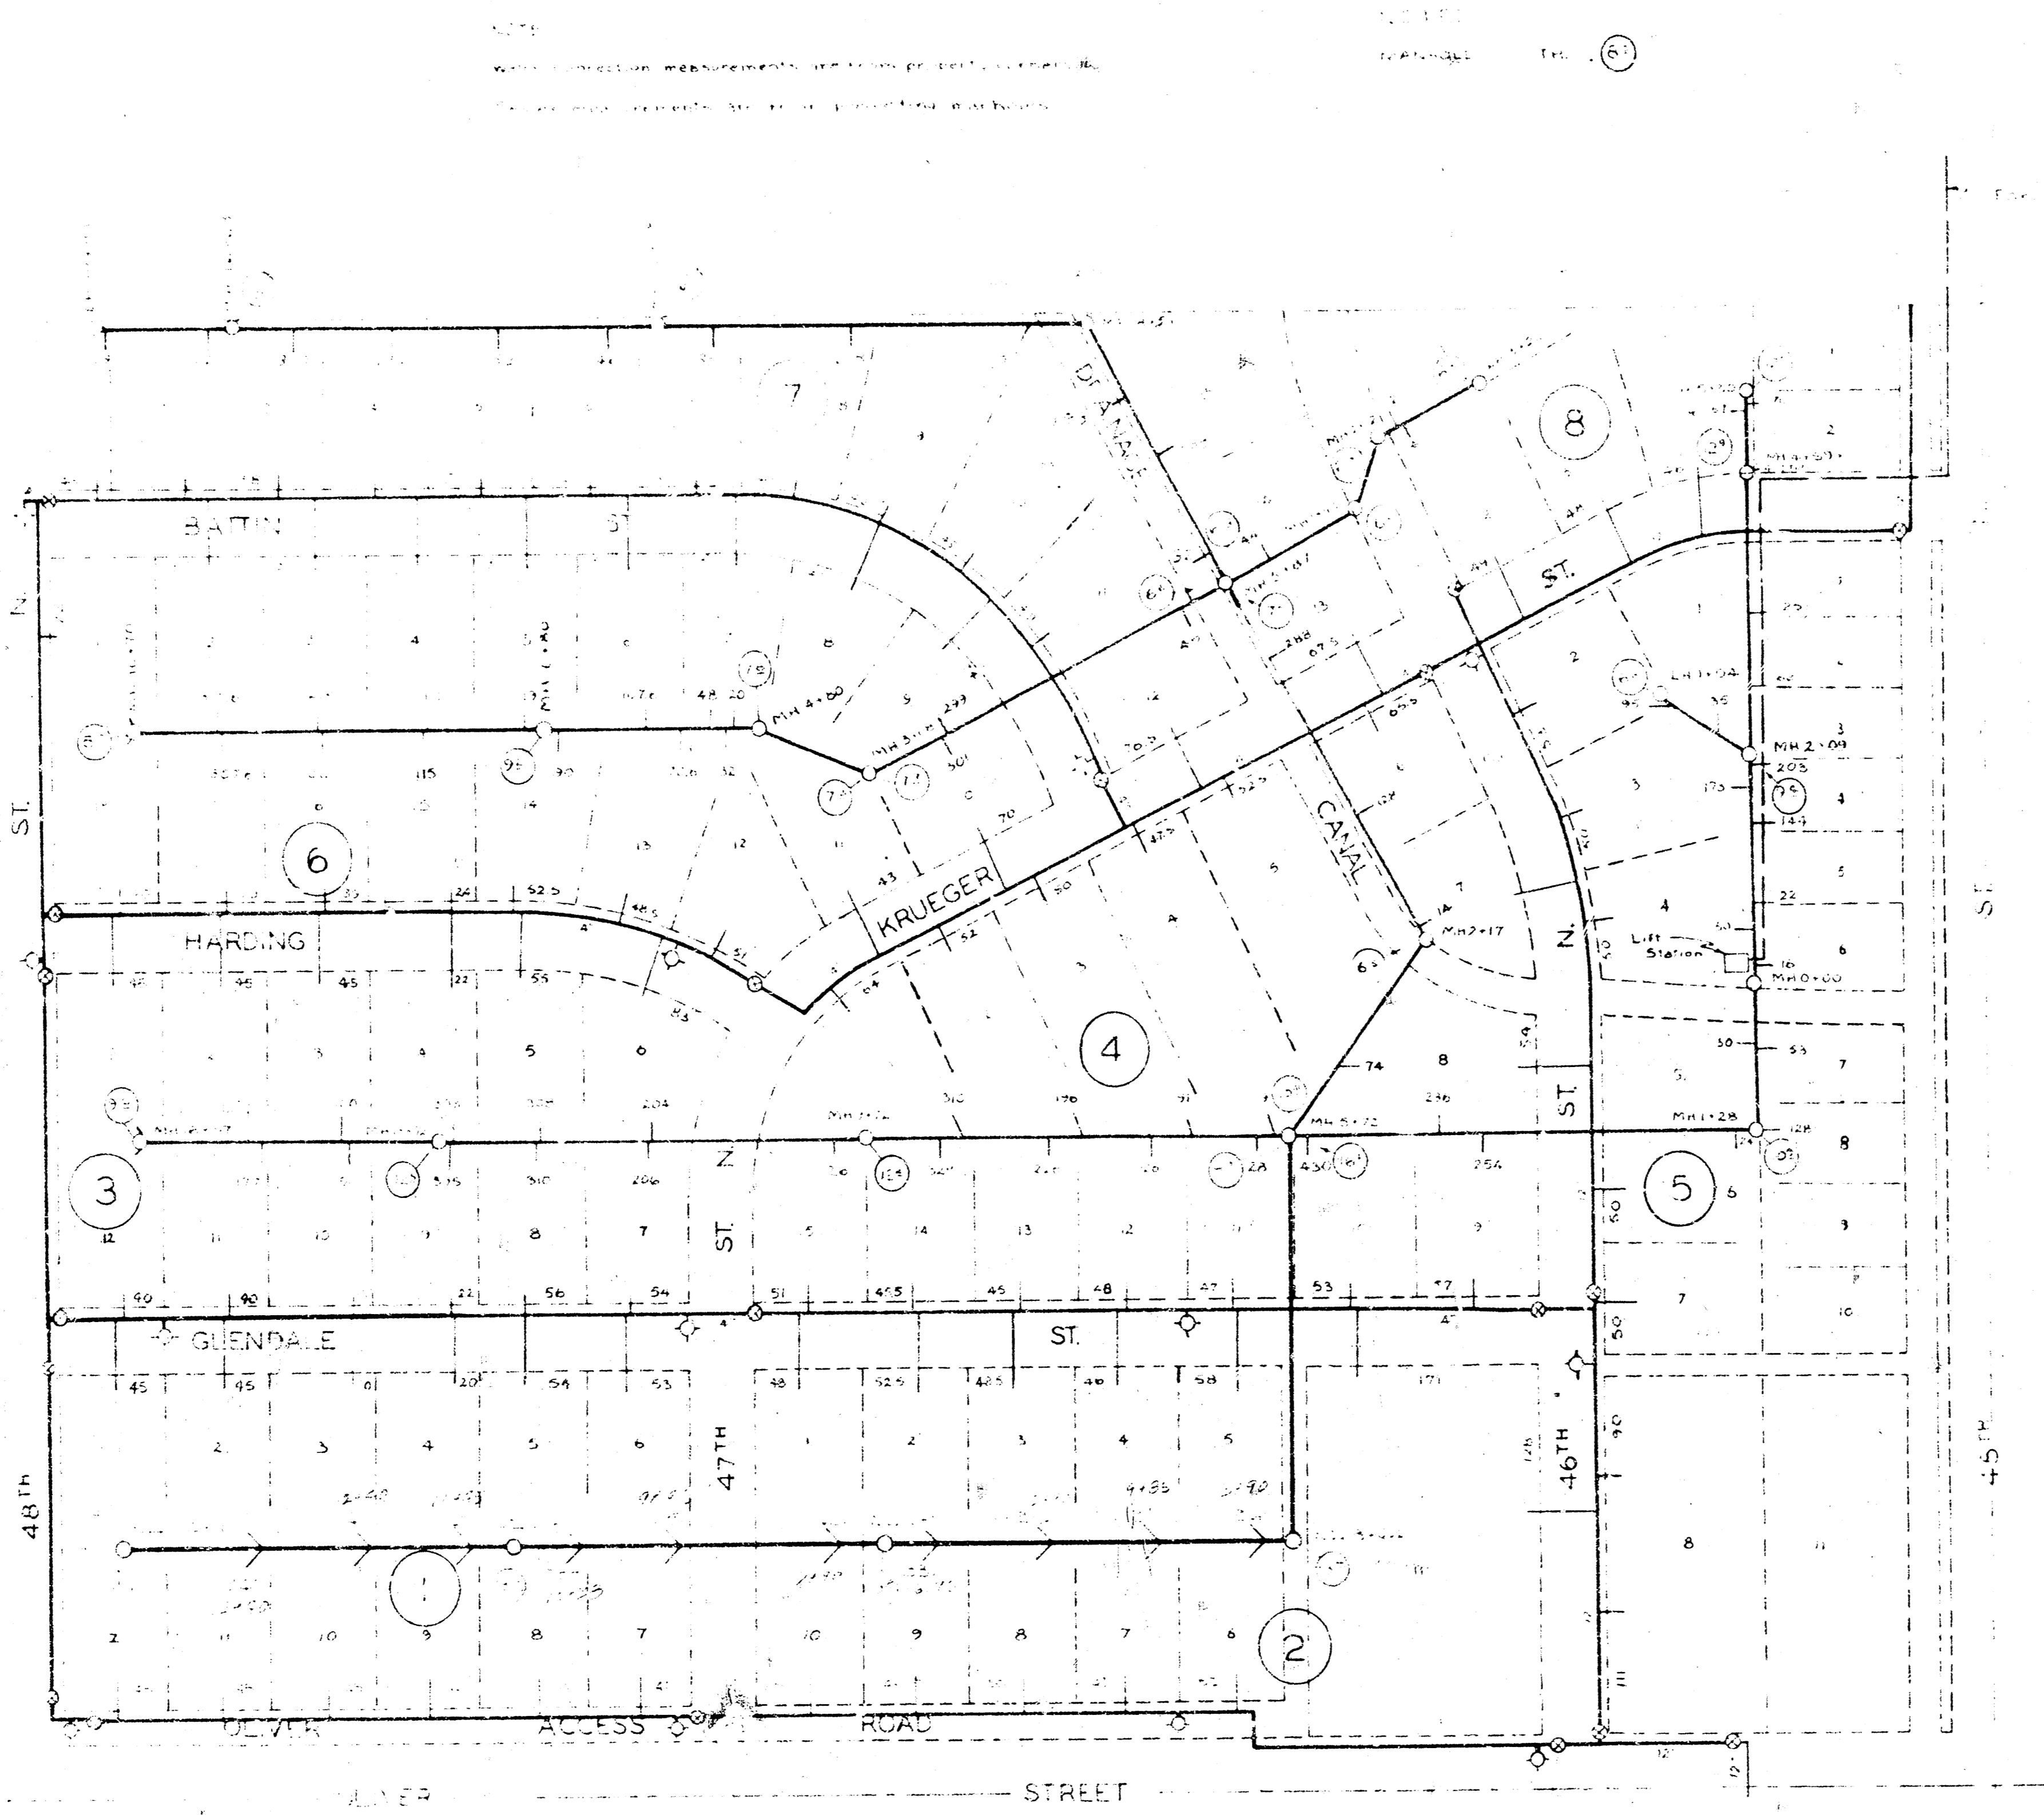

MAP OF
 REP. AT. OF LAWN TERRACE
 AND
 KRUEGER'S ADD.
 SEDGWICK CO. KANSAS
 WITH
 SEWER WYES
 AND
 WATER CONNECTIONS

SCALE 1" = 100'

REISS AND GOODNESS
 ENGINEERS

WICHITA 1960

