


1-10-77

APPROVED AS NOTED
Sanitary Sewer D.E.S.
Storm Sewer _____
Utility Approvals _____

NOTE TO CONTRACTOR

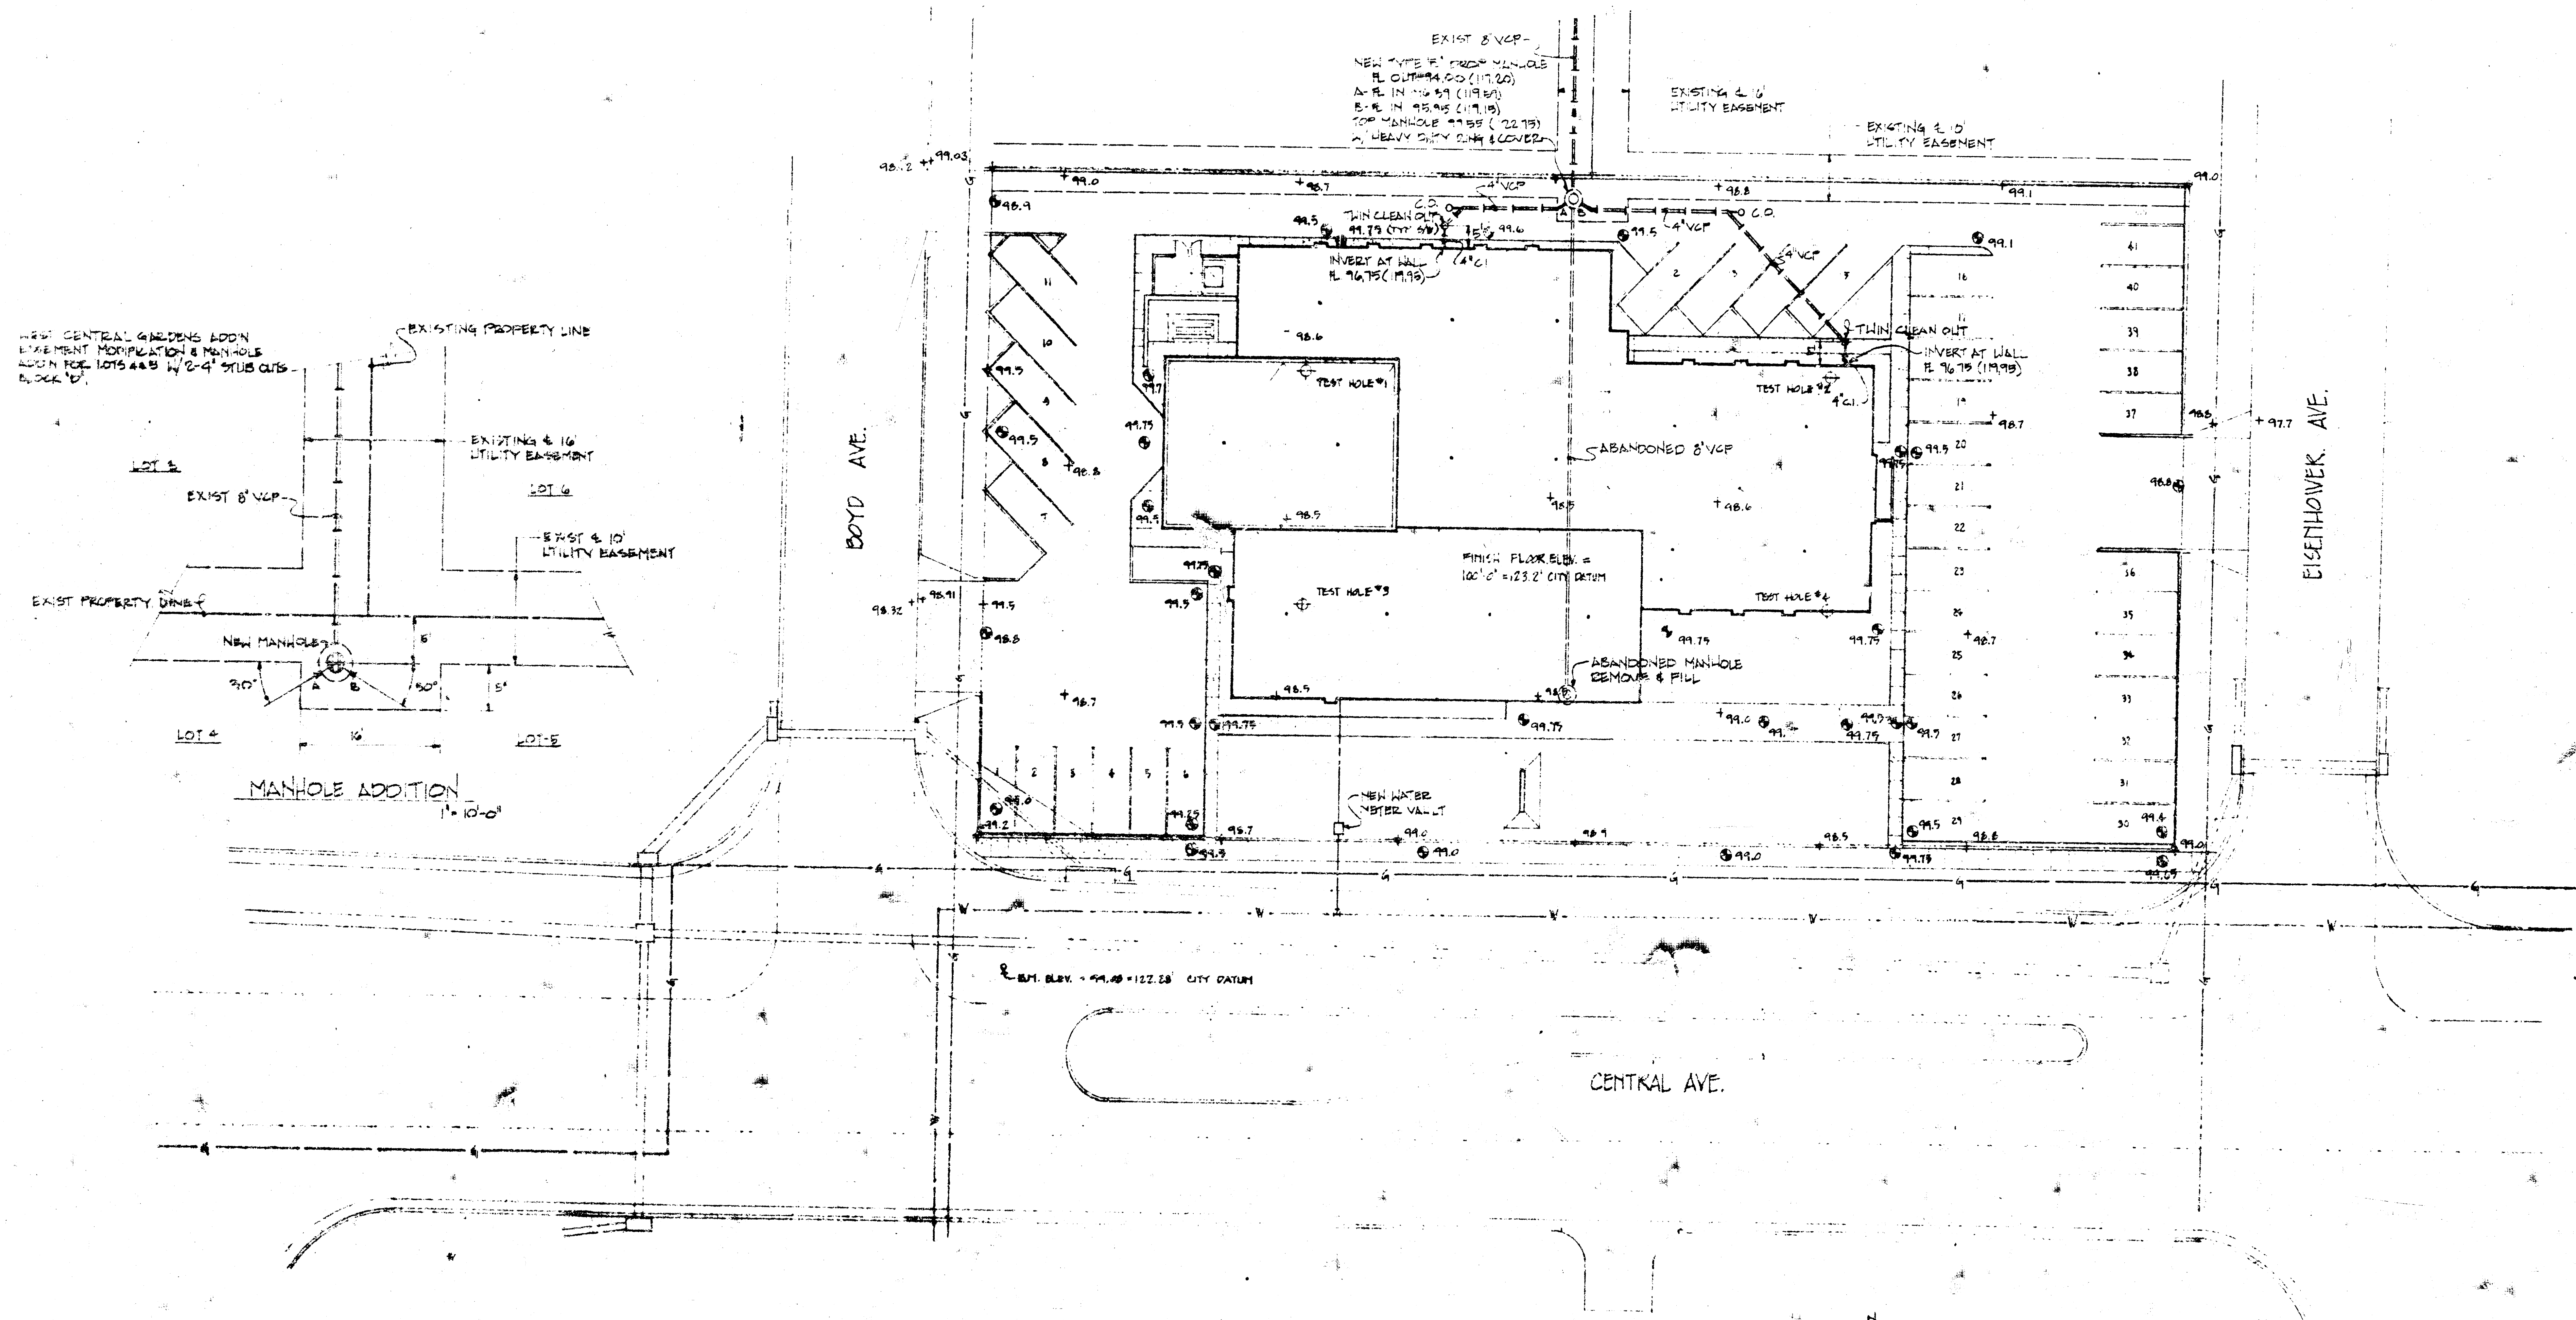

Sanitary Sewer Manhole construction

SITE PLAN

FARM BUREAU ASSOCIATION

WOODMAN, W. W. STREET
ARCHITECT PLANNING ENGINEER