R. R. spike W. side, R. Pole on S.W. cor. Woodchuck Ln. & Hendryx St.

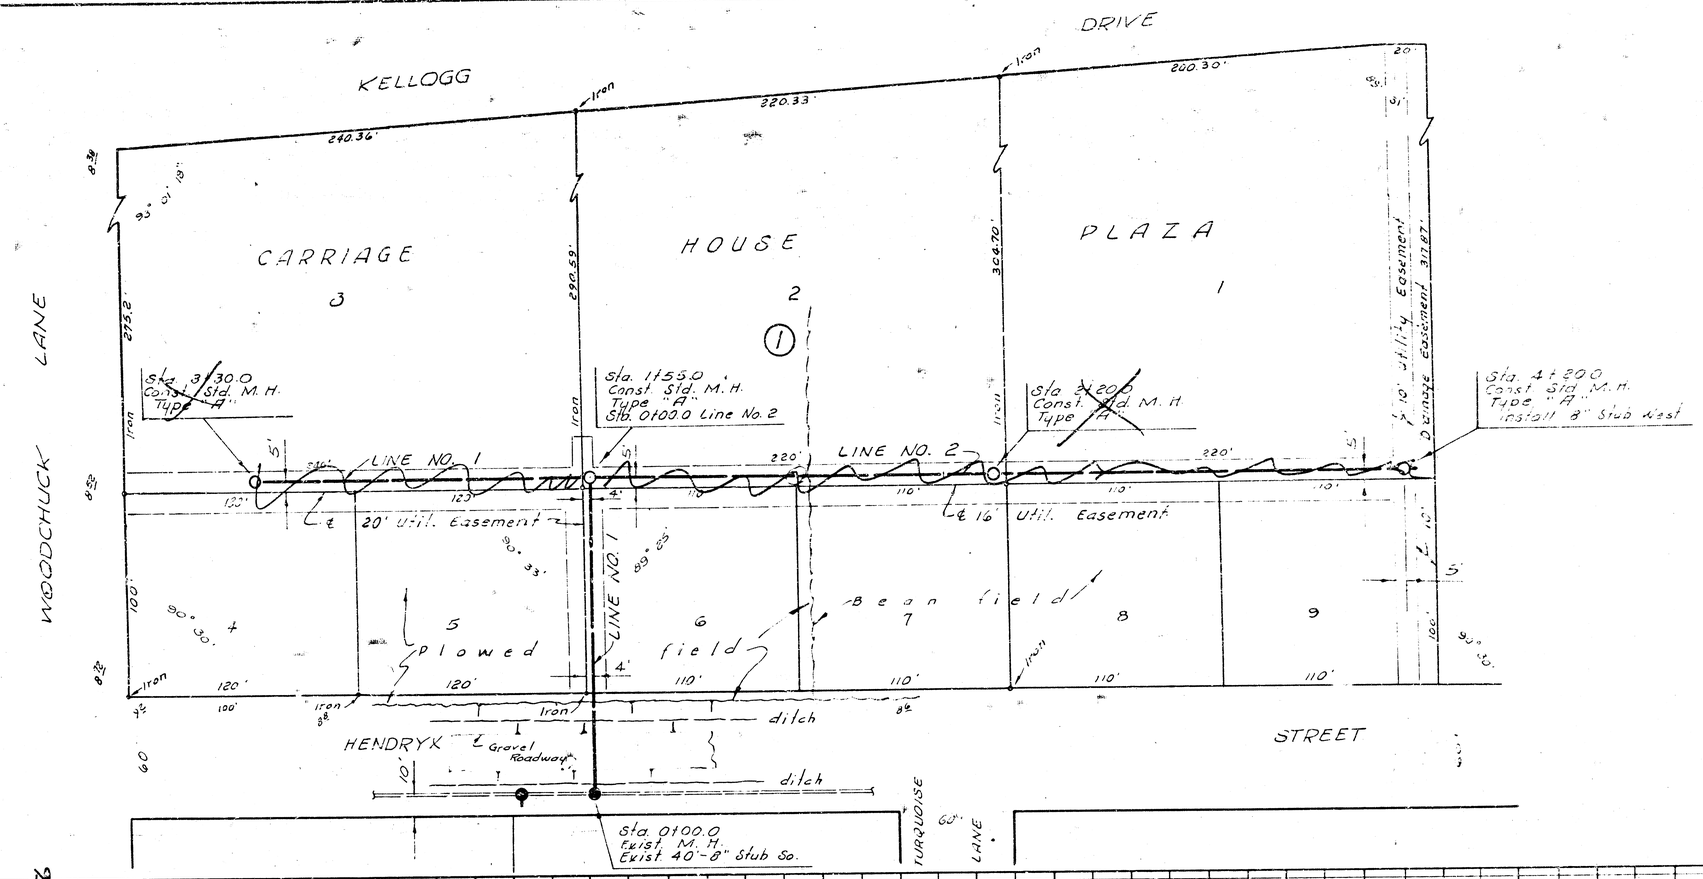

K+E PLATE 1, PLAN-PROFILE
KEUFFEL & ESSER CO.